


NORTH
Scale 1"=50'

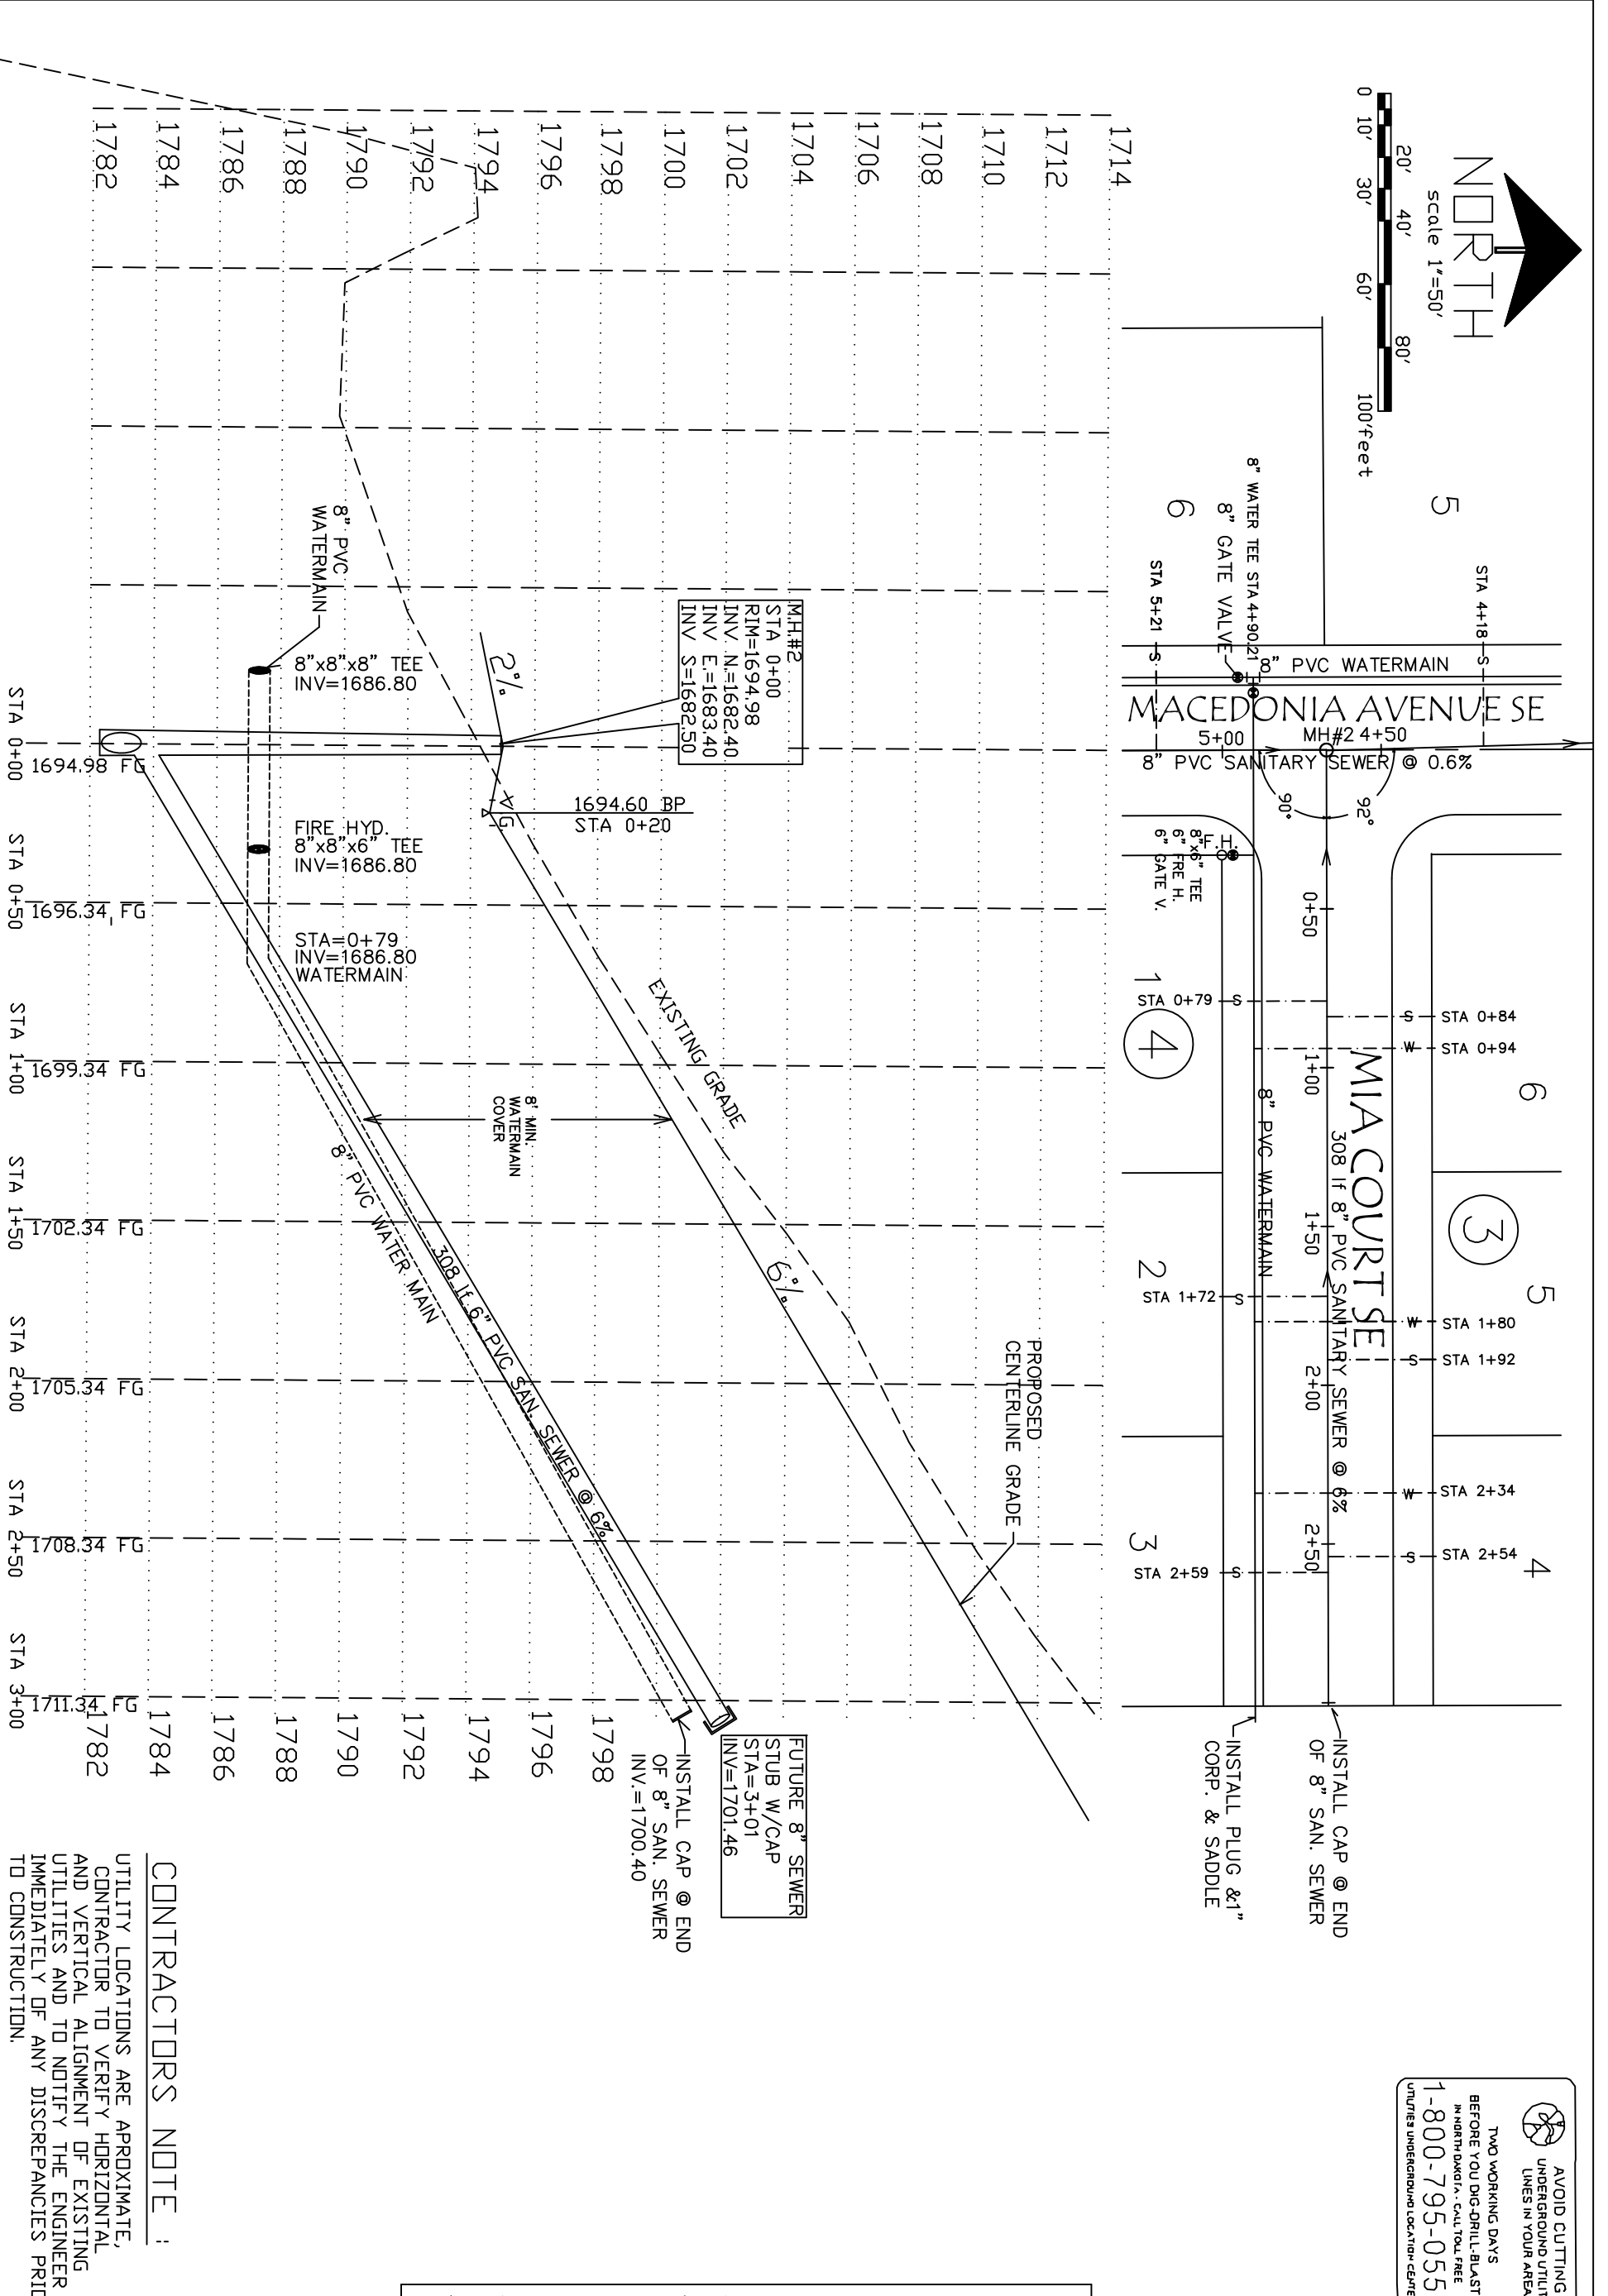

AVOID CUTTING UNDERGROUND UTILITY LINES IN YOUR AREA
TWO WORKING DAYS BEFORE YOU DIG-DRILL-BLAST IN NORTH DAKOTA - CALL TOLL FREE 1-800-795-0555 UTILITIES UNDERGROUND LOCATION CENTER

CONTRACTORS NOTE :
UTILITY LOCATIONS ARE APPROXIMATE, CONTRACTOR TO VERIFY HORIZONTAL AND VERTICAL ALIGNMENT OF EXISTING UTILITIES AND TO NOTIFY THE ENGINEER IMMEDIATELY OF ANY DISCREPANCIES PRIOR TO CONSTRUCTION.

AS BUILT -- MIA COURT SE
WATER & SEWER IMPROVEMENTS
MACEDONIA HILLS--FIRST ADDITION
PROJECT NUMBER 2013-21
CITY OF MANDAN
MORTON COUNTY, NORTH DAKOTA

REVISIONS
MACKOVSKI CONSULTING
7745 MAGGIE BELLE CT.
LAS VEGAS, NV 89123
(702) 648-9690 Phone/Fax
(702) 499-8961 Cell
MB@MBinvestors.com

SHEET C-07
7 of 14