


0 10' 20' 30' 40' 60' 80' 100'feet

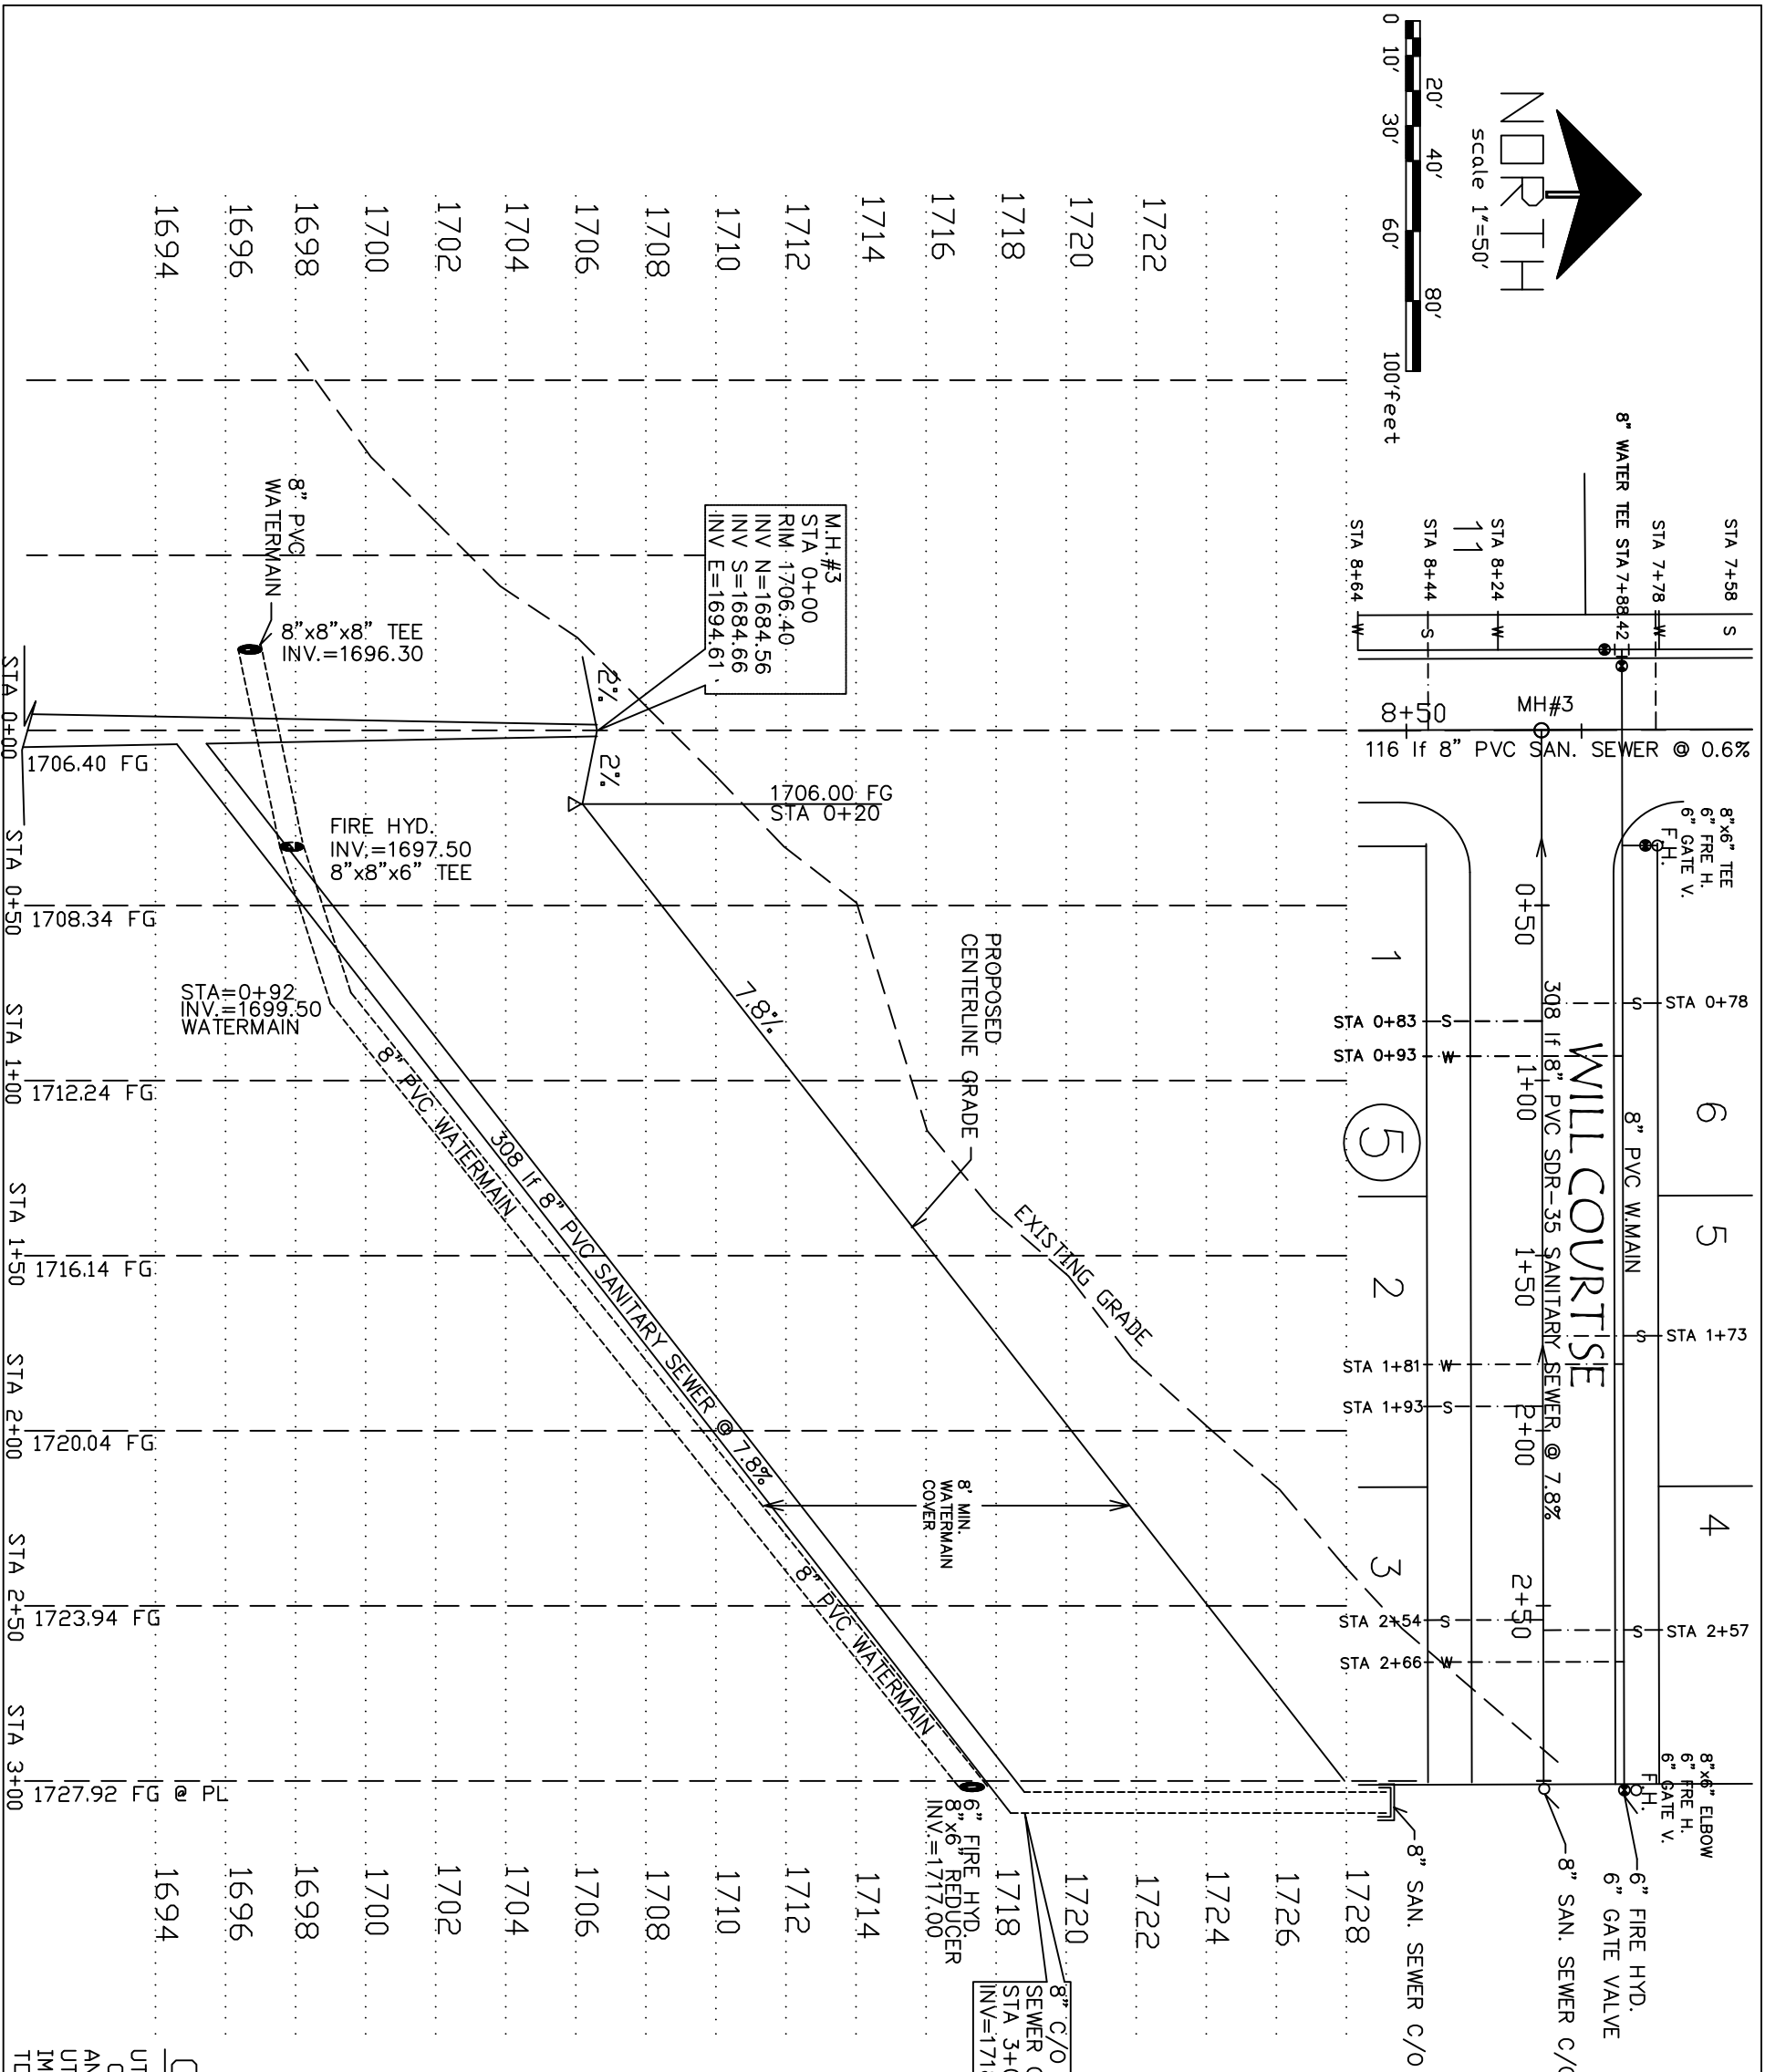

AVOID CUTTING UNDERGROUND UTILITY LINES IN YOUR AREA
 TWO WORKING DAYS BEFORE YOU DIG-DRILL-BLAST IN NORTH DAKOTA - CALL TOLL FREE 1-800-795-0555
 UTILITIES UNDERGROUND LOCATION CENTER

AS BUILT - WILL Court
 WATER & SEWER IMPROVEMENTS
 MACEDONIA HILLS—FIRST ADDITION
 PROJECT NUMBER 2013-21
 CITY OF MANDAN
 MORTON COUNTY, NORTH DAKOTA

MACKOVSKI CONSULTING
 7745 MAGGIE BELLE CT.
 LAS VEGAS, NV 89123
 (702) 648-9690 Phone/Fax
 (702) 499-8961 Cell
 MB@MBinvestors.com

REVISIONS

CONTRACTORS NOTE :

UTILITY LOCATIONS ARE APPROXIMATE, CONTRACTOR TO VERIFY HORIZONTAL AND VERTICAL ALIGNMENT OF EXISTING UTILITIES AND TO NOTIFY THE ENGINEER IMMEDIATELY OF ANY DISCREPANCIES PRIOR TO CONSTRUCTION.

SHEET
C-08
 8 of 14