

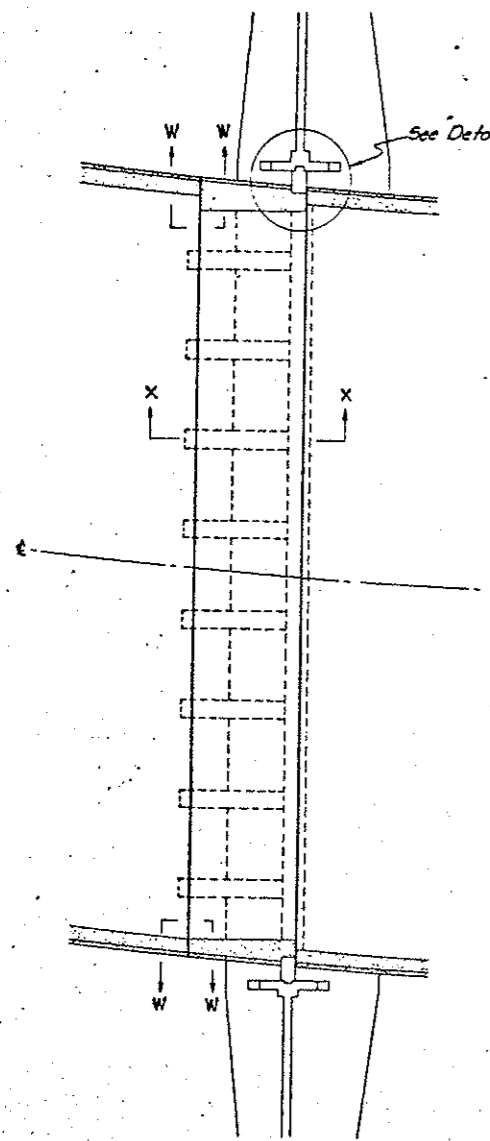


DETAILS


FED. REGION	STATE	FED. AID PROJ. NO.	SHEET NO.
8	N.D.	MG-1-010(05)	7

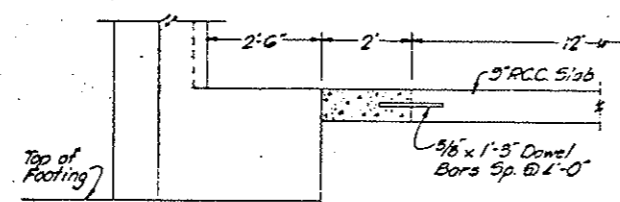



PLAN

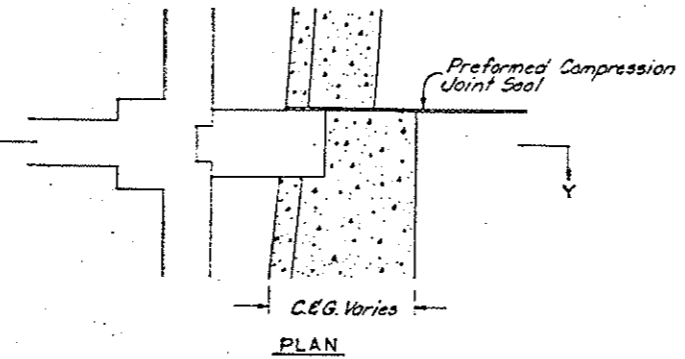

DETAIL A

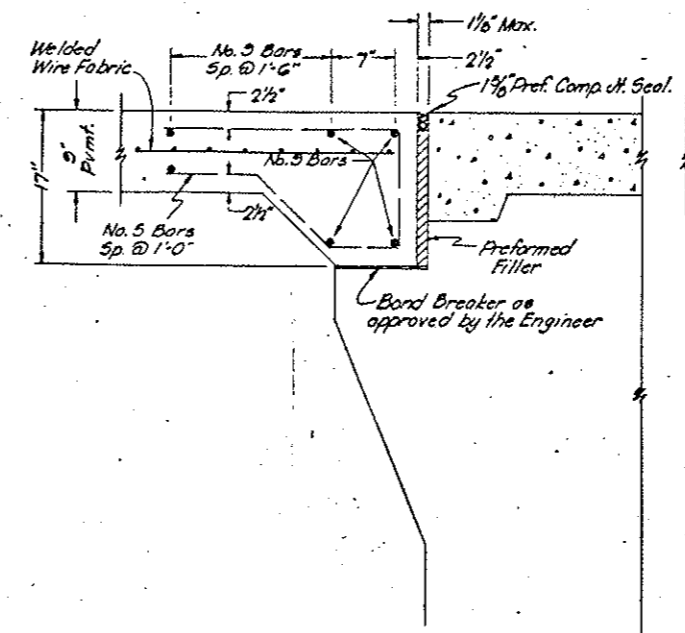

SECTION X-X

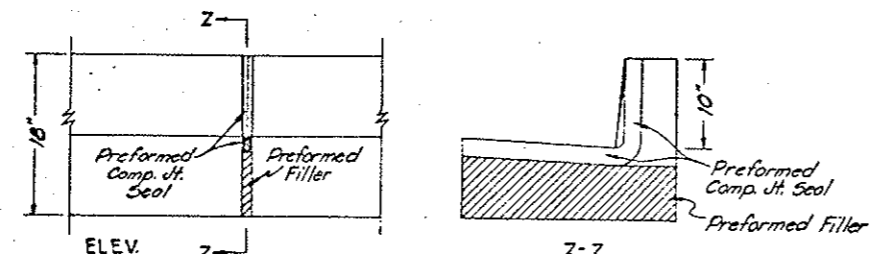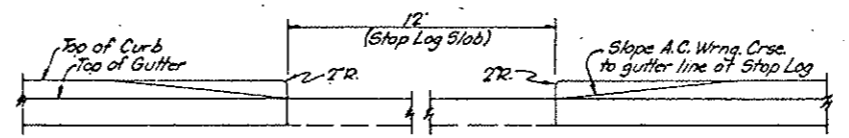

SECTION W-W

