

SLOWER TRAFFIC
KEEP RIGHT
Sta. 7+00 Rt.
R4-3-36
Assembly 11
Reg-Sign

EAST
BUSINESS LOOP
94
In Place To Remain

NO PARKING
HERE TO CORNER
In Place To Remain

YIELD
Sta. 1+25 Rt.
R1-2-48
Assembly 5
Reg-Sign

NO PARKING
HERE TO CORNER
In Place To Remain

WEST
BUSINESS LOOP
94
In Place To Remain

In Place To Remain

STOP
Back to Back
In Place To Remain

STOP
Back to Back
DO NOT ENTER
In Place To Remain

In Place Remove

CENTER LANE ONLY
Sta. 9+00 Rt.
R3-9b-36
Assembly 11
Reg-Sign

TWO WAY TRAFFIC
In Place Remove

KEEP RIGHT
In Place To Remain

Sta. 6+00 Lt.
W3-3-36
Assembly 20
Warning Sign

Install Pavement Marking, Drop on Beads, Type II

FHWA REGION	STATE	FED. AID PROJ. NO.	SHEET NO.
8	N.D.	F-1-094(03)	58

Sta. 46+29.49 to 51+00 Lt. & Rt. Lane Lines 240 L.F.
 Sta. 46+29.49 to 51+00 Lt. & Rt. No Passing Zone Lines 1445 L.F.
 Sta. 46+29.49 to 51+00 Lt. & Rt. Edge Lines 942 L.F.
 Left Arrow 1 Ea. 2627

Sta. 50+85 Lt.
 R1-1-30
 Assembly 1
 Reg-Sign




Sta. 46+91 Lt.
 R8-3-36
 Light Std. Mtd.



In Place
 Remove

50

Equation
 P.T. 9+93.2 Bk.=
 46+29.49 Ahd.

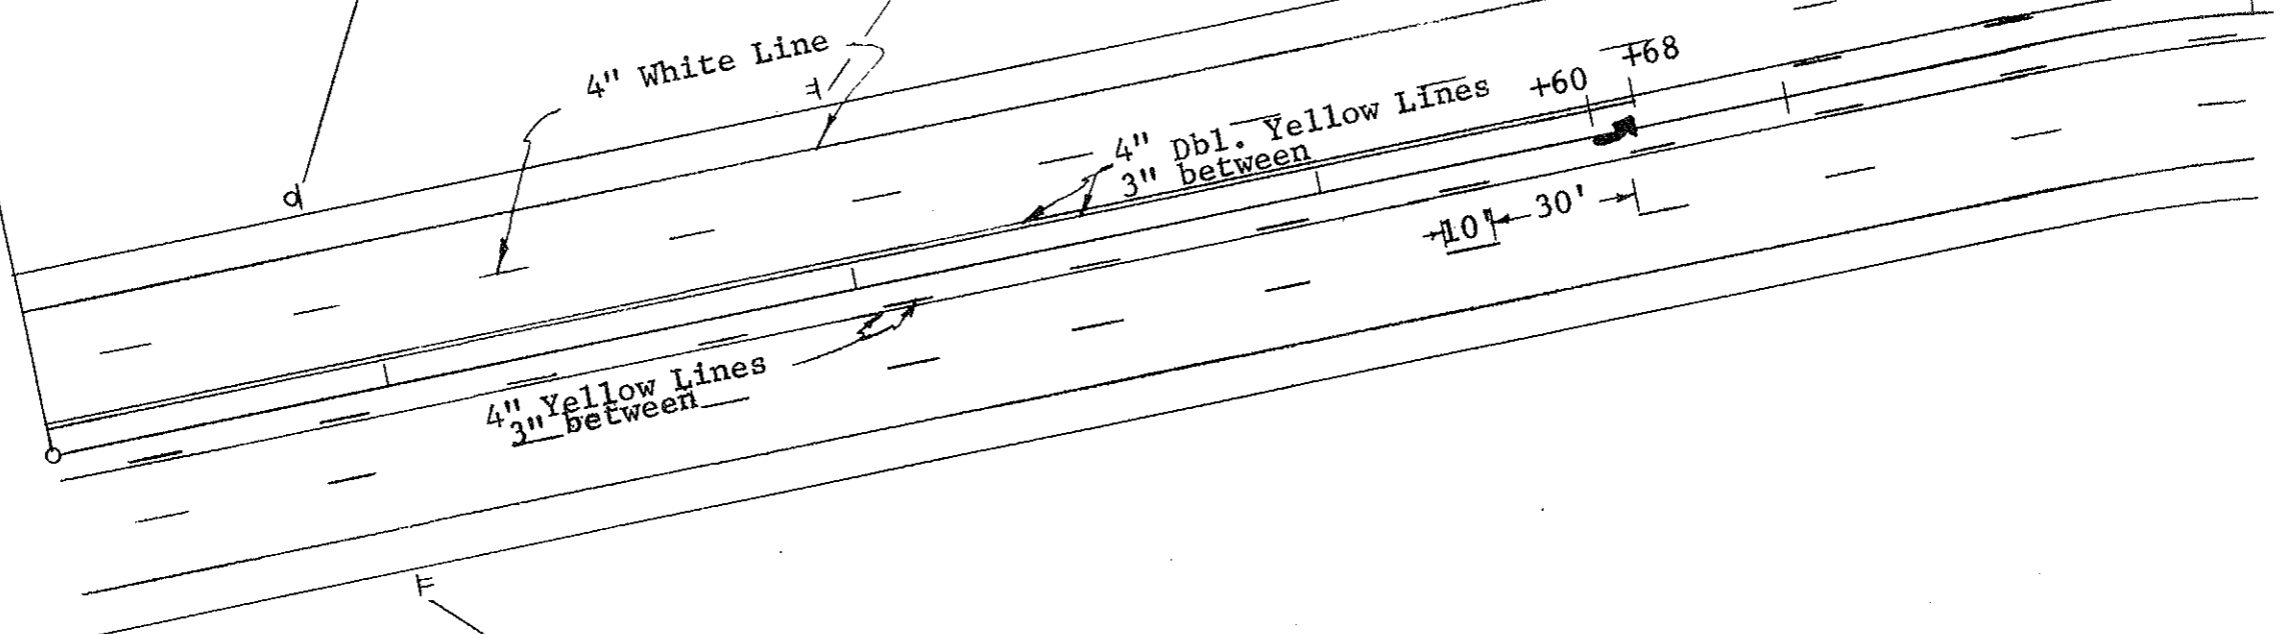

Sta. 47+00 Rt.
 R8-3-36
 Assembly 16
 Reg-Sign