



"AS BUILT PLANS" JOB# 19
 NORTH DAKOTA
 DEPARTMENT OF TRANSPORTATION

| | | | |
|-------------|-------|-------------------|-----------|
| FHWA REGION | STATE | PROJECT NO. | SHEET NO. |
| 8 | ND | HEU-1-806(032)069 | 1 |

PROJECT NO. HEU-1-806(032)069
 IN
 MORTON COUNTY
 TRAFFIC SIGNALS

GOVERNING SPECIFICATIONS:

Standard Specifications adopted by the North Dakota Department of Transportation October 1997; Standard Drawings currently in effect; and other Contract Provisions submitted herein.

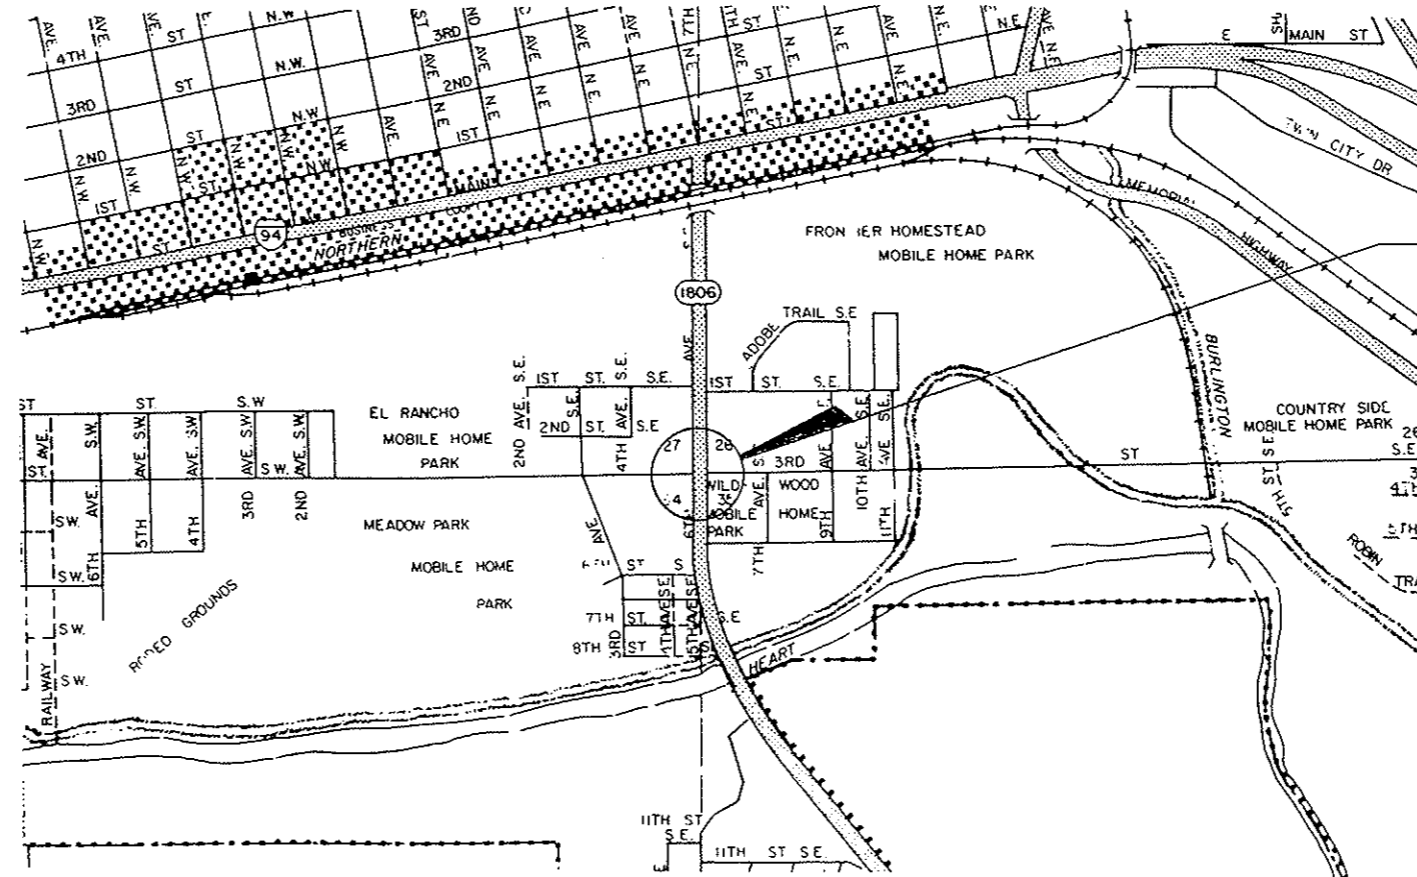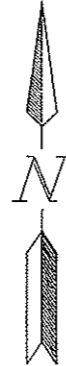

HEU-1-806(032)069
 ND 1806 AND 3RD ST SE

MANDAN

DESIGNER Blaine Johannes
 DESIGNER _____
 DESIGNER _____
 RECOMMEND APPROVAL December 18, 1997
 DESIGN ENGINEER Kurt E. Birt

U.S. DEPARTMENT OF TRANSPORTATION
 FEDERAL HIGHWAY ADMINISTRATION

 APPROVED

 DIVISION ADMINISTRATOR _____ DATE _____

APPROVED DATE 12-18-97
David Krone
 P.E. - 1199
 DIRECTOR OF HIGHWAYS
 AND ENGINEERING
 NORTH DAKOTA
 DEPARTMENT OF TRANSPORTATION

5