


① Revised 6-12-98

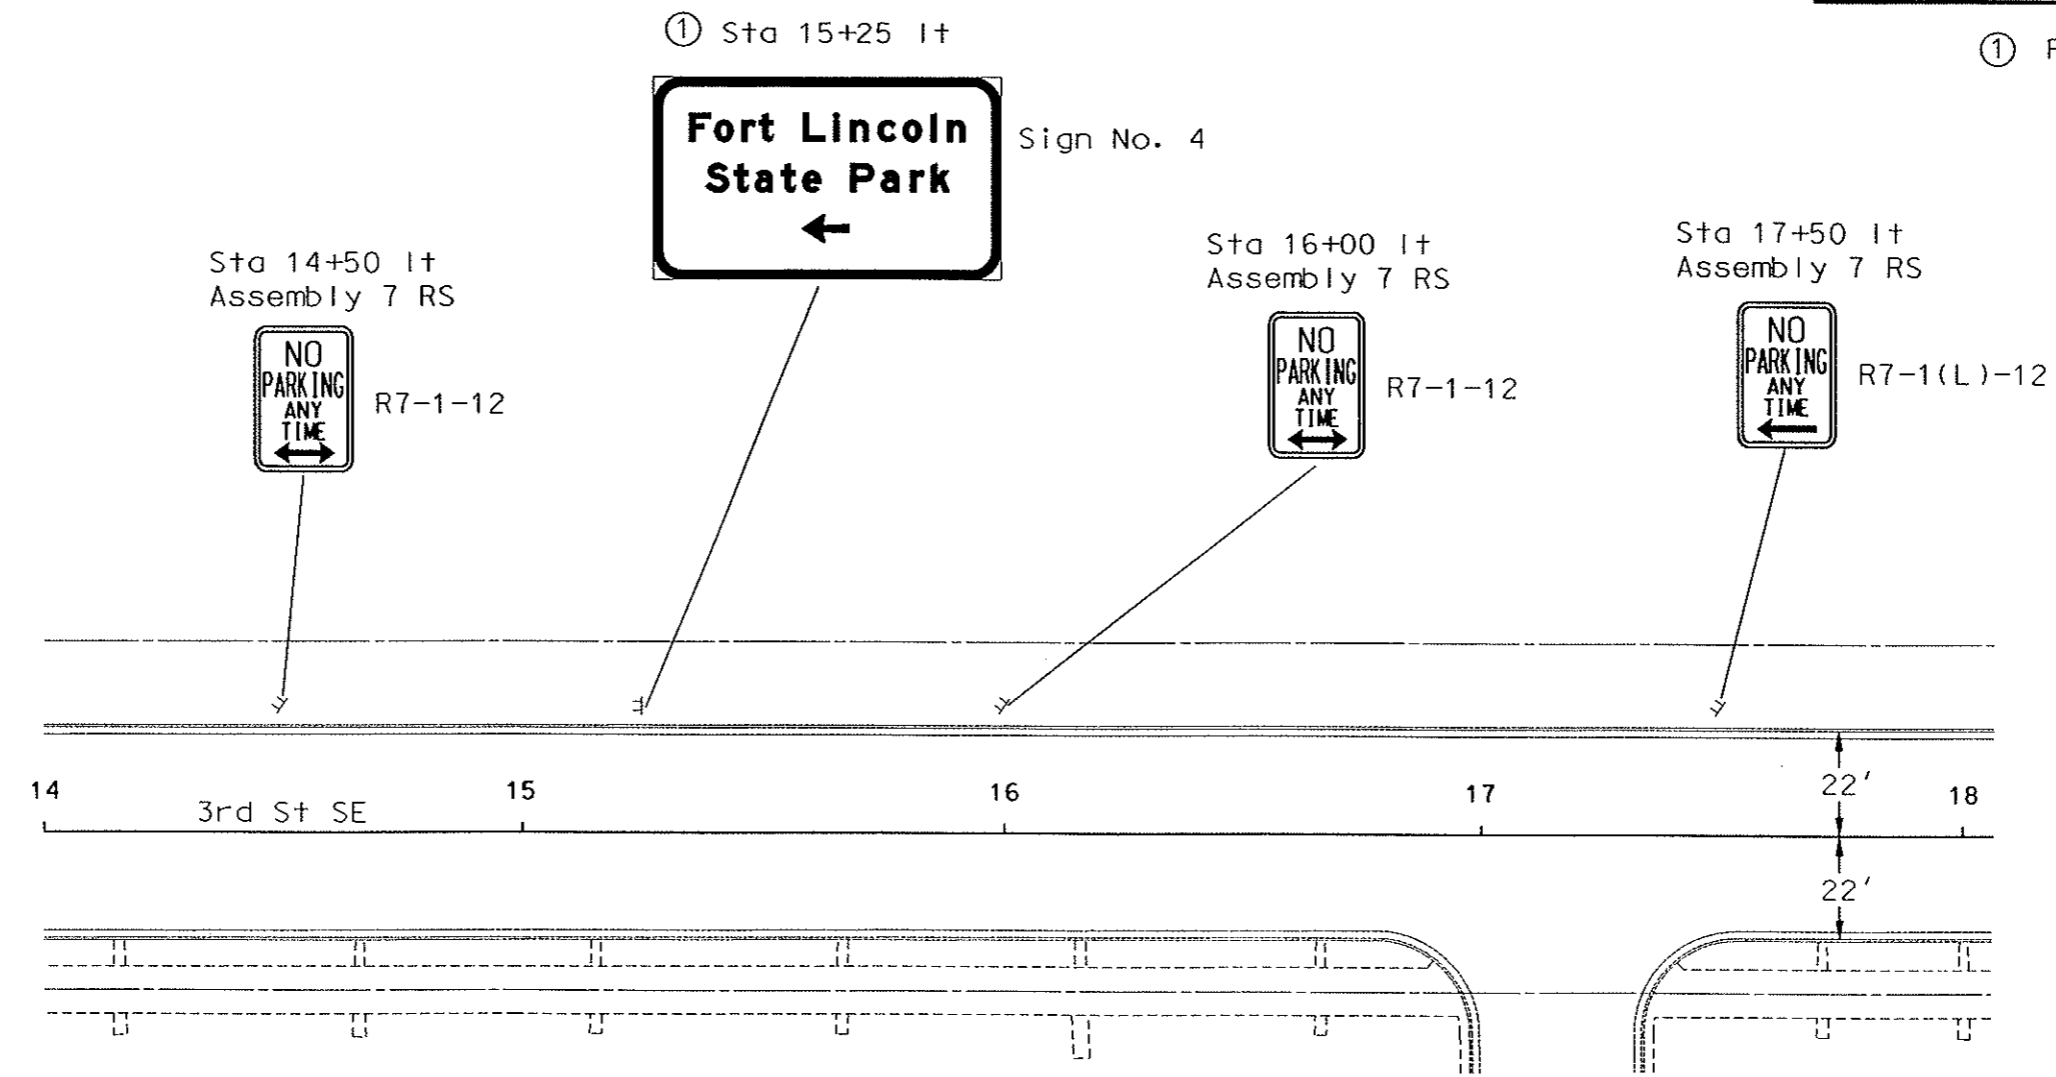

Signing layout

6th Av SE (ND 1806) &
3rd St SE

Mandan, ND