



FHWA REGION	STATE	PROJECT NO.	SHEET NO.
8	ND	HEU-1-806(032)069	17

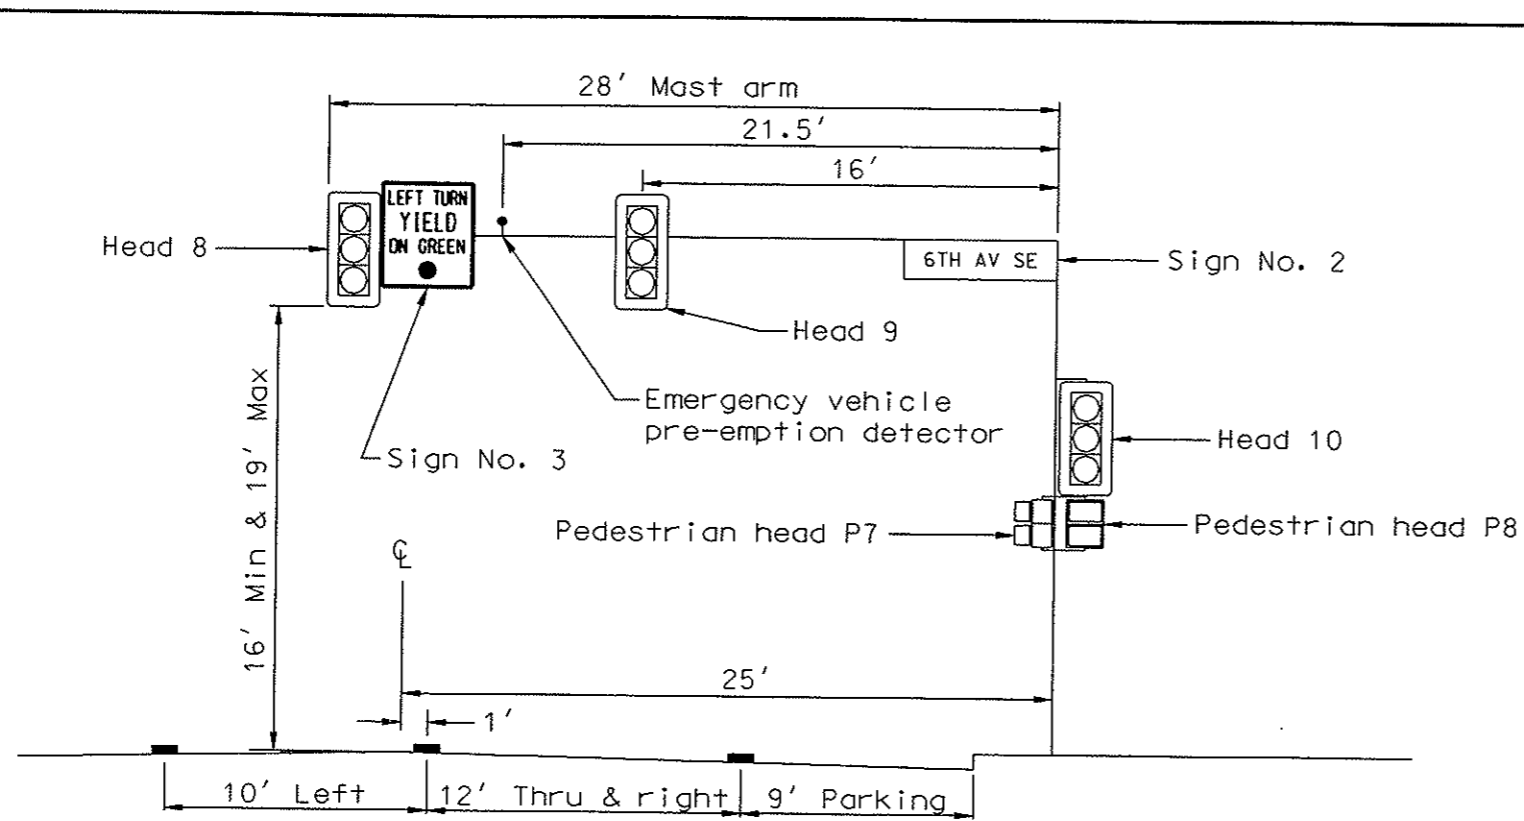

Sta 26+51-53' It
Eastbound, west approach
cross section

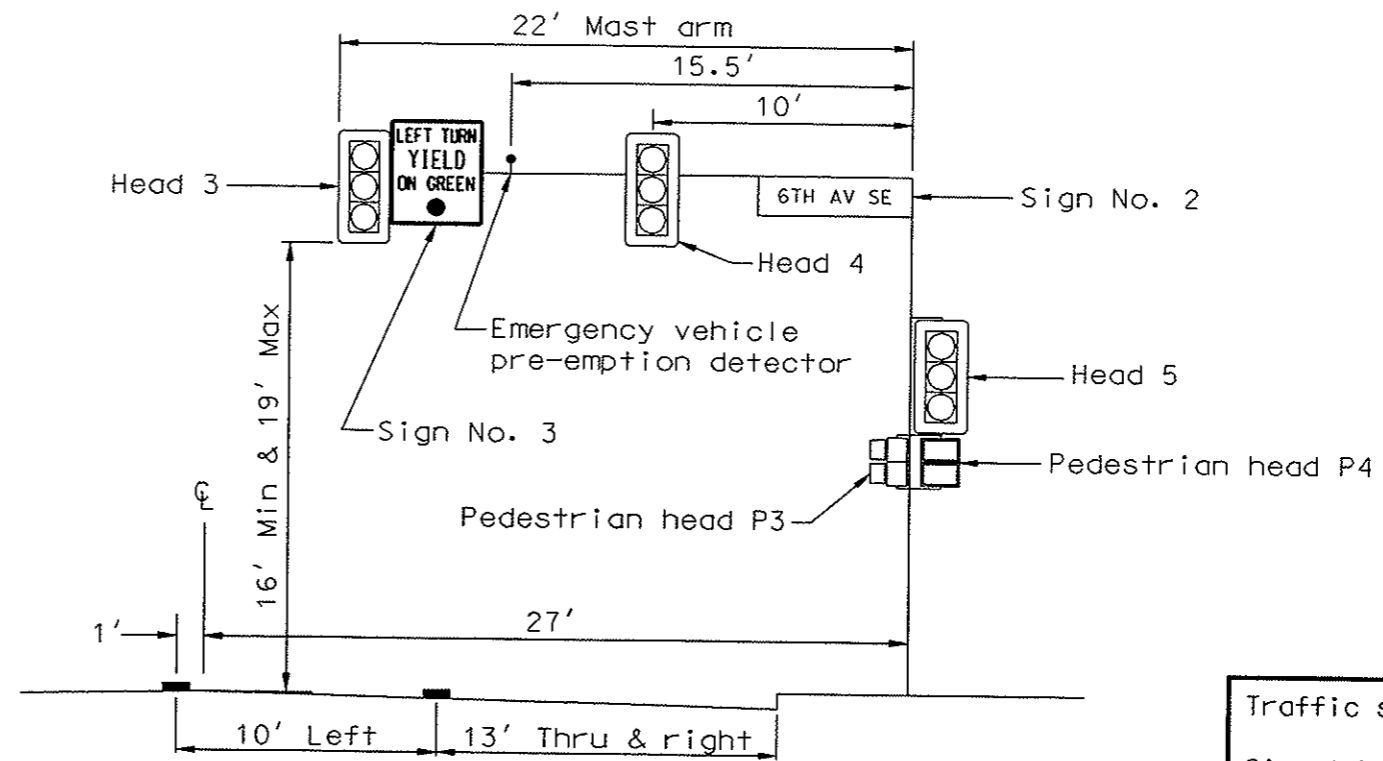

Sta 25+99-51' rt
Westbound, east approach
cross section

Traffic signals
Signal head & mast arm locations
6th Av SE (ND 1806) &
3rd St SE
Mandan, ND