


FHWA REGION	STATE	FED. AID PROJ. NO.	SHEET NO.
8	N.D.	RRS-1-006(005)066	85

① Revised 1-18-91

PULL BOX

732+70-28' Rt.	1 EA.
734+21-61' Rt.	1 EA.
734+60-42' Lt.	1 EA.
734+67-186' Lt.	1 EA.
735+37-24' Lt.	1 EA.
735+40-61' RT.	1 EA.
TOTAL	6 EA.

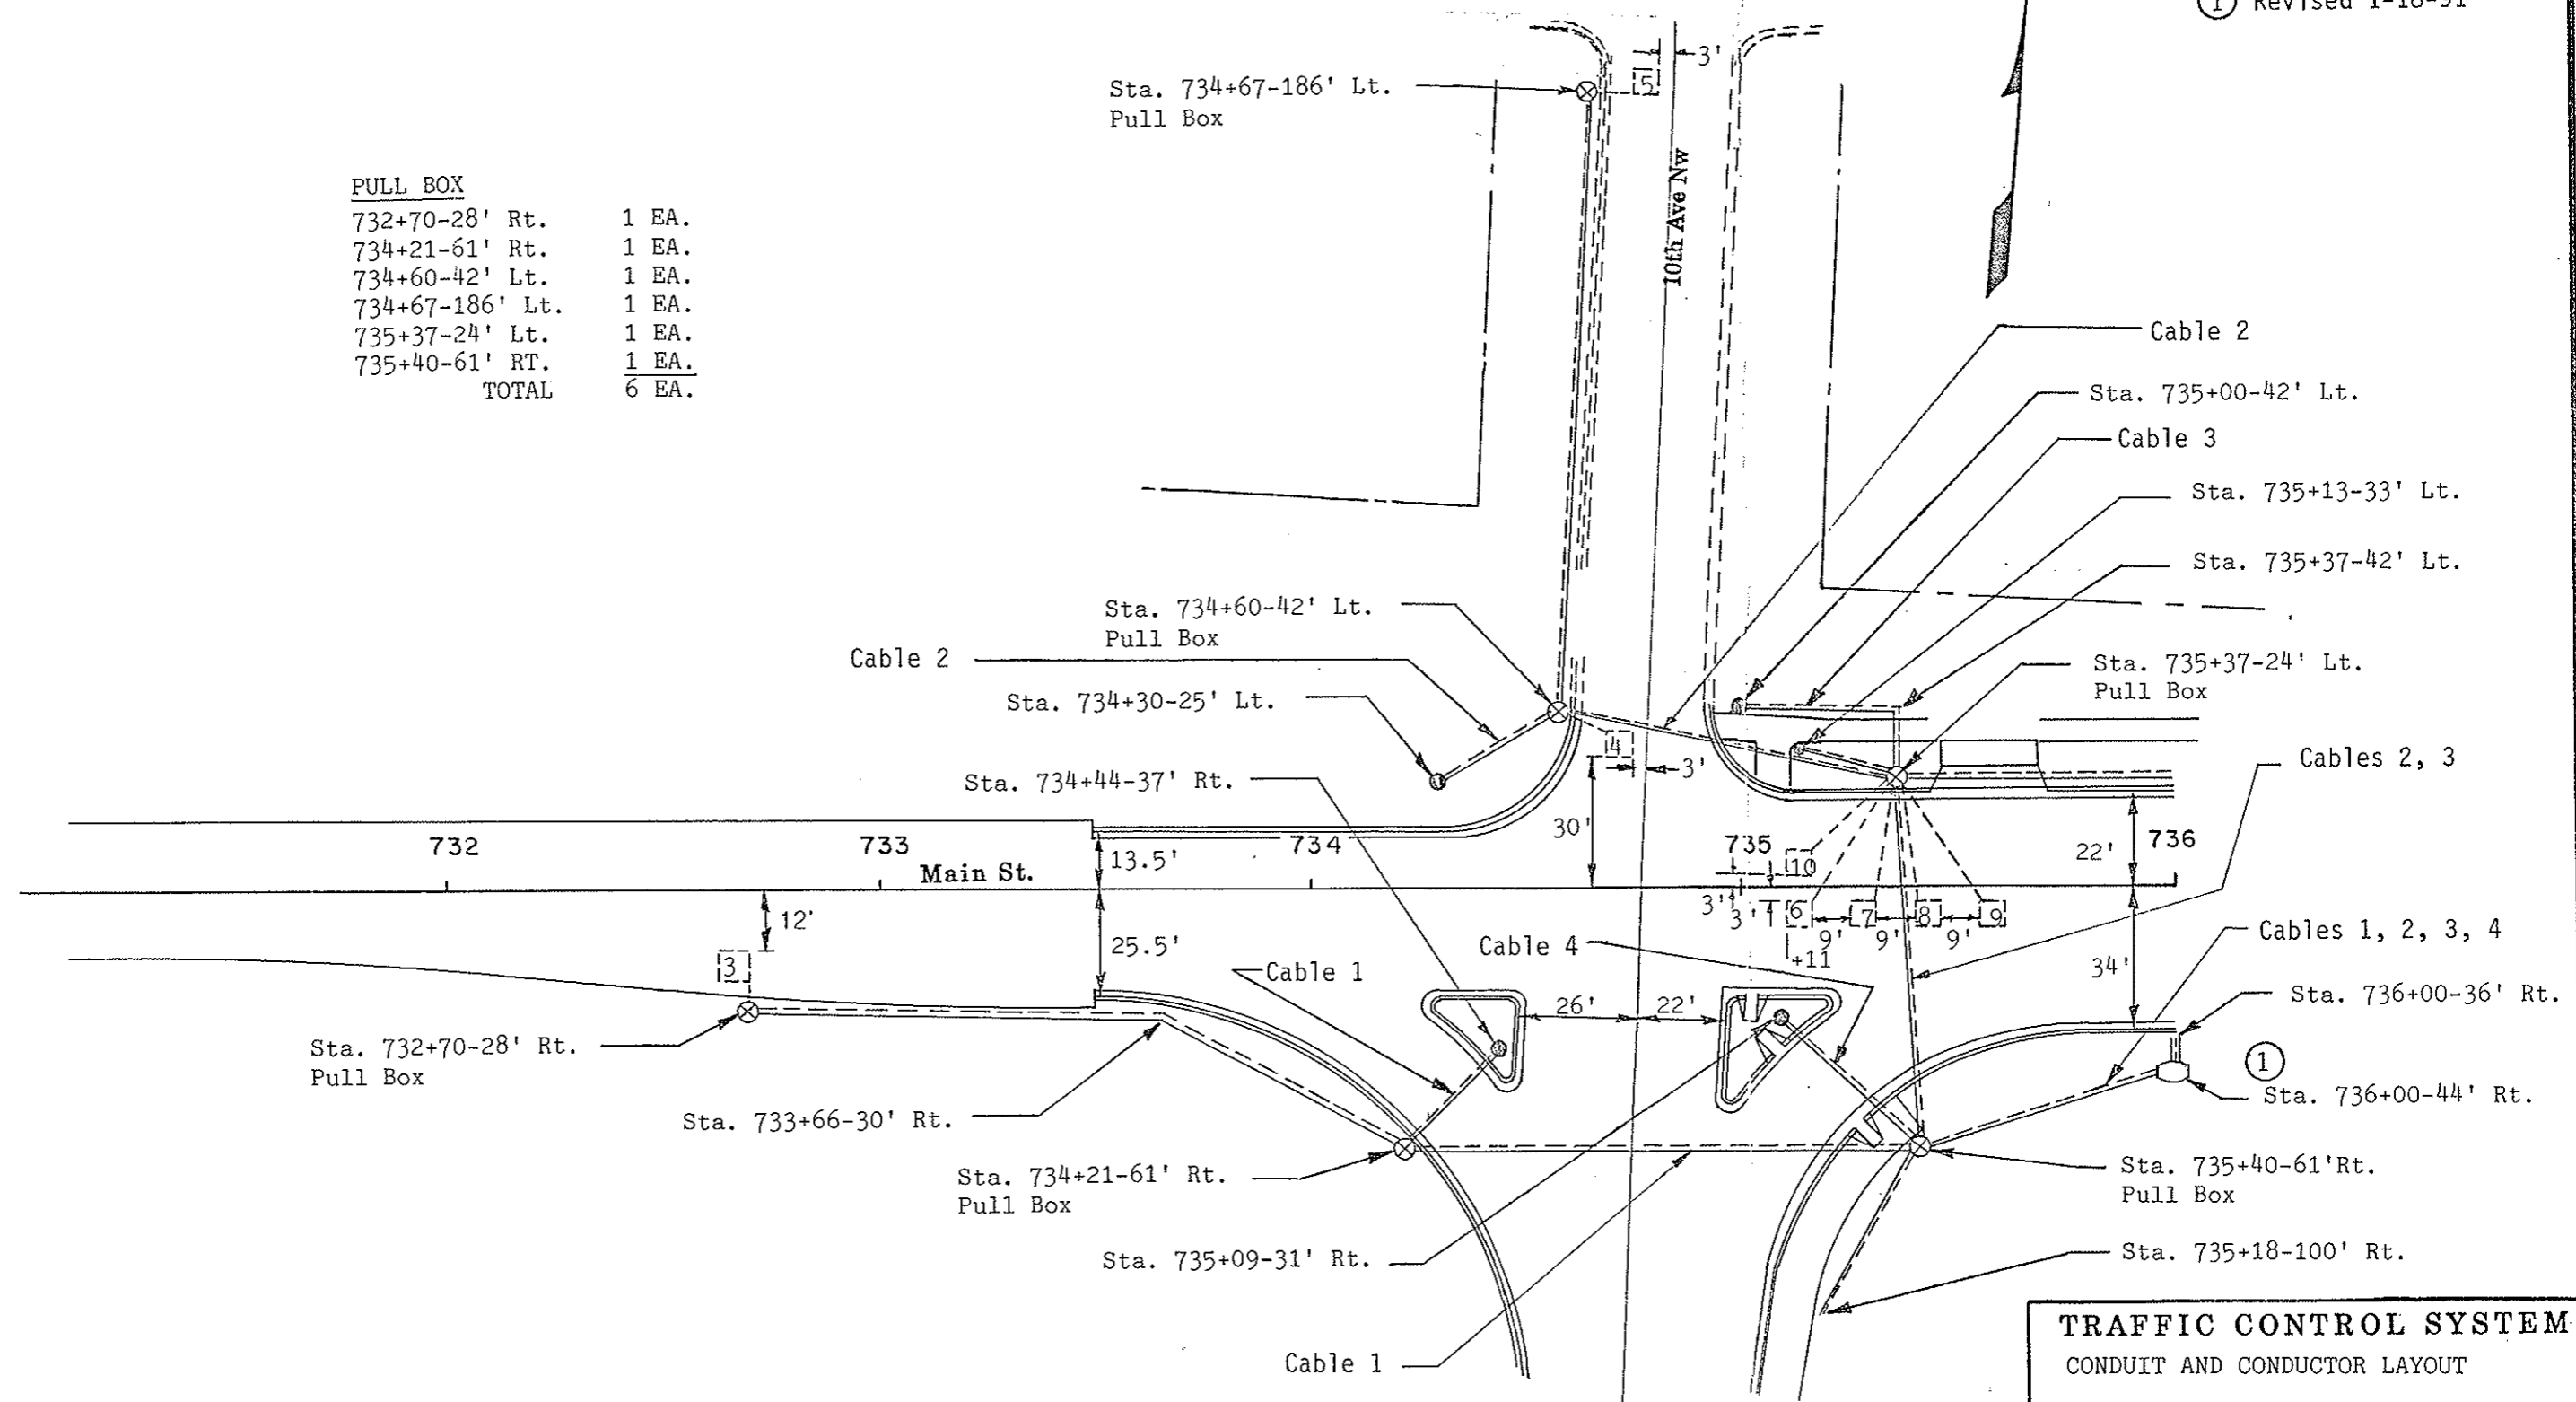

TRAFFIC CONTROL SYSTEM
CONDUIT AND CONDUCTOR LAYOUT

10th Ave SW (ND Hwy 6)
Mandan N.D.