

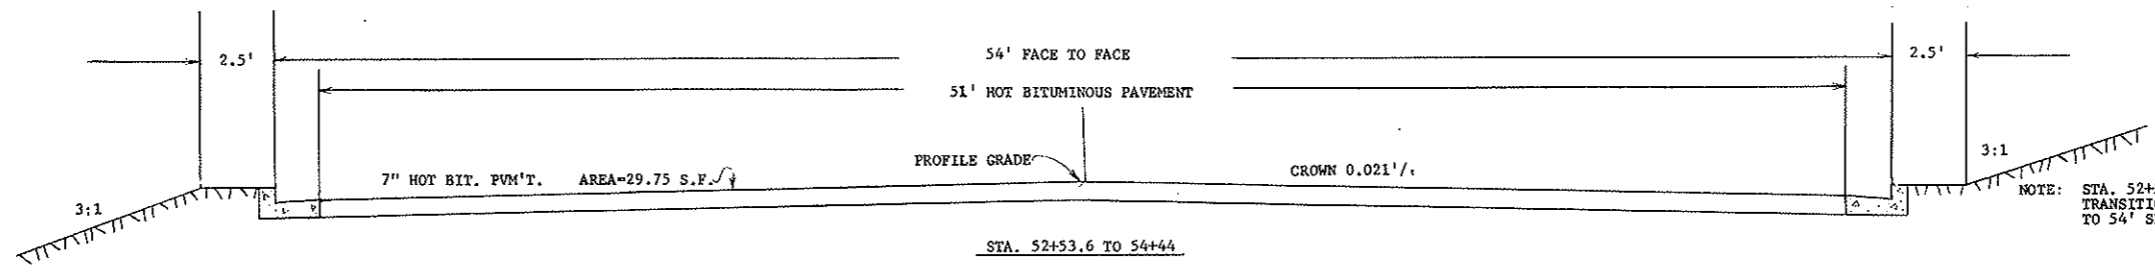
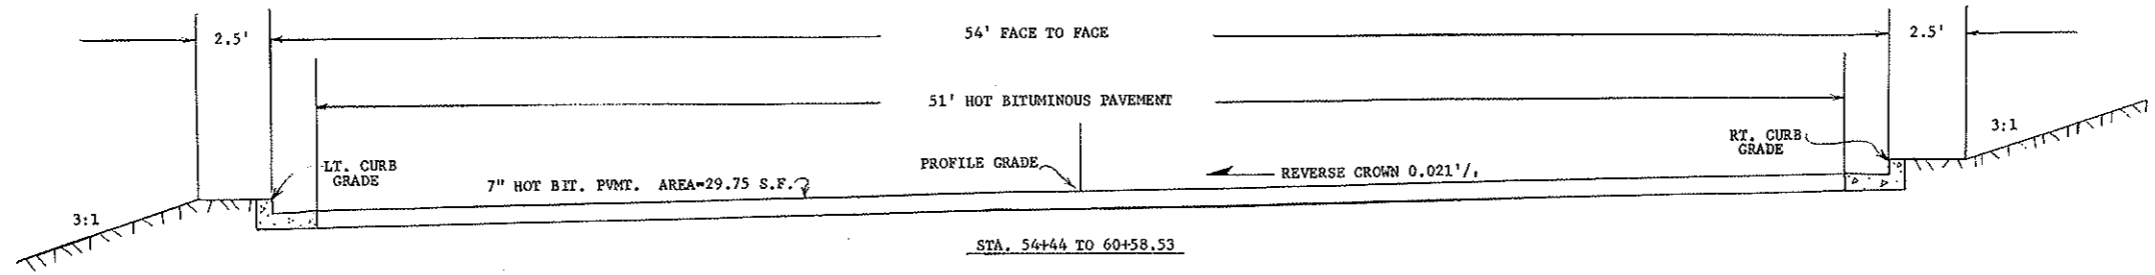



TYPICAL SECTIONS

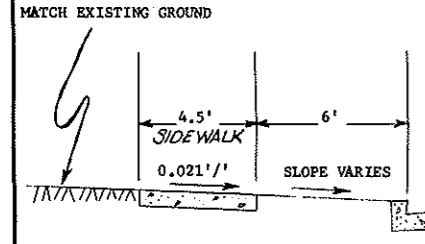

NOTE: STA. 52+53.6 TO 53+79
TRANSITION FROM 44' SECTION
TO 54' SECTION

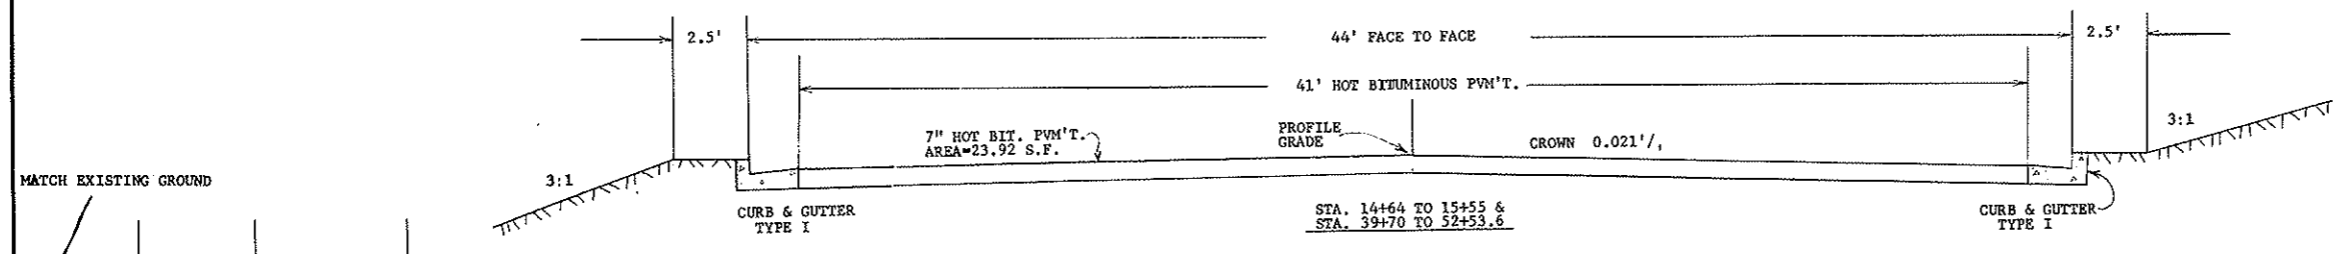


NOTE: SIDEWALK ON LEFT SIDE OF STREET FROM STA. 9+80 TO STA. 14+45

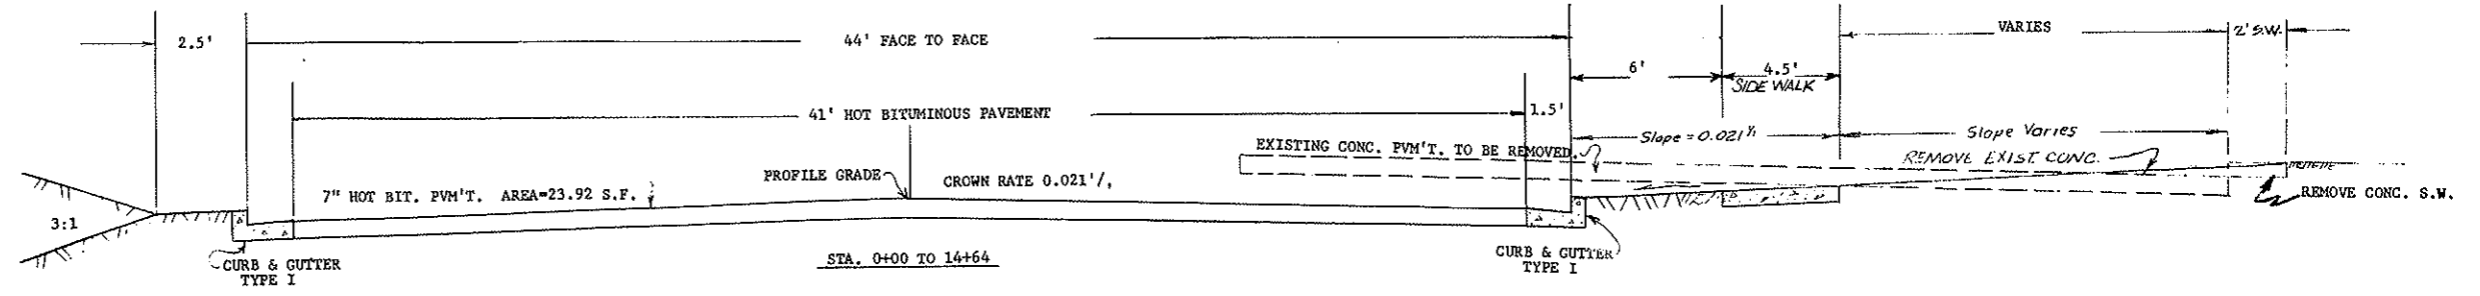


REMOVE CONC. S.W.

TYPICAL SECTIONS


FHWA REGION	STATE	FED. AID PROJ. NO.	SHEET NO.
8	N.D.	M-1-988(02)000	12

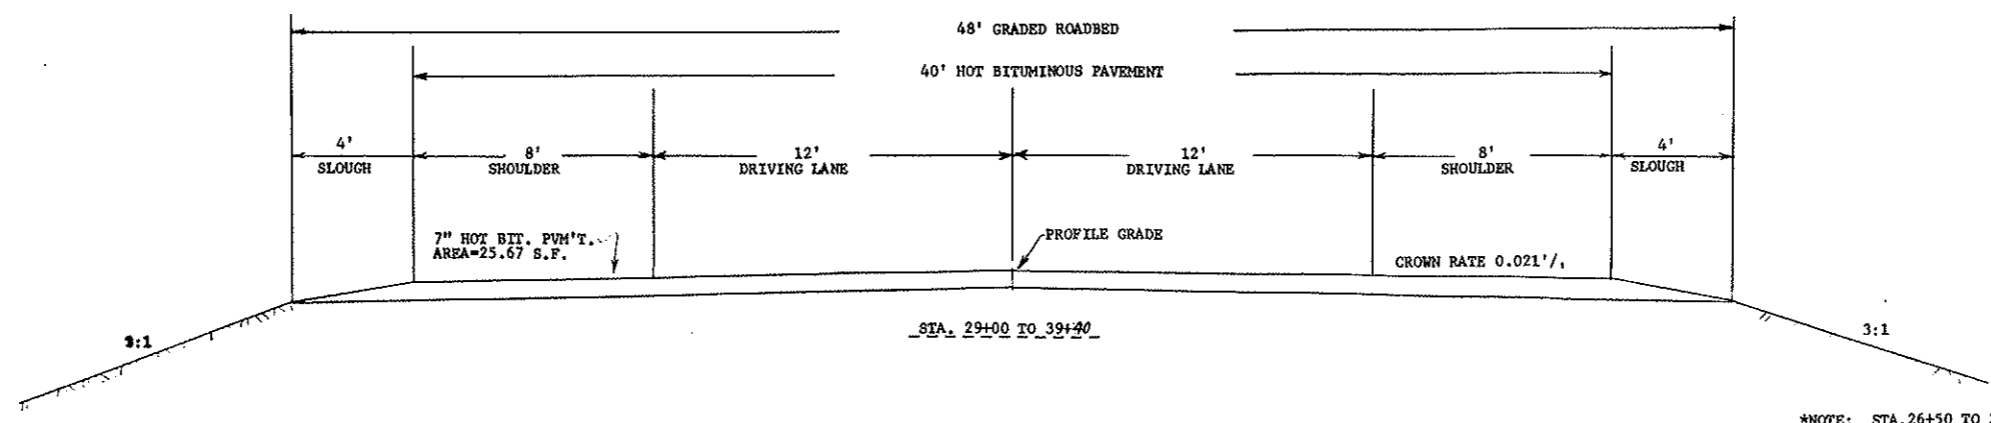


*NOTE: STA. 26+50 TO 26+75
TRANSITION BERM FROM 15' TO 0'.

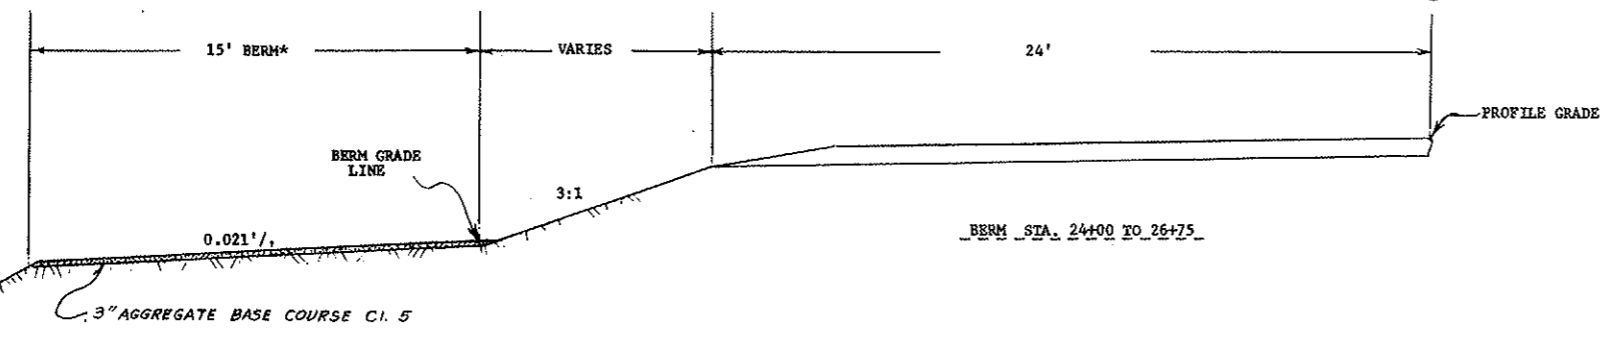

See cross-sections for slope rates

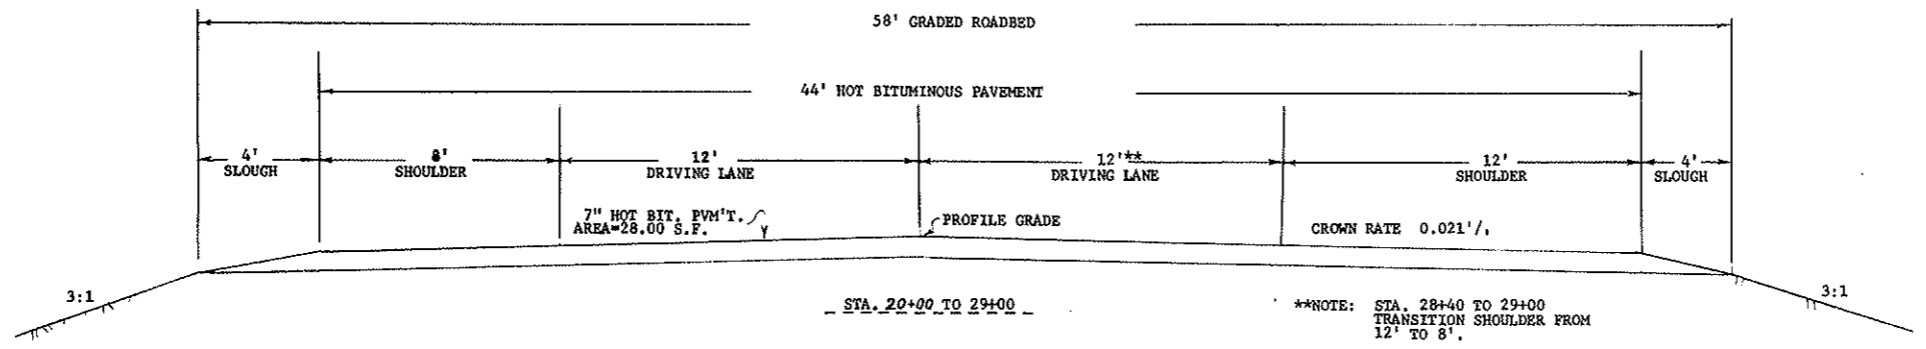

**NOTE: STA. 28+40 TO 29+00
TRANSITION SHOULDER FROM 12' TO 8'.

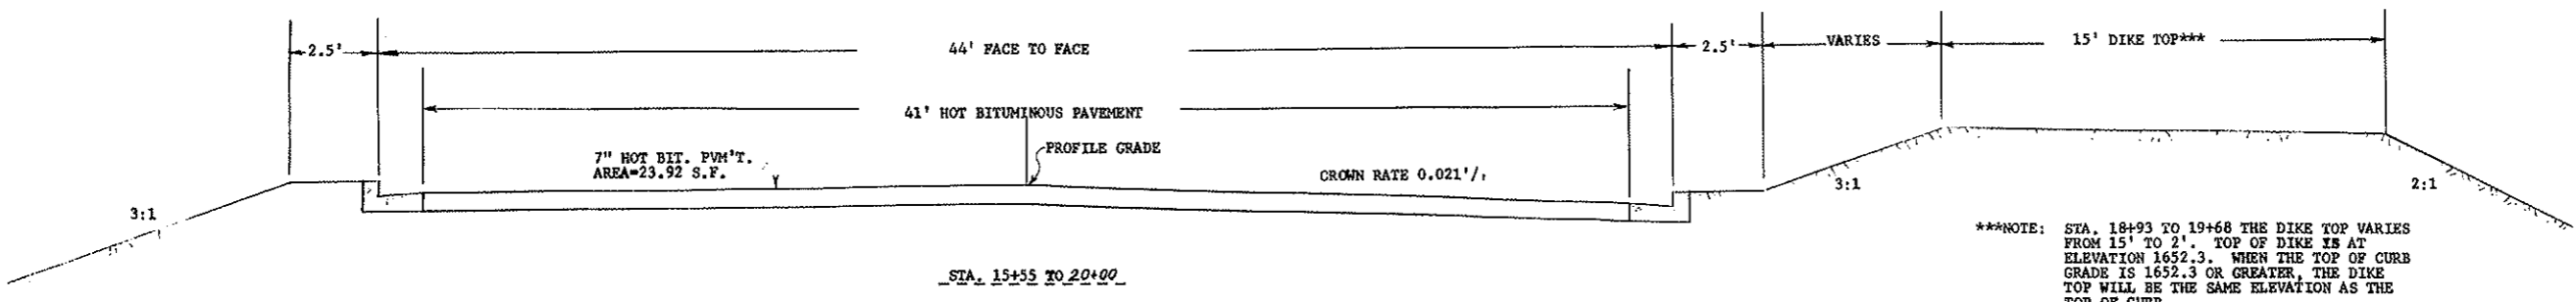

***NOTE: STA. 18+93 TO 19+58 THE DIKE TOP VARIES FROM 15' TO 2'. TOP OF DIKE IS AT ELEVATION 1652.3. WHEN THE TOP OF CURB GRADE IS 1652.3 OR GREATER, THE DIKE TOP WILL BE THE SAME ELEVATION AS THE TOP OF CURB.