


INSTALL PAVEMENT MARKINGS, DROP ON BEADS, TYPE II

Center Line 4" Yellow, 10' Line, 30' Skip 120 LF
 Barrier Line 4" Yellow 326 LF

FHWA REGION	STATE	FED. AID PROJ. NO.	SHEET NO.
8	N.D.	M-1-988(02)000	39



W10-1-36
 Assembly 63
 Warning Sign
 Sta. 38+40 Lt.

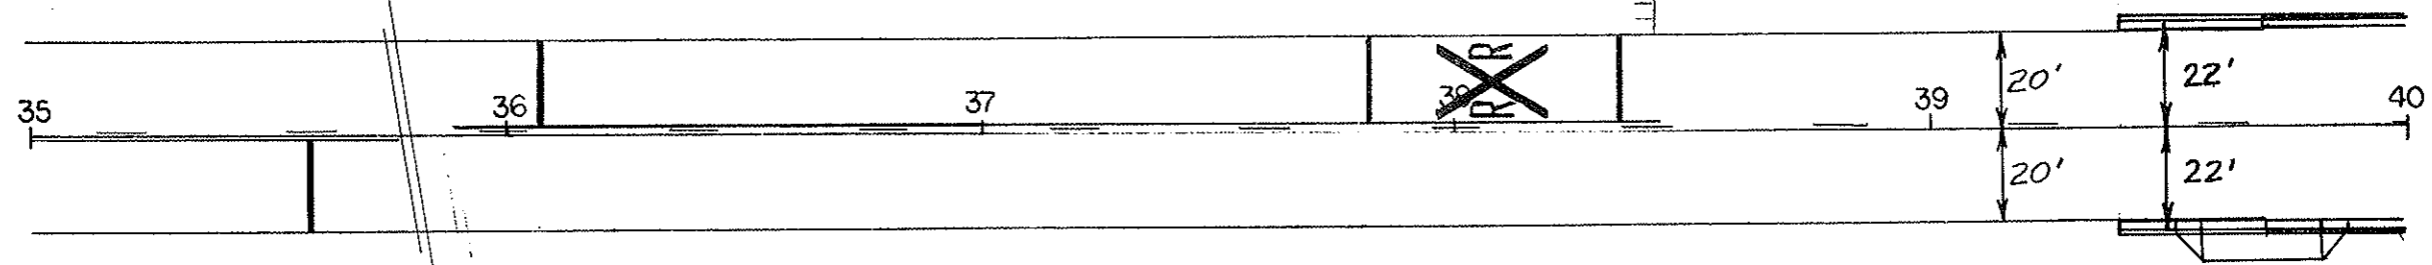

INSTALL CONFORMABLE PAVEMENT MKG. FILM (REFL.)-MESSAGES

R.R. Crossing & 2 R's 65 S.F.
 4 Bands 96 S.F.

B.N.R.R.

SIGNING LAYOUT

3rd St. S.E.
 Mandan, N.D.

FIG. 3


FHWA REGION	STATE	FED. AID PROJ. NO.	SHEET NO.
8	N.D.	M-1-988(02)000	4-a

INSTALL PAVEMENT MARKINGS, DROP ON BEADS, TYPE II

Center Line 4" Yellow - 10' Line, 30' Skip 120 LF



R1-1-30
 Assembly 1
 Reg. Sign
 Sta. 43+52 Lt.

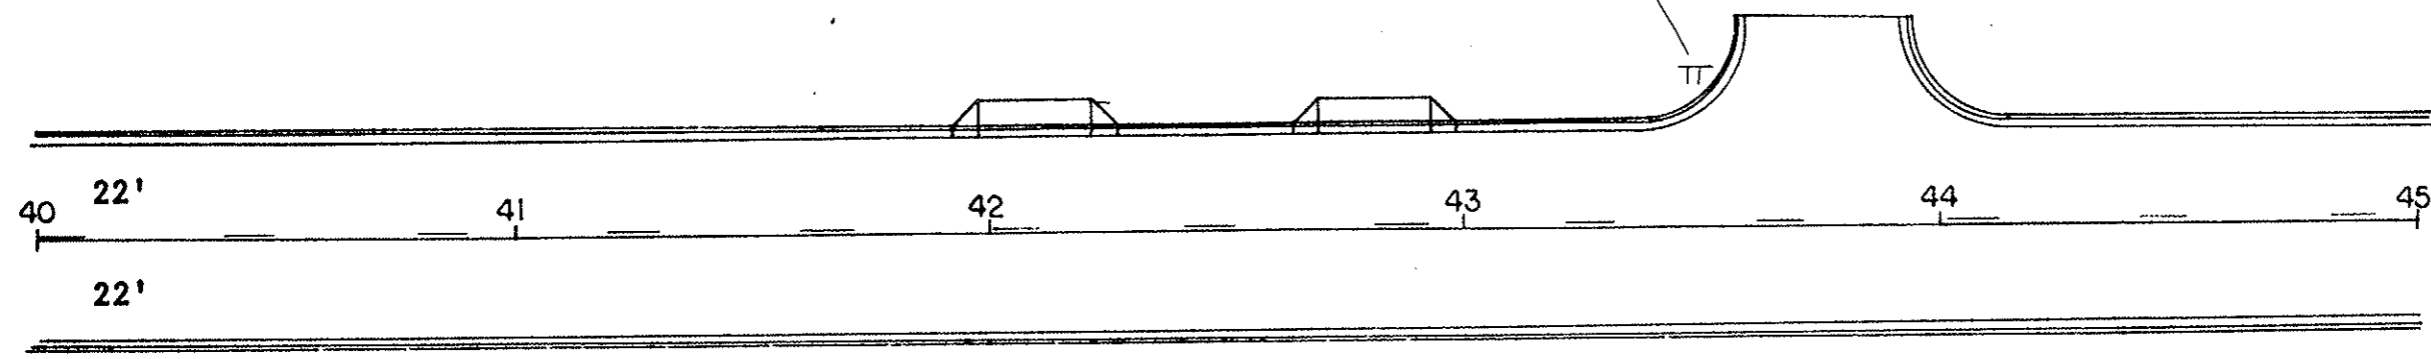

SIGNING LAYOUT

3rd St. S.E.
 Mandan, N.D.