

26

# NORTH DAKOTA STATE HIGHWAY DEPARTMENT

LENGTH OF PROJECT		
PROJECT	MILES-GROSS	MILES-NET
BRF-1-006(02)	0.217	0.217
TOTALS	0.217	0.217

**GOVERNING SPECIFICATIONS:**  
Standard Specifications adopted by the North Dakota State Highway Department, Oct. 1976, and approved by the Federal Highway Administration on December 17, 1976, and Supplemental Specifications thereto adopted July 1, 1983, and approved by the Federal Highway Administration and other Contract Provisions submitted herewith.





**SCALES**  
LAYOUT SHEET 1 IN. = 2000 FT.  
PLAN AND PROFILE DRAWINGS 1 IN. = 30 FT.  
STRUCTURAL DRAWINGS AS SHOWN  
CROSS SECTION SHEETS 1 IN. = 5 FT.

## PLANS FOR THE PROPOSED IMPROVEMENT OF A STATE HIGHWAY IN MORTON COUNTY FEDERAL AID PROJECT NO. BRF-1-006(02)066 GRADING, SURFACING, STRUCTURE & STRUCTURE REMOVAL

**DESIGN DATA**

TRAFFIC	AVERAGE DAILY	EST. BTH MAX. HR
CURRENT TRAFFIC (1983)	2275	PASS. 325 TRUCKS 2600 TOTAL 260
TRAFFIC FORECAST (2003)	5350	PASS. 650 TRUCKS 6000 TOTAL 600
DESIGN SPEED	40 MPH	
TRAFFIC CLASSIFICATION	M	
MINIMUM SIGHT DISTANCE (STOPPING)	275'	
MINIMUM SIGHT DISTANCE (SAFE PASSING)	5200'	
MINIMUM PASSING SIGHT DISTANCE FOR MARKING	1200'	
BRIDGE	STA 37+44	CLEAR ROWY WIDTH 40'+8" Sidewalk DESIGN LOADING HS 20

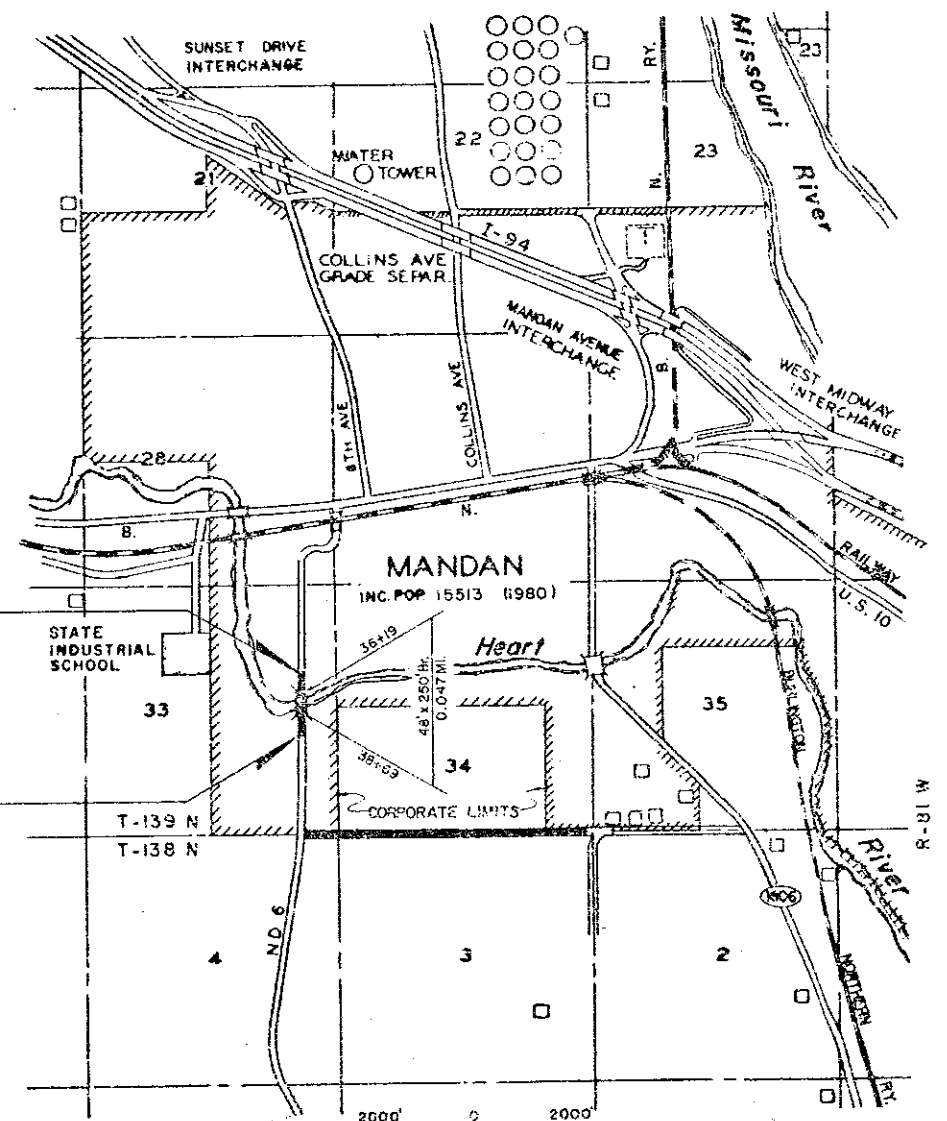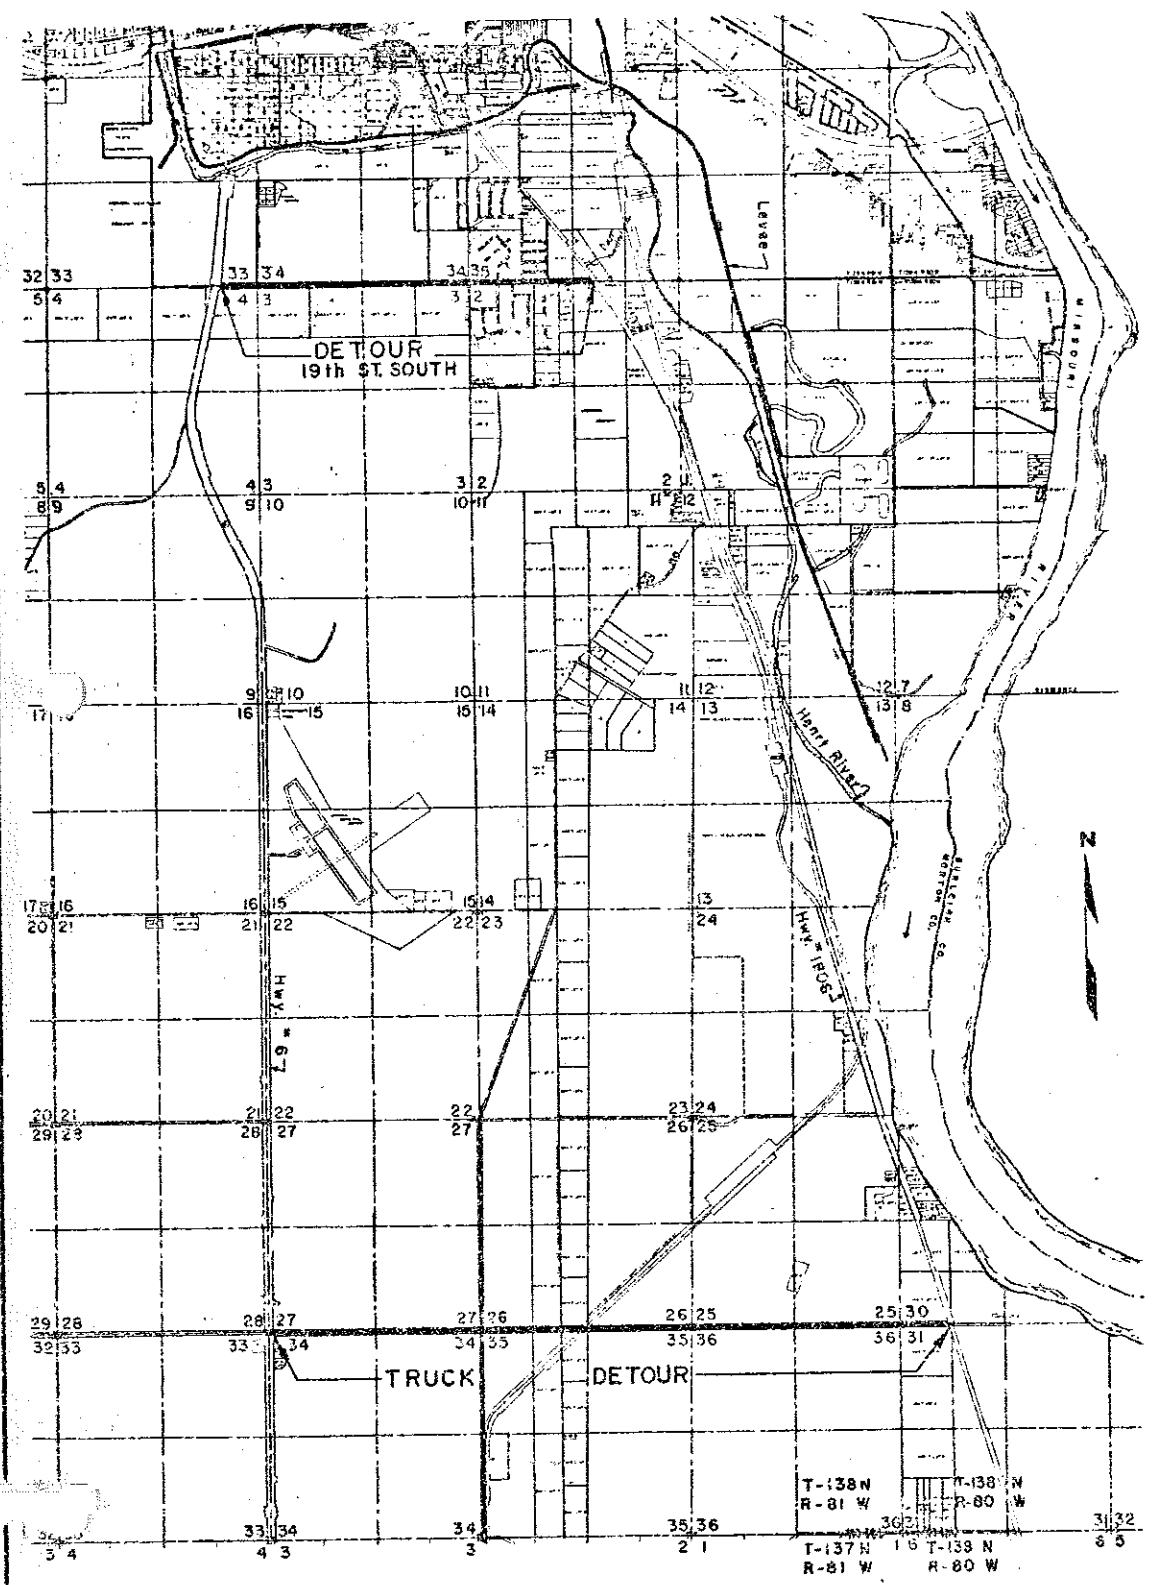

BEG. BRF-1-006(02)066 STA. 32+00=  
STA. 32+00 on F-251 (15)  
A point 719.62' West & 3383.2' North of the  
S.E. Cor. Sec. 33, T.139N., R. 81W.

END BRF-1-006(02)066 STA. 43+50  
STA. 43+50 on F-251 (15)  
A point 810.8' West & 2236.7' North of the  
S.E. Cor. Sec. 33, T.139N., R. 81W.

APPROVED	DATE
13	
CHIEF ENGINEER NORTH DAKOTA STATE HIGHWAY DEPARTMENT	

U.S. DEPARTMENT OF TRANSPORTATION FEDERAL HIGHWAY ADMINISTRATION	
APPROVED	DATE
DIVISION ENGINEER	DATE

TABLE OF CONTENTS

FHWA REGION	STATE	FED. AID PROJ. NO.	SHEET NO.
8	ND.	BRF-1-006(02)066	2

<u>SHEET NO.</u>	<u>DESCRIPTION</u>	<u>SHEET NO.</u>	<u>DESCRIPTION</u>
	<u>GENERAL</u>		<u>STANDARD DRAWINGS (CONT.)</u>
1	Title Sheet	39	D-722-1 W Beam Guardrail General Details
2	Table of Contents	40	D-722-2 Beam Guardrail - Flared End Treatment and Transition
3-5	General Notes, Basis of Estimate, & List of Special Provisions	41	D-722-3 Box Beam Guardrail at Bridge Ends (General Layout and Details)
6-8	Summary of Quantities	42	D-722-4 Box Beam Guardrail at Bridge Ends (Dimensions and Details)
9-10	Typical Sections and Details	43	D-722-5 Typical Grading at Bridge Ends
11	Curb Transition	44	D-722-16 Box Beam Guardrail at Bridge Ends Attachment Detail
12	Construction Signing	45	D-754-1 Construction Sign Details
13	Plan and Profile	46	D-754-2 Construction Sign Details
14-17	Beam Guardrail	47	D-754-3 Construction Sign Details
18	Bridge Layout	48	D-754-4 Construction Sign Details
19-21	Structural Notes	49	D-754-5 Barricade Details
22-34	Structural Drawings	50	D-754-5-A Construction Sign and Barricade Assembly Details
	<u>STANDARD DRAWINGS</u>	51	D-754-7 Construction Sign and Barricade Location Details
35	D-203-8 Section Line & Private Drive Approaches	52	D-754-9 Construction Sign and Barricade Location Details
36	D-630-4 Corrugated Steel Pipe Culverts and End Sections	53	D-754-11 Construction Sign and Barricade Location Details
37	D-708-1 Valley Gutter and Curb and Gutter	54-58	Cross Sections
38	D-720-1 Standard Right of Way Markers and Monuments	59-65	Signing

GENERAL NOTES

FHWA REGION	STATE	FED AID PROJ NO	SHEET NO
8	N.D.	BRF-1-006(02)066	3

- 100 GENERAL: The engineer will attend to the removal of existing  
011 fences to the highway right of way line and to the relocation  
or adjustment of utility facilities as shown on the plans.  
Equipment shall work around utility poles, within the  
area, that are not to be disturbed.
- 100 UNDERGROUND UTILITIES: The contractor shall notify the local  
030 utility companies prior to the beginning of construction, so they  
may stake location and depth of all utilities in the project  
area. Subcutting or scarifying over utility lines may be  
eliminated if, in the opinion of the engineer, a hazardous  
situation exists. Separate plans, if any, showing relocation or  
adjustment work to be performed by utility companies to  
accommodate highway construction will be made available to the  
contractor, upon request to the engineer.
- 100 PROJECT ENGINEER RESPONSIBILITY:  
050 (a) USC & G Bench Mark  
As soon as it has been determined that a bench mark must be  
moved, consult your Construction Survey Manual  
(Sec. 150-4.9), for the proper steps needed to preserve the  
bench mark.
- (b) All section corners must be monumented and a corner  
recording form must be filed with the County Register of  
Deeds. See Appendix G of the Preliminary Survey Manual for  
instructions on how to fill out the form.
- 100 DETOURS: The contractor shall maintain the streets used as  
060 detours (streets to be designated by the engineer) and repair  
areas damaged by the detoured traffic. Upon completion of the  
project, the contractor shall restore the streets to a condition  
at least equal to that which existed at the time traffic was  
routed over them. Work shall be as deemed necessary by the  
engineer. The repair and maintenance of the detours will be paid  
for in accordance with SP-532 "Haul Road Maintenance." Necessary  
route markers will be furnished by the State Highway Department  
and erected and maintained by the contractor as an incidental  
item.
- 100 CONCRETE PROTECTION: Adjacent concrete shall be protected during  
068 the application of all bituminous and asphalt materials to  
prevent any discoloration of the concrete. Failure to comply  
will result in the contractor having to clean the concrete at his  
own expense.
- 100 Excavate, if necessary, where the new surfacing meets existing  
120 pavement, bridge ends, or railroad crossings to allow placement  
of the full depth of the surfacing course. The excavation is not  
a pay item but shall be considered incidental to other items.
- 100 TREES, SHRUBS, AND NATIVE GRASSES: The contractor shall exercise  
130 care in his construction operations to ensure that trees,  
shrubs, and native grasses within the right of way and outside  
the construction area are disturbed as little as possible.
- 100 The contractor will be required to conduct the construction  
133 activities in such a manner as to comply with the Air Pollution  
Control Regulations of the state of North Dakota. Water will be  
used to control dust on the construction site.
- 100 HISTORICAL INFORMATION: If any scientific or historical  
140 information is encountered after construction is in progress, the  
Highway Department will immediately notify the Historical  
Society, and efforts will be made to protect the material until  
it has been examined by an archaeologist from the Historical  
Society. If future activities should result in the discovery of  
any cultural resources that are eligible for inclusion in the  
National Register of Historical Places, this will require  
compliance with Section 106 of the National Historic Preservation  
Act of 1966 and the Advisory Council on Historic Preservation  
"Procedures for the Protection of Historic and Cultural  
Properties" (36, CFR, Part 800).
- 100 UTILITY POLES: Equipment shall work around utility poles within  
160 the construction area that are not to be disturbed.
- 100 POLE LINES: Pole lines (power, telephone, etc.) interfering with  
161 construction of this project shall be removed or relocated by the  
utility companies.
- 200 SHRINKAGE: 25 percent additional volume in yardage computed by  
010 the end area method is allowed for shrinkage in earth embankment.
- 200 COMPACTION AND DENSITY CONTROL: Compaction and density controls  
021 shall be in accordance with Section 203-2.3.3 of the Standard  
Specifications, except that, if the subgrade is unstable (as  
evidenced by sponginess or rutting) when compacted to the  
required density, it will be necessary to dry the soils to obtain  
adequate stability. This may require drying below optimum  
moisture. The cost of such drying will be incidental to the  
price bid for "Common Excavation" (and/or "Borrow," if used).
- 200 INTERCEPTING DITCH: Intercepting ditches shall be constructed  
290 wherever considered necessary by the engineer.
- 200 WASTE EXCAVATION DISPOSAL: Disposal sites selected by the  
250 contractor shall be approved by the engineer. Disposal in  
wetland areas will not be approved.

GENERAL NOTES

FHWA REGION	STATE	FED. AID PROJ. NO.	SHEET NO.
8	N.D.	BRS-1-006(02)066	4

300 020 AGGREGATE BASE COURSE: The Class 11 material (clay binder) shall be weighed and paid for by the ton prior to blending this material with the aggregate base material at the plant site. No deduction in weight will be made for the Class 11 material at the time of weighing the aggregate base (Class 8) material for payment. The Class 11 material can be omitted by the Engineer if not required.

400 010 PRIME, FOG, OR TACK COAT: When directed by the engineer, emulsified asphalt for prime, fog, or tack coat shall be diluted with water prior to application in a 50-50 ratio or other approved proportions. Cost of water shall be included in the price bid for "Emulsified Asphalt for Prime, Fog, or Tack Coat."

400 028 HOT BITUMINOUS PAVEMENT: The contractor's operations shall be such that no segregation of the aggregate or hot mixed materials will occur. Any hot mix placed on road which has segregated shall be removed and replaced, with approved material, at the contractor's expense.

400 040 HOT BITUMINOUS PAVEMENT: The temperature of the mix at laydown shall not be less than 225°F, if the air temperature is above 60°F, and shall not be less than 240°F if the air temperature is below 60°F. The actual mixing temperature shall be adjusted as directed by the engineer within the allowable limitations to best suit construction conditions.

400 070 DIMENSIONS: Thicknesses shown on the typical sections for surfacing are approximate. It is intended that the plan tonnages provided for by the basis of estimate will be used uniformly throughout the project unless otherwise authorized by the engineer.

400 120 COMPACTION OF HOT BITUMINOUS PAVEMENT: The compaction equipment for mainline paving shall include not less than one approved steel roller or approved vibratory roller and one approved pneumatic tired roller. The specified density shall be obtained before the mat temperature drops below 170°F. The maximum speed of vibratory roller in the vibratory mode shall be 3 mph. The speed of nonvibratory rollers and vibratory rollers in the static mode shall not exceed 4 mph during initial and intermediate rolling prior to obtaining the required density.

406 014 BITUMINOUS PAVEMENT SLOUGHS: Bituminous pavement sloughs shall be compacted with rollers capable of providing a smooth finished compacted slough that is free of tire marks and unevenness or dropoff. No density tests will be required.

406 016 HOT BITUMINOUS PAVEMENT: The moisture of the hot bituminous pavement mixture shall not exceed 2 percent.

708 030 CLASS OF CONCRETE: The class of concrete used in the curb and gutter, sidewalks, and driveways shall be Class AE. The contractor shall have the option of using aggregate, Size No. 1, 3, 4, or 5 as defined in Section 806-2 of the Standard Specifications.

756 010 FIELD LABORATORY: If deemed unnecessary by the engineer in the field, the item "Field Laboratory" shall be deleted.

CURB ENDS: Where the new curb and gutter ends, the end four (4) feet of the curb shall be tapered from 10" in height to 0". A 1/2" premolded expansion joint which is full depth and the same shape as the curb and gutter shall be installed just ahead of the taper. An 18" tie bar shall be installed across the joint.

TOPSOIL: 4" of topsoil shall be placed on all areas to be seeded or sodded.

REMOVE 4 CABLE GUARDRAIL AND POSTS: The lengths of 4 cable guardrail shown on the plan to be removed shall have the cable, posts, and end anchors removed. The removed cable, posts, and hardware shall be stockpiled on the right of way in the location designated by the engineer. The stockpiled material shall remain the property of the state. If, in the opinion of the engineer, the concrete end anchors and anchor rod will not interfere with the construction, they may be cut off 1' (one foot) below ground line and surface restored to match the surrounding area. Cost of removing and stockpiling the 4 cable guardrail, posts, and hardware shall be included in the price bid for item; "Remove 4 Cable Guardrail and Posts."

WORK SCHEDULE: The North Dakota State Game and Fish Department (G&F) will monitor the stream to determine water quality conditions both prior to and during construction. The purpose of the monitoring is to determine the effect that construction activities will have on fish spawning. The Contractor must give the Department a minimum of 21 days notice prior to commencing construction. The Department will inform the G&F Department so they can commence monitoring activities. The Contractor will not perform any construction activities that will affect the stream during this 21 day period.

EXISTING SURFACING: The contractor shall have the option of salvaging the existing surfacing for his own use. Should the contractor salvage the existing surfacing and the dirt run is short, he shall replace this material with an equal amount of excavation at his own expense.



GENERAL NOTES

If the contractor desires to haul across bridge, he will be limited to 60 Ton Gross vehicle with maximum of 30 ton on single axle. Single vehicle on the structure at one time. Approaches maintained to avoid bouncing of vehicle going onto the bridge. Concrete shall obtain a strength of 4000 psi before use.

LOAD LIMITATIONS: The city of Mandan will be posting 19th Street South to limit the vehicular weight thereon, to a maximum of 12,000 pounds per axle (No. 2 Load Restriction).

SEEDING: The following seed mixture will be used on this project.

<u>Percent Pure Live Seed by Weight</u>	<u>Species</u>	<u>Minimum Percent Pure Live Seed (PLS)</u>
32	Western Wheatgrass (Rosanna)	70
26	Thickspike Wheatgrass (Critana)	80
18	Green Needlegrass (Lodorm)	70
14	Little Bluestem (Blaze)	60
10	Switchgrass (NDG-98)	75

The amount of pure live seed to be applied per acre shall be 18 pounds.

SPECIAL PROVISIONS

<u>SEQ. NO.</u>	<u>NAME</u>	<u>SP NO.</u>
272	Fuel Cost Adjustment	SP 272
512	Bidding Requirements and Conditions	SP 102-18
532	Haul Road Maintenance	
000	Training Special Provision	

BASIS OF ESTIMATE

WATER FOR COMPACTION: 10 Gal. per C.Y. of Embankment.  
20 Gal. per Ton of Aggregate Base Coarse

SEEDING: Entire right of way except roadbed, sidewalk, and sodded areas.

AGGREGATE BASE COARSE: Class 8 = 1.5 Ton/C.Y. +25%  
Class 11 = 10% of Class 8

S U M M A R Y   O F   Q U A N T I T I E S

FHWA REGION	STATE	FED. AID PROJ. NO.	SHEET NO.
8	ND.	BRF-1-006(02)066	6

<u>SPEC</u>	<u>CODE</u>	<u>ITEM DESCRIPTION</u>	<u>UNIT</u>	<u>TOTAL</u>
103	0100	Contract Bond	L. Sum	1
202	0105	Removal of Structure	L. Sum	1
203	0101	Common Excavation - Type A	Cu. Yd.	17,828
204	0100	Average Haul (not a pay item)	Cu. Yd. Sta.	6,711 2.67
208	0100	Class 1 Excavation	Cu. Yd.	180
208	0110	Class 2 Excavation	Cu. Yd.	300
208	0120	Class 3 Excavation	Cu. Yd.	5,820
208	0200	Foundation Preparation	L. Sum	1
216	0100	Water	M. Gal.	84
228	0100	Select Backfill	Cu. Yd.	450
302	0135	Aggregate Base Course Cl. 8	Ton	60
302	0150	Aggregate Base Course Cl. 11	Ton	6
401	0152	SS-1h or CSS-1h Emulsified Asphalt	Gal.	1,095
406	0185	Hot Bituminous Pavement Class 24	Ton	1,984
406	0320	120-150 Asphalt Cement	Ton	143
602	0130	Class AAE-3 Concrete	Cu. Yd.	552.3
602	1110	Class AE-1 Concrete	Cu. Yd.	331.1
602	7000	Special Surface Finish	Sq. Ft.	4,220
612	0115	Reinforcing Steel - Grade 60	Lb.	83,908
612	0116	Reinforcing Steel - Grade 60 (Epoxy Coated)	Lb.	72,575
616	5890	Structural Steel	L. Sum	1
622	0020	Steel Piling HP 10 x 42	L. Ft.	840
622	0040	Steel Piling HP 12 x 53	L. Ft.	1,350

S U M M A R Y   O F   Q U A N T I T I E S

FHWA REGION	STATE	FED. AID PROJ. NO.	SHEET NO.
8	N.D.	BRF-1-006(02)066	7

<u>SPEC</u>	<u>CODE</u>	<u>ITEM DESCRIPTION</u>	<u>UNIT</u>	<u>TOTAL</u>
622	0393	Steel Test Piling HP 10 x 42	L. Ft.	160
622	1200	Steel Test Piling HP 12 x 53	L. Ft.	110
624	0124	Pedestrian Fence	L. Ft.	329
630	0085	24 In. Corrugated Steel Pipe .064 in.	L. Ft.	52
630	0485	24 In. Corr. Steel End Section .064 in.	Ea.	2
702	0130	Loose Rock Riprap	Cu. Yd.	2,100
703	0100	Aggregate Cushion	Cu. Yd.	520
705	0100	Mobilization	L. Sum	1
708	0098	Curb Transition	Ea.	2
708	0301	Curb & Gutter Type I (Sec. B)	L. Ft.	90
712	0100	Concrete Sidewalk	Sq. Yd.	57
720	0110	Right of Way Markers	Ea.	7
722	0118	Box Beam Guardrail	L. Ft.	183
722	0600	Box Beam Guardrail - Flared End Treatment & Transition	Ea.	2
722	2040	Remove 4-Cable Guardrail & Posts	L. Ft.	60
726	0241	Seeding, Type C, Class V	Acre	4
726	0244	Seeding, Type C, Class VII	Acre	4
728	0100	Sodding	Sq. Yd.	2,376
*743	0102	Pvmt. Mkg. Drop on Beads - Type II (Line)	L. Ft.	2,878
746	0100	Flagging	M. Hr.	100
750	0100	Linseed Oil Treatment	Gal.	28
*754	0116	Flat Sheet for Signs-Type II Refl. Shtng.	Sq. Ft.	10
*754	0117	Flat Sheet for Signs-Type III & IV Refl. Sht.	Sq. Ft.	5


\* Not a pay item. To be done by state forces.

S U M M A R Y   O F   Q U A N T I T I E S


FHWA REGION	STATE	FED. AID PROJ. NO.	SHEET NO.
8	ND.	BRF-1-006(02)066	8

<u>SPEC</u>	<u>CODE</u>	<u>ITEM DESCRIPTION</u>	<u>UNIT</u>	<u>TOTAL</u>
756	0100	Field Laboratory - Type A	Ea.	1
762	3298	Traffic Control	L. Sum	1
772	0100	Wood Excelsior Fibermat	S.Y.	3,000
900	3000	Bridge Bench Marks	Set	1
900	8505	Trainee	M.Hr.	1,000

TYPICAL SECTIONS & DETAILS

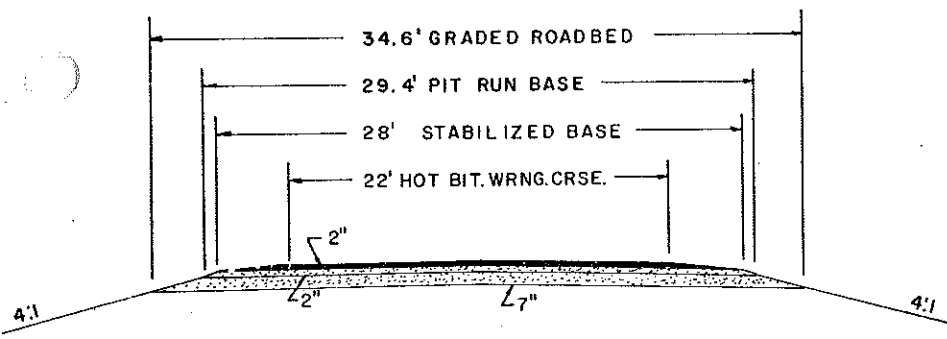


EXISTING TYPICAL SECTION HWY. #6

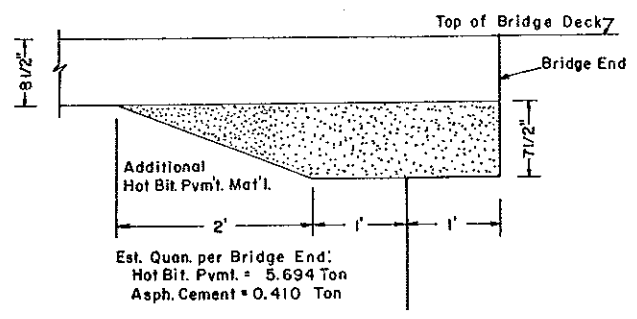

BITUMINOUS SURFACING DETAIL AT BRIDGE ENDS


CURB & GUTTER SECTION		50' GRADED SECTION		BASIS OF ESTIMATE			
QUANTITY PER STA.	WIDTH	QUANTITY PER STA.	WIDTH	QUANTITY PER SY.	DEPTH	UNIT	DESCRIPTION
0.473		0.473				"M" GAL.	Water for Dust Palliative 25 "M" Gal./ Mi.
88.58	41	105.43	47.6	0.19444	3 1/2"	TON	Hot Bituminous Pavement (Base Course) @ 2.0 Ton / C.Y. Class 24
6.38		7.59		0.01400		TON	120-150 Asphalt Cement for Hot Bit. Pavement @ 7.2 % Hot Bit.
22.78	41	26.44	47.6	0.05		GAL.	SS-1H or CSS-1H Emuls. Asphalt for Tack Coat @ 0.05 Gal./S.Y.
75.92	41	86.11	45.4	0.16667	3"	TON	Hot Bituminous Pvm't. (Base Crse.) @ 2.0 Ton / C.Y. Class 24
5.47		6.20		0.01200		TON	120-150 Asphalt Cement for Hot Bit. Pvm't. @ 7.2 % Hot Bit. Pvm't.
22.78	41	25.22	45.4	0.05		GAL.	SS-1H or CSS-1H Asphalt for Tack Coat @ 0.05 Gal./S.Y.
50.62	41	55.18	44.0	0.11111	2"	TON	Hot Bit. Pavement (Surf. Crse.) @ 2.0 Ton / C.Y. Class 24
3.64		3.97		0.00800		TON	120-150 Asphalt Cement for Hot Bit. Pvm't. @ 7.2 % of Hot Bit. Pvm't.
				0.200		GAL.	SS-1H or CSS-1H Emuls. Asph. for Dust Control @ 0.20 Gal./S.Y. +

+ For detour west of Highway 1806 approx. 1/4 Mile (South 19th Street)

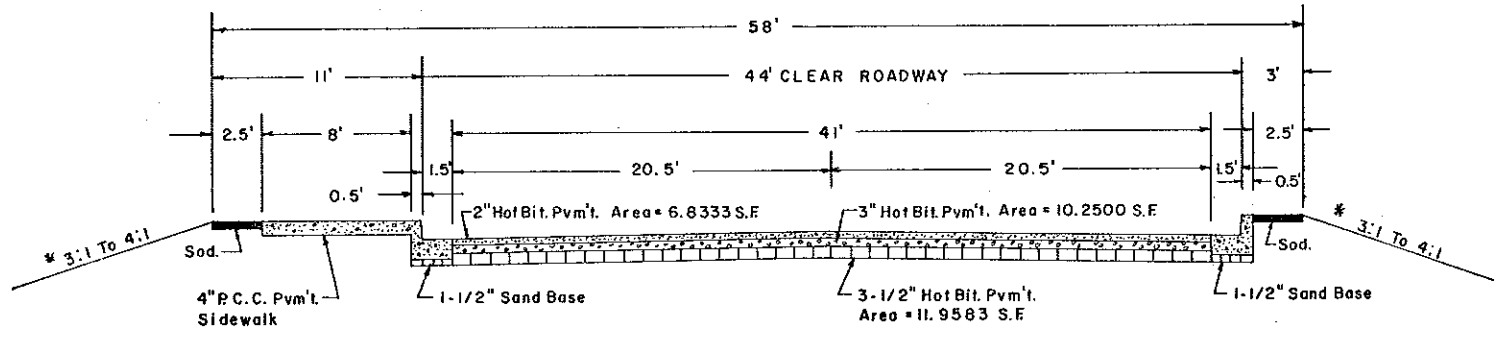

TYPICAL SECTION (NORTH OF STRUCTURE)


\* SEE CROSS SECTIONS

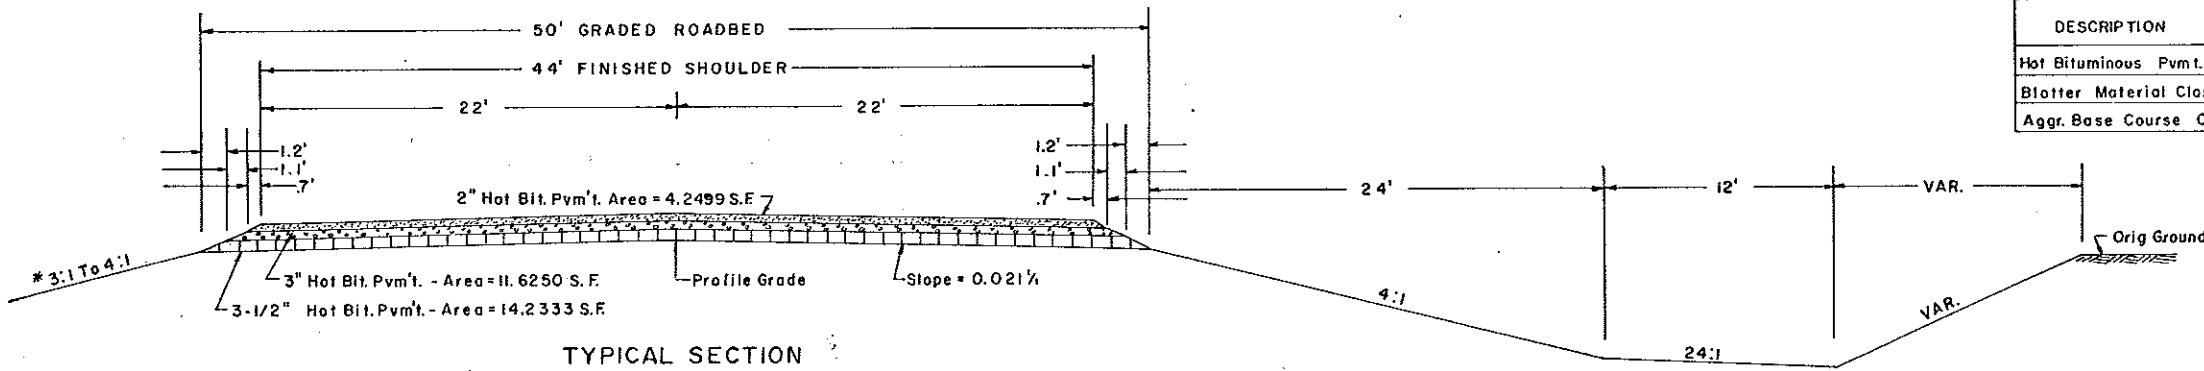


TYPICAL SECTION (SOUTH OF STRUCTURE)

MAXIMUM SIZE OF AGGREGATE		
DESCRIPTION	TYPE OF AGGREGATE	MAXIMUM SIZE
Hot Bituminous Pvm't. Cl. 24	Crushed	3/4"
Blotter Material Class 44	Screened	5/8"
Aggr. Base Course Class 8	Crushed	3/4"

ESTIMATE OF QUANTITIES				
SPEC. NO.	216	406	401	
CODE NO.	0120	0185	0320	0152
DESCRIPTION	WATER	HOT BIT. PVM'T. CL. 24	120-150 ASPH. CEMENT	SS-1H or CSS-1H EMULS. ASPH FOR TACK COAT
	"M" Gal.	Ton	Ton	Gal.
32+00 To 35+22 (Trans.)	1.5	659.9	47.5	138.0
35+22 To 35+81	0.3	126.9	9.1	26.9
38+96 To 40+60	0.8	390.9	28.1	82.5
40+60 To 42+70	1.0	515.2	37.1	108.0
42+70 To 43+50 (Trans.)	0.4	163.7	11.8	34.2
P.D. Appr.		31.8	2.3	9.0
Add. Mat'l. for Bridge Ends		11.4	0.8	
Detour (South 19th St.)				66.7
Add'l. Mat'l. Btwn. Asph. Sidewalk & M.L.	0.8	53.8	3.9	15.5
38+88 To 40+51 Sidewalk	0.8	30.8	2.2	13.8
<b>GRAND TOTAL</b>	<b>5.6</b>	<b>1984.4</b>	<b>142.8</b>	<b>494.6</b>

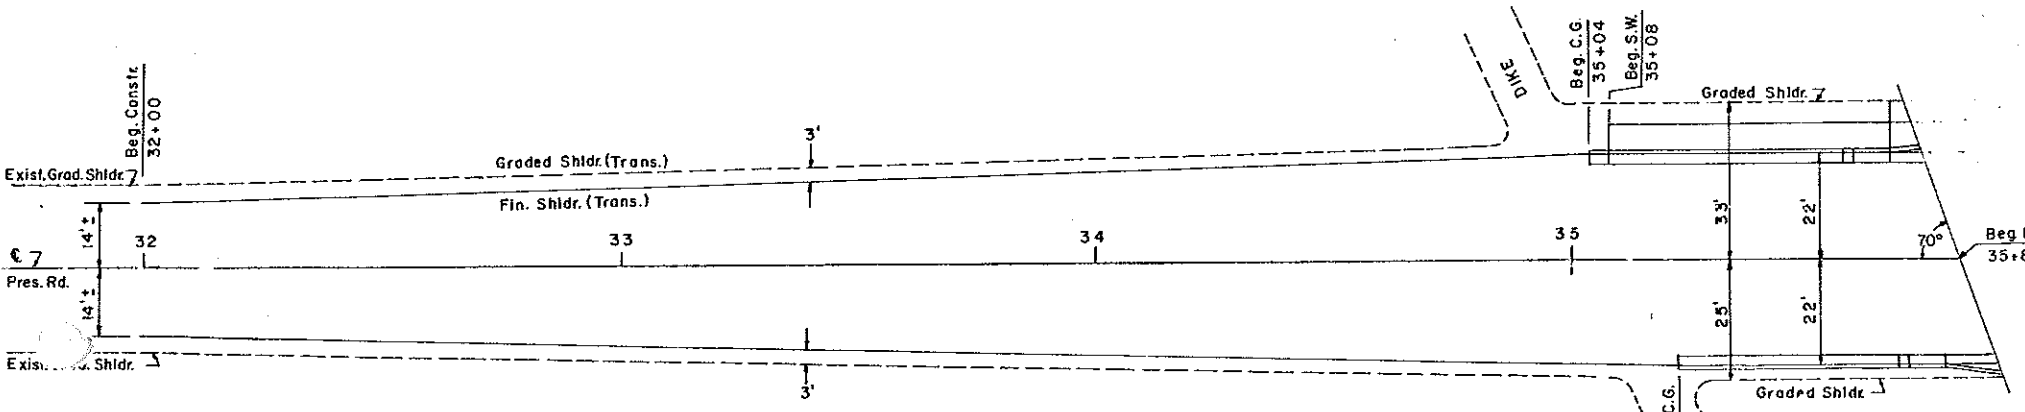


SHOULDER TRANSITION N. OF STRUCTURE

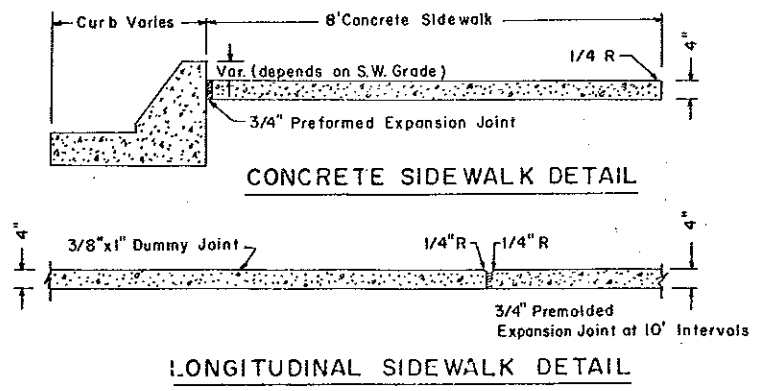


CONCRETE SIDEWALK DETAIL


LONGITUDINAL SIDEWALK DETAIL

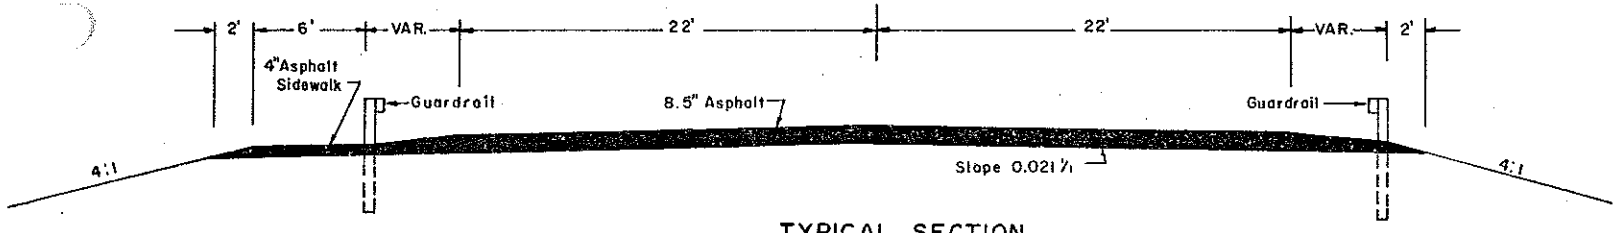

TYPICAL SECTION  
38+96 to 40+39 Lt.  
38+96 to 40+01.2 Rt.

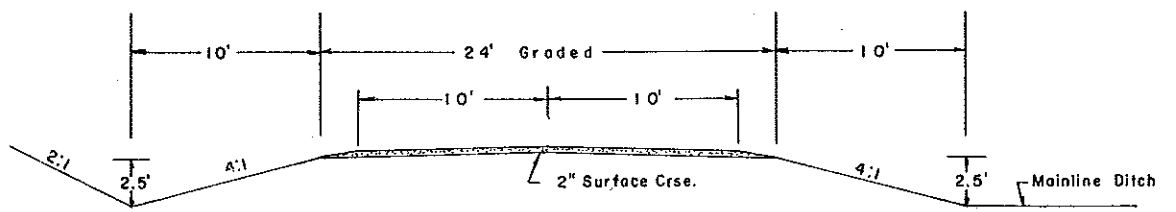


TYPICAL SECTION  
APPR. ROAD

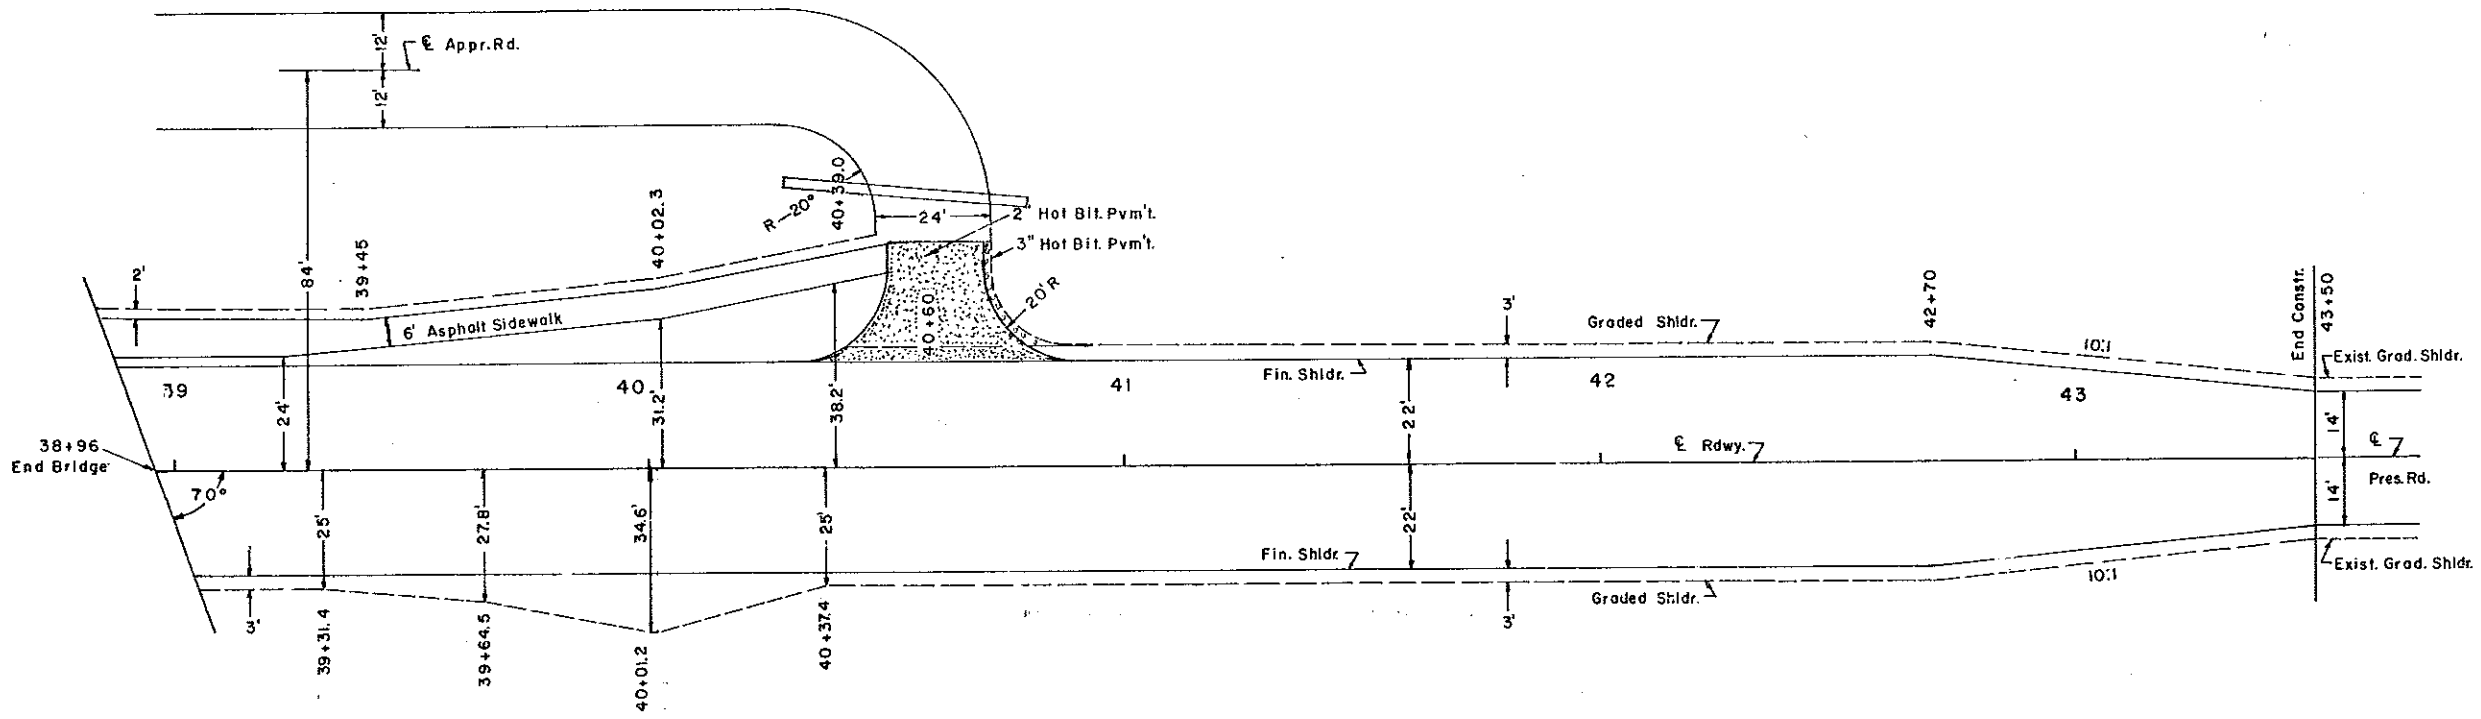




SOUTH END OF STRUCTURE

FHWA REGION	STATE	FED. AID PROJ. NO.	SHEET NO.
8	N.D.	BRF-I-006(02)	

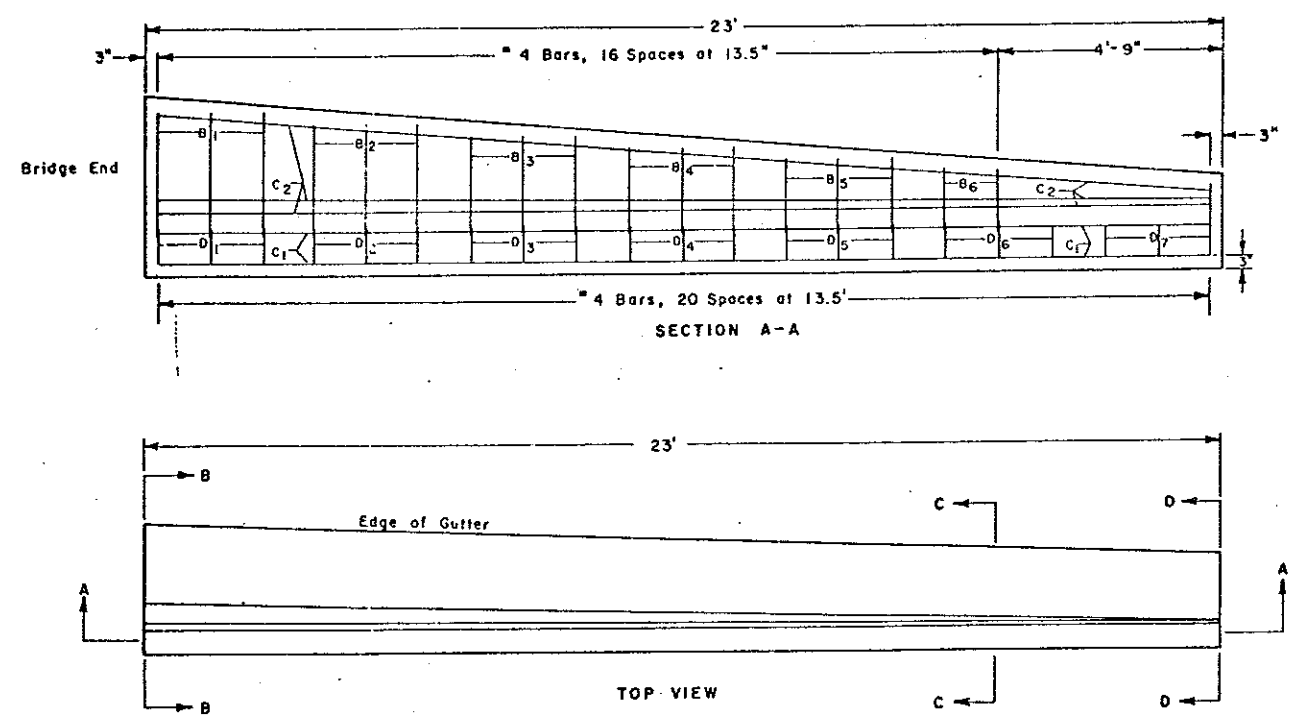


BAR LIST				
MARK	QUANTITY	SIZE	LENGTH	SHAPE
A1	3	4	2'-7"	Str.
A2	3	4	2'-4"	Str.
A3	3	4	2'-1"	Str.
A4	3	4	1'-10"	Str.
A5	3	4	1'-7"	Str.
A6	2	4	1'-4"	Str.
B1	3	4	3'-10"	Bent
B2	3	4	3'-7"	Bent
B3	3	4	3'-4"	Bent
B4	3	4	3'-1"	Bent
B5	3	4	2'-10"	Bent
B6	2	4	2'-7"	Bent
C1	6	4	22'-6"	Str.
C2	3	4	22'-7"	Str.
D1	3	4	6'-5"	Bent
D2	3	4	6'-2"	Bent
D3	3	4	6'-0"	Bent
D4	3	4	5'-9"	Bent
D5	3	4	5'-6"	Bent
D6	3	4	5'-4"	Bent
D7	3	4	5'-1"	Bent

Note: Curb Transitions as shown on this detail are not a separate pay item. Costs to be included in prices bid for Curb and Gutter. Each curb transition consists of approximately 3.5 cu. yds. of concrete and 275 lbs. of reinforcing steel.

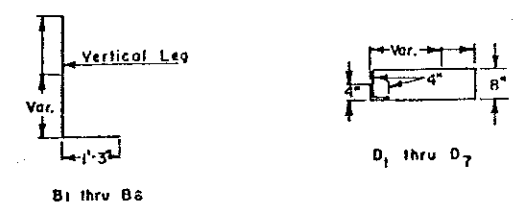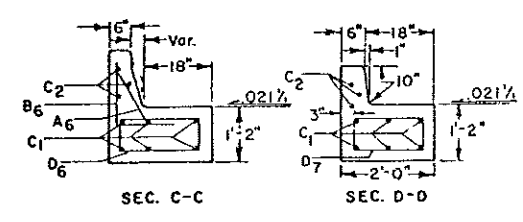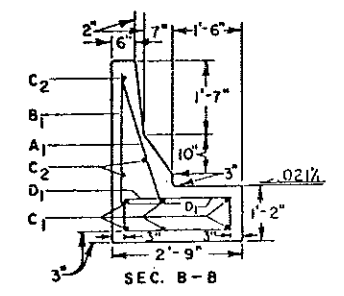

CURB TRANSITION



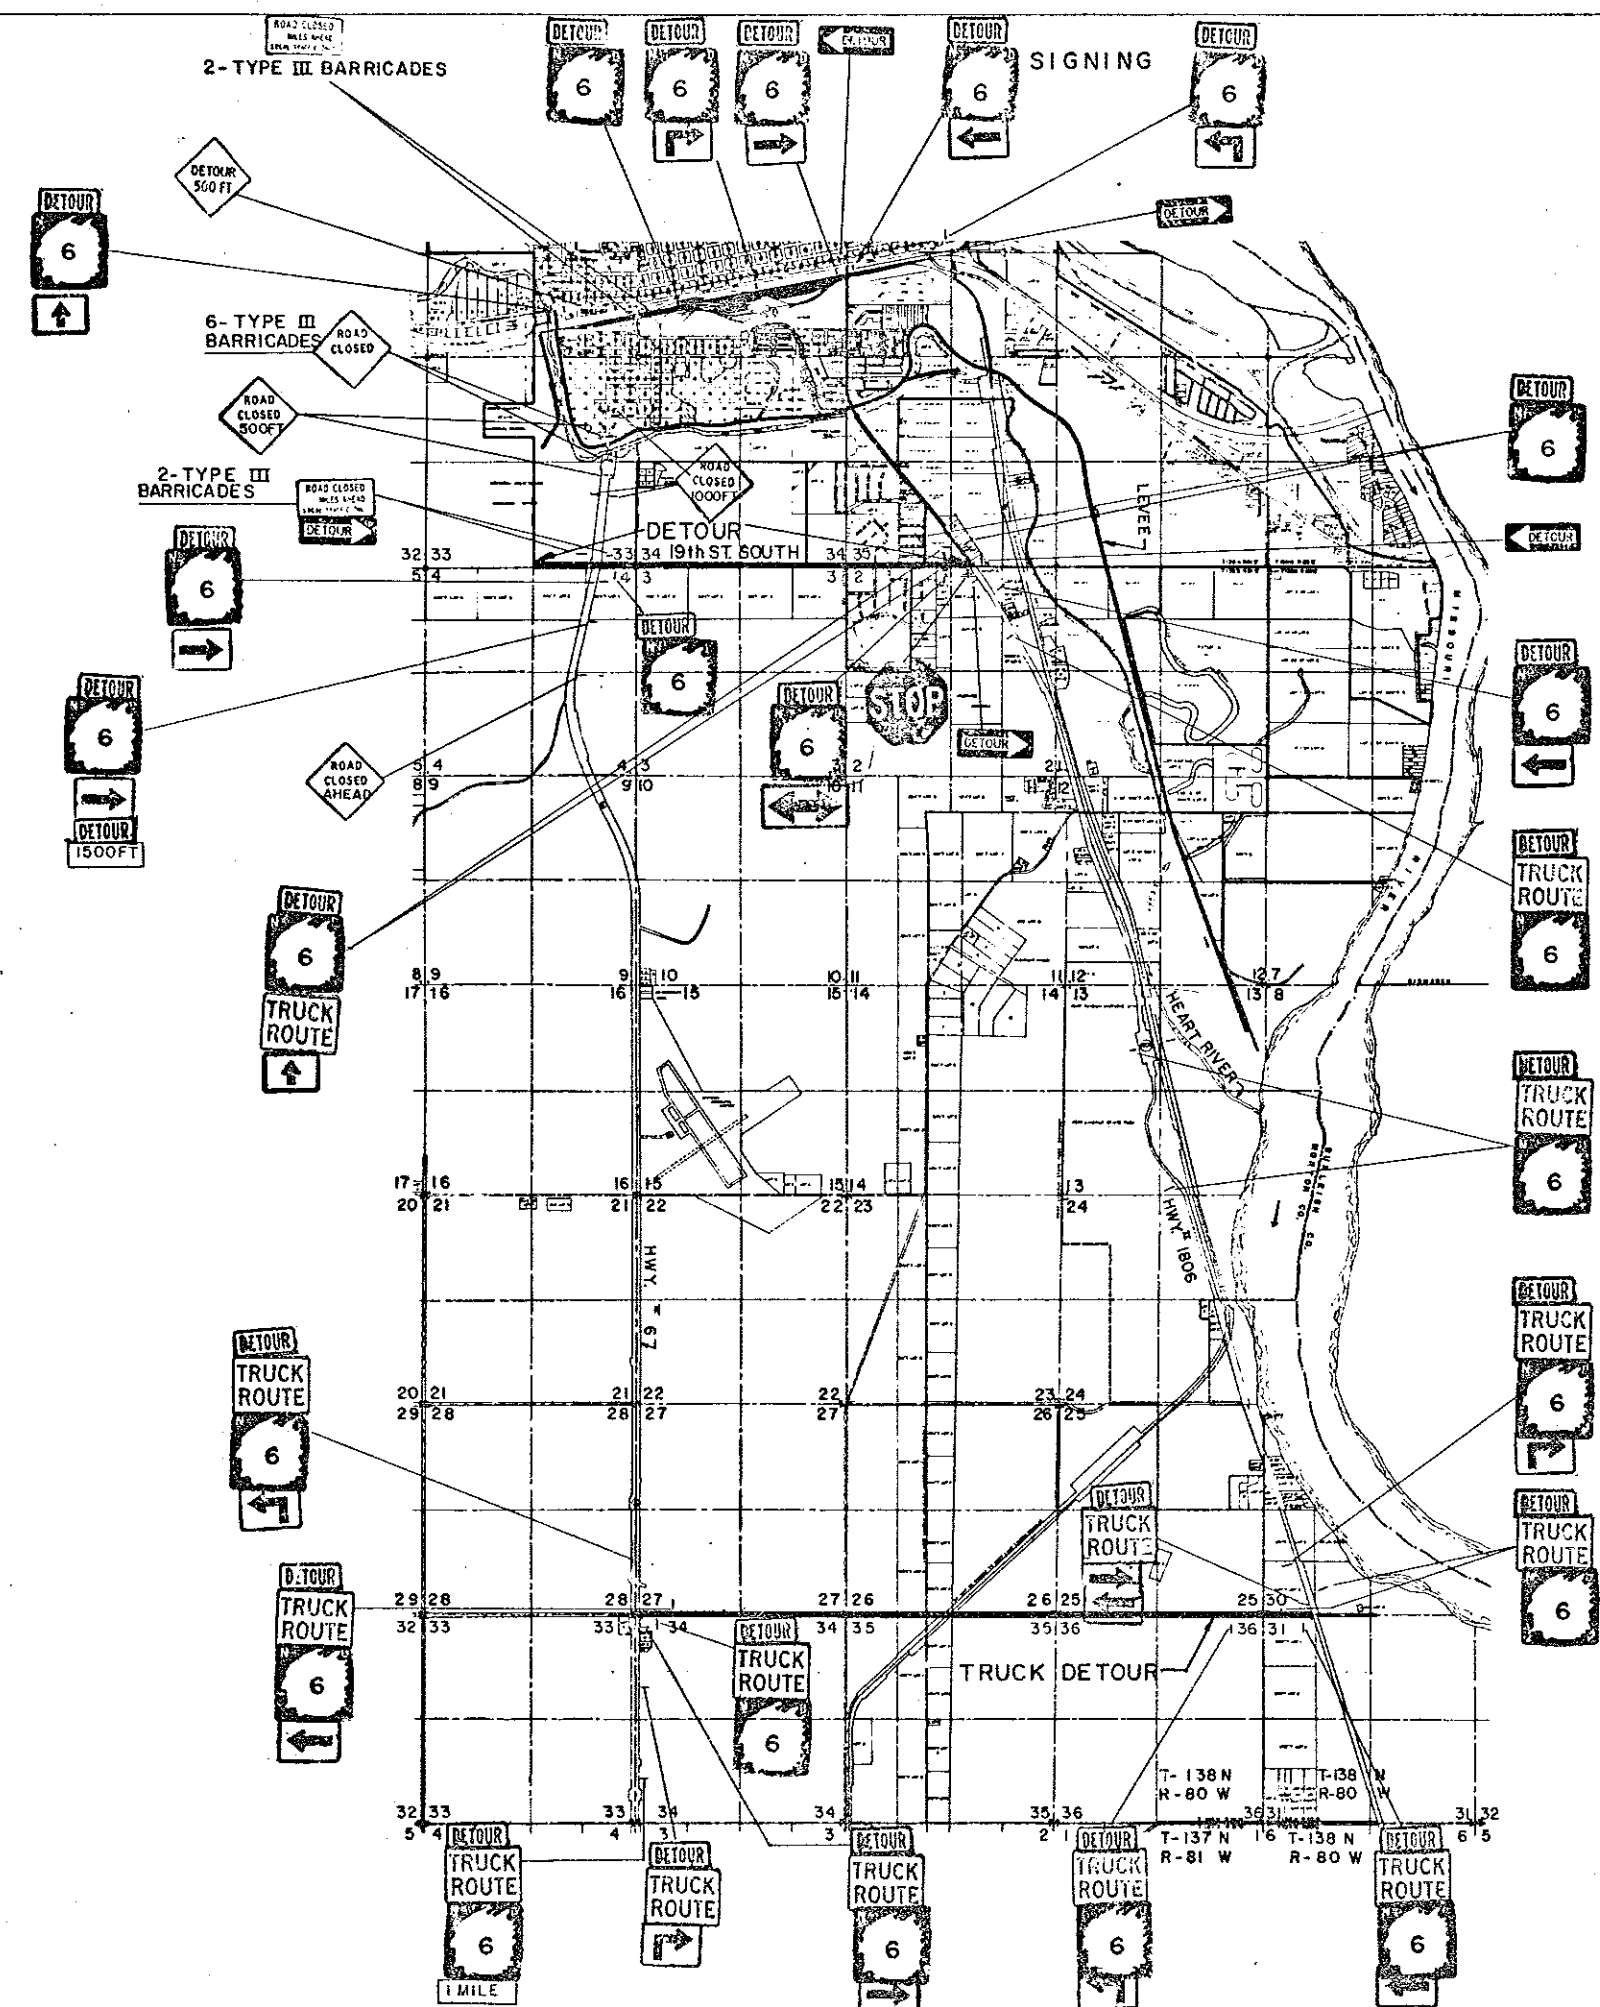

CONSTRUCTION SIGNING

MANDAN  
INC. POP. 15,513(1980)

FED. ROAD DIST. NO.	STATE	PROJECT NO.	SHEET NO.
8	N.D.	BRF-1-006(02)	



BENCH MARKS		LOCATION	ELEV.
NO	DESCRIPTION		
1	E Edge of Light Sid Base	33 + 80 Rt	1648.17
2	Curb NW Cor of Bridge	36 + 04	1660.49
3	Curb SW Cor of Bridge	38 + 69	1662.38
4	Top of Pipe N End	44 + 36 48' Lt	1676.61

Begin BRF-1-006(02)066 Sta 32+00 =  
Sta. 32+00 on F-251(15)

End BRF-1-006(02)066 Sta 43+50  
Sta. 43+50 on F-251(15)

**INSTALL CURB & GUTTER TYPE 1(SEC B-10)**

35+04 to 35+50 Lt. 46 L.F.  
35+22 to 35+60 Rt. 44 L.F.

**INSTALL CONCRETE SIDE WALK**


35+08 to 35+72.8 Lt. 57 S.Y.

**INSTALL CURB TRANSITION**

35+50 to 35+73 Lt. 1 Ea.  
35+66 to 35+89 Rt. 1 Ea.

**INSTALL R/W MARKERS**

41+00 Lt. 2  
41+50 Rt. 2  
43+50 Lt & Rt. 3

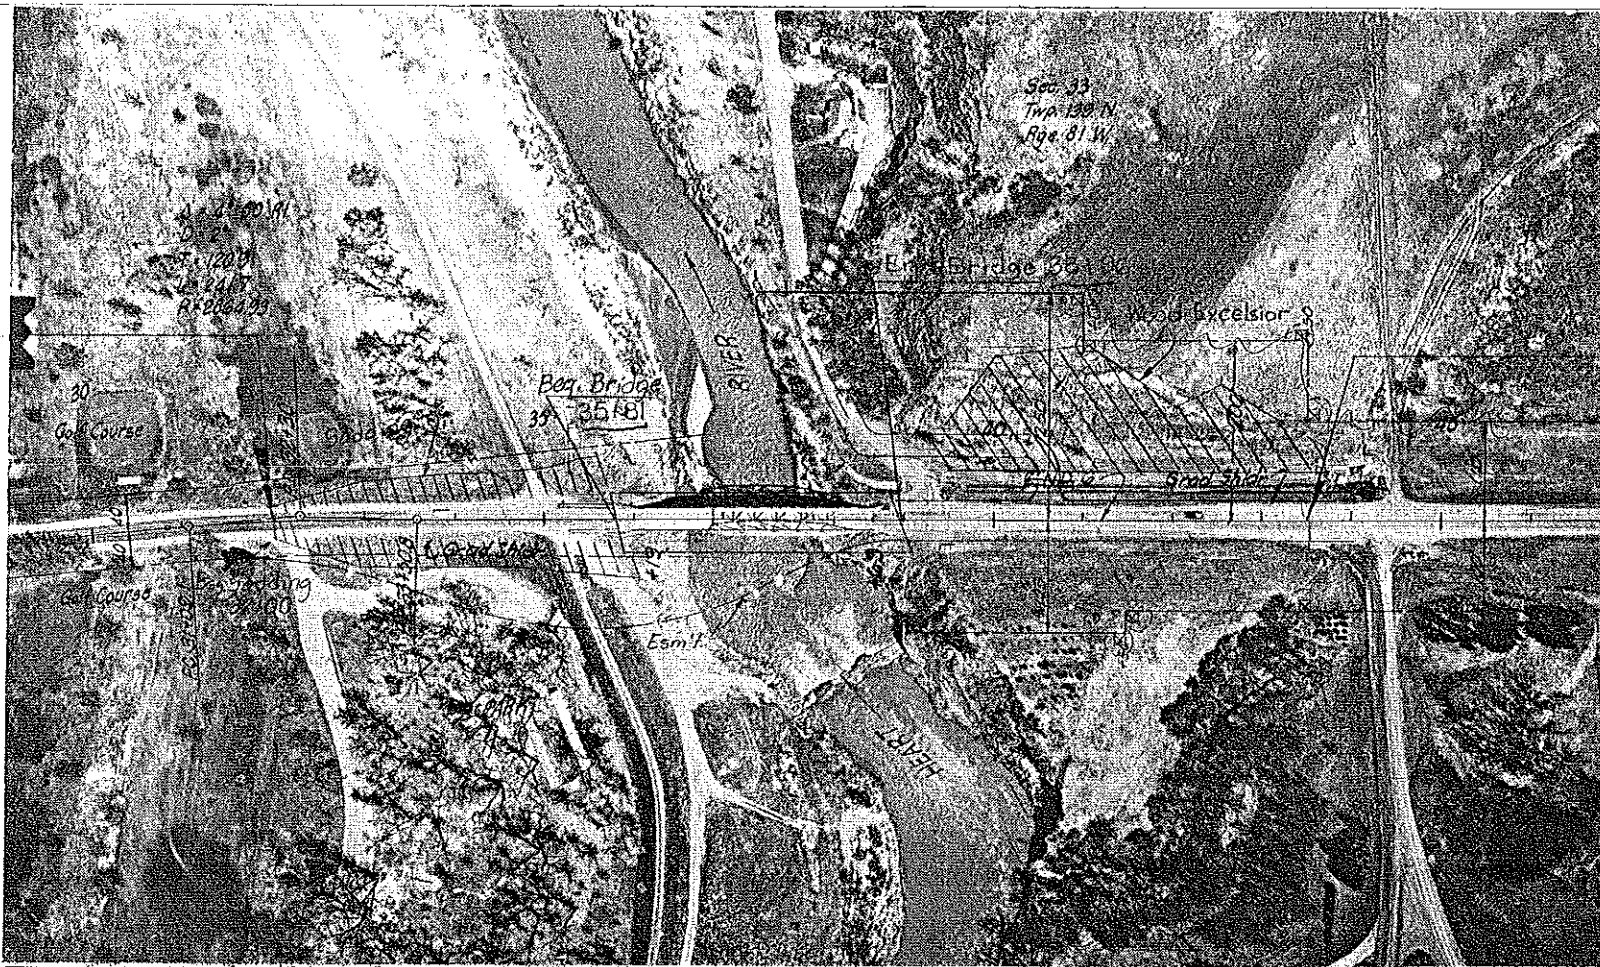


**INSTALL PIPE CULVERT**  
40+60 Lt. 24"x52' C.S.P. (064) 2-C.S.E.S. (064)

**INSTALL SODDING**  
32+00 to 35+89 Lt & Rt 2376 S.Y.

**INSTALL WOOD EXCELSIOR FIBERMAT**  
38+96 to 41+00 Lt. Backslope 3000 S.Y.

Sta. 36+04.06 to Sta. 38+69.06  
3-Span Bridge CL. Rdwy. 22.0  
N. End Span - Conc. Slab Supported by Rolled Beams  
S. End Span - Conc Slab  
Center Span - Steel Truss with Conc. Slab


39+15 Lt.  
24"x42' C.M.P.  
Remove & Seal

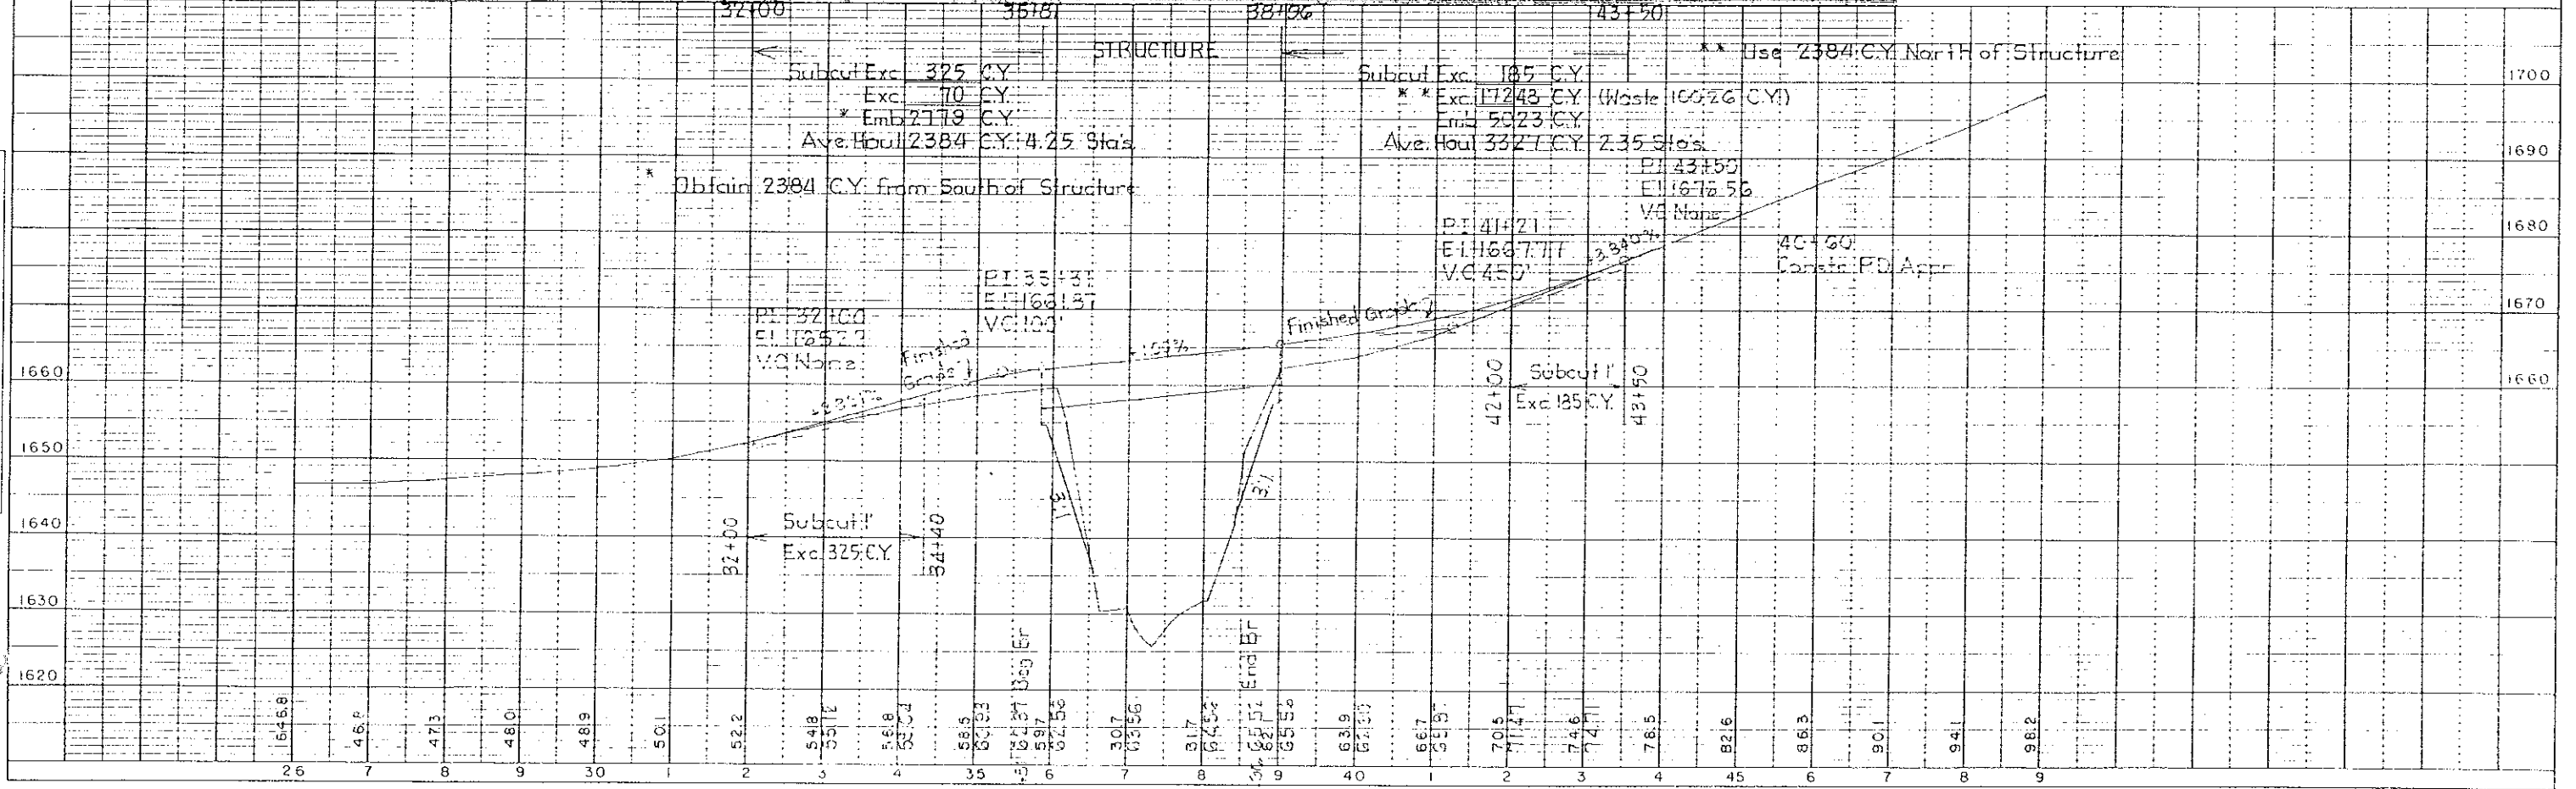

PLAN  
NOT TO SCALE  
SHOWN FOR REFERENCE ONLY  
DO NOT USE FOR CONSTRUCTION

PROFILE  
NOT TO SCALE  
SHOWN FOR REFERENCE ONLY  
DO NOT USE FOR CONSTRUCTION


FHWA REGION	STATE	FED. AID PROJ. NO.	SHEET NO.
8	N.D.	BRF-1-006(02)066	

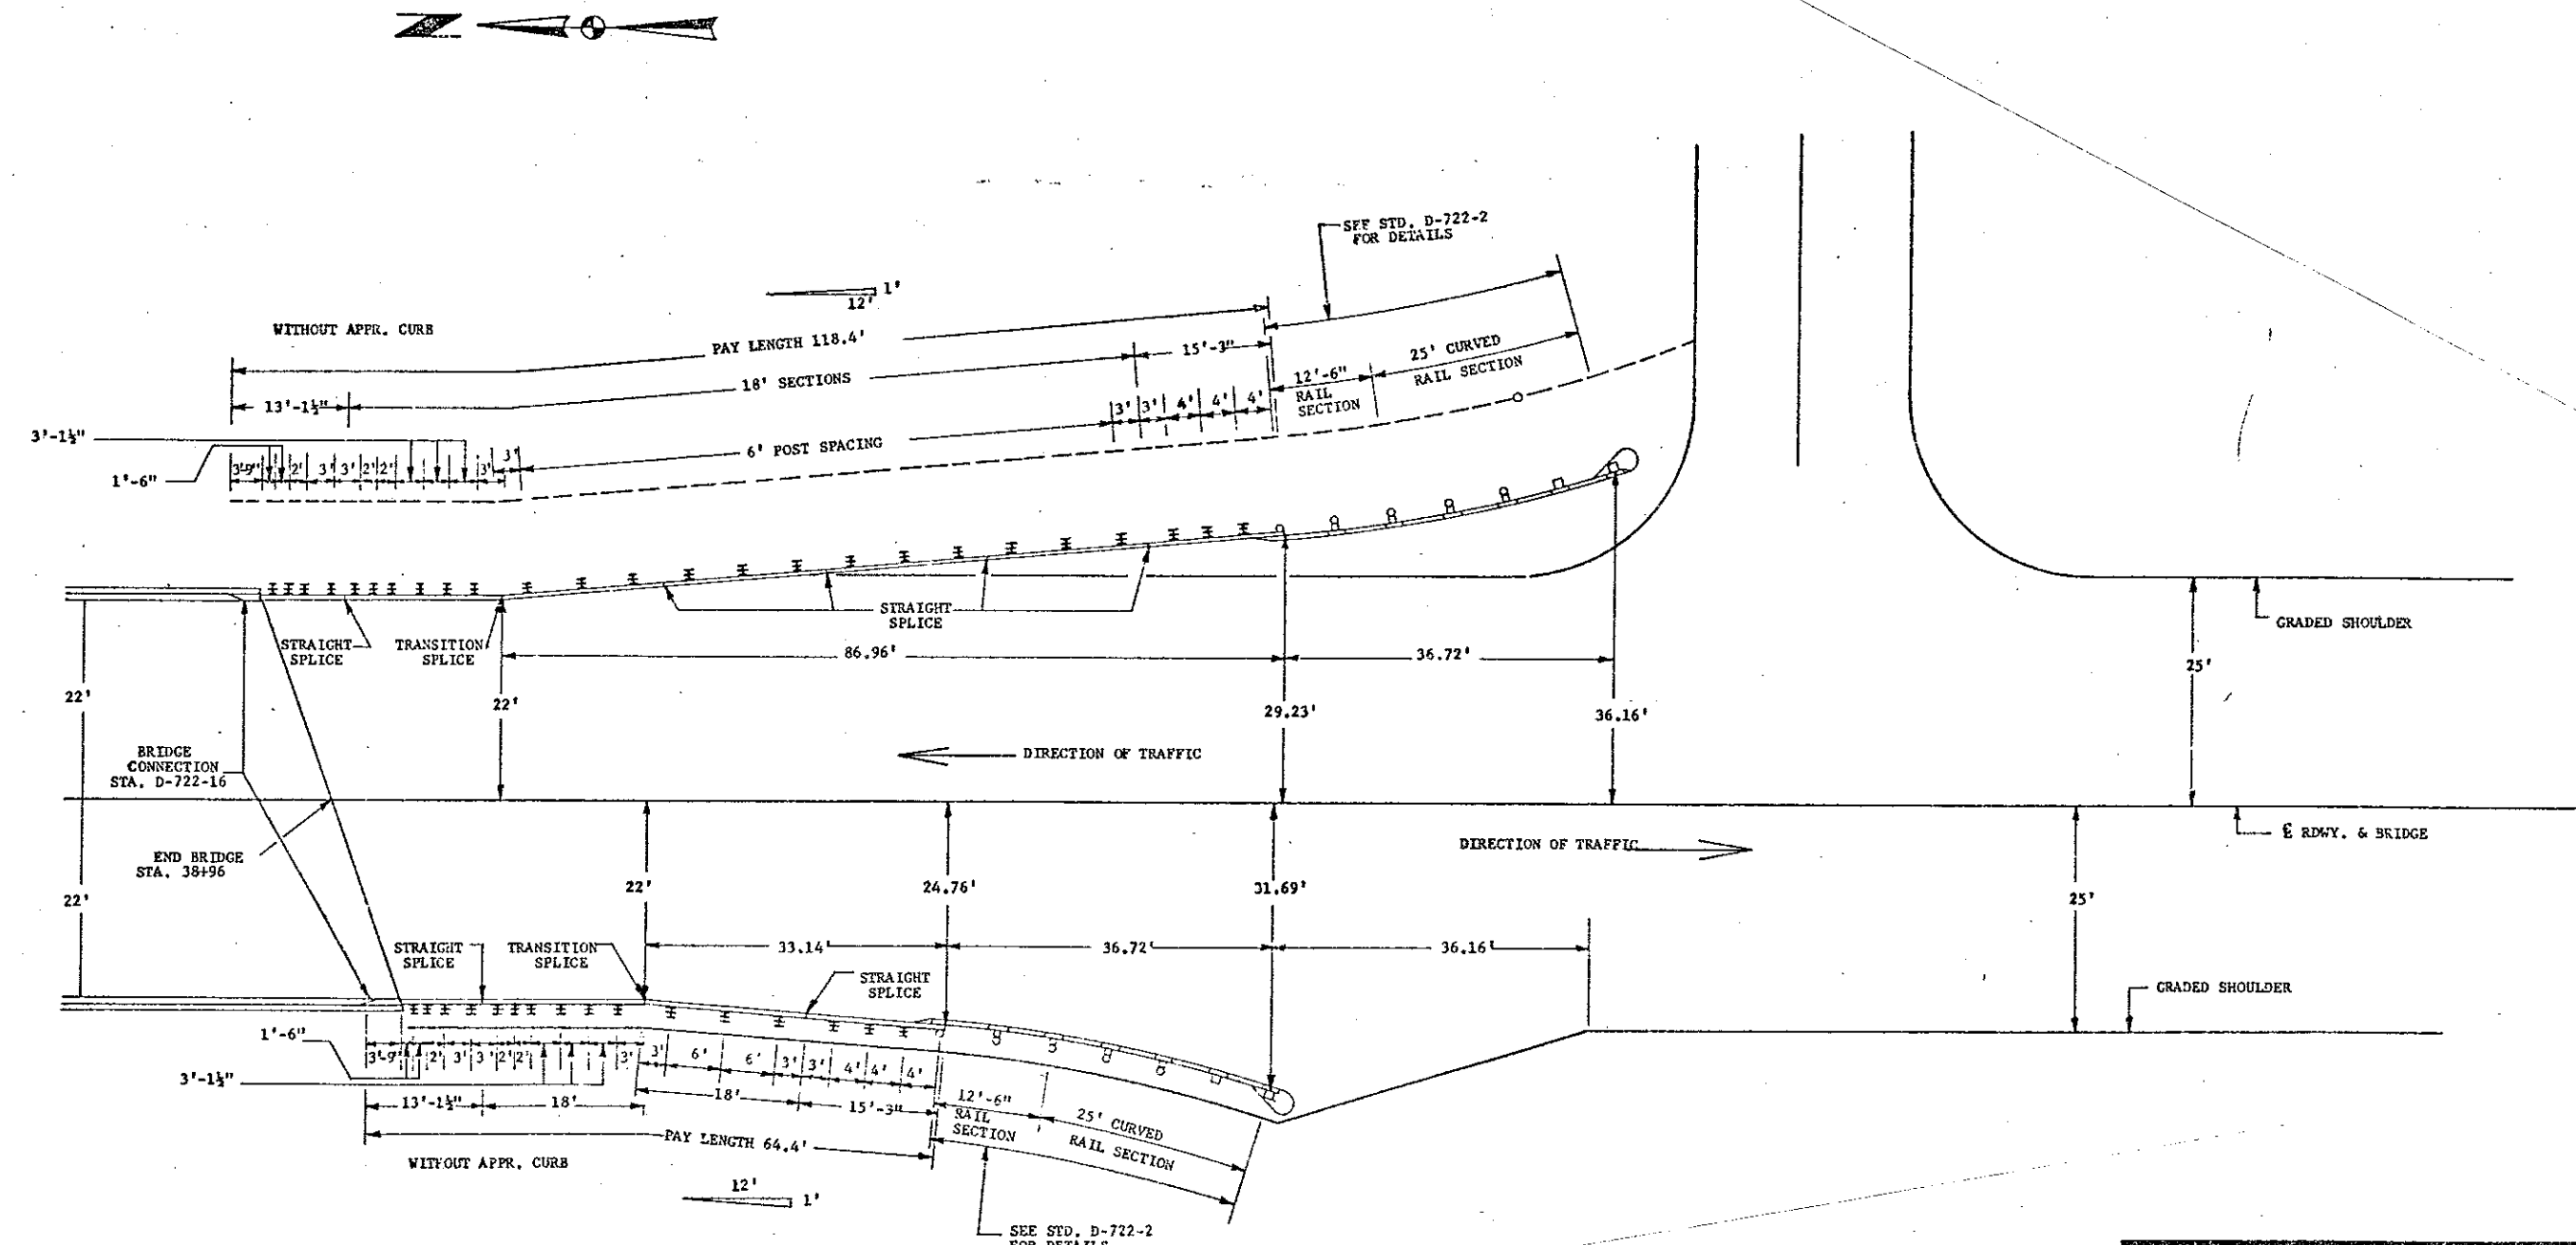

**BOX BEAM GUARDRAIL LAYOUT**  
 Sta. 38+96 @ - End Bridge  
 Heart River Bridge  
 Skew 20° Lt. & Bk.  
 Morton County  
 Mandan, ND

FHWA REGION	STATE	FED. AID PROJ. NO.	SHEET NO.
8	N.D.	BRF-1-006(02)065	

BOX BEAM GUARDRAIL  
CONTINUES-SEE STD. D-722-16

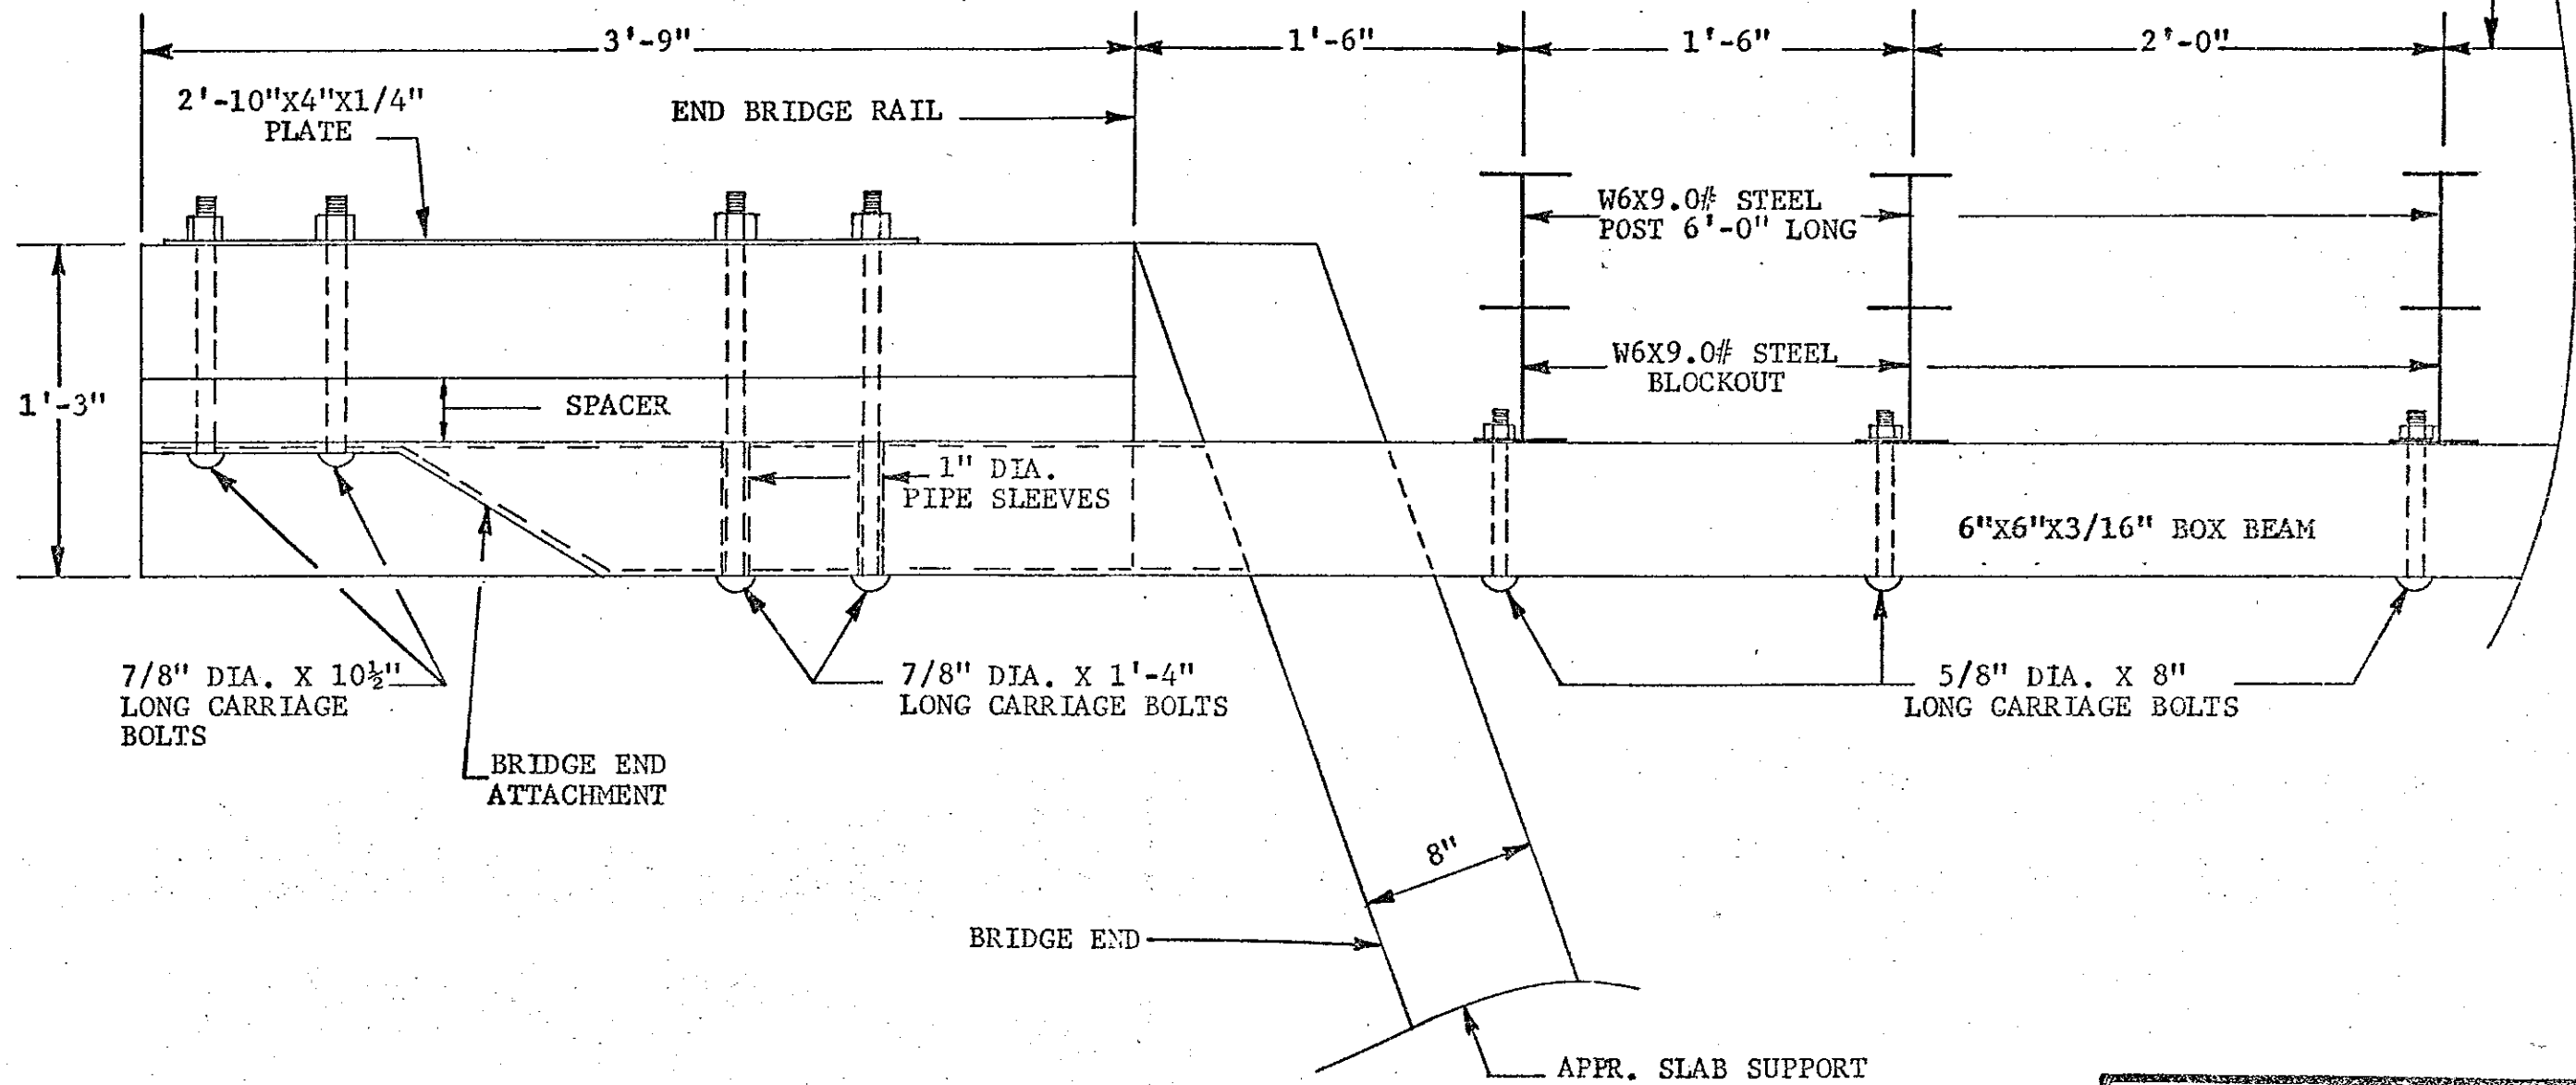

BOX BEAM GUARDRAIL BRIDGE  
CONNECTION DETAIL  
STA. 38+96 E - END BRIDGE  
HEART RIVER BRIDGE  
Skew 20° Lt. & Bk.  
Morton County  
Mandan, ND

ESTIMATED GUARDRAIL QUANTITIES\*

LOCATION	Box Beam Guardrail-Flared End Treatment & Transition																
	RAIL SECTION	CURVED RAIL SECTION	LINE POSTS	6"X8" WOOD ANCHOR POSTS	CONCRETE FOOTINGS	6"X6"X14" WOODEN OFFSET BLOCK	BACKING PLATE	ANCHOR PLATE AND CABLE ASSEMBLY	2'-6" SPECIAL END SHOE	BUFFER END SECTION	7/8" DIA. X 8" LONG CARRIAGE BOLTS	5/8" DIA. POST ATTACHMENT BOLTS	SPLICE BOLTS	REFLECTORIZED PLATES			
	LF	LF	EA	EA	EA	EA	EA	EA	EA	EA	EA	EA	EA	EA			
39+64.66 to 40+02.16 Rt.	12.5	25	5	2	2	4	4	1	2	1	3	7	25	2			
40+03.10 to 40+40.60 Lt.	12.5	25	5	2	2	4	4	1	2	1	3	7	25	2			
TOTALS	25	50	10	4	4	8	8	2	4	2	6	14	50	4			

\*These items are not to be bid separately but shall be included in the price bid for item; "Box Beam Guardrail-Flared End Treatment & Transition."

INSTALL BOX BEAM GUARDRAIL-FLARED END TREATMENT & TRANSITION

39+64.66 to 40+02.16 Rt.            1 EA  
 40+03.10 to 40+40.60 Lt.        1 EA

BOX BEAM GUARDRAIL QUANTITIES  
 HEART RIVER BRIDGE  
 Sta. 38+96 End Bridge  
 Morton County  
 Mandan, ND

ESTIMATED GUARDRAIL QUANTITIES\*

LOCATION	Box Beam Guardrail																				
	W6X9.0# POSTS	W6X9.0# BLOCKOUTS	5/8" DIA. X 8" LONG CARRIAGE BOLTS	5/8" DIA. X 1-3/4" LONG HEX HEAD BOLTS	S3X5.7# POSTS	S3X5.7# ADJUSTMENT BLOCK	5/8" DIA. X 8" LONG HEX HEAD BOLTS	3/8" DIA. X 1-3/4" LONG HEX HEAD BOLTS	5"X3 1/2"X7.0# BEAM ATTACHMENT ANGLE	TRANSITION SPLICE	STRAIGHT SPLICE	REFLECTORIZED PLATES	3'-9" LONG BRIDGE ATTACHMENT SPACER	2'-10" X 4" X 1/4" PLATE	7/8" DIA. X 1'-4" LONG CARRIAGE BOLTS	7/8" DIA. X 10 1/2" LONG CARRIAGE BOLTS	1" DIA. PIPE SLEEVES				
	EA	EA	EA	EA	EA	EA	EA	EA	EA	EA	EA	EA	EA	EA	EA	EA	EA	EA			
39+00.26 to 39+64.66 Rt.	5	5	5	10	11	11	11	44	11	1	2	2	1	1	2	2	6				
38+84.70 to 40+03.10 Lt.	5	5	5	10	20	20	20	80	20	1	5	5	1	1	2	2	6				
TOTALS	10	10	10	20	31	31	31	124	31	2	7	7	2	2	4	4	12				

\*These items are not to be bid separately but shall be included in the price bid for item; "Box Beam Guardrail."

INSTALL BOX BEAM GUARDRAIL

39+00.26 to 39+64.66 Rt.	64.4 LF
38+84.70 to 40+03.10 Lt.	118.4 LF





REMOVE 4-CABLE GUARDRAIL & POSTS

35+89.06 to 36+04.06 Rt. & Lt.	30 LF
38+69.06 to 38+84.06 Rt. & Lt.	30 LF

BOX BEAM GUARDRAIL QUANTITIES  
 HEART RIVER BRIDGE  
 Sta. 38+96 End Bridge  
 Morton County  
 Mandan, ND



BRIDGE CODE	FHWA REGION	STATE	FED. AID PROJ. NO.	SHEET NO.
X-071	8	N.D.	BRF-1-006 ( )	

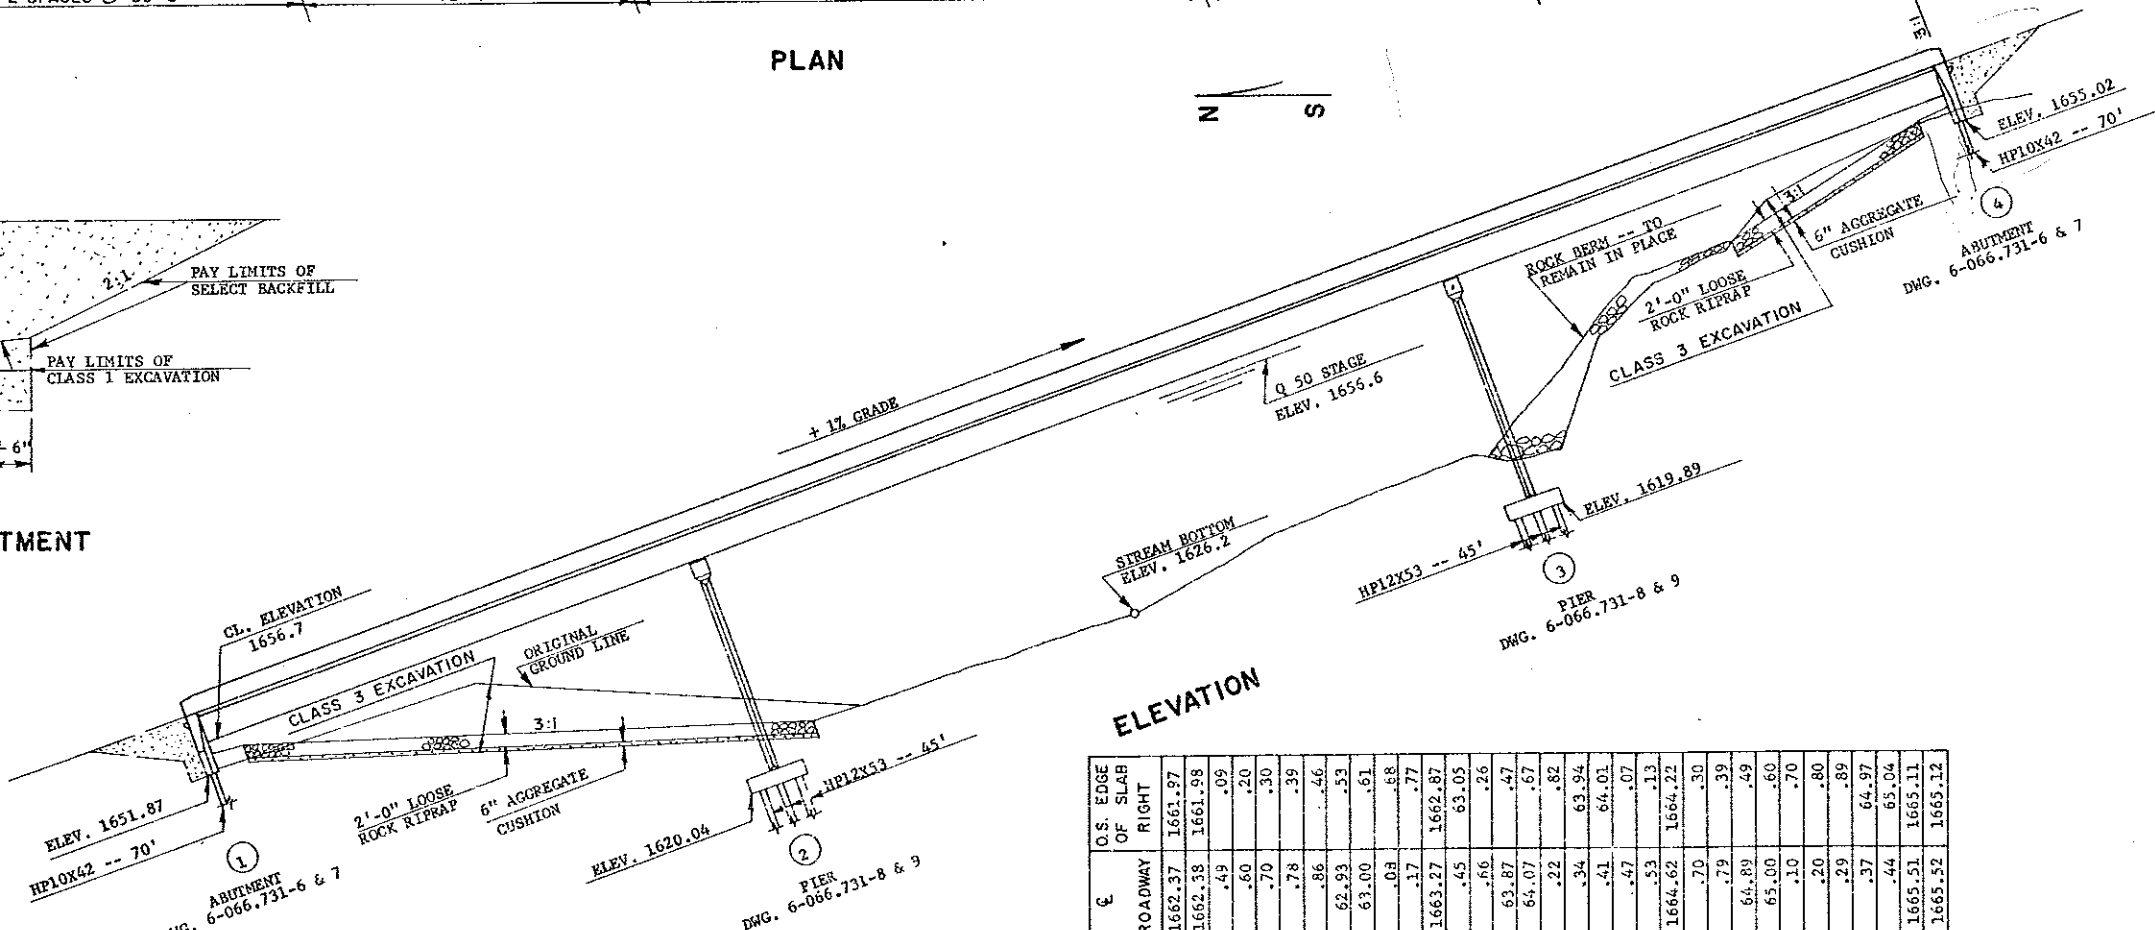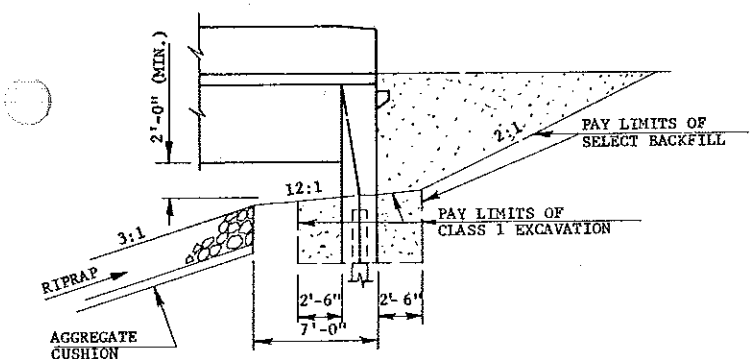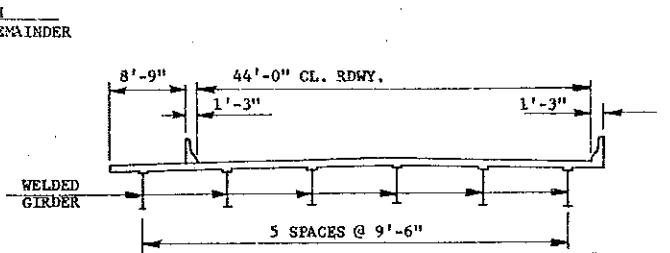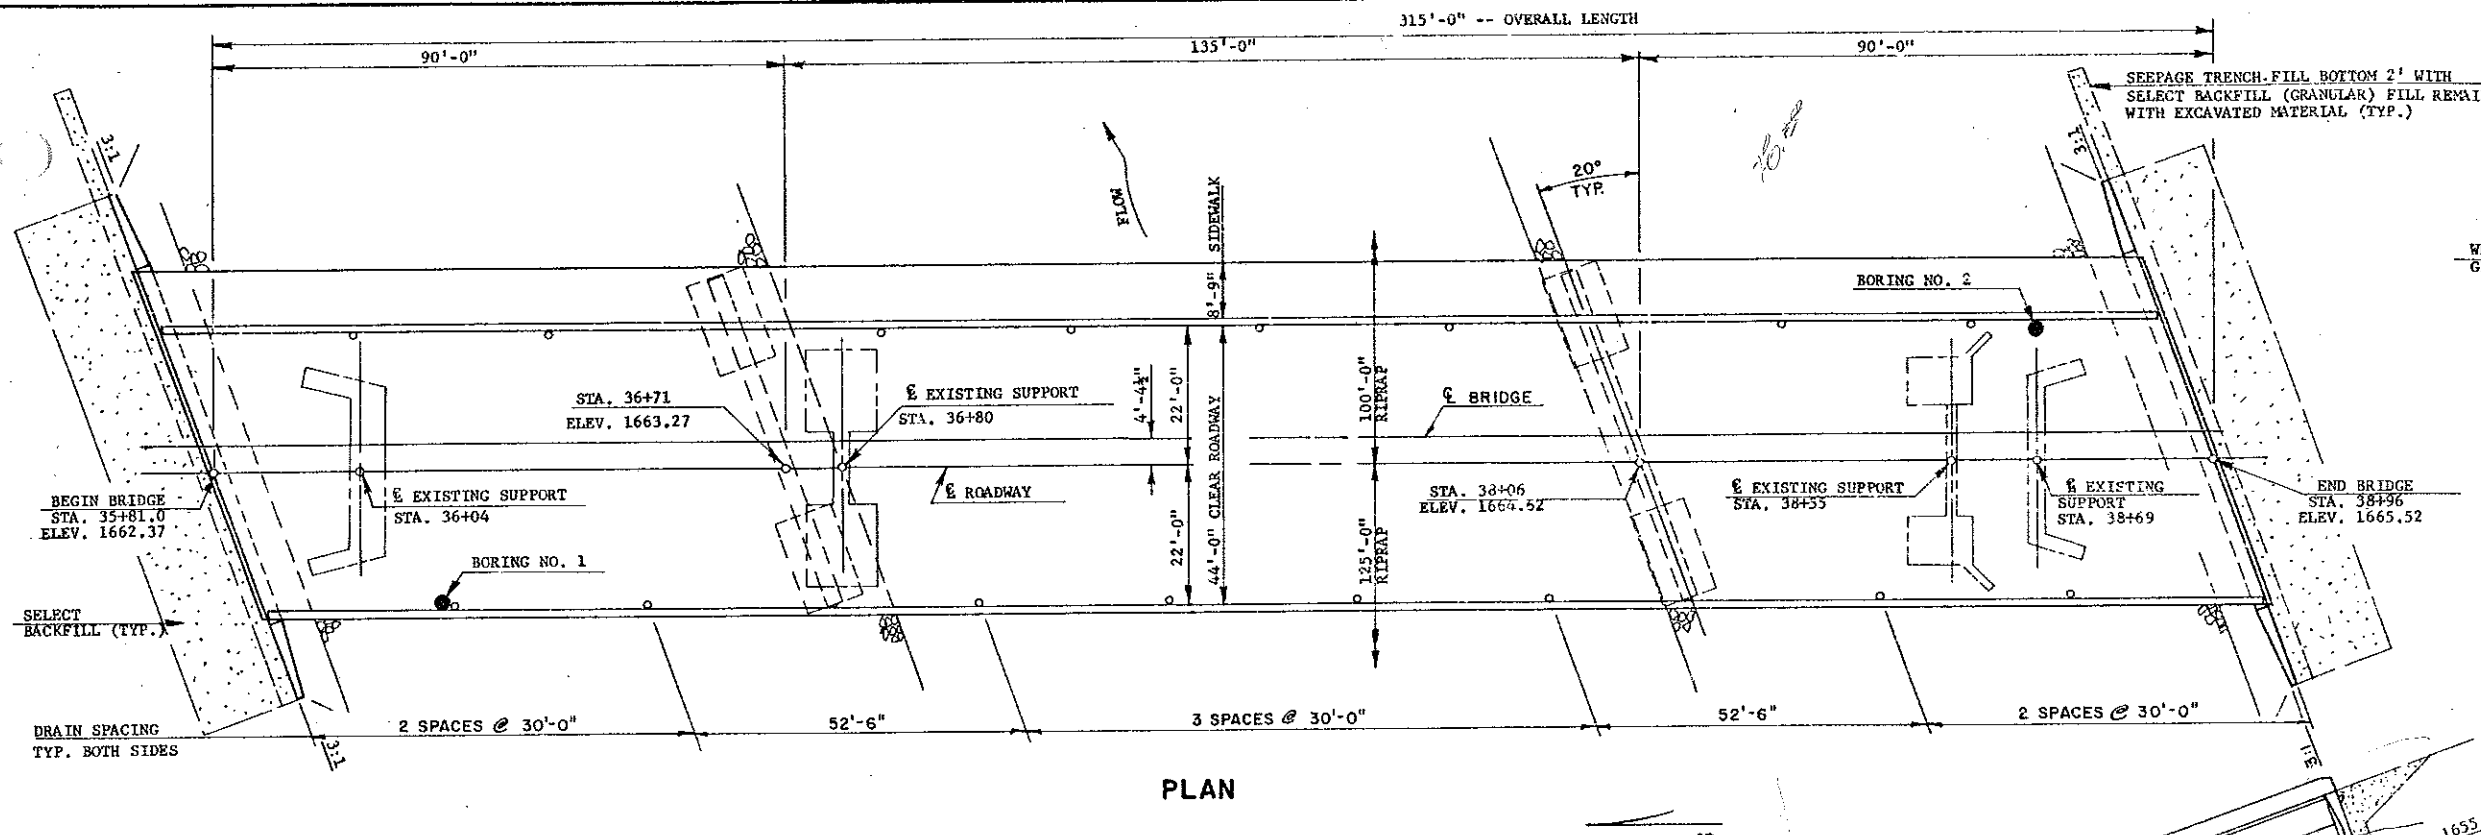

**DESIGN STRENGTHS**  
 f'c = 3,000 psi -- CLASS AE-1 CONCRETE  
 f'c = 4,000 psi -- CLASS AAE-3 CONCRETE  
 fy = 50,000 psi -- A572 STRUCTURAL STEEL  
 fy = 36,000 psi -- A36 STRUCTURAL STEEL  
 fy = 60,000 psi -- REINFORCING STEEL

LOAD FACTOR DESIGN

\* BELOW BOTTOM CONCRETE ELEVATIONS

BENCH MARKS				PILE LOADINGS					
NO.	DESCRIPTION	LOCATION	ELEV.	LOCATION	DEAD LOAD	LIVE LOAD	* MIN. PENETRA	DESIGN LOAD	MAX. BEARING
1	EAST EDGE OF LIGHT STANDARD	STA. 33+80 RT.	1648.17	ABUT. 1	26.3	6.1	45	32.4 T.	55 T.
2	CURB SW CORNER OF BRIDGE	STA. 36+04	1660.49	PIER 2	50.3	11.8	15	62.1 T.	70 T.
3	CURB SW CORNER OF BRIDGE	STA. 38+69	1662.38	PIER 3	50.3	11.8	15	62.1 T.	70 T.
4	TOP OF PIPE, NORTH END	STA. 44+36-48' LT.	1676.61	ABUT. 4	26.3	6.1	45	32.4 T.	55 T.

**SCREED ELEVATIONS**  
 ELEVATIONS ARE TO TOP OF FINISHED CONCRETE

O.S. EDGE OF SLAB	ROADWAY	RIGHT	LEFT
1661.59	1662.37	1663.97	1661.98
1661.60	1662.38	1661.98	1661.99
.71	.49	.09	.20
.82	.60	.30	.39
61.91	.70	.30	.46
62.00	.78	.39	.53
.08	.86	.46	.61
.15	62.93	.53	.68
.22	63.00	.61	.77
.30	.08	.68	.82
.39	.17	.77	.89
1662.49	1663.27	1662.87	.67
.67	.65	63.05	.76
62.88	.56	.26	.47
63.09	63.87	.47	.57
.29	64.07	.57	.67
.44	.22	.82	.94
.56	.34	63.94	.07
.63	.41	64.01	.13
.69	.47	.07	.20
.75	.53	.13	.26
1664.84	1664.62	1664.22	.30
.83	.70	.30	.39
64.01	.79	.39	.49
.11	64.89	.49	.60
.21	65.00	.60	.70
.32	.10	.70	.80
.42	.20	.80	.89
.51	.29	.89	.97
.59	.37	.97	65.04
.66	.44	65.04	1665.11
1664.73	1665.51	1665.11	1665.52
1664.74	1665.52	1665.12	

**SPECIAL PROVISIONS**

NO.	NAME
388	404 PERMITS - EARTHWORK
102-18	BUY AMERICA - CEMENT AND STEEL

**ESTIMATE OF QUANTITIES**

SPEC. CODE NO.	BID ITEM	LUMP SUM
202 0105	REMOVAL OF STRUCTURE	
208 0100	CLASS 1 EXCAVATION	180 C.Y.
208 0110	CLASS 2 EXCAVATION	300 C.Y.
208 0120	CLASS 3 EXCAVATION	9820 C.Y.
208 0200	FOUNDATION PREPARATION	LUMP SUM
228 0100	SELECT BACKFILL	450 C.Y.
602 0130	CLASS AAE-3 CONCRETE	552.3 C.Y.
602 1110	CLASS AE-1 CONCRETE	3311 C.Y.
602 7000	SPECIAL SURFACE FINISH	+220 S.F.
612 0115	REINFORCING STEEL - GRADE 60	83,908 LBS.
612 0116	REINF. STEEL - GR. 60 (EPOXY COATED)	72,575 LBS.
616 5890	STRUCTURAL STEEL	LUMP SUM
(ESTIMATED TOTAL - A572 & A36 = 368,519 LBS.)		
622 0020	STEEL PILING HP 10x42	840 L.F.
622 0040	STEEL PILING HP 12x53	1350 L.F.
622 0393	STEEL TEST PILING HP 10x42	160 L.F.
622 1200	STEEL TEST PILING HP 12x53	110 L.F.
624 0124	PEDESTRIAN FENCE	329 L.F.
702 0130	LOOSE ROCK RIPRAP	200 C.Y.
703 0100	AGGREGATE CUSHION	520 C.Y.
750 0100	LINSEED OIL TREATMENT	28 GAL.
900 3000	BRIDGE BENCH MARKS	1 SET

**STRUCTURAL DRAWINGS**

GENERAL DRAWINGS (THIS SHEET), 6-066.731-1 THRU 5  
 SUBSTRUCTURE 6-066.731-6 THRU 9, & H-0401  
 SUPERSTRUCTURE 6-066.731-10 THRU 16 & C-900-1

DESIGN LOADING (HS20 1944) SCALE 1 INCH = 15 FEET

NORTH DAKOTA STATE HIGHWAY DEPARTMENT  
 HEART RIVER, MANDAN  
 BRIDGE LAYOUT

PROJECT NO. BRF-1-006 ( ) 066 STA. 37+38.5 MORTON COUNTY

APPROVED: [Signature]  
 DATE: 1-30-54  
 DESIGN ENGINEER

6-066.731



FHWA REGION	STATE	FED. AID PROJ. NO.	SHEET NO.
8	ND.	BRF-1-006 (02)	

100 GENERAL: The cost of furnishing and placing preformed expansion  
010 joint filler, bar spacers, bar supports, screed chairs, threaded  
inserts, deck drains, and other miscellaneous items shall be  
included in the price bid for Class AE-1 and AAE-3 concrete.

100 Bearing areas shall be finished true to plan and elevation by  
017 grinding, if necessary, before bearing plates are set.

100 Dead load deflections have been accounted for in the screed  
020 elevations.

208 Excavation Class 1, at the abutments, shall extend from the  
020 bottom of the footing to the upper limits as shown on the bridge  
layout drawing.

228 BACKFILL: All backfilling shall be done according to Sections  
010 203-2.3.2 and 228 of the Standard Specifications. Select  
backfill shall not be placed above the elevation of the berm  
until the superstructure has cured.

602 DECK-FINISHING MACHINE: In addition to the requirements of  
010 Section 602-3.6.2.2 of the Standard Specifications, the  
deck-finishing machine shall be self propelled, mounted on  
wheels which ride on a track, and have one or more power-driven,  
oscillating, rotating, or vibrating screeds.

602 CONCRETE BARRIER RAILING: The concrete barrier shall be formed  
110 for a minimum of three contiguous sections. Concrete shall be  
placed in alternate sections and shall have a curing period of  
three days between placement of adjacent sections. Provide  
adequate tie wires on the barrier forms to avoid any shifting  
during the placement. Form a 3/4" triangular groove at the  
midpoint of each barrier section. Groove both vertical faces  
and across the top. At the barrier deflection joints, use nails  
to hold the preformed joint filler in place. If an approved method  
of holding the joint filler in alignment is used, the contractor  
may pour the complete barrier wall at one time.

602 If the forms for the barrier railing are held in place by  
120 concrete inserts in the deck slab, the inserts shall be removed  
when the form removal has been completed and the cavities in the  
deck slab cleaned and filled flush with a nonshrink epoxy mortar  
approved by the engineer.

602 CURING AAE-3 CONCRETE: The method of curing the deck concrete  
210 shall be in accordance with Section 602-3.7.2.2. The intent is  
to place the covering as soon as possible without causing a  
significant amount of blemish to the surface. Once the covering  
operation has started, it shall be a continuous operation to keep  
pace with the finisher. The covered concrete shall be kept  
continuously moist by a fog spray for five days, and no  
waterproof material such as polyethylene shall be used to cover  
the canvas or burlap.

602 The concrete shall be protected during the interval between final  
220 finishing and placement of the covering with a linseed oil-based  
emulsion containing at least 50 percent linseed oil and meeting  
the requirements of AASHTO M-148. The minimum rate of  
application shall be 200 square feet per gallon. This emulsion  
shall not be applied to surfaces which are to receive the special  
surface finish.

602 SPECIAL SURFACE FINISH: Special surface finish shall be required  
310 for all exposed surfaces of barrier, and exposed edges of slab.  
The intent of the finish is to provide a uniform color and to  
provide an aesthetic appearance. All surfaces which are to  
receive the special surface finish should be cleaned to remove  
laitance, form oil, fins, etc., and roughened by brushing and  
sandblasting so that special surface finish material will develop  
adequate bond to the prepared concrete surface.

602 The special surface finish shall be applied in two applications  
320 as one of the last items of work and only after the ordinary  
surface finish and cure period are complete. A spray  
application of special surface finish is required, and the rate  
of application for the commercially-packaged mortar shall be as  
recommended by the manufacturer.

602 The method of cure shall be as stated in the Specifications  
330 except that liquid membrane curing compounds will not be allowed  
on surfaces that are to receive the special surface finish.

610 CONCRETE: All superstructure concrete shall be Class AAE-3 or  
010 AAE-4. Concrete for the substructure shall be Class AE-1, AE-3,  
or AE-4. The class of concrete paid for will be that class shown  
on the plans.

FHWA REGION	STATE	FED. AID PROJ. NO.	SHEET NO.
8	ND.	BRF-1-006(02)	

610 Type I or Type II cement may be used.  
020

610 If the depth of the concrete risers between the tops of the 040  
girders and the bottom of the deck slab exceed the theoretical  
dimensions, the additional concrete required shall be furnished  
at no expense to the state.

610 The contractor will be expected to place the slab concrete  
050 for one bridge in one continuous operation. Minimum rate of  
placement shall be 40 cubic yards per hour.

612 REINFORCING STEEL: Dimensions for bent bars are given out to out  
010 and to tangent intersections unless otherwise noted. Bent bars  
shall be bent around AC1 standard size pins.

612 The bar fabricator shall add a prefix to all bar designations to  
020 differentiate between the several parts of the structure.

612 The top layer of transverse deck slab reinforcement shall be  
030 tied down with wire ties to the shear connectors of the beams.  
The ties shall be at intervals of five to six feet along the  
full length of all beams. Two wraps with 14-gauge plastic or  
epoxy-coated ties shall be used for this purpose.

612 All reinforcing steel shall be Grade 60.  
040

616 Girder web, flanges, stiffeners, and splice plates are A-572,  
011 Grade 50. All other structural steel shall be A-36.

616 The girders shall be cambered in the shop as detailed on  
015 Drawing 6-066.371-12. The shop camber diagram represents the  
total rise, in inches, to be cut into the web plates of the  
girders.

616 A minimum of two (2) contiguous beam sections shall be placed in  
020 their correct relative positions before drilling the holes for  
the field splice between those sections. The proper alignment  
shall be maintained between sections while reaming the holes.  
Templates shall not be used in lieu of the above shop assembly.  
Wire rope slings shall not be used to handle the beams; they  
shall be handled with beam clamps designed for that purpose or  
other devices approved by the engineer.

616 Shear connector on splice plates shall be moved to clear bolt  
025 holes.

616 Shop-welded connections of diaphragm angles to gusset plates may  
030 be used in place of the bolted connections shown. Details shall  
be shown on shop drawings.

616 All field connections shall be made with 7/8 inch diameter,  
035 ASTM A325 high-strength bolts.

616 Temporary or permanent attachments or devices that are not shown  
040 on the plans as part of the structure shall not be welded to the  
structural steel members during the fabrication and construction  
process.

616 Swedge bolts shall be provided by the steel fabricator, and the  
050 cost shall be incidental to the total cost of structural steel.

616 STEEL ERECTION: Falsework with provisions for jacking must be  
110 provided at all splice points during erections. All splice  
points in each girder line shall be brought to their proper  
elevation and supported in this position before the bolts in any  
of the splices are tightened to the required tension.

622 PILING: Piling shall be driven with a steam, air, or diesel  
110 hammer with a rated energy and ram weight not less than 32,073  
foot-pound-tons, as computed by the formula  $W(E-10,946) + .586E$ ,  
where W is the weight of the ram in tons and E is the rated  
hammer energy as allowed in Section 622 of the Specifications.  
In no case shall the ram weight be less than 4,000 pounds.

622 Test piles shall be driven to a bearing not less than 125% of  
115 the design load as determined by the dynamic formula in section  
622-3.3.

718 PAINT AND PAINTING: Paint shall conform to the Standard  
010 Specifications, Section 870-1.1 and 870-1.18. The finish coats  
shall be red color no. 31302 and shall meet Federal Standard  
No. 595 colors. The first coat shall be tinted to differentiate  
it from the second coat. The dry thickness of each finish and  
spot coat shall not be less than 1.5 mil for any reading. The  
dry thickness of the shop coat shall not be less than 1.5 mil  
for any reading.

750 LINSEED OIL TREATMENT: Linseed oil treatment shall not be  
010 started until all concrete work is completed and the asphalt curb  
seal is in place. Only one uniform application of .015 gallons  
per square yard shall be applied to the deck.

FHWA REGION	STATE	FED. AID PROJ. NO.	SHEET NO.
8	N.D.	BRF-1-006(02)	

900 The contractor shall submit the following shop drawings for  
010 approval by the bridge engineer before fabrication;

1. Structural steel.

900 The rock berm around pier 3 shall remain. Only that portion  
500 interfering with construction of the new pier shall be removed.  
The rock berm shall be restored to its original shape.

900 The existing structure is a three-span bridge with a clear  
510 roadway of 22 feet. The north span is 76' in length and consists  
of a concrete slab supported by rolled beams. The center span is  
a 175-foot steel truss with a concrete slab. The south span is a  
14-foot concrete slab.

The structural steel is to become the property of the contractor  
and shall be removed from the site. The concrete shall be broken  
up and disposed of at a landfill site approved by the engineer.

900 The contractor shall remove the existing bridge in a manner which  
515 will minimize the entry of debris into the water course.


900 The telephone conduit and gas line on the existing bridge will be  
520 removed by the owners by April 1, 1984.

900 CONDUIT MATERIALS: The contractor shall notify Giles Jantzer  
521 (222-7384) a minimum of 72 hours before the conduit is to be  
delivered to the project by Northwestern Bell Telephone Company.

Installation of conduit by contractor shall be incidental to  
AAE-3 Concrete.


900 ENVIRONMENTAL PROTECTION: This project has been classified as  
400 a categorical exclusion; therefore, the following special  
conditions, if applicable, must be met.

1. Any discharge of dredged or fill material will not occur in the proximity of a public water supply intake.
2. Any discharge of dredged or fill material will not occur in areas of concentrated shellfish production, unless the discharge is directly related to a shellfish harvesting activity.
3. The activity will not jeopardize a threatened or endangered species as identified under the Endangered Species Act, or destroy or adversely modify the critical habitat of such species. In the case of federal agencies, it is the agency's responsibility to review its activities to determine if the action "may affect" any listed species or critical habitat. If so, the federal agency must consult with the Fish and Wildlife Service and/or National Marine Fisheries Service.
4. The activity will not significantly disrupt the movement of those species of aquatic life indigenous to the waterbody (unless the primary purpose of the fill is to impound water).
5. Any discharge of dredged or fill material will consist of suitable material free from toxic pollutants (see Section 307 of Clean Water Act) in toxic amounts.
6. Any structure or fill authorized will be properly maintained.
7. The activity will not occur in a component of the National Wild and Scenic River System.
8. The activity will not cause an unacceptable interference with navigation.
9. The best management practices listed below shall be followed to the maximum extent practicable.

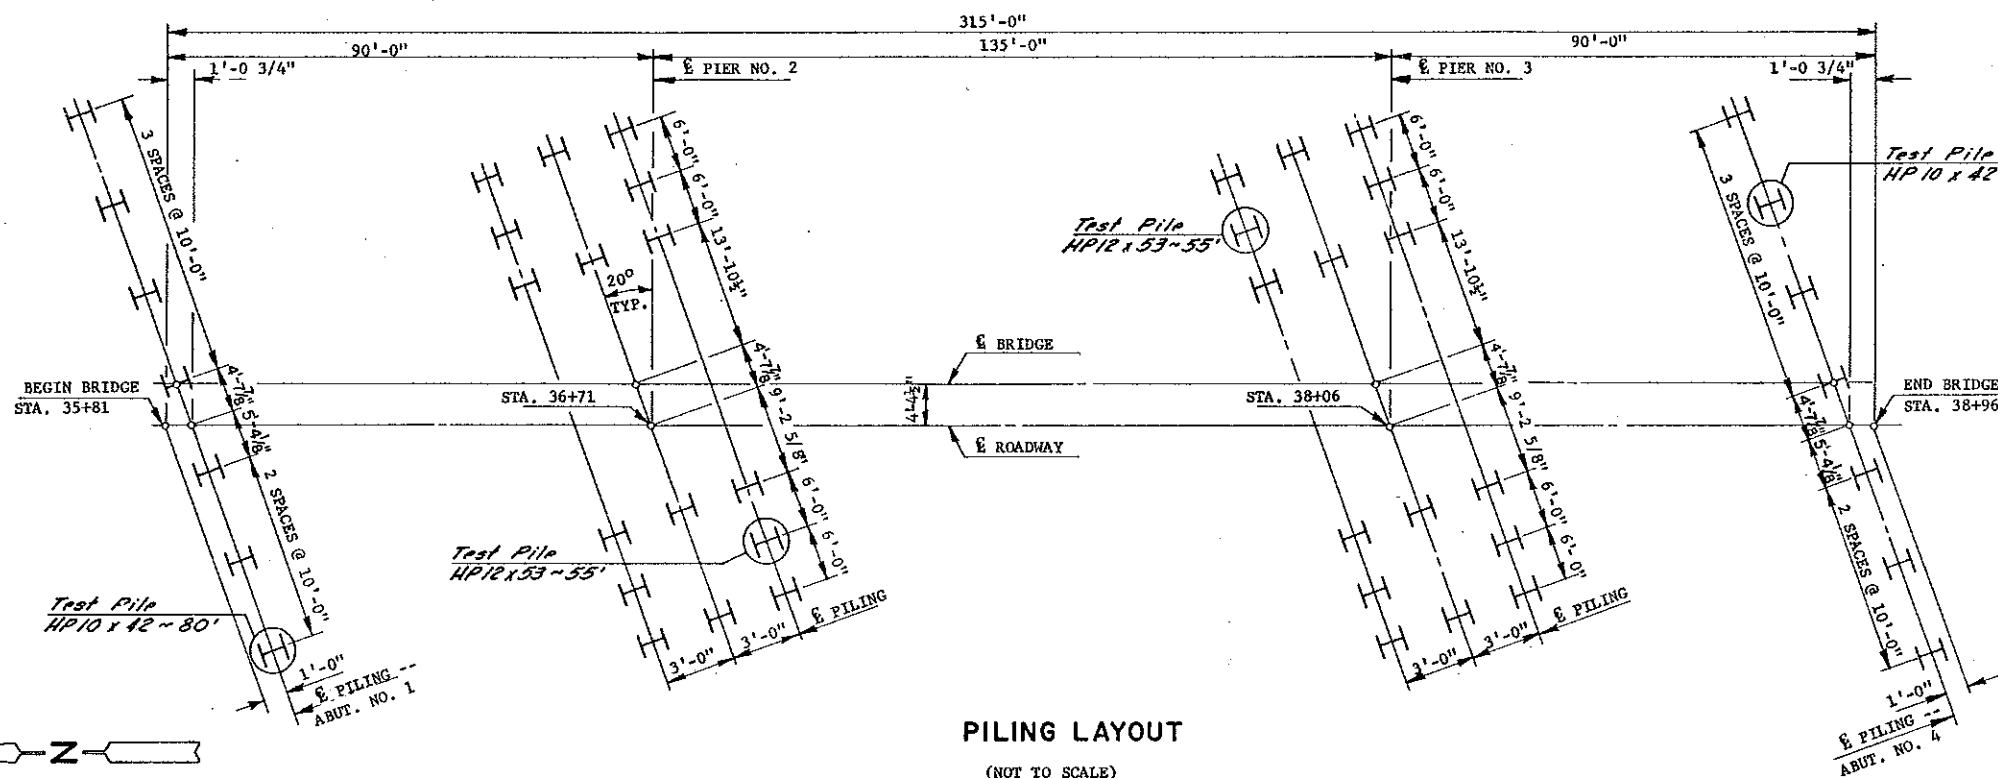





### HYDRAULIC DESIGN DATA

DRAINAGE AREA	3,330	SQ. MI.
DESIGN FREQUENCY	50	- YEAR
DESIGN DISCHARGE	42,825	C.F.S.
DESIGN STAGE	1656.6	M.S.L.
STREAM GRADIENT	0.0005	FT/FT
WATERWAY PROVIDED BELOW DESIGN STAGE	5,706	SQ. FT.
WATERWAY PROVIDED BELOW CLEARANCE	5,736	SQ. FT.
AVERAGE VELOCITY OF FLOW IN NATURAL CHANNEL	7.6	F.P.S.
DEPTH OF FLOW	31.1	FT.
VELOCITY OF FLOW UNDER BRIDGE	7.5	F.P.S.
FREEBORD PROVIDED	0.1	FT.
100-YEAR FREQUENCY DISCHARGE	52,575	C.F.S.
100-YEAR FREQUENCY STAGE	1658.1	M.S.L.
MAXIMUM RECORDED STAGE (1952)	1656.5	M.S.L.
MAXIMUM RECORDED DISCHARGE (1950)	30,500	C.F.S.
FREQUENCY OF MAXIMUM FLOOD	UNKNOWN	
MINIMUM WATER ELEVATION	1627.5	±

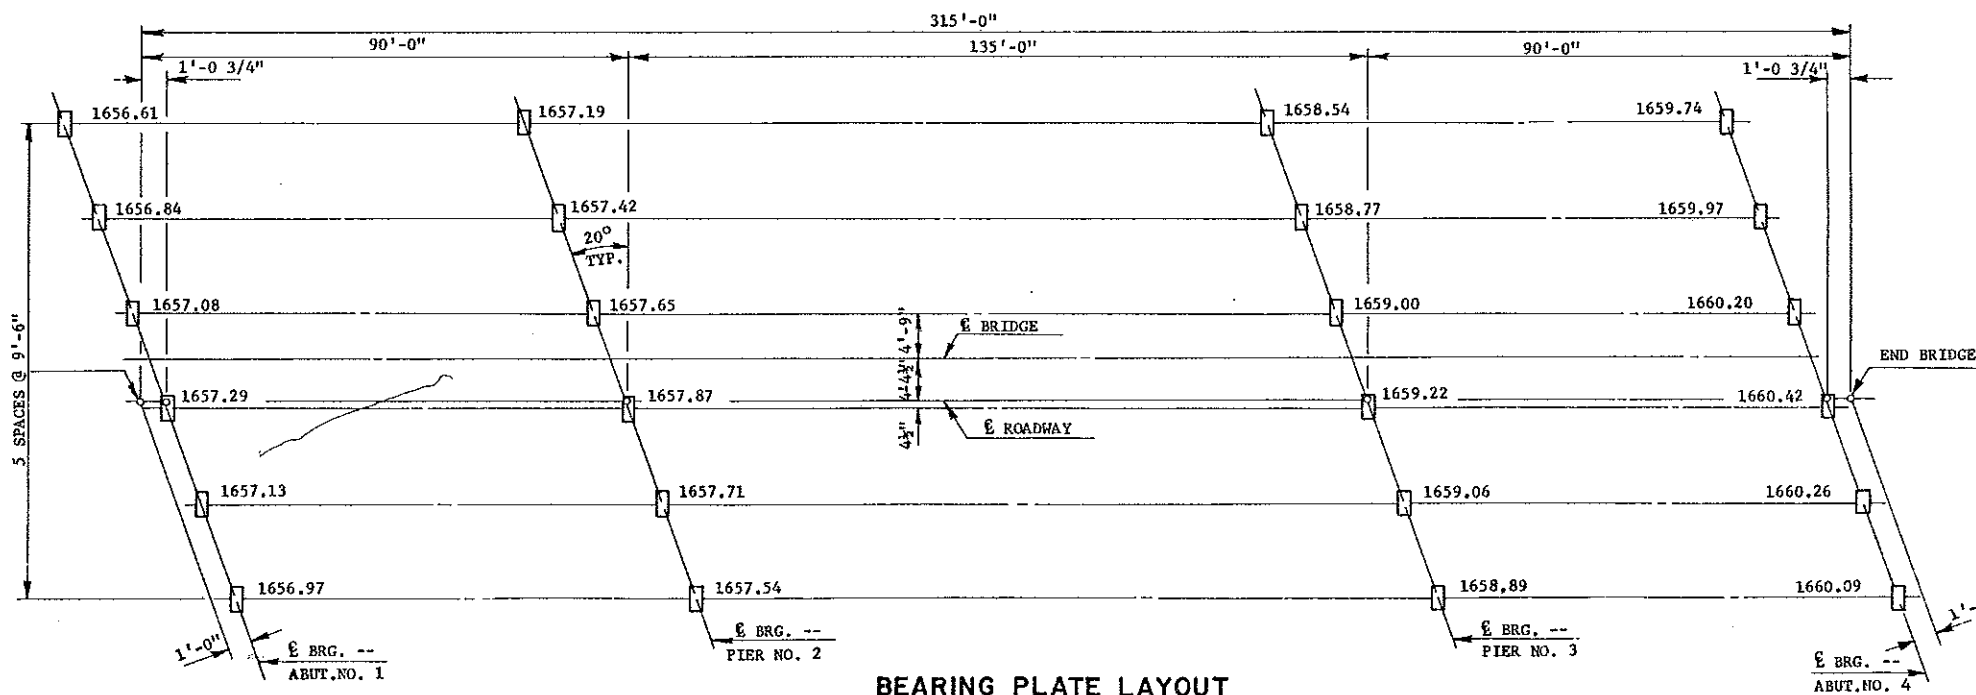

HEART RIVER BRIDGE  
PILING LAYOUT  
BEARING PLATE LAYOUT



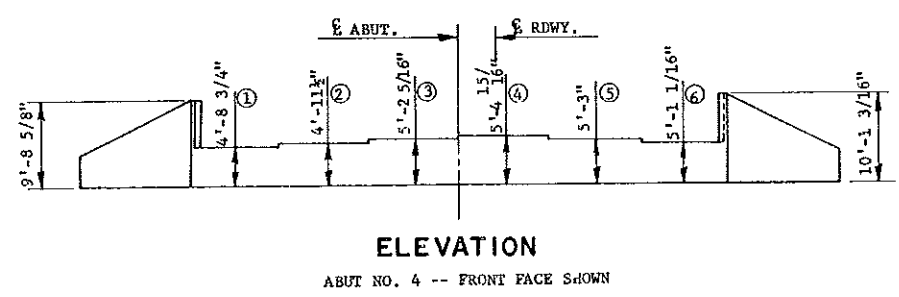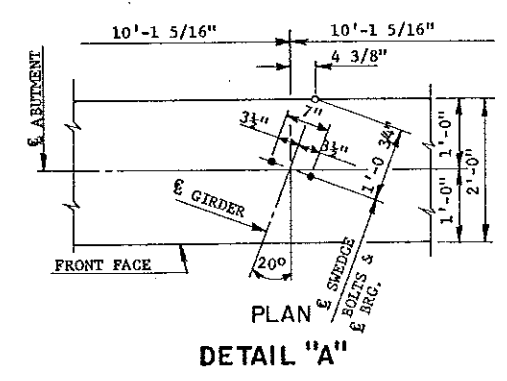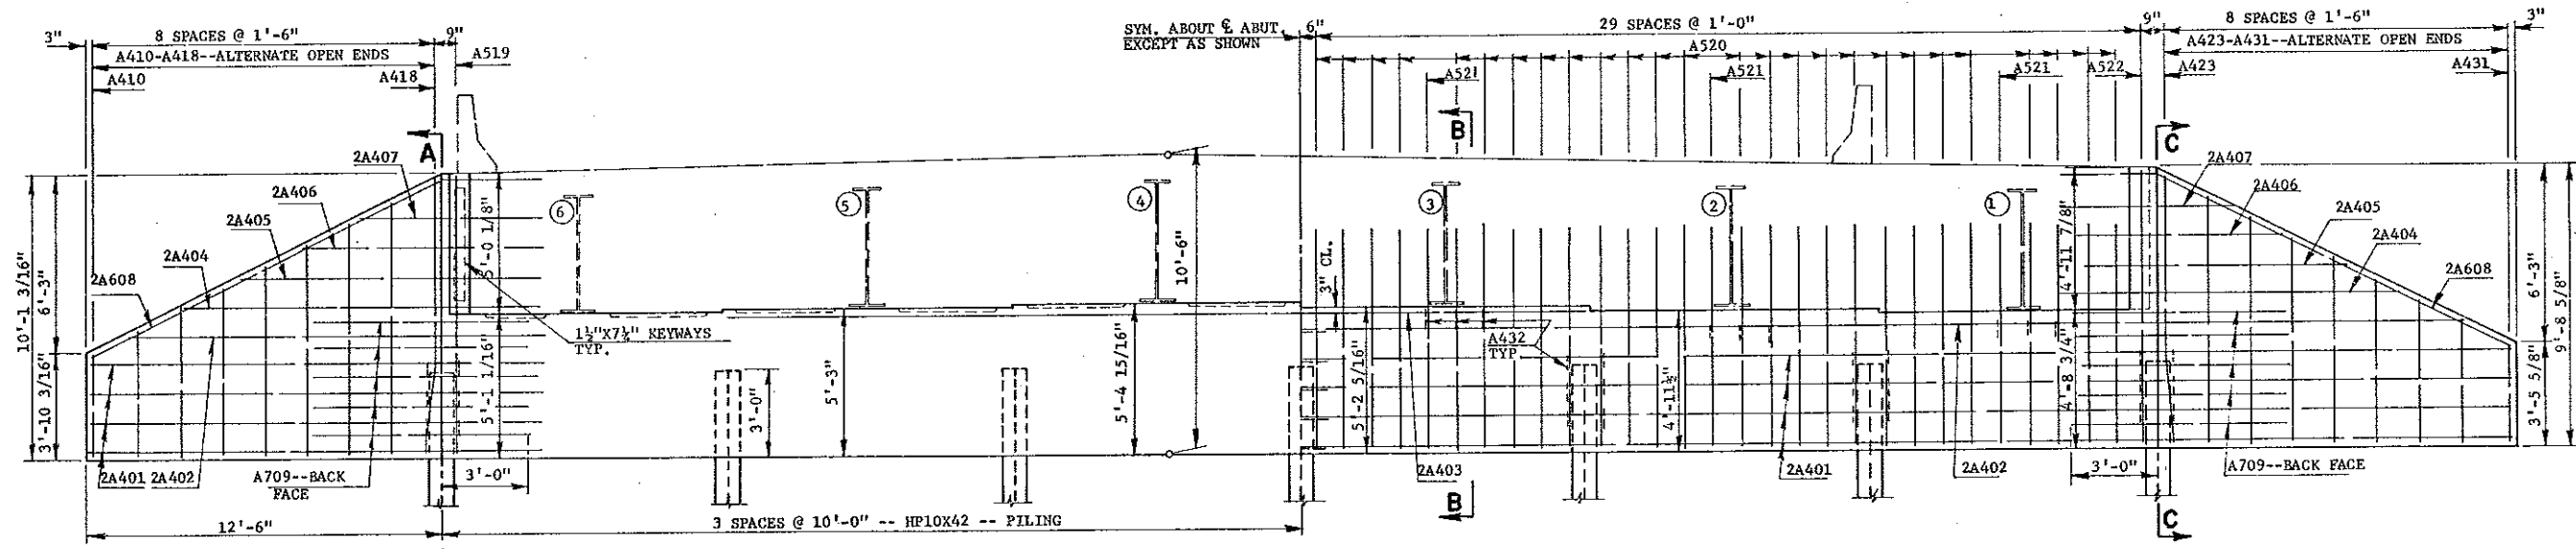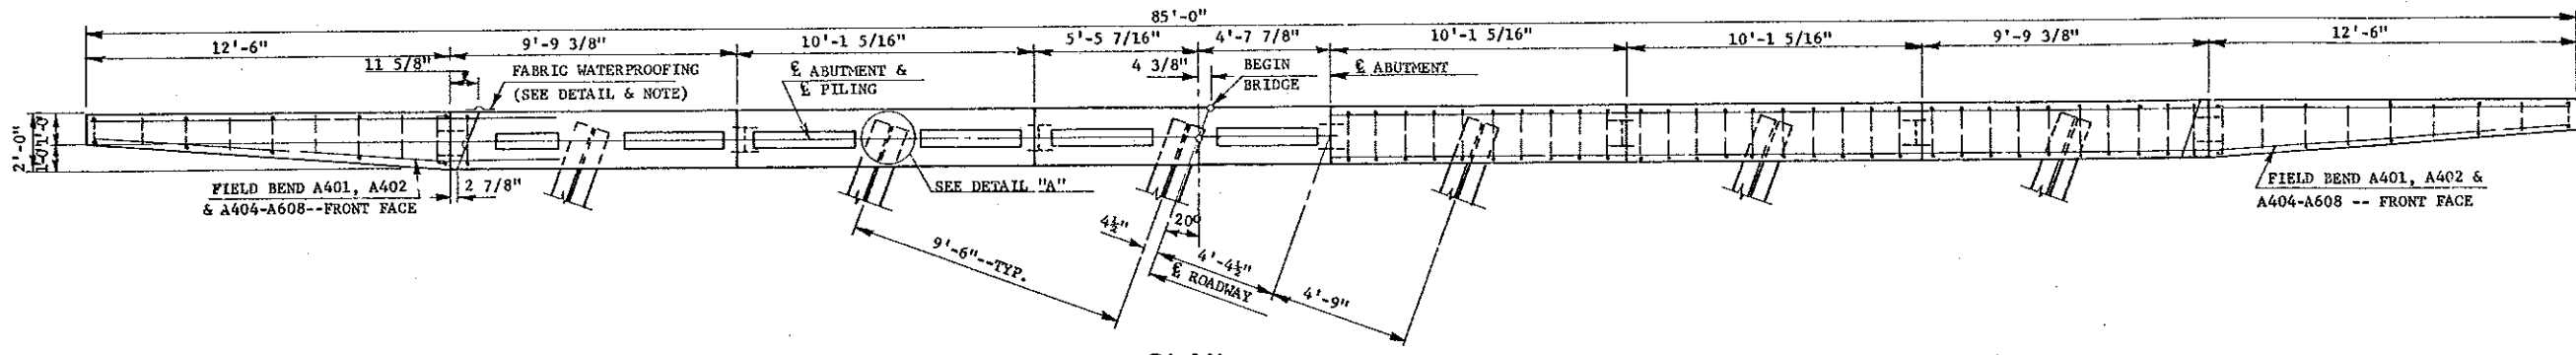

2" MIN. WIDTH OF MATERIAL -- 1'-0" (MIN) 2" MIN.




**TWO-PLY FABRIC WATERPROOFING DETAIL**

ALL MATERIALS AND WORK SHALL BE CONSIDERED INCIDENTAL TO THE PAY ITEM FOR CLASS AE-1 CONCRETE.


SEE DWG. 6-066.731-7 FOR SECTIONS A-A, B-B, C-C.

QUANTITIES	
SEE DWG. 6-066.731-7	



HEART RIVER BRIDGE  
ABUTMENT DETAILS

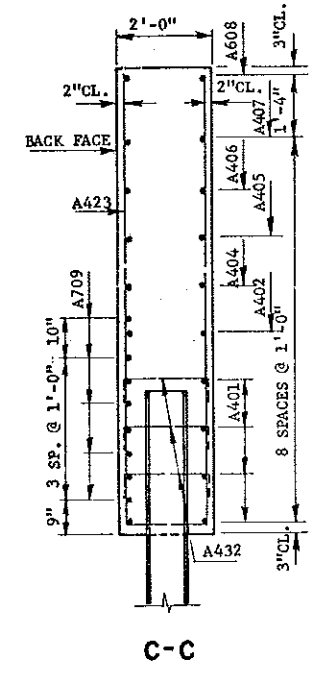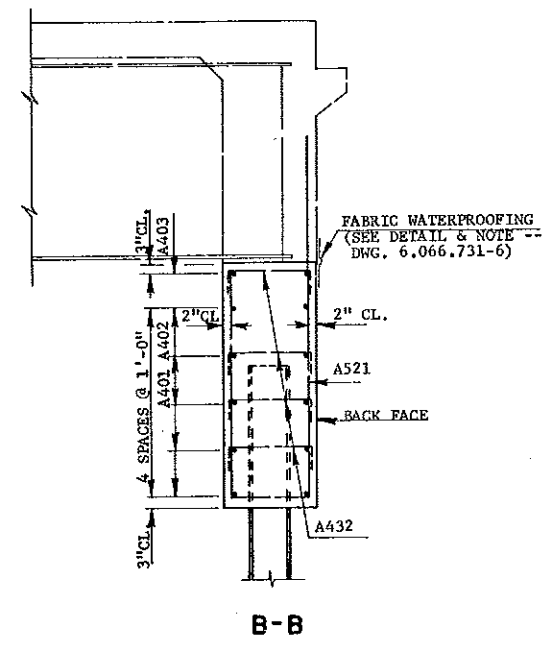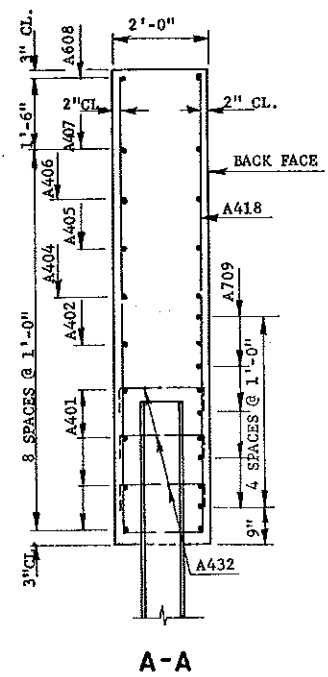

BAR LIST (ONE ABUT.)				
MARK	NO.	SIZE	LENGTH	SHAPE
A401	16	4	43'-2"	STR.
A402	4	4	42'-2"	"
A403	2	4	30'-0"	"
A404	4	4	12'-6"	"
A405	4	4	10'-6"	"
A406	4	4	8'-6"	"
A407	4	4	6'-6"	STR.
A608	4	6	17'-3"	BENT
A709	10	7	7'-6"	STR.
A410	1	4	7'-10"	BENT
A411	1	4	9'-5"	"
A412	1	4	11'-1"	"
A413	1	4	12'-8"	"
A414	1	4	14'-4"	"
A415	1	4	15'-11"	"
A416	1	4	17'-7"	"
A417	1	4	19'-2"	"
A418	1	4	20'-10"	"
A519	1	5	21'-0"	"
A520	52	5	17'-0"	"
A521	6	5	13'-8"	"
A522	1	5	20'-4"	"
A423	1	4	20'-2"	"
A424	1	4	18'-6"	"
A425	1	4	16'-11"	"
A426	1	4	15'-3"	"
A427	1	4	13'-8"	"
A428	1	4	12'-0"	"
A429	1	4	10'-5"	"
A430	1	4	8'-9"	"
A431	1	4	7'-2"	"
A432	60	4	2'-8"	BENT

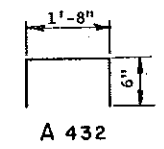

3'-7"	-- A410
4'-4"	-- A411
5'-1"	-- A412
5'-10"	-- A413
6'-7"	-- A414
7'-4"	-- A415
8'-1"	-- A416
8'-10"	-- A417
9'-7"	-- A418
9'-8"	-- A519
7'-8"	-- A520
9'-4"	-- A522
9'-3"	-- A423
8'-6"	-- A424
7'-9"	-- A425
7'-0"	-- A426
6'-3"	-- A427
5'-6"	-- A428
4'-9"	-- A429
4'-0"	-- A430
3'-3"	-- A431
8"	A410 & A431
9"	A411 & A430
11"	A412 & A429
1'-0"	A413 & A428
1'-2"	A414 & A427
1'-3"	A415 & A426
1'-5"	A416 & A425
1'-6"	A417 & A424
1'-8"	A418, A519, A520, A522 & A423

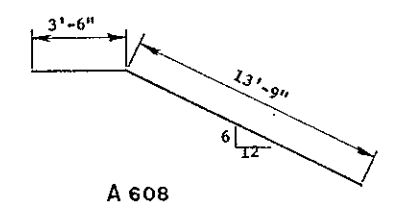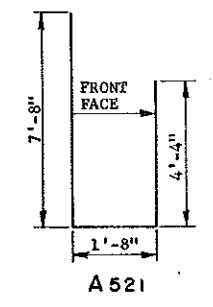


A410-A520 & A522-A431  
**BENT BAR DETAILS**  
 DIMENSIONS SHOWN ARE OUT TO OUT

QUANTITIES (ONE ABUT.)	
CLASS AE-1 CONCRETE	33.1 CY
REINFORCING STEEL	2298 LB
EXCAVATION (SEE LAYOUT)	
PILING (SEE LAYOUT)	

HEART RIVER BRIDGE  
 ABUTMENT DETAILS






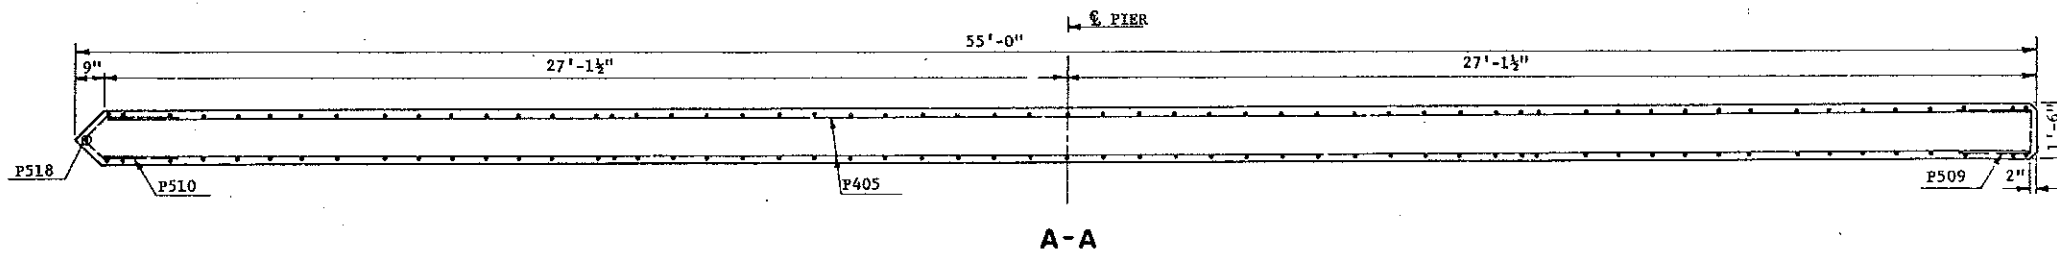


A-A


BAR LIST					
MARK	NUMBER		SIZE	LENGTH	SHAPE
	PIER 2	PIER 3			
F701	64	64	7	17'-6"	BENT
F602	12	12	6	14'-6"	STR.
P401	12	12	4	14'-2"	STR.
P402	4	4	4	14'-5"	"
P403	4	4	4	15'-5"	"
P604	4	4	6	53'-11"	"
P405	54	56	4	53'-11"	"
P406	2	2	4	54'-5"	"
P607	4	4	6	54'-5"	"
P608	4	4	6	10'-0"	STR.
P509	45	46	5	5'-1"	BENT
P510	31	33	5	5'-6"	"
P511	4	4	5	6'-2"	"
P512	57	57	5	9'-0"	BENT
P513	64	5	5	27'-4"	STR.
		64	5	28'-10"	STR.
P514	4	5	5	31'-0"	STR.
		4	5	32'-6"	STR.
P515	46	5	5	29'-5"	STR.
		46	5	31'-2"	STR.
P416	100	100	4	2'-2"	BENT
P517	23	23	5	5'-2"	STR.
P518	1	5	5	30'-9"	STR.
		1	5	32'-3"	STR.

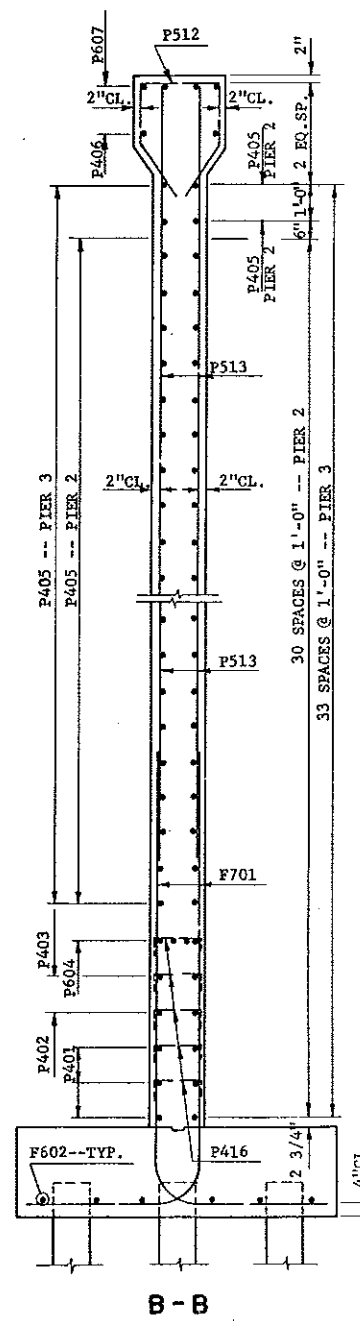

B-B

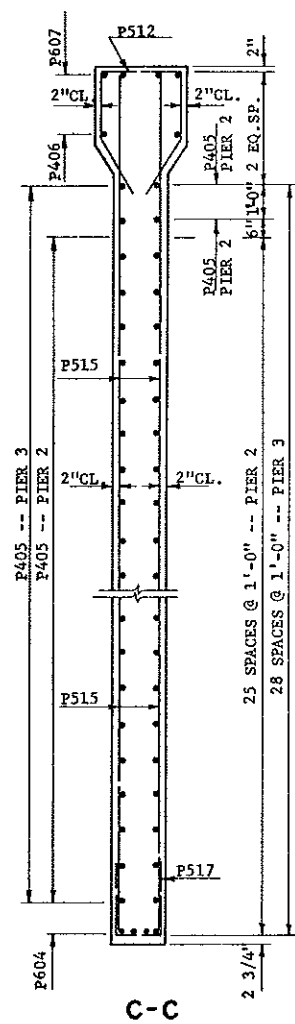


C-C

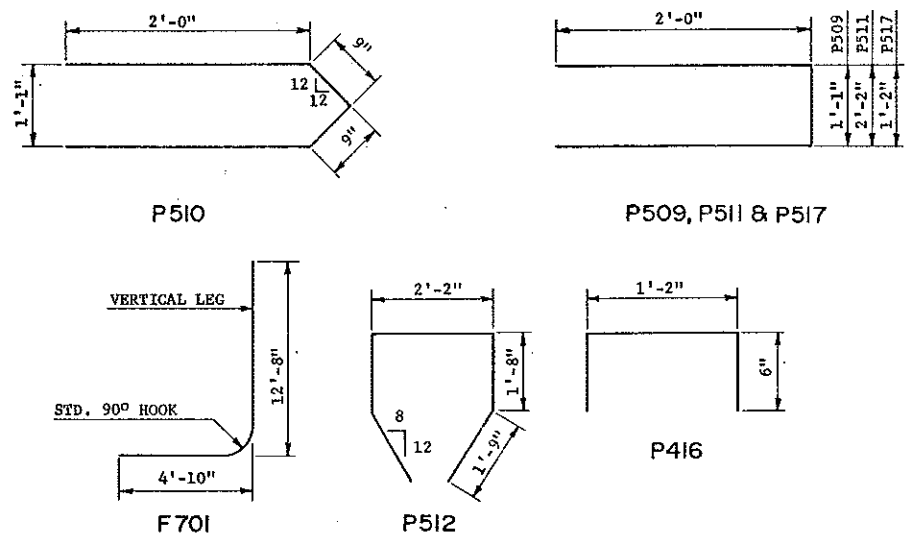

BENT BAR DETAILS

DIMENSIONS SHOWN ARE OUT TO OUT

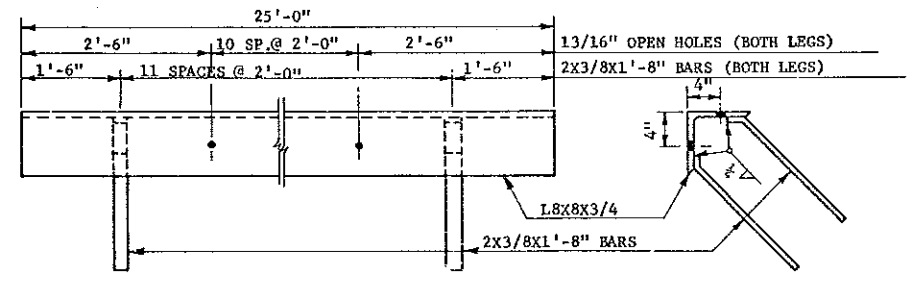

ICE NOSE ANGLE

QUANTITIES		
PIER 2		
CLASS AE-1 CONCRETE	130.2	CY
REINFORCING STEEL	9948	LBS
STRUCTURAL STEEL (A36)	2150	LBS
PIER 3		
CLASS AE-1 CONCRETE	134.7	CY
REINFORCING STEEL	10,396	LBS
STRUCTURAL STEEL (A36)	2150	LBS


HEART RIVER BRIDGE  
PIER 2 & 3 DETAILS








PLAN

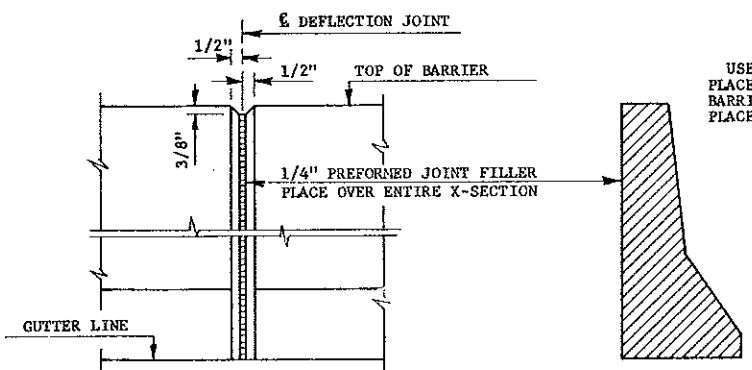


BARRIER DEFLECTION JOINT  
DETAIL "A"

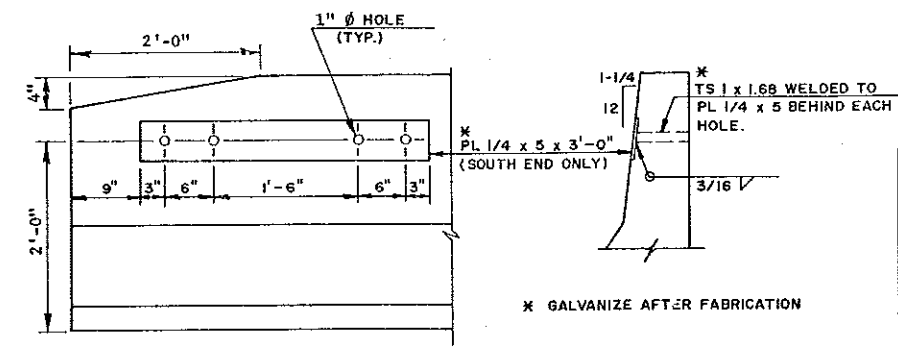


(SEE ALSO GUARDRAIL DETAILS)  
BARRIER END DETAILS

QUANTITIES	
SEE DWG. 6-066.731-15	


HEART RIVER BRIDGE  
SLAB LAYOUT

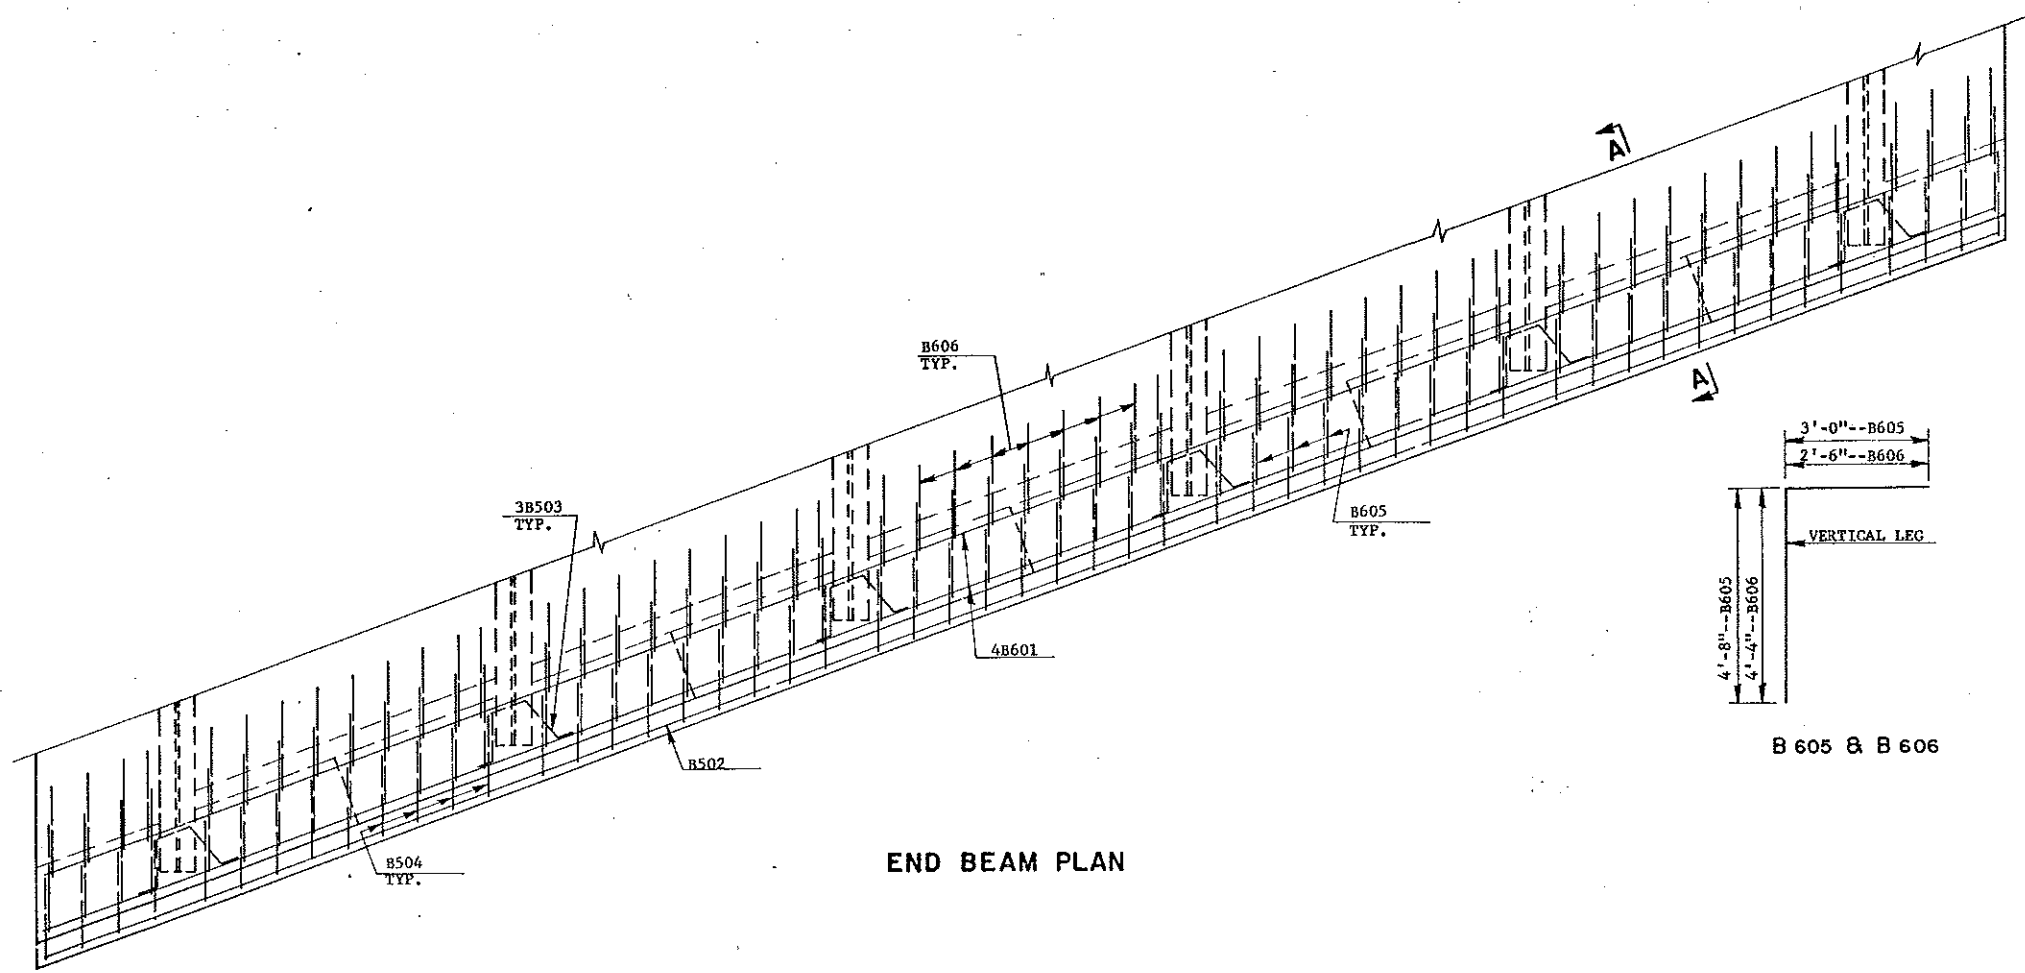


END BEAM PLAN

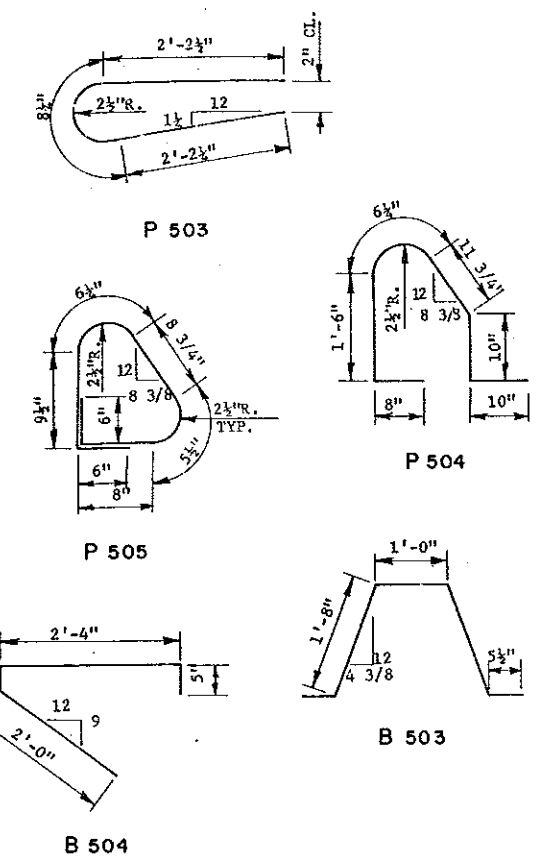


BENT BAR DETAILS

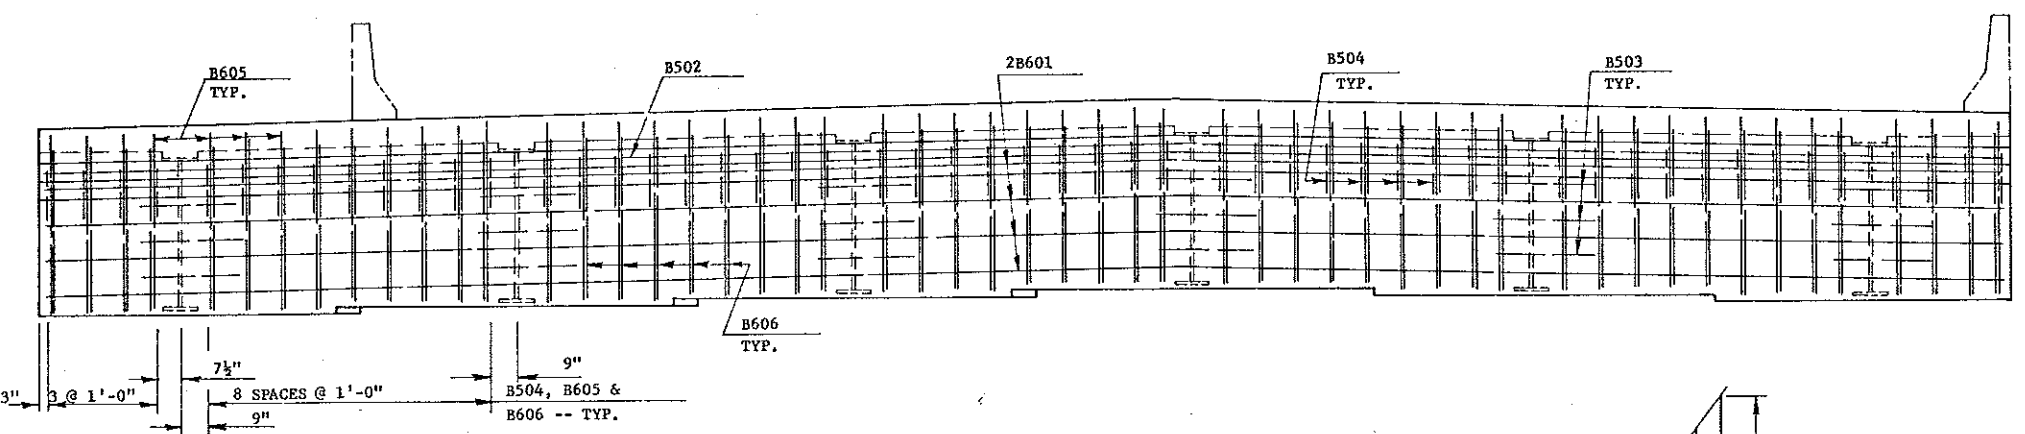

END BEAM ELEVATION

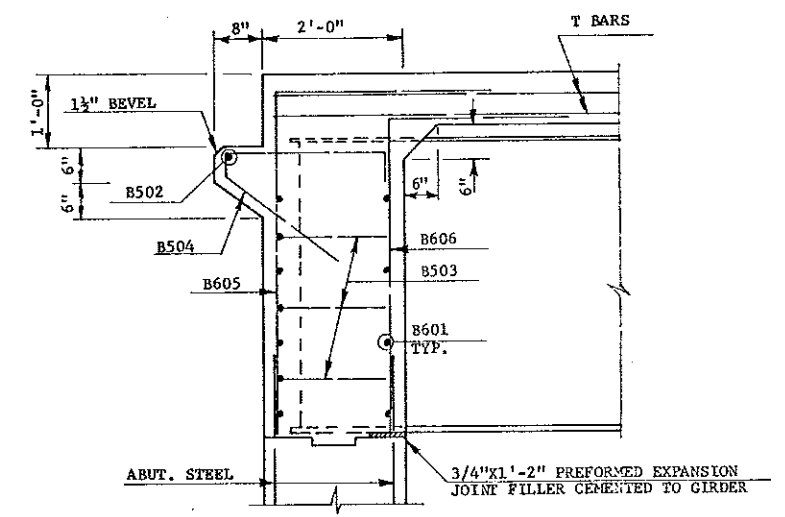

A-A

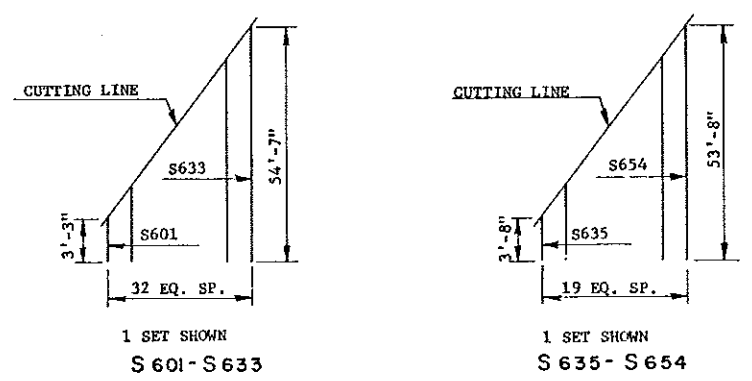

BAR CUTTING DIAGRAMS

BAR LIST				
MARK	NUMBER	SIZE	LENGTH	SHAPE
B601	16	6	58'-6"	STR.
B502	2	5	58'-6"	STR.
B503	36	5	5'-3"	BENT
B504	106	5	5'-1"	"
B605	106	6	7'-8"	"
B606	106	6	6'-10"	BENT
P401	112	4	22'-2"	STR.
P402	28	4	22'-2"	STR.
P503	644	5	5'-1"	BENT
P504	322	5	5'-4"	"
P505	322	5	4'-2"	"
P606	252	6	2'-0"	STR.
S601-33	2 sets	6	954'-3"	"
S634	510	6	54'-11"	"
S635-54	2 sets	6	573'-4"	"
S655	311	6	54'-11"	STR.
T501	275	5	60'-0"	STR.
T502	55	5	20'-11"	"
T603	108	6	22'-6"	"
T504	272	5	51'-7"	"
T505	136	5	60'-0"	STR.

\* EPOXY COATED REINFORCING STEEL



QUANTITIES	
CLASS AAE-3 CONCRETE	552.3 CY
REINFORCING STEEL	58,968 LBS
REINFORCING STEEL (EPOXY)	72,575 LBS

HEART RIVER BRIDGE

SLAB DETAILS








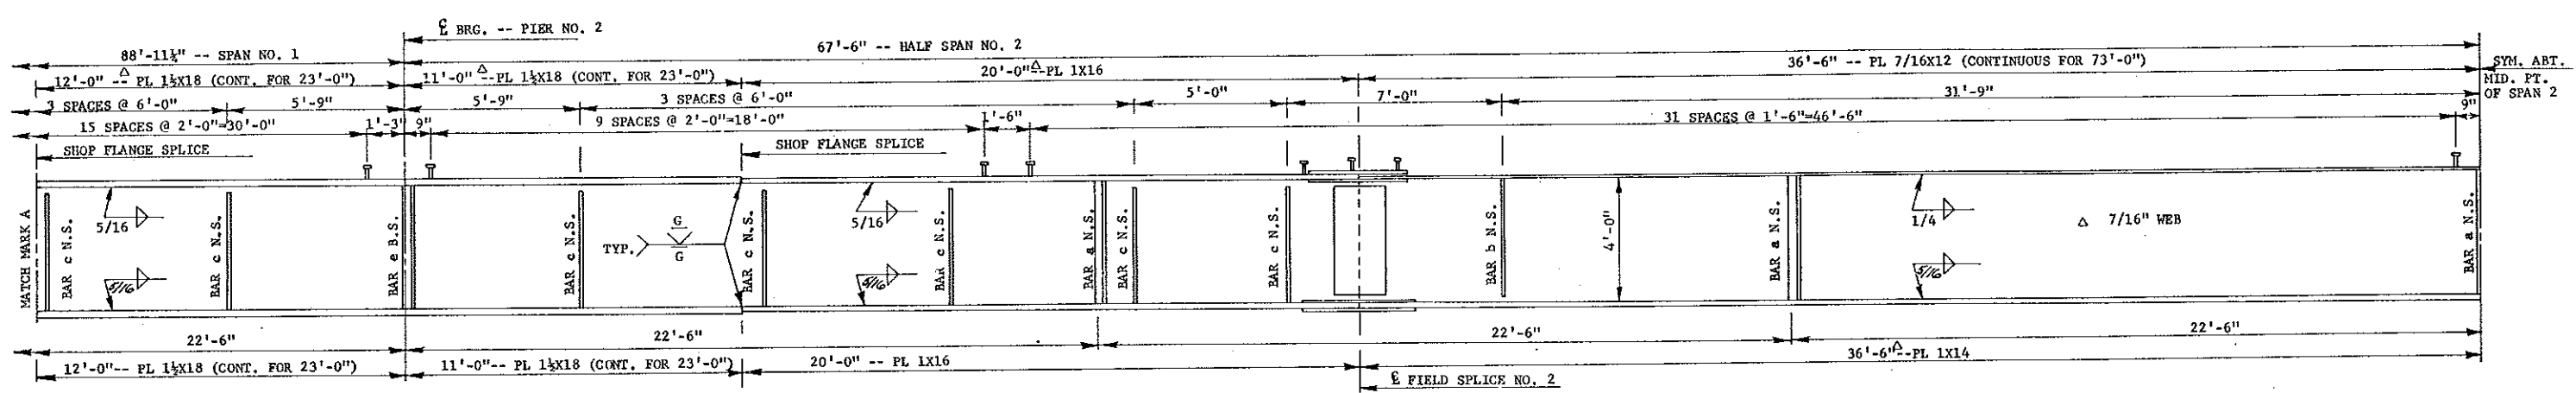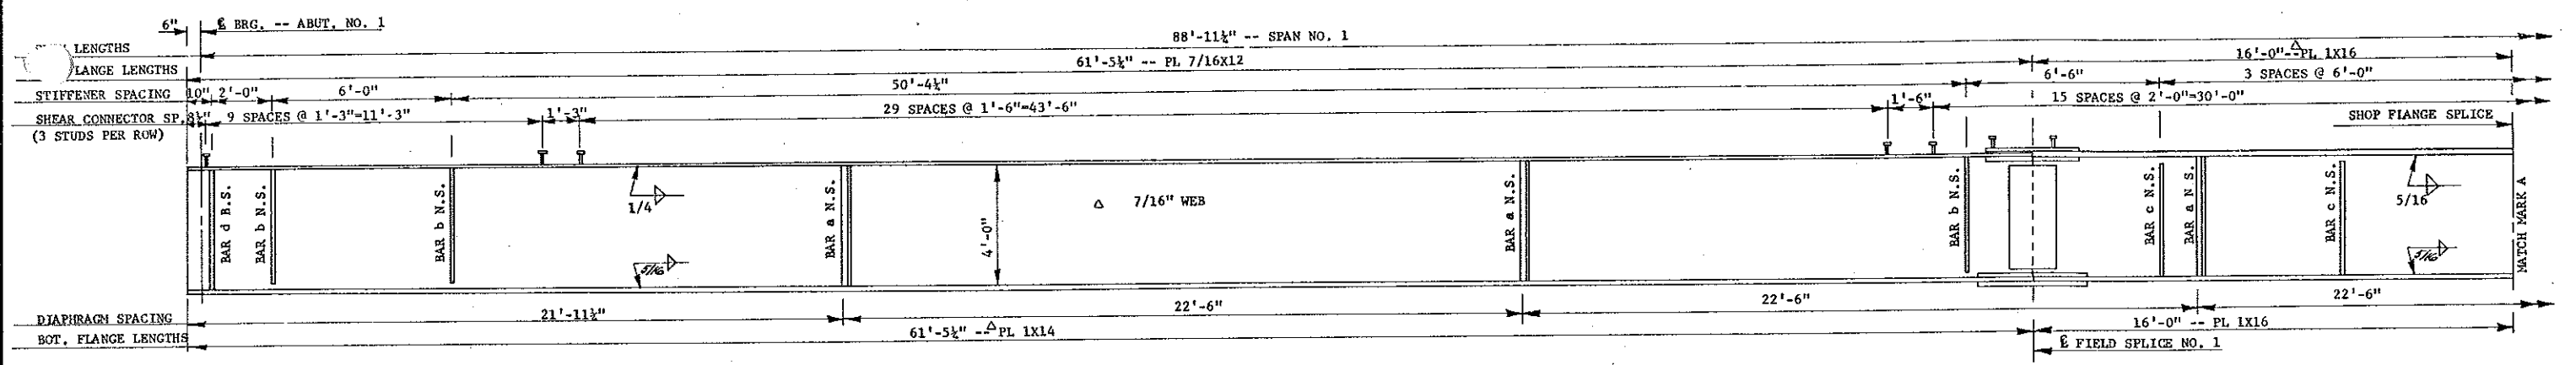


**GIRDER HALF ELEVATION**

NOTE: THE ELEVATION DETAILS SHOWN REPRESENT GIRDER NO. 1 IN A SIX GIRDER BRIDGE. OTHER GIRDERS ARE SIMILAR AND SHALL BE FABRICATED IN ACCORDANCE WITH DRAWINGS 6-066.371-10 THRU 6-066.371-12.

△ ALL PLATES DESIGNATED SHALL MEET THE "LONGITUDINAL CHARPY V-NOTCH" TEST FOR 15 FT.-LBS. AT 40°F. SAMPLING AND TESTING PROCEDURES SHALL BE IN ACCORDANCE WITH ASTM A673, THE (H) FREQUENCY OF HEAT TESTING SHALL BE USED.

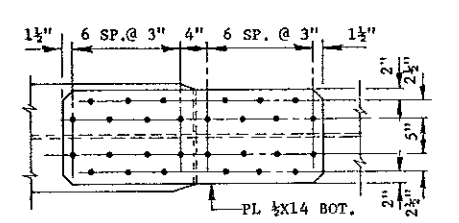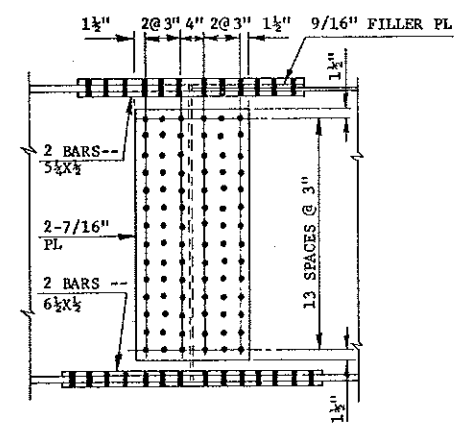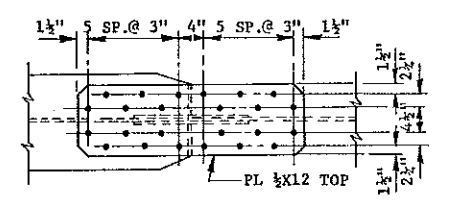


**FIELD SPLICE DETAIL**

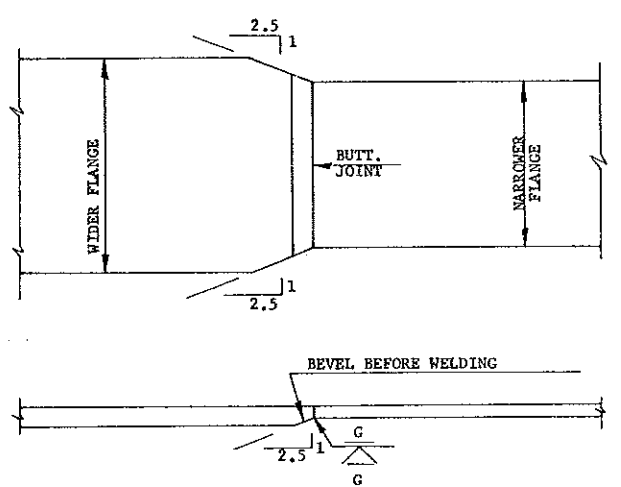

**TYPICAL SHOP FLANGE SPLICE**

BOTTOM FLANGE SPLICE -- TOP FLANGE SIMILAR

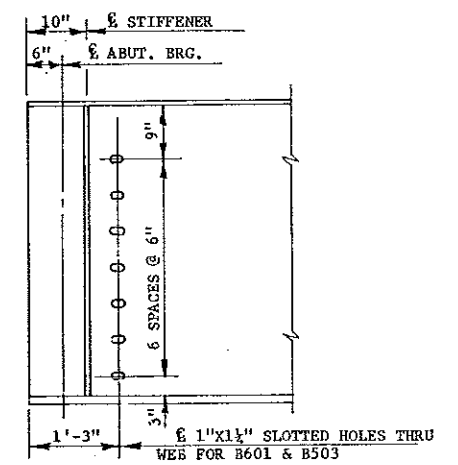


**GIRDER DETAIL**



NOMENCLATURE:  
N.S. = NEAR SIDE  
B.S. = BOTH SIDES

QUANTITIES	
SEE DWG.	6-066.371-12

**HEART RIVER BRIDGE**  
**WELDED GIRDER**  
**DETAILS**






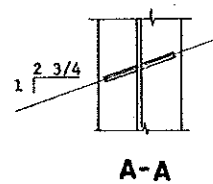


NOTE: BARS b, c, & d WELDED PERPENDICULAR TO WEB.

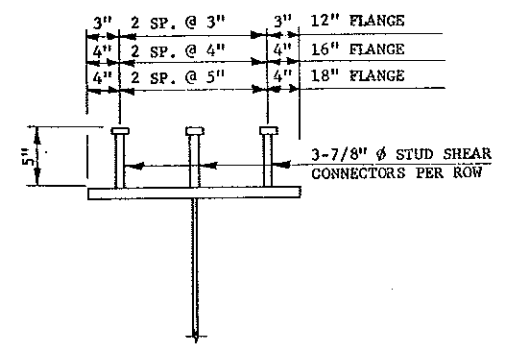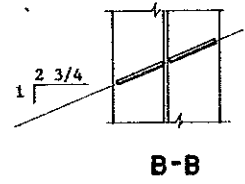

**SHEAR CONNECTOR DETAIL**

THE WEIGHT OF STUD SHEAR CONNECTORS IS INCLUDED WITH A36 STEEL

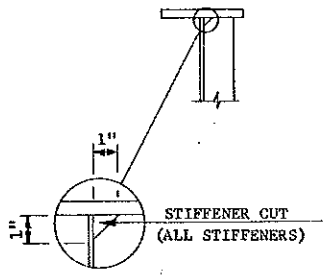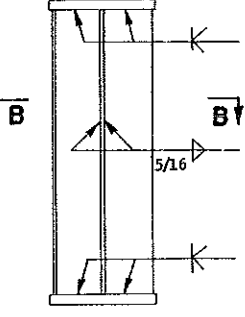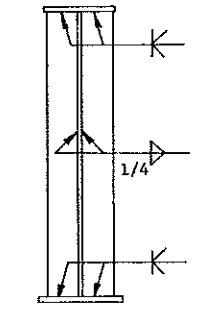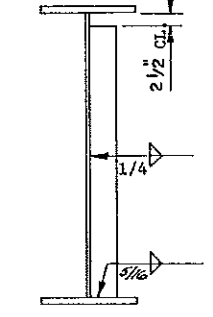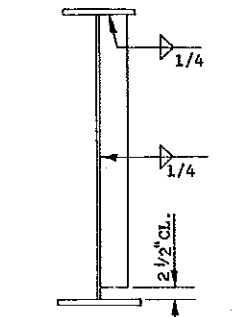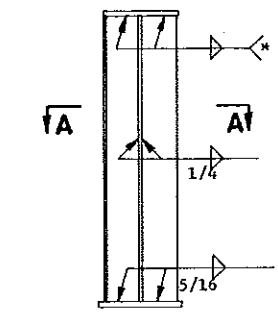

BAR a (5 3/4x5/8)  
@ INTERMEDIATE DIAPHRAGM CONNECTIONS

BAR b (4 1/2x1/2)


BAR c (4 1/2x1/2)

BAR d (5 1/2x5/8)  
@ ABUTS.

BAR e (7/8x8 1/2)  
@ PIER DIAPHRAGM CONNECTIONS


**WEB STIFFENER DETAILS**

TERMINATE STIFFENER TO WEB FILLET WELDS 1/2" FROM THE END OF THE STIFFENERS

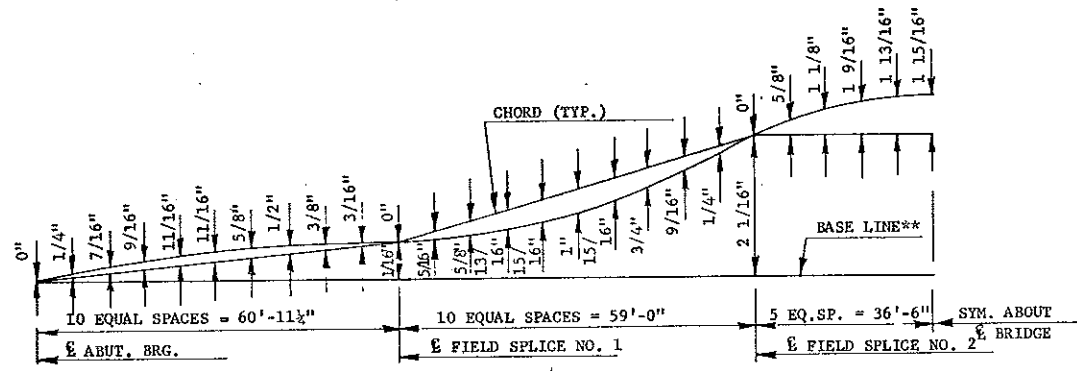


**SHOP CAMBER DIAGRAM**

\*\*BASE LINE REPRESENTS A CHORD BETWEEN ABUTMENT BEARINGS.

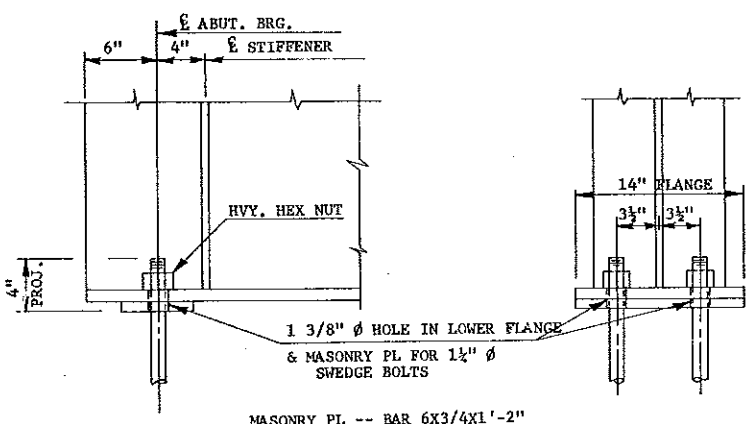

MASONRY PL -- BAR 6X3/4X1'-2"  
SWEDGE BOLTS -- 1 1/2" Ø X 2'-0"

**ABUTMENT BEARING DETAILS**

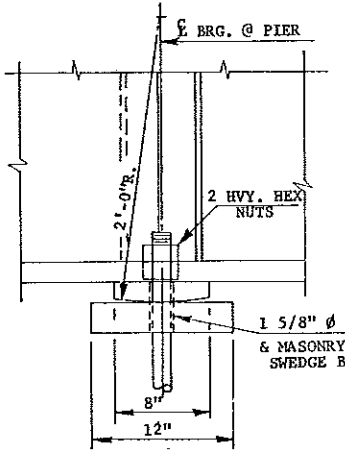

SOLE PL -- BAR 8X1 1/2X2'-2"  
MASONRY PL -- PL 2 1/2X12X2'-2"  
SWEDGE BOLTS -- 1 1/2" Ø X 2'-0"

**PIER BEARING DETAILS**

* WELD SIZE	FLANGE THICKNESS
1/4	7/16"
5/16	1" & 1 1/2"


QUANTITIES	
STRUCTURAL STEEL A572	338,031 LBS
STRUCTURAL STEEL A36	26,116 LBS

HEART RIVER BRIDGE  
WELDED GIRDER  
DETAILS

# SECTION LINE & PRIVATE DRIVE APPROACHES (RURAL)


TR. NO.	STATE	NO. AND PROJ. NO.	SCALE
8	N.D.		

D-203-8

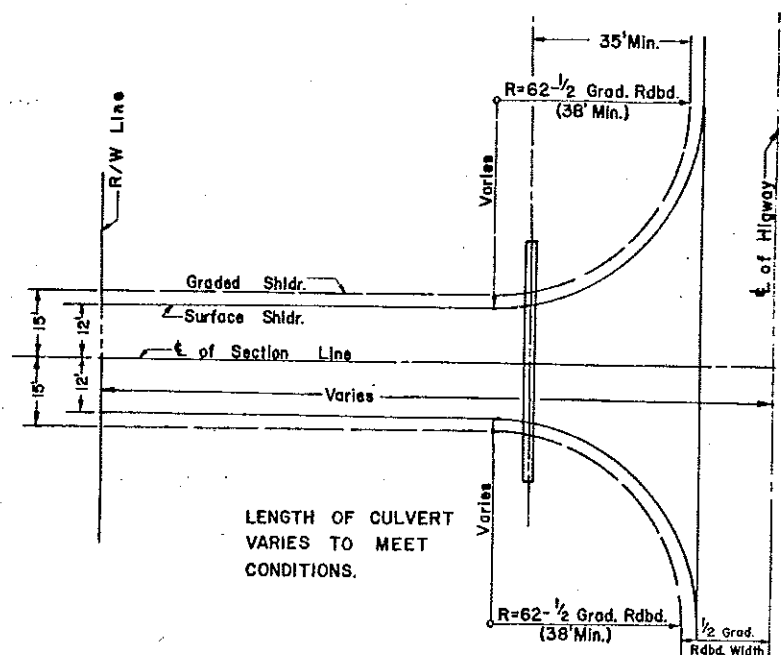


LENGTH OF CULVERT  
VARIES TO MEET  
CONDITIONS.

PLAN VIEW SECTION LINE APPROACH (WITHOUT SKEW)

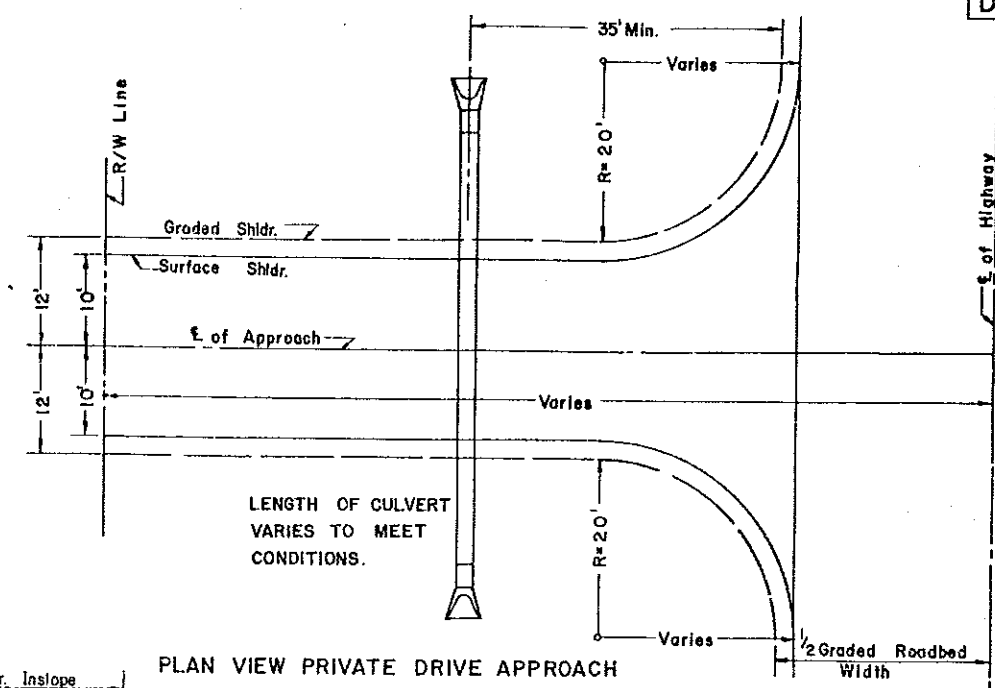

LENGTH OF CULVERT  
VARIES TO MEET  
CONDITIONS.


PLAN VIEW PRIVATE DRIVE APPROACH

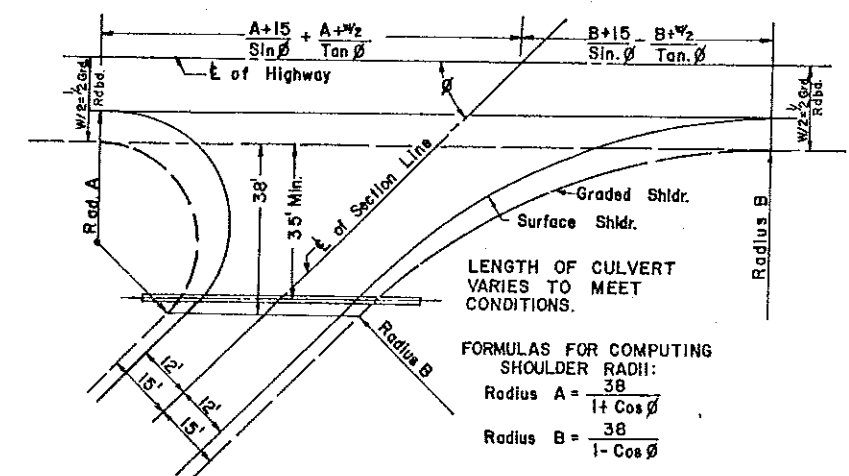


PLAN VIEW SECTION LINE APPROACH (SKEWED)

NOTE:  
DIMENSIONS SHOWN FOR SURFACING ARE FOR  
AGGREGATE SURFACE COURSE OR BITUMINOUS  
SURFACE CONSTRUCTED WITH GRADING CONTRACT.  
APPR. GRADES AND TYPICAL SECTIONS APPLY  
TO BOTH PRIVATE DRIVES AND SECTION LINE  
APPROACHES.


- FOOT NOTES
- ① 10% Max. on Field Drives
  - ② 3:1 Slope - 20' to 30' Fill
  - ③ 2:1 Slope on Fills over 30'
  - ④ 15' on Sec. Line Appr's.
  - ⑤ 12' on Sec. Line Appr's

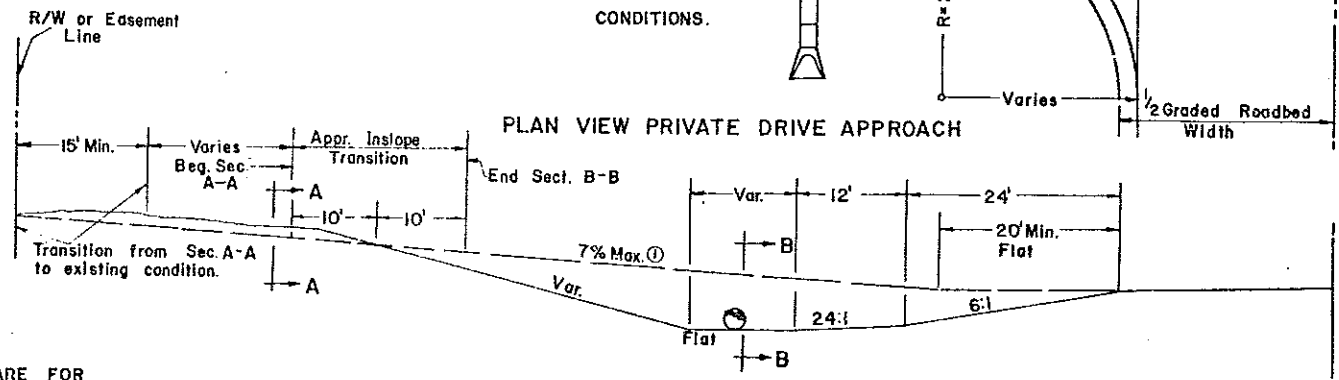


APPROACH GRADE ON CUT SECTION

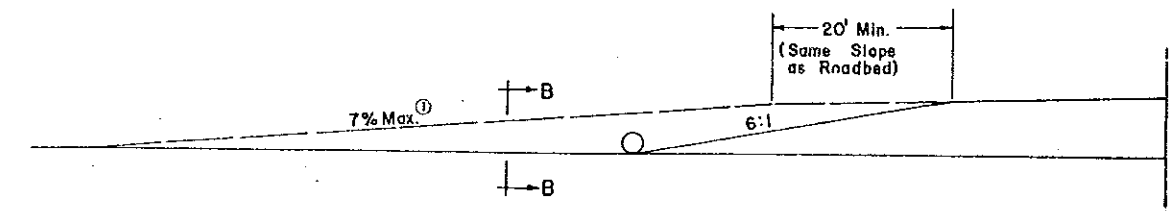


APPROACH GRADE ON FILL SECTION 12 FEET OR LESS

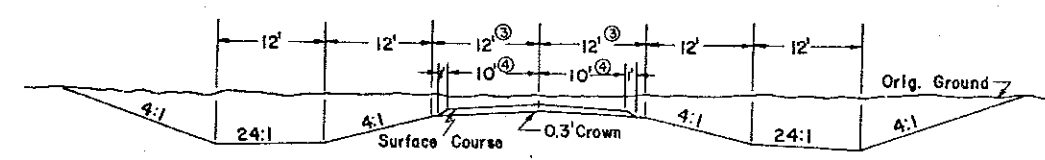


SECTION A-A

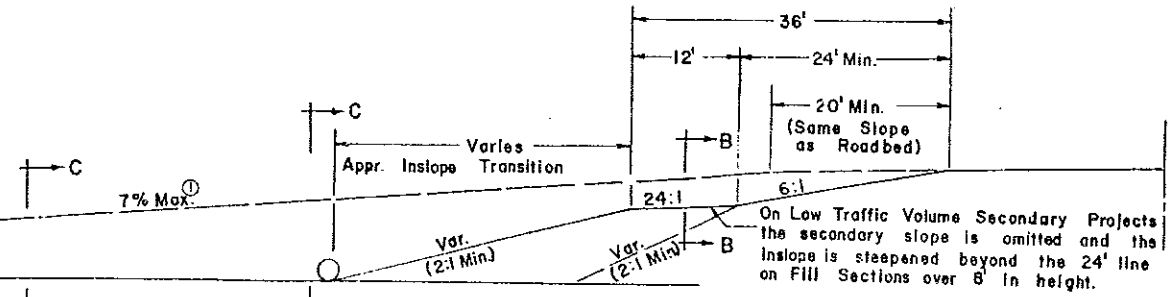

APPROACH GRADE ON FILL SECTION OVER 12 FEET

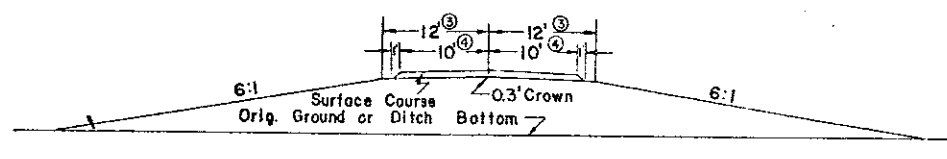

SECTION B-B

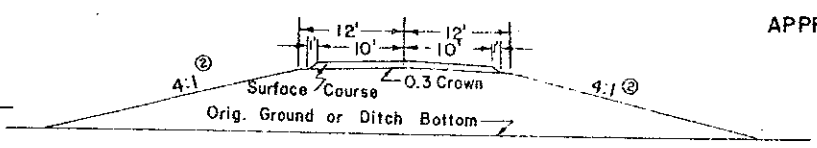

SECTION C-C

1-1-75		NORTH DAKOTA STATE HIGHWAY DEPARTMENT
DATE	REVISIONS	
	CHANGE	Submitted: _____ Design Engineer
		Recommended: _____ Asst. Chief Engineer Pre-Construction
		Approved: _____ Chief Engineer

# CORRUGATED STEEL PIPE CULVERTS AND END SECTIONS (ROUND PIPE)

**NOTES:**

Pipe and Connecting Bands shall conform to applicable sections of 1'DSHD Standard Specifications and to AASHTO M-36.



Top edge of all End Sections to have tubing reinforcement or rolled tubed reinforcement (See Section A-A). The tubing is to be supplemented with 2"x2"x 1/4" Galv. Angle for 50" thru 72" Dia. and 2 1/2"x2 1/2"x 1/4" Galv. Angle for 78" and 84" Dia. Angles to be attached by Gal. 3/8" bolts and nuts. Angles are to extend from Pipe to the corner wing bend.

Elongated pipe shall be factory preformed so that the vertical diameter shall be 5% greater and the horizontal diameter 5% less than a circular pipe.


Fill Height Tables are based on the following criteria:

1. Embankment weight = 120 lb/ft<sup>3</sup>
2. Max. pipe deflection = 5%
3. Bedding - Class C
4. Compaction = 95% Proctor Density
5. Modulus of passive soil resistance (E') = 1400 psi
6. H-20 Live Load





This connection for 42" thru 84" diameter pipe to be bolted or riveted to the end section with 3/8" Galv. bolts or rivets.

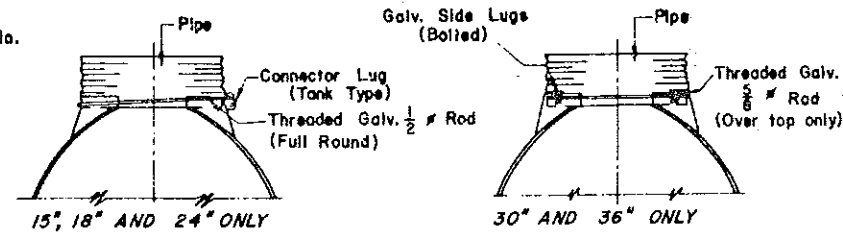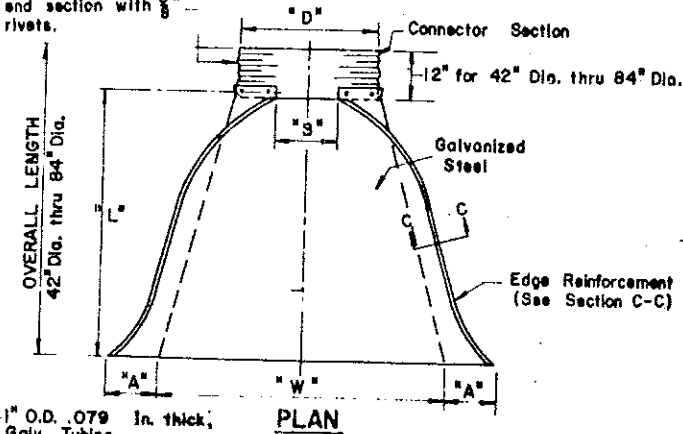

ROD CONNECTION DETAILS

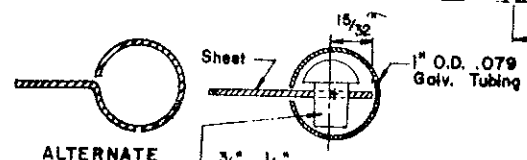

SECTION C-C

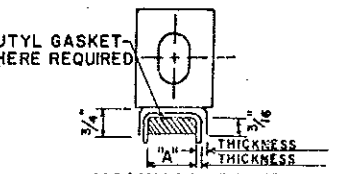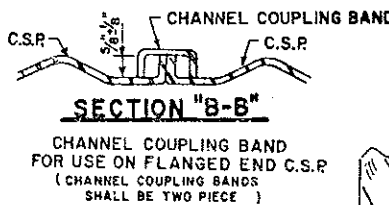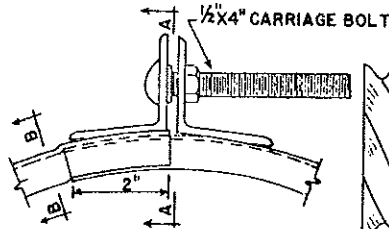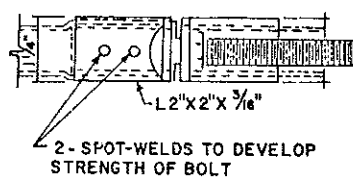


**NOMINAL DIMENSIONS**

THICKNESS	"A"	FOR USE WITH C.S.P.
0.079"	3/4"	0.09" THICK OR LIGHTER
0.109"	1"	0.138" THICK OR HEAVIER




SECTION "A-A"

**CORRUGATED STEEL PIPE FLANGE BAND DETAILS**

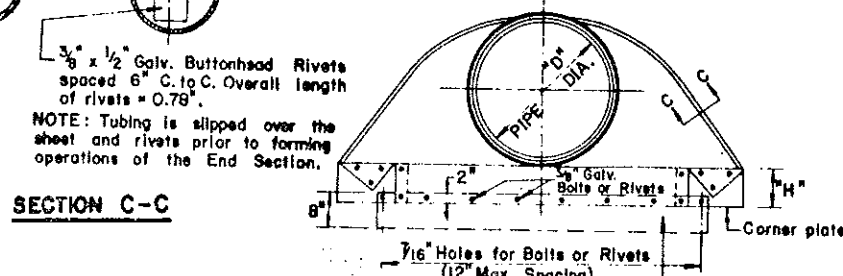


SECTION C-C

ELEVATION

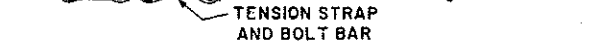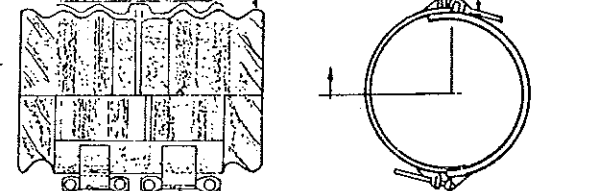
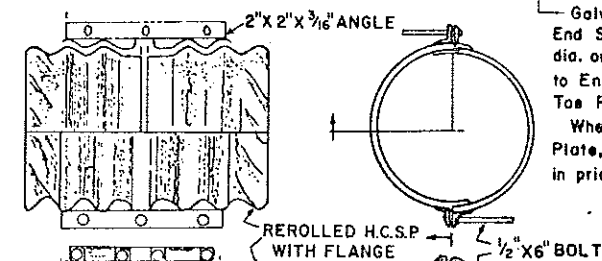


Galv. Toe Plate required on End Sections for pipe of 30" dia. or larger. Plate to be fastened to End Section in field. Thickness of Toe Plate to be same as End Section. Where Toe Plate is needed the Toe Plate, Bolts and Nuts are to be included in price bid for End Sections.

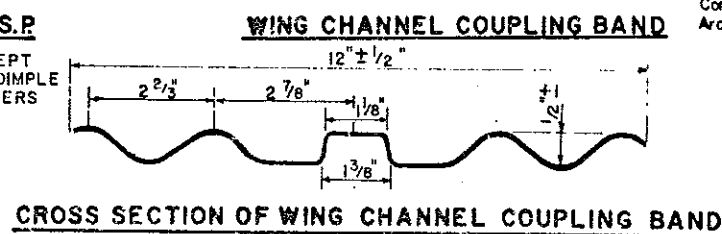

**WING CHANNEL COUPLING BAND FOR ANNULAR C.S.P. OR REFORMED H.C.S.P.**

**CONNECTING BAND DETAILS FOR HELICAL, WELDED - SEAM CULVERT**

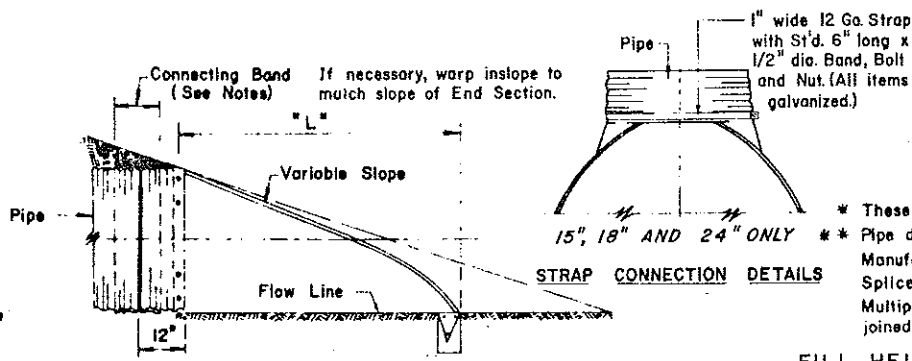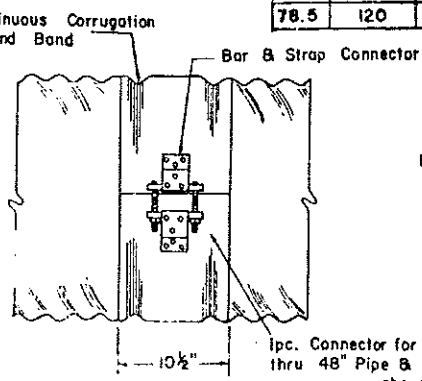

TYPICAL CROSS-SECTION (Showing Connector Section)

STRAP CONNECTION DETAILS

**FILL HEIGHT TABLES**


**RIVETED, WELDED OR HELICAL FABRICATION**

**3" BY 1" CORRUGATIONS**

**2 2/3" BY 1/2" CORRUGATIONS**


WATERWAY AREA SQ. FT.	PIPE DIA. (IN.)	MIN. COVER (IN.)	MAX. FILL HEIGHTS OVER TOP OF PIPE						WATERWAY AREA SQ. FT.	PIPE DIA. (IN.)	MIN. COVER (IN.)	MAX. FILL HEIGHTS OVER TOP OF PIPE				
			GALV METAL THICKNESS (IN.)									GALV METAL THICKNESS (IN.)				
			.064	.079	.109	.138	.168	.064				.079	.109	.138	.168	
7.1	36	12	48	60	78 (88)	89 (106)	101 (118)	1.2	15	12	67	73				
9.6	42	12	41	51	64 (76)	71 (94)	79 (104)	1.8	18	12	56	61				
12.6	48	12	36	45	57 (66)	61 (80)	66 (88)	3.1	24	12	42	46	59			
15.9	54	12	32	40	52 (59)	55 (71)	59 (79)	4.9	30	12	34	36	47			
19.6	60	12	29	36	49 (53)	51 (64)	54 (71)	7.1	36	12	28	30	39	41		
23.8	66	12	26	33	47	49 (58)	51 (64)	9.6	42	12	31	43	46 (67)	48 (70)	50 (73)	
28.3	72	12	24	30	44	47 (53)	49 (58)	12.6	48	12	27	37	45 (58)	46 (61)	47 (64)	
33.2	78	12	22	28	41	46 (49)	47 (54)	15.9	54	12		33	43 (52)	44 (54)	45 (57)	
38.5	84	12	21	26	38	45	46 (51)	19.6	60	12			43 (47)	43 (49)	44 (51)	
44.2	90	12	19	24	35	43	45	28.8	66	12			42	43	43 (47)	
60.3	96	12	18	22	33	40	44	28.3	72	12				41	43	
66.7	102	24	17	21	31	38	42	33.2	78	12					39	
83.6	108	24		20	30	35	39	38.5	84	12					35	
70.9	114	24		19	29	34	37									
78.5	120	24			27	32	35									

VALUES FOR ELONGATED PIPE ARE SHOWN IN PARENTHESES

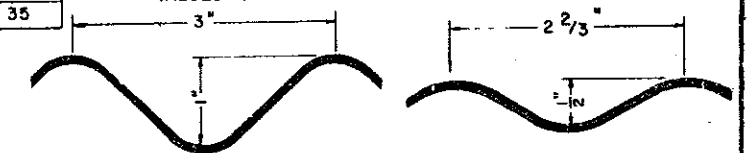

3" BY 1" CORRUGATIONS

2 2/3" BY 1/2" CORRUGATIONS

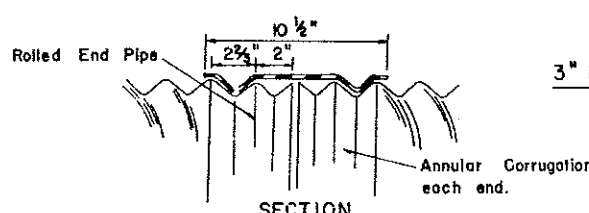

SECTION


6-1-74 REVISIONS	
DATE	CHANGE
1-1-75	Connecting Band
3-16-77	Connecting Strap
5-1-78	Flange Band Details

NORTH DAKOTA STATE HIGHWAY DEPARTMENT  
Submitted: *D. P. Thomas*  
Design Engineer  
Recommended: *[Signature]*  
Asst. Chief Engineer  
Pre-Construction  
Approved: *[Signature]*  
Chief Engineer


FHWA REGION	STATE	PROJECT	SHEET NO.
8	N.D.		

D-708-1


VALLEY GUTTER AND CURB & GUTTER

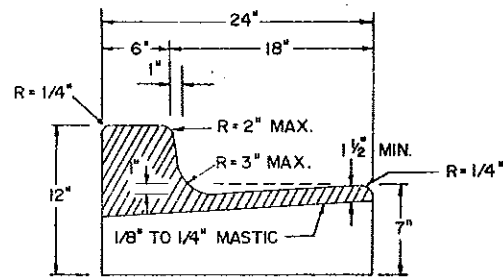


CURB & GUTTER TYPE I (SEC. A)

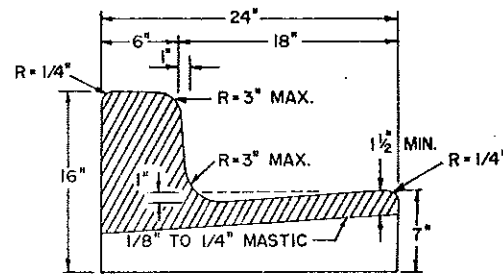


CURB & GUTTER TYPE I (SEC. B)

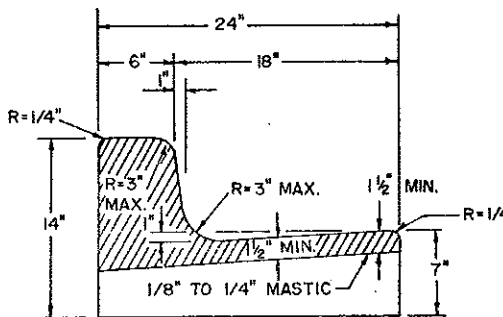


CURB & GUTTER TYPE I (SEC. C)

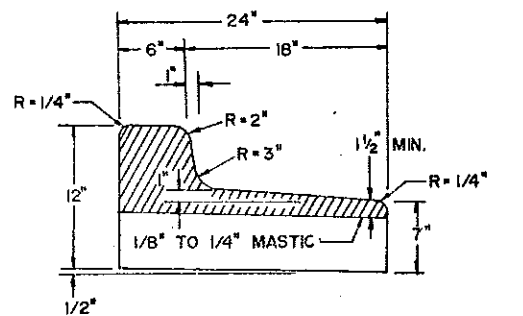


CURB & GUTTER TYPE I (SEC. D)

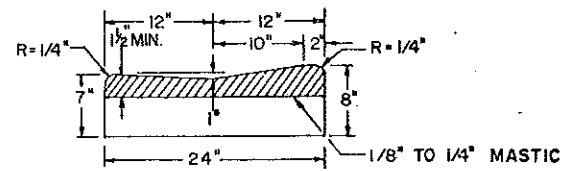


MOUNTABLE CURB & GUTTER TYPE I (SEC. A)

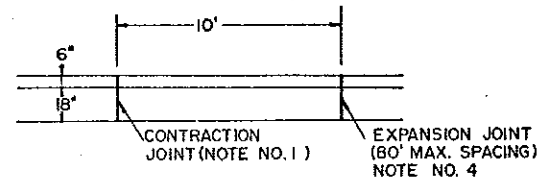


EXPANSION JOINT DETAIL

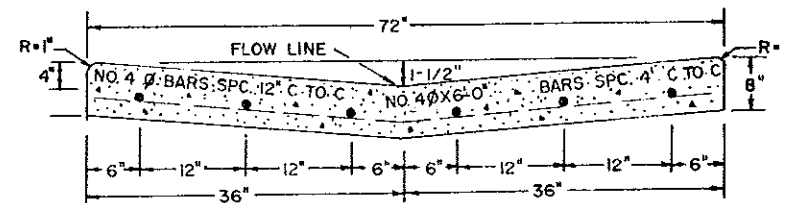


72" CONCRETE VALLEY GUTTER

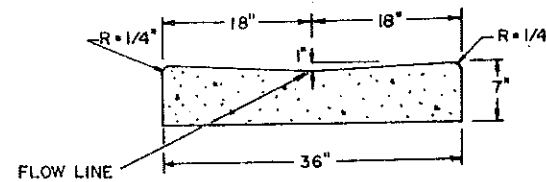


36" CONCRETE VALLEY GUTTER

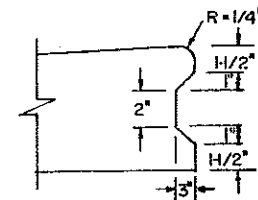


KEYWAY DETAIL FOR CURB & GUTTER (TO BE USED WITH P.C.C. PAVEMENT)

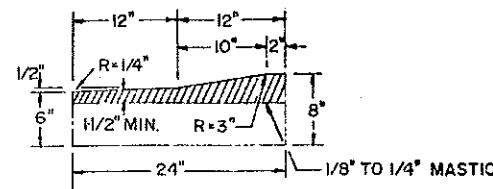

MOUNTABLE CURB & GUTTER TYPE I (SEC. B)

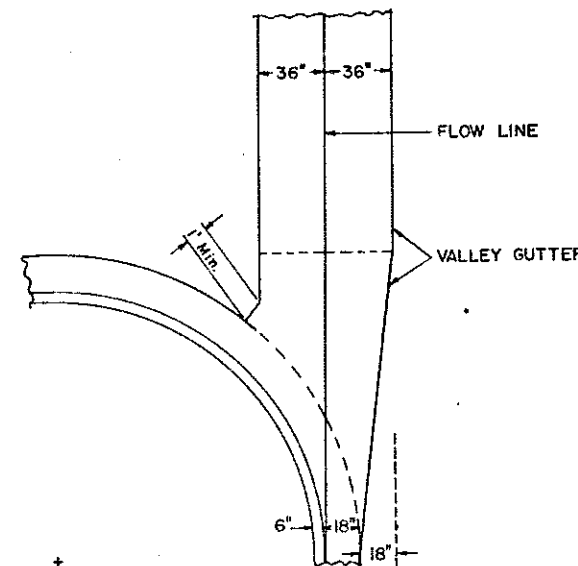

72" CONCRETE VALLEY GUTTER

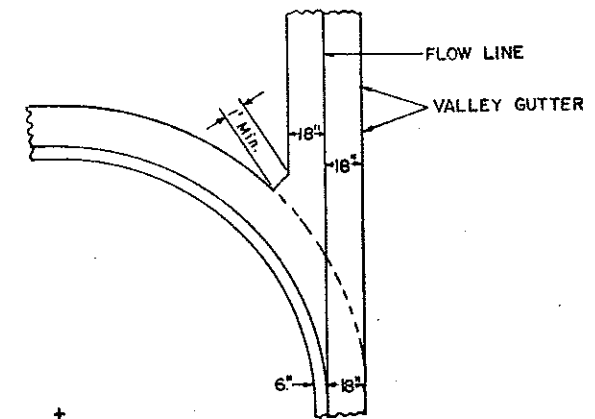

36" CONCRETE VALLEY GUTTER

NOTES:

- CONTRACTION JOINTS: USE 1/8"-1/4" ASPHALTIC MASTIC BOARD EMBEDDED 1-1/2" INTO THE GUTTER AND THROUGH THE CURB. THE CONTRACTOR MAY SCORE THE CURB AND GUTTER TO A DEPTH OF 2" AS AN ALTERNATE TO USING ASPHALTIC MASTIC BOARD UPON APPROVAL OF THE ENGINEER. CONTRACTION JOINTS SPACING SHALL BE AS SHOWN IN ABOVE DETAIL OR MATCH JOINTS ON FCC PAV'T.
- THE CONTRACTOR MAY USE A 5" TOP OF CURB IN PLACE OF A 6" TOP. THE FACE OF THE CURB WILL BE MEASURED 6" FROM THE BACK OF THE CURB IN ALL CASES.
- CURB & GUTTER TYPE I (SEC. A) TO BE USED UNLESS OTHERWISE SPECIFIED.
- CURB AND GUTTER EXPANSION JOINT MATERIAL SHALL BE OF 3/4" PREMOULDED EXPANSION JOINT FULL DEPTH AND THE SAME SHAPE AS THE CURB AND GUTTER CONFORMING TO SECTION 824-5 OF THE STANDARD SPECIFICATIONS. ALL JOINTS SHALL BE SEALED WITH A PARAPLASTIC HOT Poured JOINT FILLER MEETING THE REQUIREMENTS OF ASHTO M-173 CONCRETE JOINT SEALER, HOT Poured ELASTIC TYPE. THE COST OF ALL LABOR AND MATERIAL NECESSARY TO CONSTRUCT EXPANSION JOINTS SHALL BE INCLUDED IN THE PRICE BID FOR CURB AND GUTTER.

7-26-77	
DATE	REVISIONS
	CHANGE
8-11-80	ADDED NOTE NO. 6.
9-26-82	NOTE REVISION
9-30-82	REVISED VALLEY GUTTER

Submitted:	<i>William E. Eber</i> Design Engineer
Recommended:	Asst. Chief Engineer Pre-Construction
Approved:	<i>William E. Eber</i> Chief Engineer

# STANDARD RIGHT-OF-WAY MARKERS AND MONUMENTS


NOTES D-720-1

**GENERAL:**  
 CONTRACTOR SHALL USE CONC. POSTS UNLESS OTHERWISE SHOWN ON THE PLANS. INSTALL POSTS 12" FROM MONUMENTS. IRON MONUMENTS AND POSTS SHALL BE INSTALLED ON RIGHT-OF-WAY LINE.  
 ALL POSTS SHALL BE INSTALLED WITH THE LETTER SIDE FACING THE PROJECT ROADWAY. STANDARD R/W MARKERS SHALL BE PAID FOR AT THE CONTRACT UNIT PRICE PER EACH, COMPLETE IN PLACE, WHICH PRICE SHALL BE PAYMENT IN FULL FOR ALL EXCAVATION, BACK-FILLING, MATERIAL, LABOR, TOOLS, EQUIPMENT AND INCIDENTALS NECESSARY TO INSTALL THE UNIT AS SHOWN ON THE STANDARD DRAWING AT THE LOCATIONS DESIGNATED ON THE PLANS.


**CONCRETE POSTS:**  
 CONCRETE POST TO BE CLASS A CONCRETE.

**STEEL POSTS:**  
 THE RIGHT OF WAY MARKER SHALL HAVE AN ALUMINUM OR STEEL BACKING CONFORMING TO THE REQUIREMENTS OF SECTION 894-2 OF THE STANDARD SPECIFICATIONS. THE RIGHT OF WAY MARKER SHALL BE PAINTED OR HAVE REFLECTIVE SHEETING APPLIED. THE BACKING SHALL BE CUT TO SHAPE AND SHALL BE DEGRADED, ETCHED AND COATED AS SPECIFIED IN SECTION 754 OF THE STANDARD SPECIFICATIONS. THE PAINT SHALL CONFORM TO THE REQUIREMENTS OF SECTION 870 OF THE STANDARD SPECIFICATIONS AND SHALL BE WHITE AND BLACK EXCEPT THE REFLECTIVE SHEETING SHALL MEET THE REQUIREMENTS OF SECTION 894 OF THE STANDARD SPECIFICATIONS, Type II. THE LEGEND SHALL BE PAINTED ON PAINTED BACKGROUND OR SCALENED OR DIRECT APPLIED ON REFLECTIVE SHEETING IN ACCORDANCE WITH SECTION 894 OF THE STANDARD SPECIFICATIONS.  
 THE POST, ANCHOR AND REINFORCING SLEEVE SHALL CONFORM TO THE REQUIREMENTS OF SECTION 894-7.6 OF THE STANDARD SPECIFICATIONS.


**IRON MONUMENTS:**  
 IRON MONUMENTS (1"X24") TO BE FURNISHED AND PLACED BY STATE HIGHWAY DEPARTMENT OR COUNTY HIGHWAY DEPARTMENT PERSONNEL AT SECTION LINES, RIGHT OF WAY BREAKS, CURVE POINTS, AND NEAR THE MID POINT OF EACH MILE. THE MONUMENTS AT THE MID POINT CAN BE ELIMINATED IF CURVE POINTS OR R/W BREAKS ARE IN THE IMMEDIATE VICINITY.

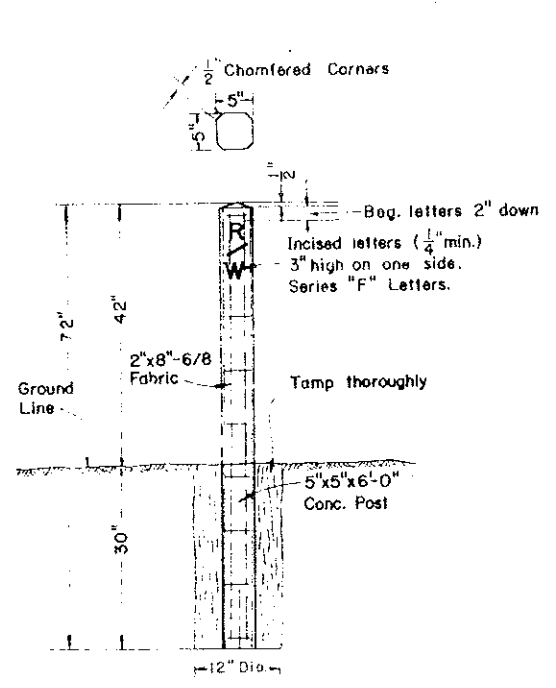

POST DETAIL


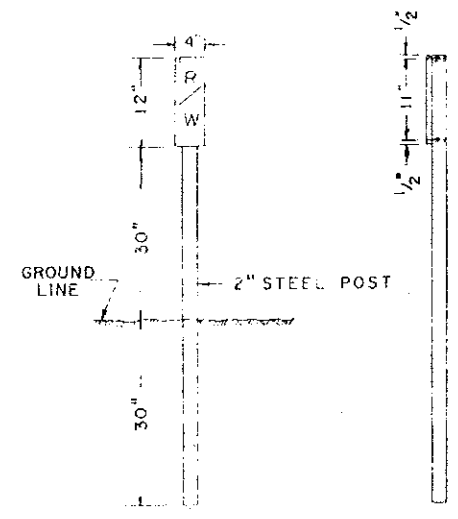


POST DETAIL

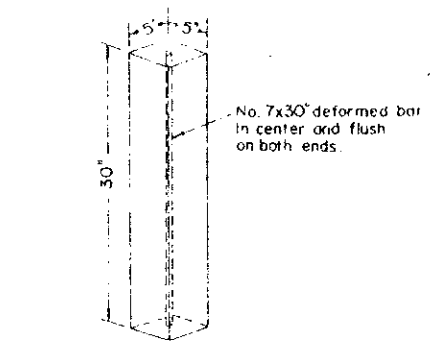


CONCRETE MONUMENT


## VARIOUS POST PLACEMENTS

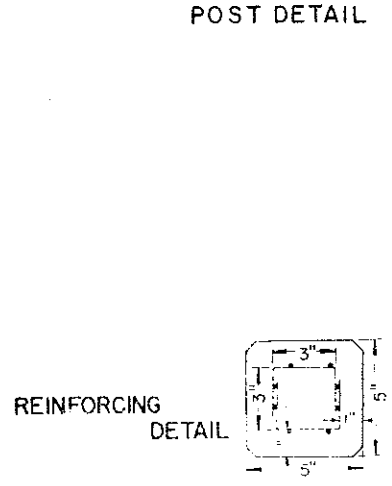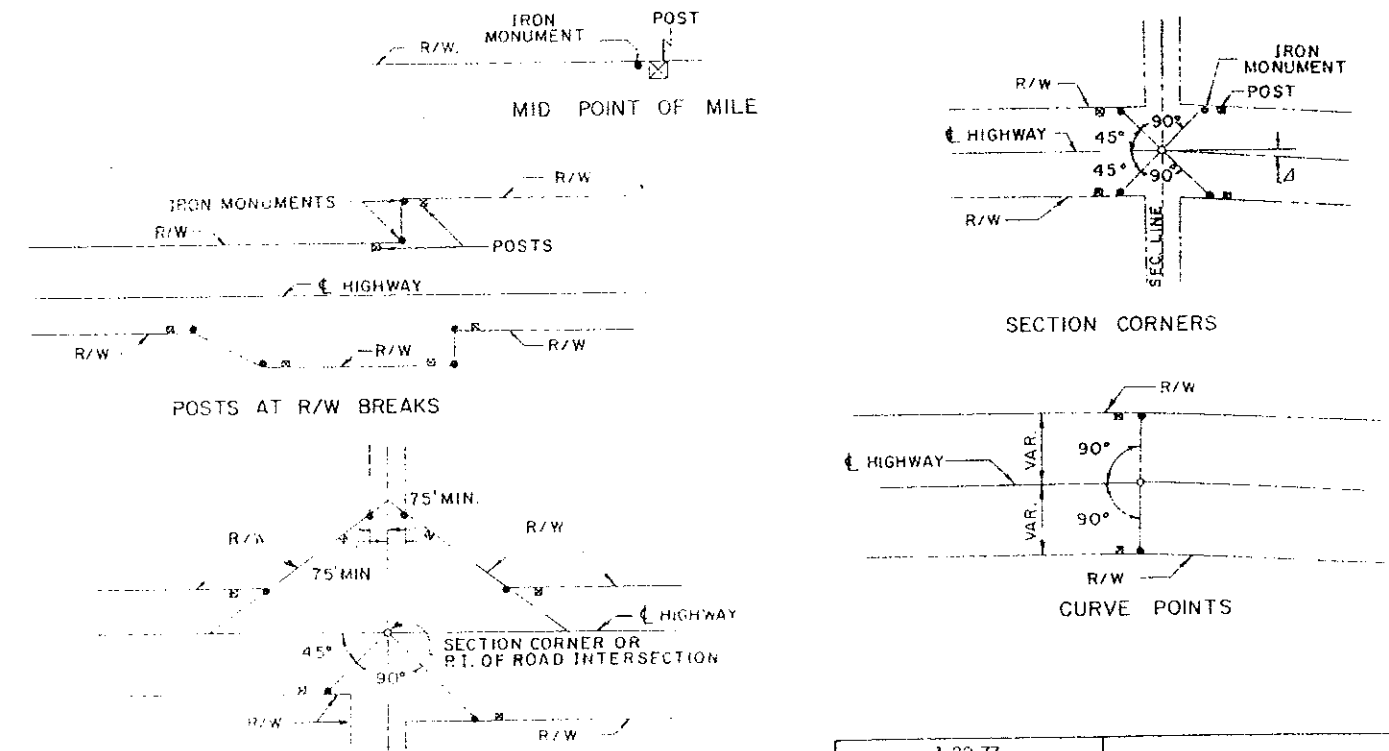

REINFORCING DETAIL

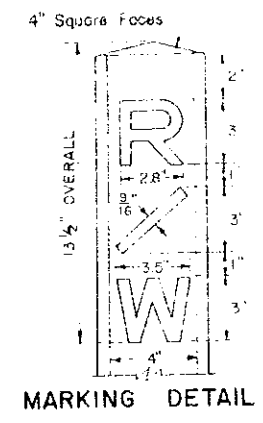

MARKING DETAIL

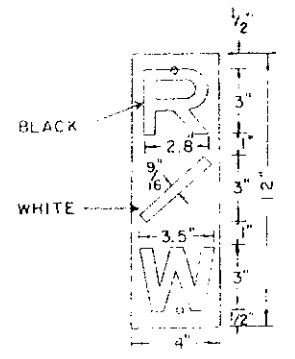

MARKING DETAIL

NOTE: ALL HOLES SHALL BE PUNCHED ROUND FOR 3/8" DIAMETER BOLTS

## CONCRETE POST DETAILS

## STEEL POST DETAILS


## FLARED R/W BREAKS

REVISIONS		DATE	CHANGE	APPROVED
3-29-77				
5-26-77	Conc. Post Details Added			Submitted: <i>[Signature]</i> Design Engineer
6-23-80	Notes on Steel Post			Recommended: <i>[Signature]</i> Asst. Chief Engineer Pre-Construction
11-16-83	Note Added - Steel Post Dimensions Changed			Approved: <i>[Signature]</i> Chief Engineer


### W BEAM GUARDRAIL GENERAL DETAILS

FHWA REGION	STATE	FED AID PROJ NO	DATE
8	M.D.	BRF-1-006(02)066	4-1-83


D-722-1

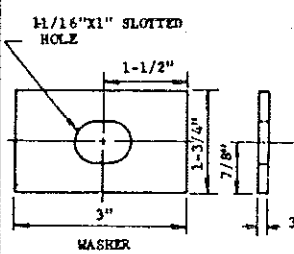


RECTANGULAR PLATE WASHER  
NO RECTANGULAR WASHER USED UNDER POST BOLT HEADS IN THE 2ND THRU 6TH POST OF END TREATMENT.

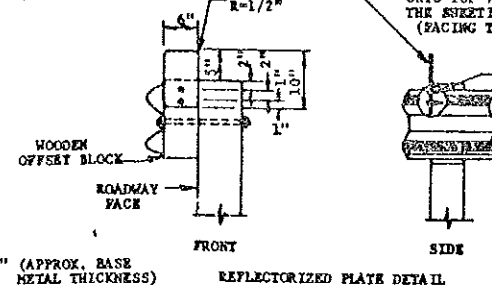








REFLECTORIZED PLATE DETAIL  
CROSS SECTION IS TO BE WITH W-BEAM

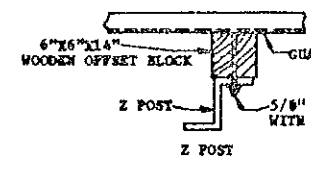


ATTACHMENT DETAIL

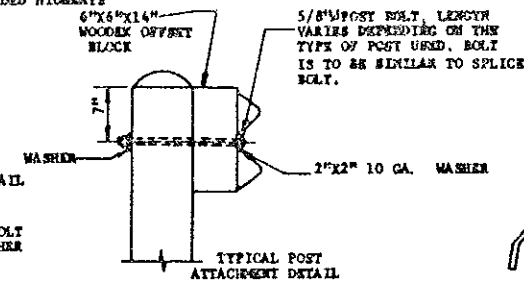


TYPICAL POST ATTACHMENT DETAIL

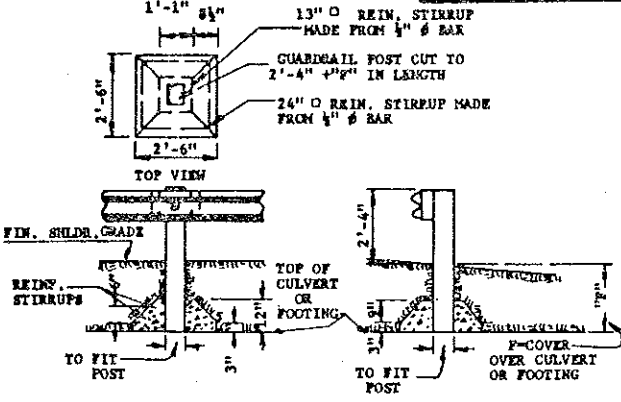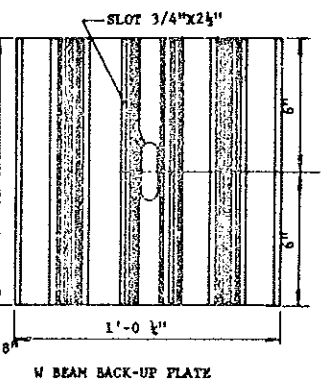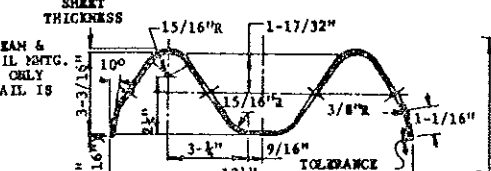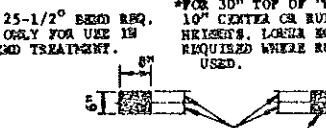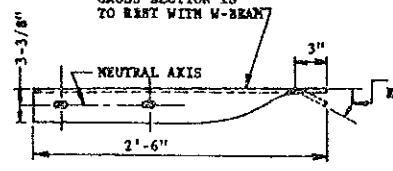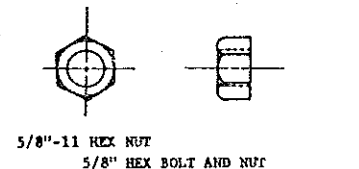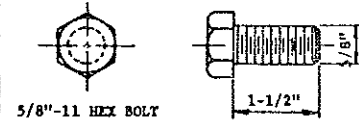


DETAIL OF CONCRETE PEDIESTAL FOR POSTS

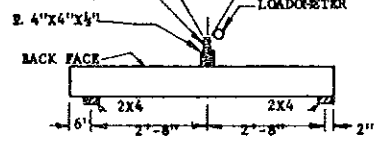


TRANSVERSE LOAD TEST (CONCRETE POSTS)

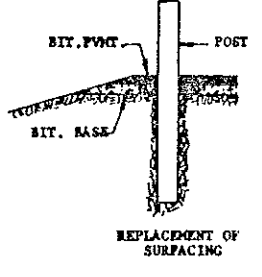


REPLACEMENT OF SURFACING

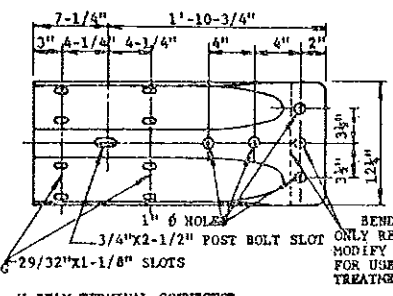

W BEAM TERMINAL CONNECTOR

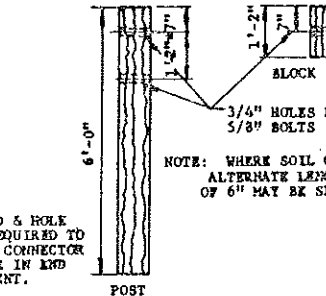

6X8 TIMBER POST & BLOCK

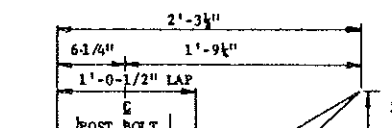

5/8" CARRIAGE BOLT


L	THREAD LENGTH
1 1/4"	FULL LENGTH THREAD
3"	1 1/4" MIN. THREAD LENGTH
11"	1-3/4" MIN. THREAD LENGTH
13"	1-3/4" MIN. THREAD LENGTH

NOTE: REFLECTORS: THE REFLECTOR SHALL BE THE SAME COLOR AS THE PAVEMENT MARKING ADJACENT TO THE REFLECTOR UNLESS NOTED OTHERWISE ON THE PLANS.


ALTERNATE FOR CONCRETE FOOTINGS: A STEEL TUBE WITH A SOIL PLATE MAY BE USED AS AN ALTERNATE FOR CONCRETE FOOTINGS END TREATMENT. THE BREAKAWAY WOOD POST SHALL BE 6"x8"x24" LONG.

DETAIL OF CONCRETE PEDIESTAL FOR POSTS: TO BE USED OVER CULVERTS OR FOOTINGS WHEN DIMENSION "F" IS LESS THAN 3'-8". WHEN 2 OR ROUND POSTS ARE USED AND THE PEDIESTAL IS REQUIRED THE POST HOLE IN THE PEDIESTAL SHALL BE VARIED AS REQUIRED BY THE POST SHAPE.


MANNER OF REPLACING BIT, MATERIAL AT GUARDRAIL POST: ALL EXCESS EARTH FROM EXCAVATIONS FOR GUARD POSTS SHALL BE DISPOSED OF AS DIRECTED BY THE ENGINEER. REPLACE BIT, MATERIAL WHEREVER GUARDRAIL IS INSTALLED AFTER MAT HAS BEEN LAID. COST OF EXCAVATION AND REPLACING OF BIT, MATERIAL TO BE INCLUDED IN THE PRICE BID FOR OTHER ITEMS.

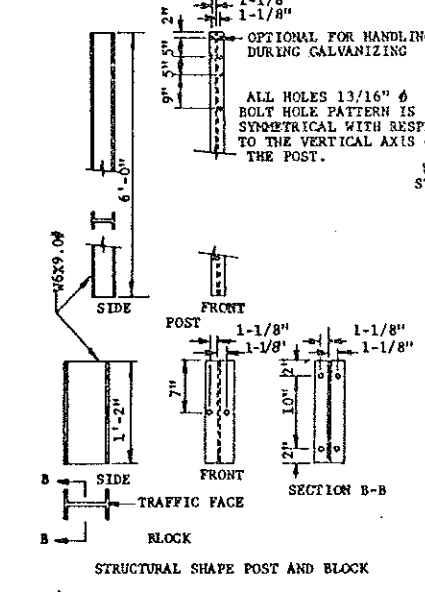


STRUCTURAL SHAPE POST AND BLOCK

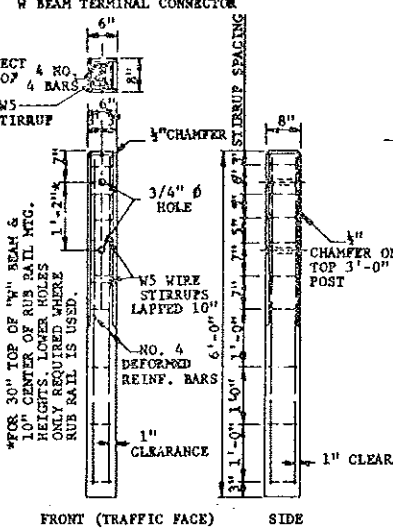

6X8 CONCRETE POST

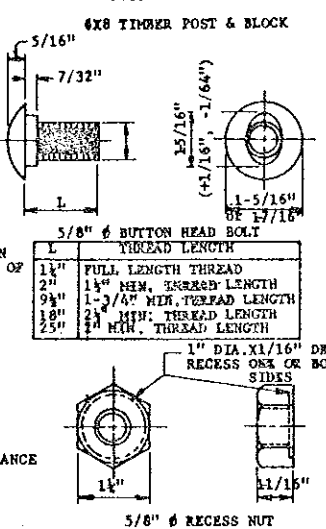


5/8" RECESS NUT  
5/8" BUTTON HEAD BOLT AND RECESS NUT

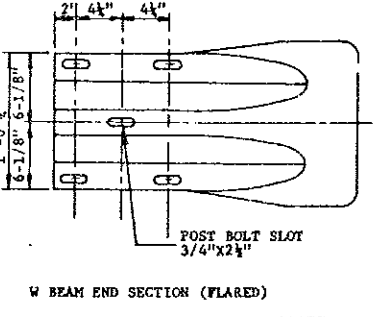


W BEAM END SECTION (FLARED)




5/8" HEX NUT  
5/8" CARRIAGE BOLT & NUT

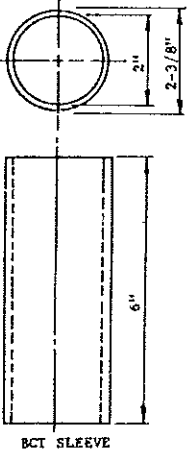


BCT SLEEVE

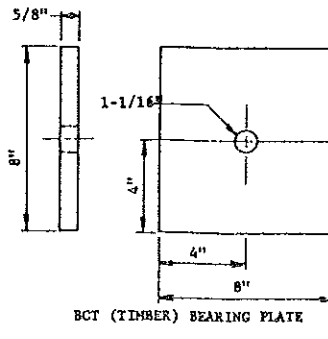


BCT (TIMBER) BEARING PLATE

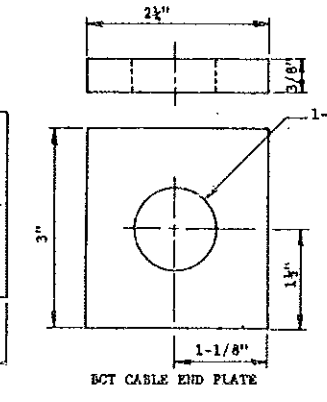


BCT CABLE END PLATE

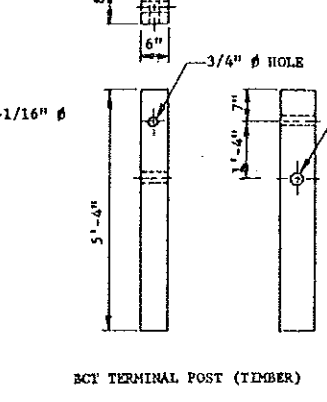


BCT TERMINAL POST (TIMBER)

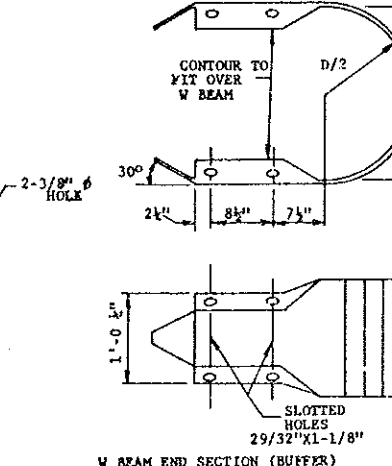

W BEAM END SECTION (BUFFER)

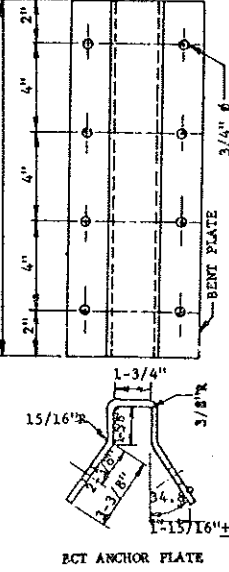

BCT ANCHOR PLATE

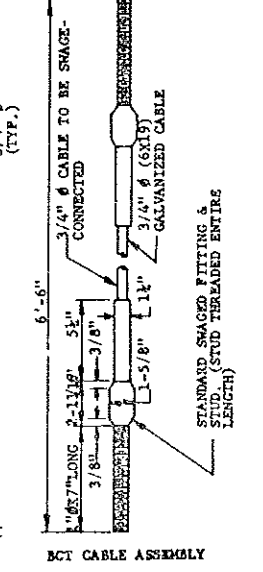

BCT CABLE ASSEMBLY


4-1-83	
DATE	REVISIONS
7-10-83	NOTE CHANGE

NORTH DAKOTA STATE HIGHWAY DEPARTMENT  
SUBMITTED: *[Signature]*  
DESIGN ENGINEER


# BEAM GUARDRAIL-FLARED END TREATMENT AND TRANSITION

AREA	STATE	FED. AID PROJ. NO.	SHEET NO.
8	N.D.	BRF-1-006(02)066	

D-722-2

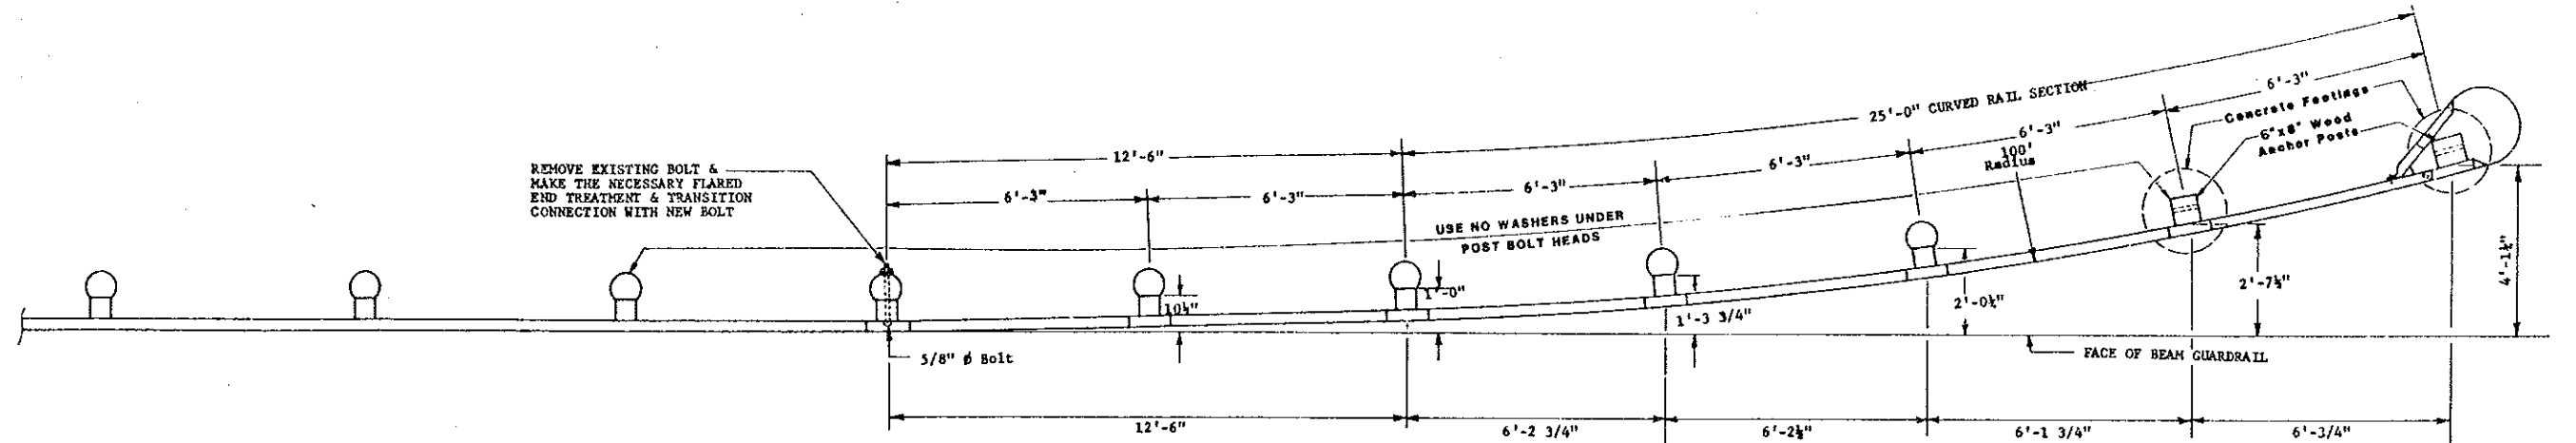


PLAN

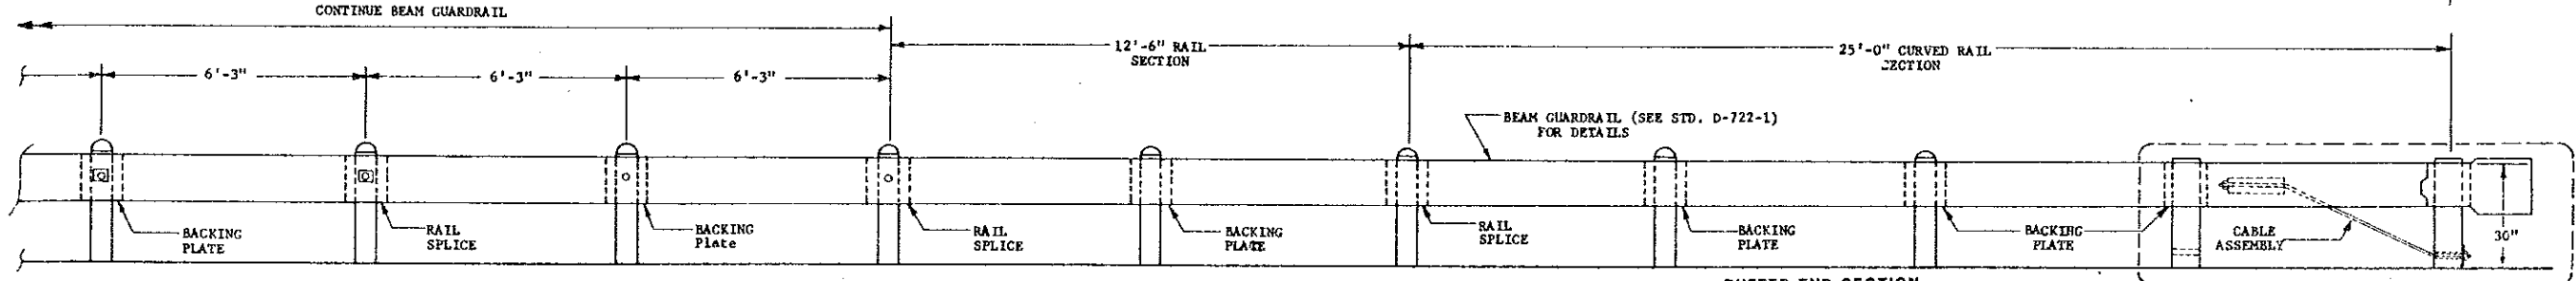


ELEVATION


BUFFER END SECTION

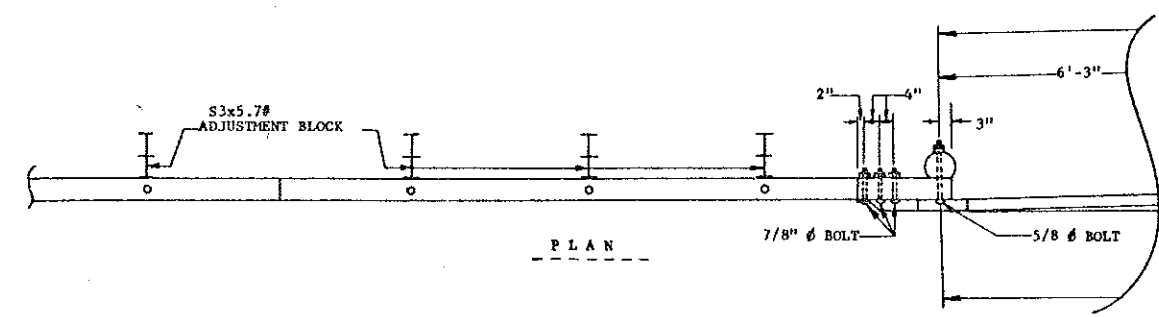

PLAN

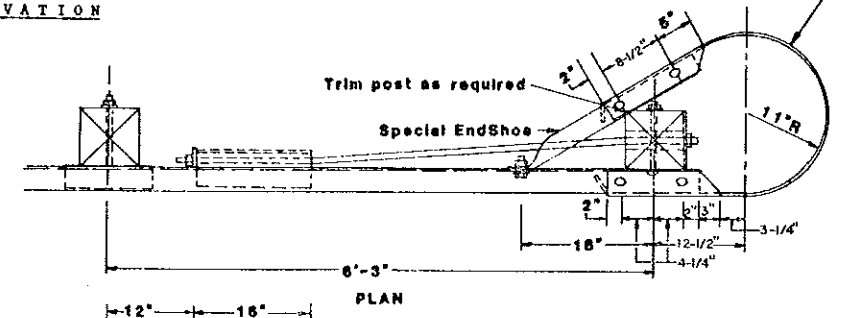


PLAN

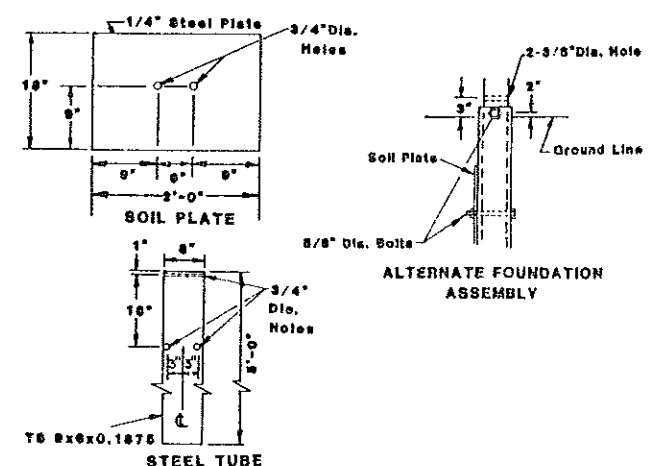


STEEL TUBE

ALTERNATE FOUNDATION ASSEMBLY

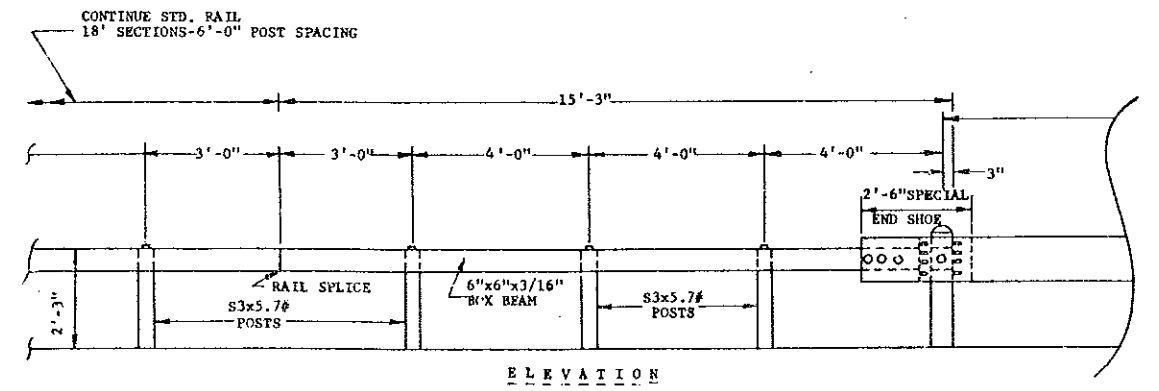

ELEVATION

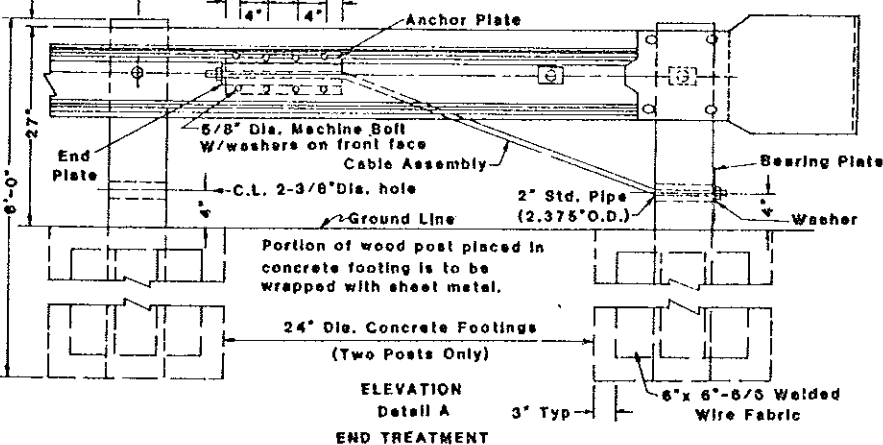

ELEVATION  
Detail A  
END TREATMENT






4-15-83	
REVISIONS	
DATE	CHANGE
6-21-83	ANCHOR POST SIZE
7-19-83	ADD NOTE

NORTH DAKOTA  
STATE HIGHWAY DEPARTMENT  
Submitted: *[Signature]*  
Design Engineer



### BOX BEAM GUARDRAIL AT BRIDGE ENDS GENERAL LAYOUT & DETAILS

FHWA REGION	STATE	FED. AID PROJ. NO.	DRAWING NO.
		BRF-1-006(02)066	D-722-3

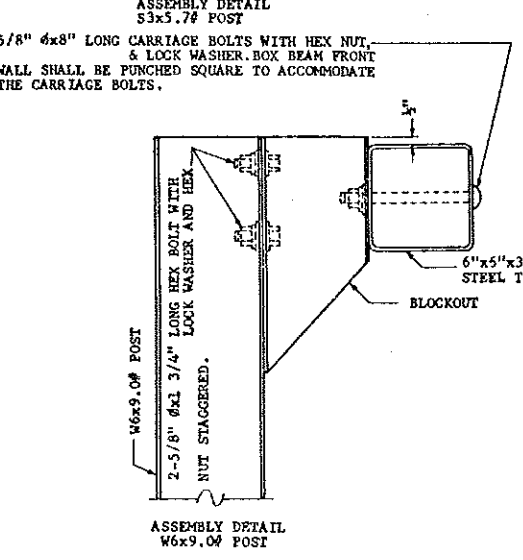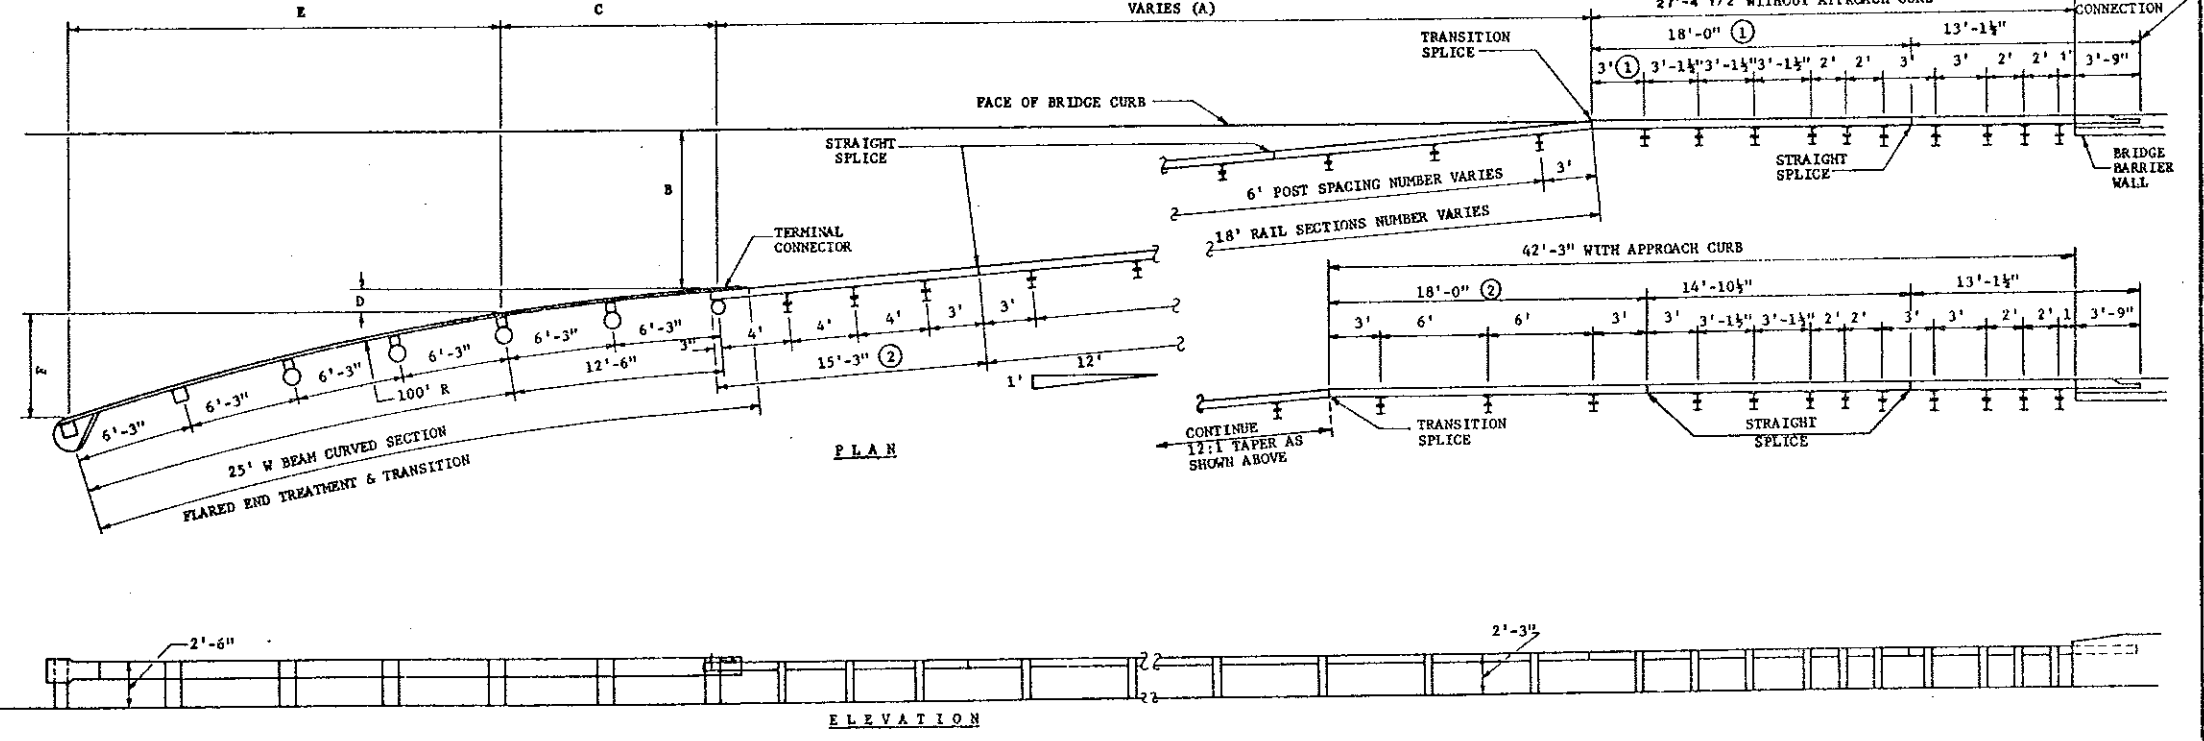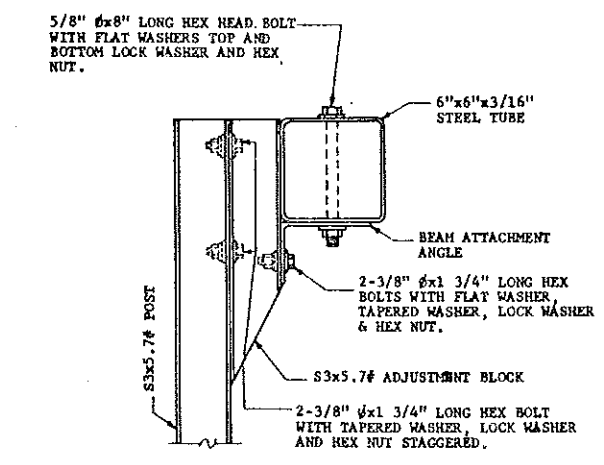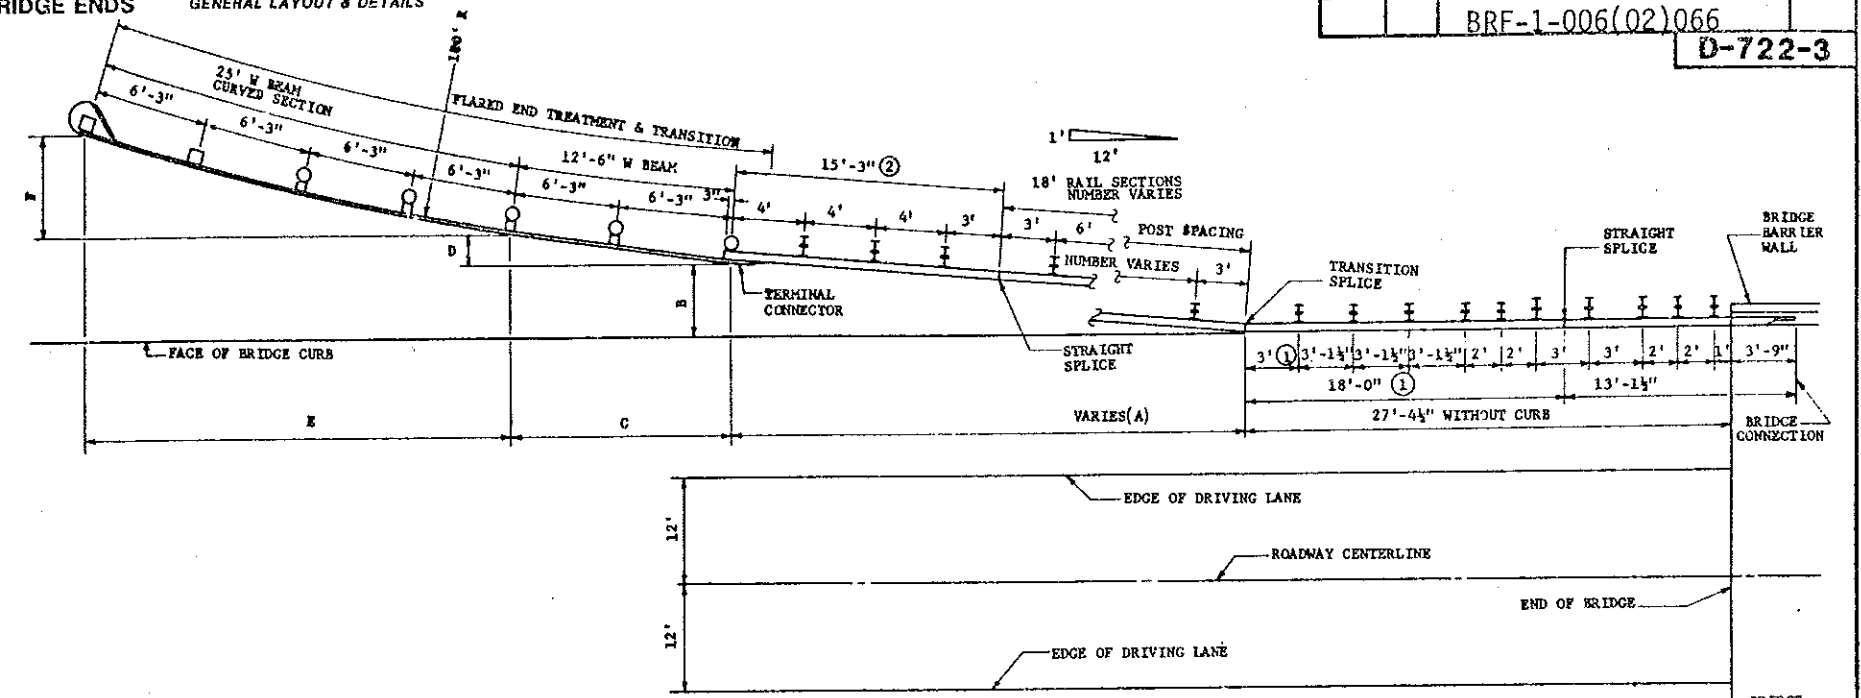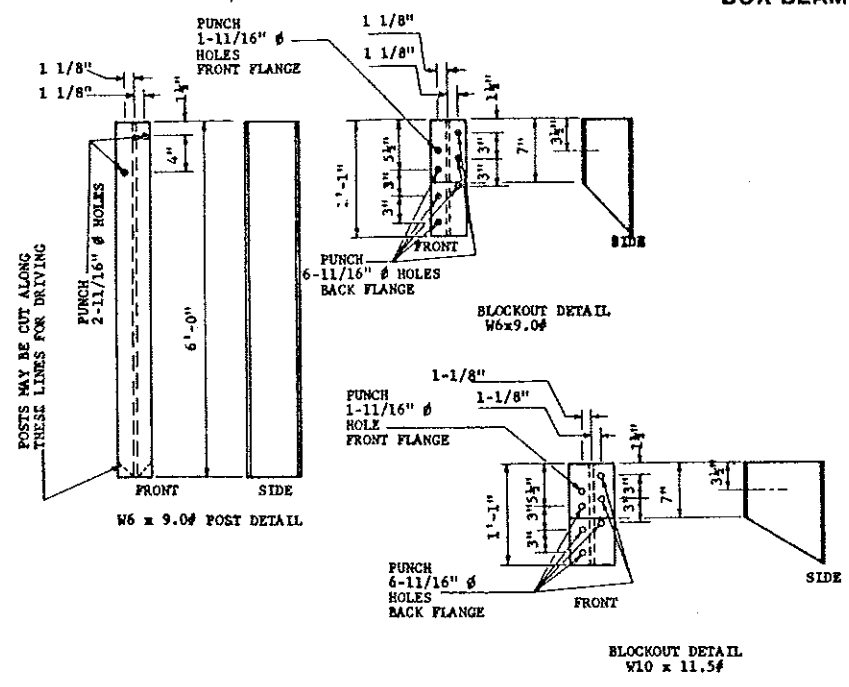

**NOTE: POST AND BLOCKOUTS**

THE POST AND BLOCKOUTS SHALL CONFORM TO THE REQUIREMENTS SECTION 850 OF THE STANDARD SPECIFICATION, BOX BEAM GUARDRAIL.

BOX BEAM SHALL CONFORM TO THE REQUIREMENT OF SECTION 722 OF THE STANDARD SPECIFICATION.

- ① THE 18' SECTION SHALL BE REPLACED WITH A 15'-3" SECTION WITH THE LAST 3' SPACE REDUCED TO 3" AND HAVE THE TERMINAL CONNECTOR ATTACHED AND 12'-6" W BEAM SECTION AS SHOWN ON STD. D-722-2 THE FLARED END TREATMENT INSTALLED ACCORDINGLY.
- ② THE 18' SECTION SHALL BE REPLACED WITH 15'-3" SECTION AND POST SPACING AS SHOWN FOR THE 15'-3" SECTION AND HAVE THE TERMINAL CONNECTOR ATTACHED AND 12'-6" W BEAM GUARDRAIL SECTION ON STD. D-722-2 . THE FLARED END TREATMENT INSTALLED ACCORDINGLY.

12-1-82	
REVISIONS	
DATE	CHANGE
7-18-83	ADD DISTANCE


NORTH DAKOTA STATE HIGHWAY DEPARTMENT

Submitted: *David H. Lee*  
Design Engineer

BOX BEAM GUARDRAIL AT BRIDGE ENDS  
DIMENSIONS AND DETAILS

BOX BEAM DIMENSION TABLE

CLEAR HWY. WIDTH OF BRIDGE	APPROACH SIDE														OPPOSITE SIDE																			
	WITHOUT APPROACH CURB							WITH APPROACH CURB							WITHOUT APPROACH CURB							WITH APPROACH CURB												
	A	B	C	D	E	F	GUARD RAIL ①	A	B	C	D	E	F	GUARD RAIL ①	A	B	C	D	E	F	GUARD RAIL ①	A	B	C	D	E	F	GUARD RAIL ①						
UNDER 250	44	33.14	2.76				64.4							15.20	1.27												28.4							43.3
	42	33.14	2.76				64.4							15.20	1.27												28.4							43.3
	40	33.14	2.76				64.4							33.14	2.76												27.5							43.3
	38	51.08	4.25				82.4							33.14	2.76												28.5							43.3
	36	51.08	4.25				82.4							33.14	2.76												28.5							43.3
	34	51.08	4.25	12.43			82.4							51.08	4.25	12.43											28.5							43.3
	32	69.02	5.74		1.29		100.4							51.08	4.25		1.29										28.5							43.3
	30	69.02	5.74			24.29	100.4							51.08	4.25			24.29									28.5							43.3
	28	69.02	5.74				100.4							69.02	5.74												46.4							43.3
	26	86.96	7.23				118.4							69.02	5.74												46.4							43.3
24	86.96	7.23				118.4							69.02	5.74												46.4	15.20	1.27	12.43	1.29	24.29	5.64		61.3
800-250	44	51.08	4.25				82.4							33.14	2.76											28.4							43.3	
	42	51.08	4.25				82.4							33.14	2.76											28.4							43.3	
	40	51.08	4.25				82.4							51.08	4.25											28.4							43.3	
	38	69.02	5.74				100.4							51.08	4.25											28.4							43.3	
	36	69.02	5.74				100.4							51.08	4.25											28.4							43.3	
	34	69.02	5.74	12.43			100.4							69.02	5.74	12.43										28.4							43.3	
	32	86.96	7.23		1.29		118.4							69.02	5.74		1.29									46.4							43.3	
	30	86.96	7.23			24.29	118.4							69.02	5.74			24.29								46.4							43.3	
	28	86.96	7.23				118.4							86.96	7.23											64.4							43.3	
	26	86.96	7.23				118.4							86.96	7.23											64.4							43.3	
24	104.90	8.72				136.4							86.96	7.23											64.4	15.20	1.27	12.43	1.29	24.29	5.64		61.3	
2000-800	44	51.08	4.25				82.4							51.08	4.25										28.4							43.3		
	42	69.02	5.74				100.4							51.08	4.25										28.4							43.3		
	40	69.02	5.74				100.4							51.08	4.25										28.4							43.3		
	38	86.96	7.23				100.4							69.02	5.74										46.4							43.3		
	36	86.96	7.23				118.4							69.02	5.74										46.4							43.3		
	34	86.96	7.23	12.43			118.4							69.02	5.74	12.43									46.4							43.3		
	32	86.96	7.23		1.29		118.4							86.96	7.23		1.29								64.4							43.3		
	30	104.90	8.72			24.29	136.4							86.96	7.23			24.29							64.4							43.3		
	28	104.90	8.72				136.4							86.96	7.23										64.4							43.3		
	26	104.90	8.72				136.4							104.90	8.72										64.4							43.3		
24	122.84	10.21				154.4							104.90	8.72										64.4	15.20	1.27	12.43	1.29	24.29	5.64		61.3		
6000-2000	44	69.02	5.74				100.4							69.02	5.74										46.4							43.3		
	42	86.96	7.23				118.4							69.02	5.74										46.4							43.3		
	40	86.96	7.23				118.4							69.02	5.74										46.4							43.3		
	38	86.96	7.23				118.4							86.96	7.23										64.4							43.3		
	36	104.90	8.72				136.4							86.96	7.23										64.4							43.3		
	34	104.90	8.72	12.43			136.4							86.96	7.23	12.43									64.4							43.3		
	32	104.90	8.72		1.29		136.4							104.90	8.72		1.29								64.4							43.3		
	30	122.84	10.21			24.29	154.4							104.90	8.72			24.29							64.4							43.3		
	28	122.84	10.21				154.4							104.90	8.72										64.4							43.3		
	26	122.84	10.21				154.4							122.84	10.21										64.4							43.3		
24	122.84	10.21				154.4							122.84	10.21										64.4							43.3			
OVER 6000	44	86.96	7.23				118.4							86.96	7.23										64.4							43.3		
	42	104.90	8.72				136.4							86.96	7.23										64.4							43.3		
	40	104.90	8.72				136.4							86.96	7.23										64.4							43.3		
	38	104.90	8.72				136.4							104.90	8.72										64.4							43.3		
	36	122.84	10.21				154.4							104.90	8.72										64.4							43.3		
	34	122.84	10.21	12.43			154.4							104.90	8.72	12.43									64.4							43.3		
	32	122.84	10.21		1.29		154.4							122.84	10.21		1.29								64.4							43.3		
	30	140.78	11.70			24.29	172.4							122.84	10.21			24.29							64.4							43.3		
	28	140.78	11.70				172.4							122.84	10.21										64.4							43.3		
	26	140.78	11.70				172.4							140.78	11.70										64.4							43.3		
24	140.78	11.70				172.4							140.78	11.70										64.4							43.3			

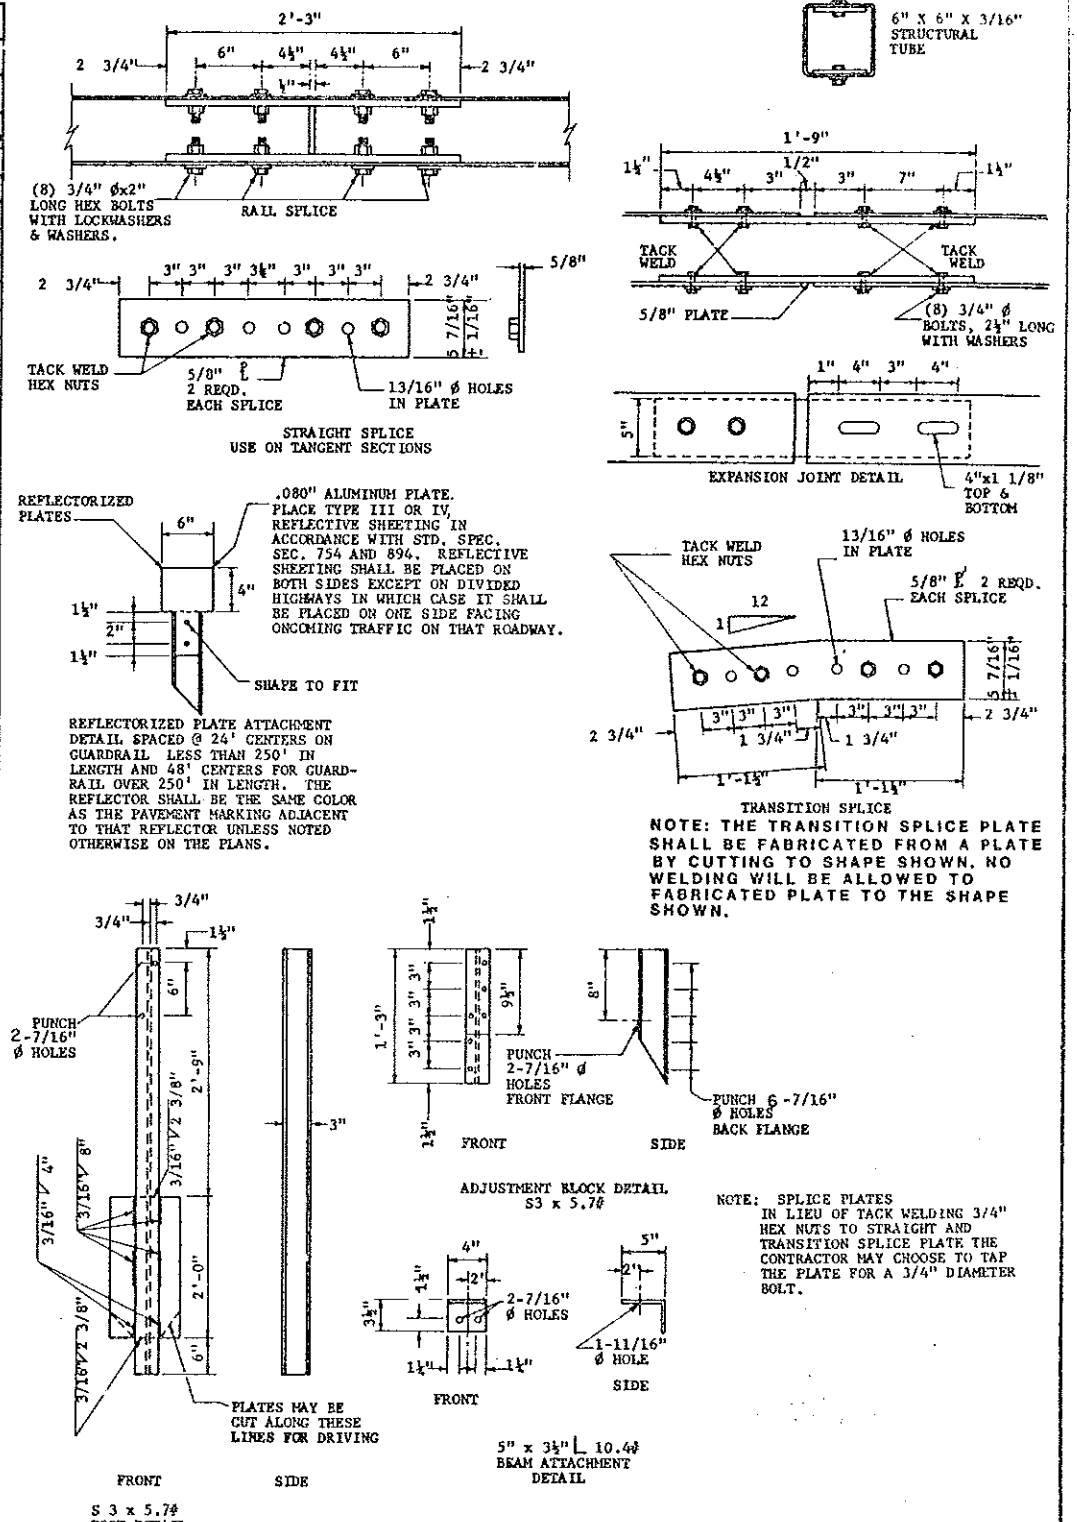

12-1-82		REVISIONS	
DATE	CHANGE	DATE	CHANGE
6-21-83	POST & ADJUST. BLK. HOLE PUNCHING		
7-18-83	NOTE CHANGE		
9-7-83	Add Note		

APPROVED: *David K. Lee*  
DESIGN ENGINEER


NORTH DAKOTA STATE HIGHWAY DEPARTMENT

① THE GUARDRAIL LENGTH DOES NOT INCLUDE THE END TREATMENT & TRANSITION 37.5' W-BEAM.

# TYPICAL GRADING AT BRIDGE ENDS

With Breakaway Cable Terminal

DESIGN TRAFFIC VOLUME (ADT)	BOX BEAM DIMENSION TABLE								
	APPROACH SIDE				OPPOSITE SIDE				
	WITHOUT APPROACH CURB		WITH APPROACH CURB		WITHOUT APPROACH CURB		WITH APPROACH CURB		
	A	B	A	B	A	B	A	B	
	FT.	FT.	FT.	FT.	FT.	FT.	FT.	FT.	
UNDER 250	44	60.5	12.8	57.5	11.3	30.1	10.0	39.5	10.0
	42	60.5	11.8	57.5	10.3	30.1	9.0	39.5	9.0
	40	60.5	10.8	75.4	10.8	30.1	8.0	39.5	8.0
	38	78.5	11.3	75.4	9.8	30.1	7.0	39.5	7.0
	36	78.5	10.3	75.4	8.8	30.1	6.0	39.5	6.0
	34	78.5	9.3	93.3	9.3	30.1	5.0	39.5	5.0
	32	96.4	9.7	93.3	8.3	30.1	4.0	39.5	4.0
	30	96.4	8.7	93.3	7.3	30.1	3.0	39.5	3.0
	28	96.4	7.7	111.3	7.7	42.6	3.3	39.5	2.0
	26	14.3	8.2	11.3	6.7	42.6	2.3	39.5	1.0
	24	14.3	7.2	11.3	5.7	42.6	1.3	57.5	1.3
800-250	44	78.5	14.3	75.4	12.3	30.1	10.0	39.5	10.0
	42	78.5	13.3	75.4	11.8	30.1	9.0	39.5	9.0
	40	78.5	12.3	93.3	12.3	30.1	8.0	39.5	8.0
	38	96.4	12.7	93.3	11.3	30.1	7.0	39.5	7.0
	36	96.4	11.7	93.3	10.3	30.1	6.8	39.5	6.0
	34	96.4	10.7	111.3	10.7	42.6	6.3	39.5	5.0
	32	114.3	11.2	111.3	9.7	42.6	5.3	39.5	4.0
	30	114.3	10.2	111.3	8.7	42.6	4.3	57.5	4.3
	28	114.3	9.2	129.2	9.2	60.5	4.8	57.5	3.3
	26	14.3	8.2	29.2	8.2	60.5	3.8	57.5	2.3
	24	132.3	8.7	29.2	7.2	60.5	2.8	57.5	1.3
2000-800	44	78.5	14.3	93.3	14.3	30.1	10.0	39.5	10.0
	42	96.4	14.7	93.3	13.3	30.1	9.0	39.5	9.0
	40	96.4	13.7	93.3	12.3	30.1	8.0	39.5	8.0
	38	96.4	12.7	111.3	12.7	42.6	8.3	39.5	7.0
	36	114.3	13.2	111.3	11.7	42.6	7.3	39.5	6.0
	34	114.3	12.2	111.3	10.7	42.6	6.3	57.5	6.3
	32	114.3	11.2	129.2	11.2	60.5	6.8	57.5	5.3
	30	132.3	11.7	129.2	10.2	60.5	5.8	57.5	4.3
	28	132.3	10.7	129.2	9.2	60.5	4.8	75.4	4.8
	26	132.3	9.7	147.2	9.7	78.5	5.3	75.4	3.8
	24	132.3	8.7	147.2	8.7	78.5	4.3	75.4	2.8
6000-2000	44	96.4	15.7	111.3	15.7	42.6	11.3	39.5	10.0
	42	114.3	16.2	111.3	14.7	42.6	10.3	39.5	9.0
	40	114.3	15.2	111.3	13.7	42.6	9.3	57.5	9.3
	38	114.3	14.2	129.2	14.2	60.5	9.8	57.5	8.3
	36	132.3	14.7	129.2	13.2	60.5	8.8	57.5	7.3
	34	132.3	13.7	129.2	12.2	60.5	7.8	57.5	6.3
	32	132.3	12.7	147.2	12.7	78.5	8.3	75.4	6.8
	30	150.2	13.2	147.2	11.7	78.5	7.3	75.4	5.8
	28	150.2	12.2	147.2	10.7	78.5	6.3	93.3	6.3
	26	150.2	11.2	165.1	11.2	78.5	5.3	93.3	5.3
	24	150.2	10.2	165.1	10.2	96.4	5.7	93.3	4.3
OVER 6000	44	114.3	17.2	129.2	17.2	60.5	12.8	57.5	11.3
	42	132.3	17.7	129.2	16.2	60.5	11.8	75.4	11.8
	40	132.3	16.7	129.2	15.2	60.5	10.8	75.4	10.8
	38	132.3	15.7	147.2	15.7	78.5	11.2	75.4	9.3
	36	150.2	16.2	147.2	14.7	78.5	10.2	75.4	8.8
	34	150.2	15.2	147.2	13.7	78.5	9.2	93.3	9.3
	32	150.2	14.2	165.1	14.2	96.4	9.7	93.3	8.3
	30	168.2	14.7	165.1	13.2	96.4	8.7	93.3	7.3
	28	168.2	13.7	165.1	12.2	96.4	7.7	111.3	7.7
	26	168.2	12.7	183.0	12.7	114.4	8.2	111.3	6.7
	24	168.2	11.7	183.0	11.7	114.4	7.2	111.3	5.7

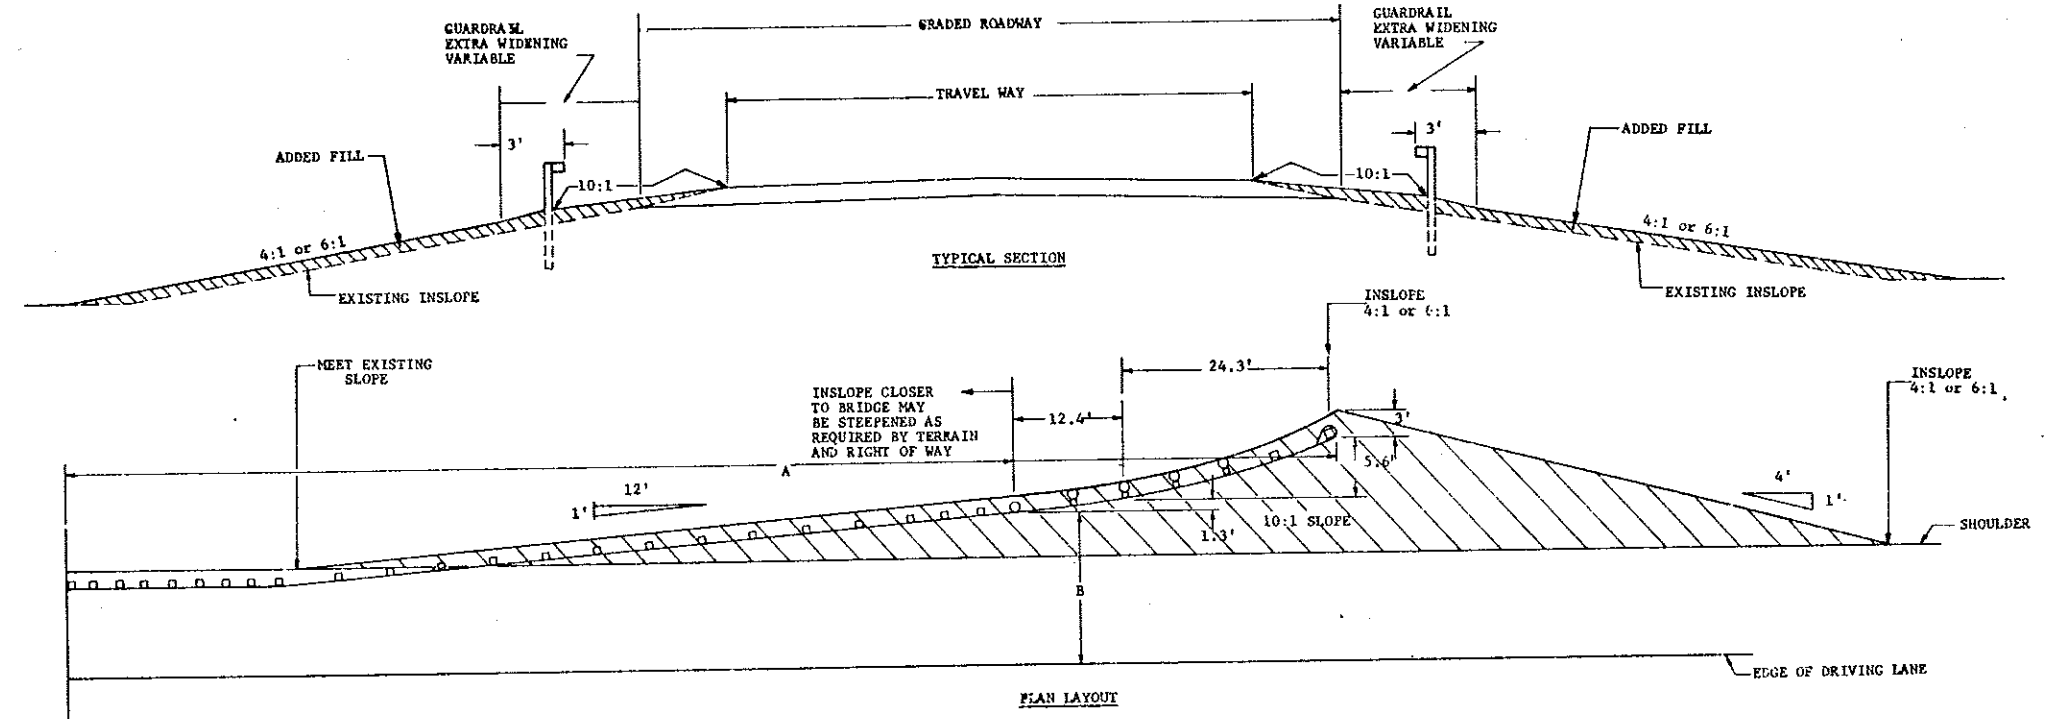




NOTE: THE DESIGN TRAFFIC VOLUMES (ADT) SHALL BE AS SHOWN ON TITLE SHEET UNDER TRAFFIC FORECAST. THE 'WITH APPROACH CURB' LENGTH SHALL BE USED WHERE BRIDGE APPROACH DRAINS ARE INSTALLED. ON DIVIDED HIGHWAYS THE MEDIAN SIDE SHALL USE THE LENGTHS AS SHOWN ON THE PLAN LAYOUTS. WHERE NORMAL INSLOPE IS 4:1 THE ADDED FILL SHALL BE 4:1. WHERE NORMAL INSLOPE IS 6:1 THE ADDED FILL SHALL BE 6:1.

DATE	REVISIONS	APPROVED: <i>David K. Loefer</i> DESIGN ENGINEER
7-26-83	NOTE CHANGE	




NORTH DAKOTA  
STATE HIGHWAY DEPARTMENT

# BOX BEAM GUARD RAIL AT BRIDGE ENDS ATTACHMENT DETAIL WITHOUT CURB

FHWA REGION	STATE	FED. AID PROJ. NO.
6	N.D.	BRF-1-006(02)066
		D-722-16

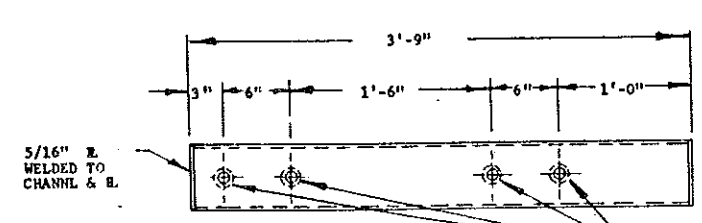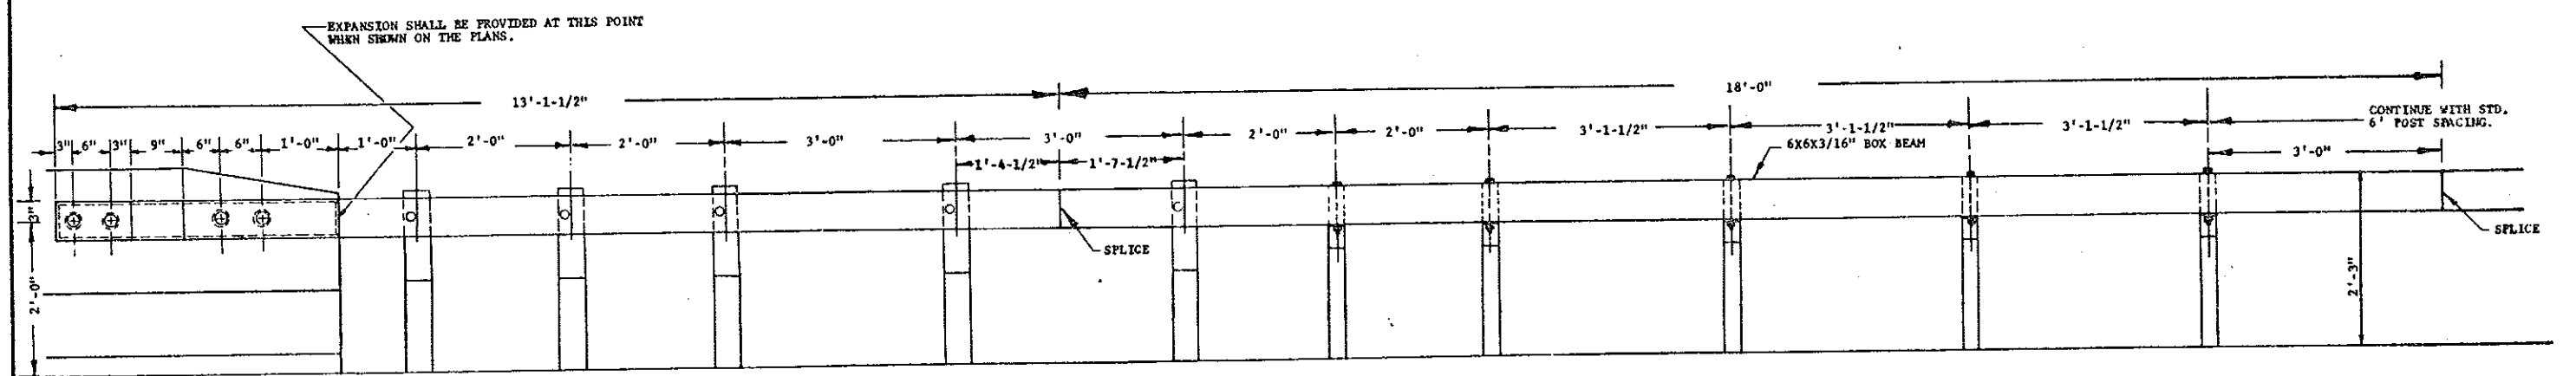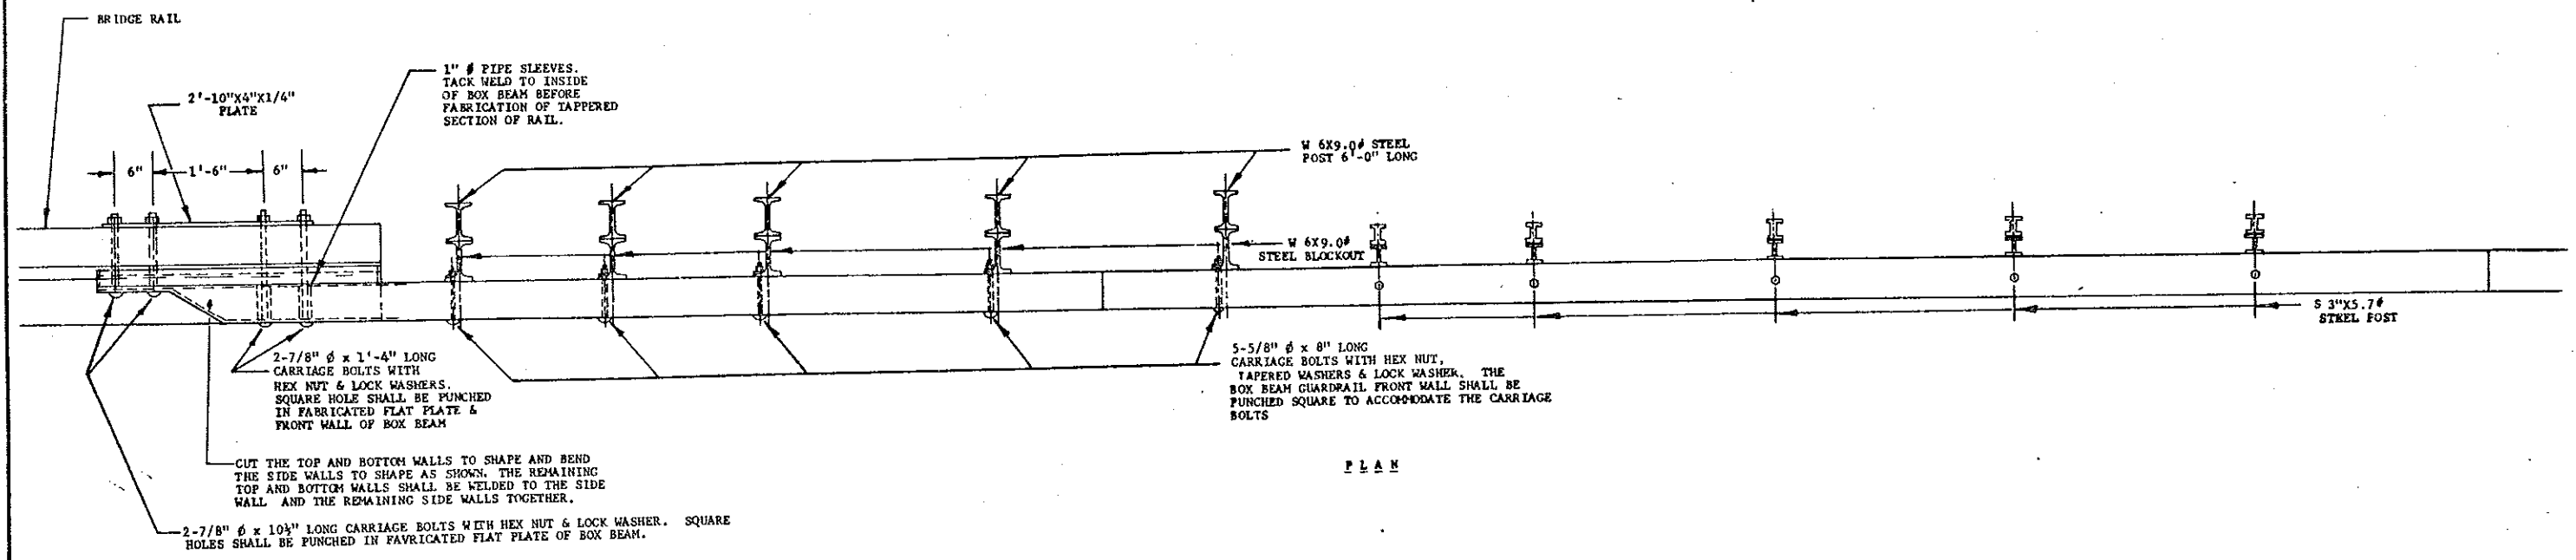


1" Ø PIPE SLEEVES SPOT WELD TO EITHER CHANNEL OR PLATE TO ALINE HOLES & HOLD IN PLACE UNTIL BOLTS ARE INSTALLED.

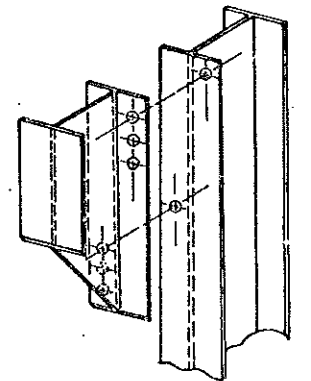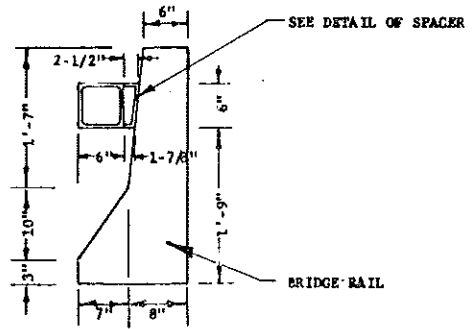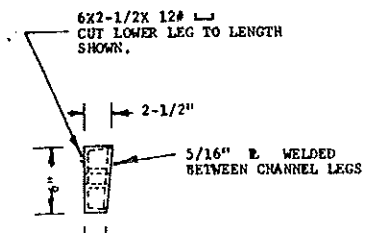


12-15-80		NORTH DAKOTA STATE HIGHWAY DEPARTMENT
REVISIONS		
DATE	CHANGE	SUBMITTED: <i>[Signature]</i> DESIGN ENGINEER
7-28-81	GUARDRAIL HEIGHT	
10-13-81	BLOCKOUT SIZE AND WEIGHT	
6-24-82	ELEV. & SPACER DETAIL	
9-27-82	ADD NOTE & BOLT LENGTH	


CONSTRUCTION SIGN DETAILS

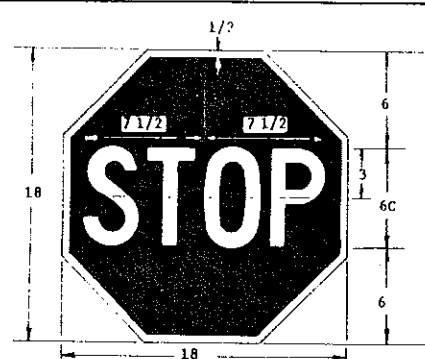


STOP-SLOW PADDLE  
RED & WHITE  
FLAGPERSON PADDLE

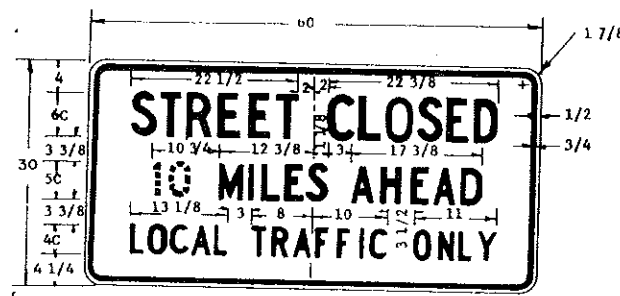


R11-2a-87  
BLACK & WHITE

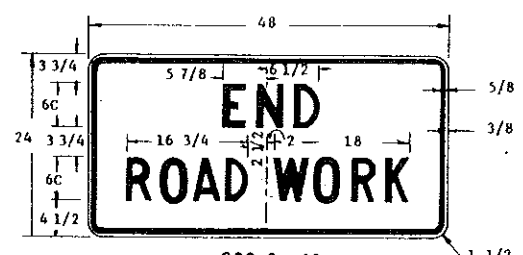


Q20-2a-48  
BLACK & ORANGE

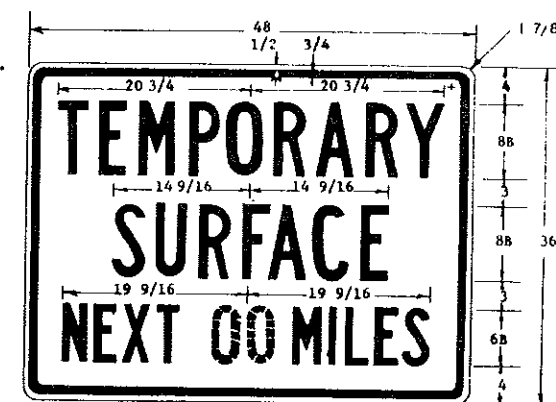


Q20-8-46  
BLACK & ORANGE

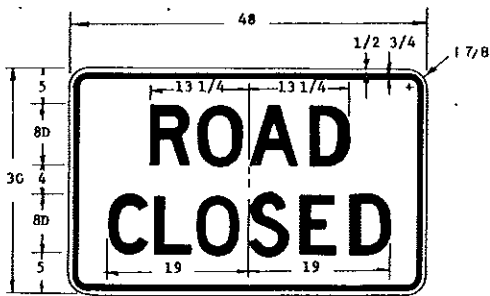

R11-2-48  
BLACK & WHITE

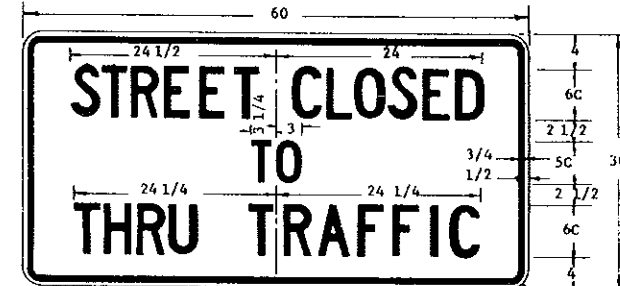


R11-4a-60  
BLACK & WHITE

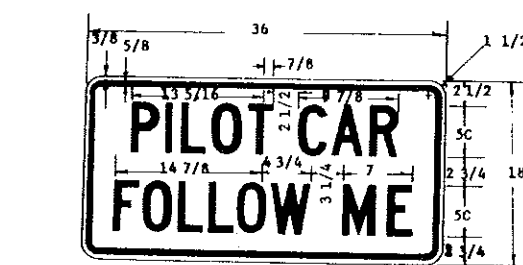

Q20-4-38  
BLACK & ORANGE


PILOT CAR SIGN SHALL BE MOUNTED ON REAR OF A VEHICLE USED FOR GUIDING CONTROLLED ONE-WAY TRAFFIC THROUGH A CONSTRUCTION AREA.

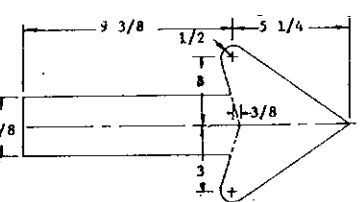


ARROW DETAIL FOR SIGN NO'S.  
Q20-50-72 & Q20-52-72

MESSAGES AND BORDERS: THE MESSAGES AND BORDERS SHALL BE SCREENED ON REFLECTIVE SHEETING OR IN STALLED USING PIGMENTED PLASTIC FILM CONFORMING TO THE REQUIREMENT OF SEC. 804-3.5 OF THE STD. SPECIFICATIONS. THE PIGMENTED PLASTIC FILM SHALL BE INSTALLED IN ACCORDANCE WITH THE REFLECTIVE SHEETING MANUFACTURERS RECOMMENDATIONS. THE BORDERS SHALL HAVE THE RADII AND WIDTH SHOWN ON THE PLANS. THE LETTERS SHALL BE FABRICATED IN ACCORDANCE WITH THE STANDARD LETTER GUIDE OF THE HEIGHT AND SERIES SHOWN ON THE PLANS. THE DETAILS OF THESE LETTERS MAY BE OBTAINED FROM THE STATE HIGHWAY DEPARTMENT OR THE SHEETING MANUFACTURER.


NOTE: ALL SIGNS SHALL HAVE REFLECTORIZED MESSAGE BORDER AND BACKGROUND, UNLESS SHOWN OTHERWISE ON THE PLANS. IN NO CASE IS THE COLOR BLACK REFLECTORIZED.

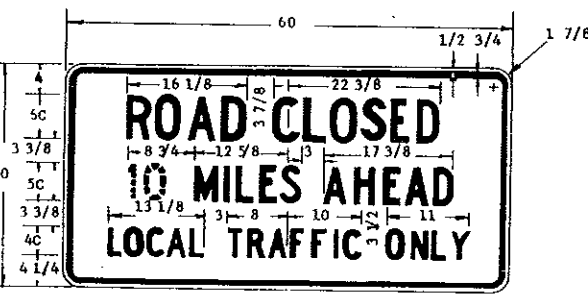


R11-3a-80  
BLACK & WHITE

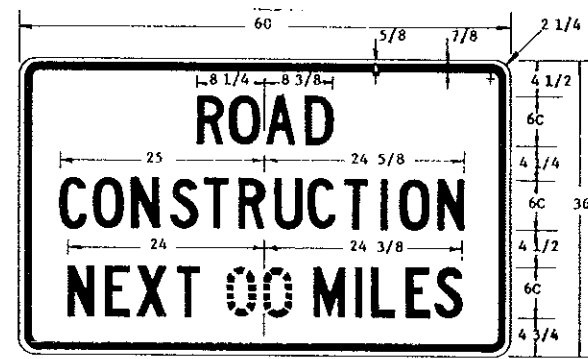


Q20-1-60  
BLACK & ORANGE

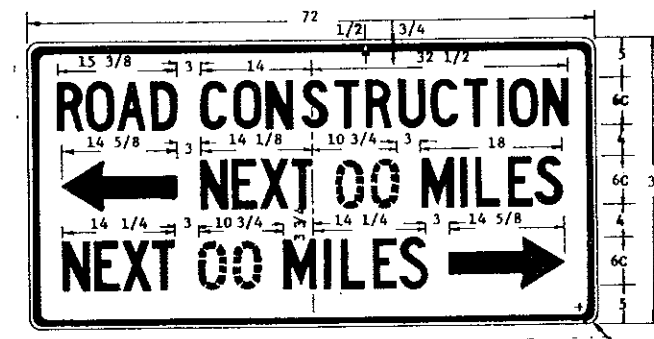

Q20-60-72  
BLACK & ORANGE

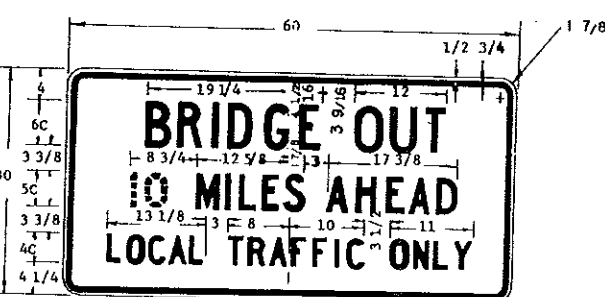

R11-3b-60  
BLACK & WHITE

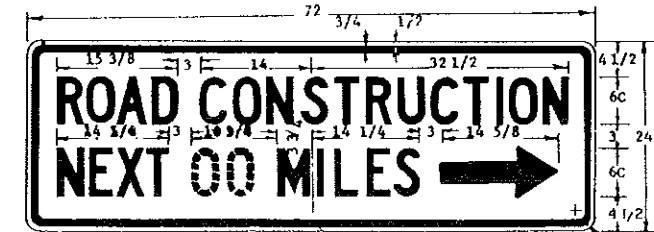


Q20-62-72  
BLACK & ORANGE

ARROW MAY BE TO RIGHT OR LEFT OF LEGEND TO INDICATE CONSTRUCTION TO THE RIGHT OR LEFT.



R11-2b-48  
BLACK & WHITE

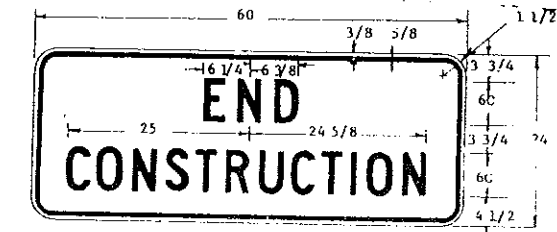

Q20-2-60  
BLACK & ORANGE



















Q20-54-48  
BLACK & ORANGE

2-17-78 REVISIONS		NORTH DAKOTA STATE HIGHWAY DEPARTMENT
DATE	CHANGE	
12-18-78	TITLE ADDED	Submitted: <i>[Signature]</i> District Engineer
2-21-80	SIGN COLOR	
6-23-80	SIGN DIMENSIONS	
7-19-80	SIGN MOUNTING	
8-1-81	SIGN MATERIALS	
		Recommended: <i>[Signature]</i> Assistant District Engineer
		Approved: <i>[Signature]</i> District Engineer

CONSTRUCTION SIGN DETAILS

FHWA REGION	STATE	FED. AID DIST. NO.	
8	N.D.	BRF-1-006(02)066	D-754-2

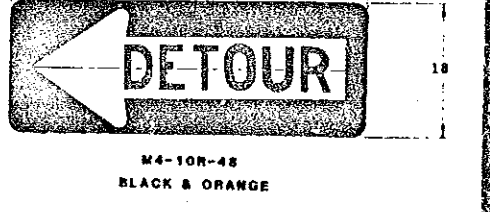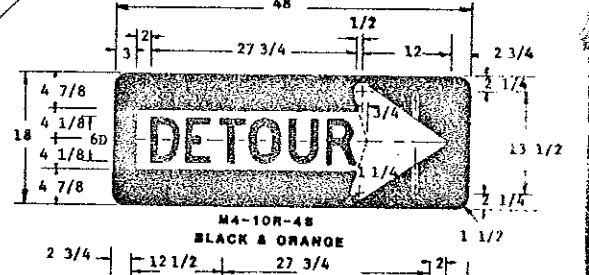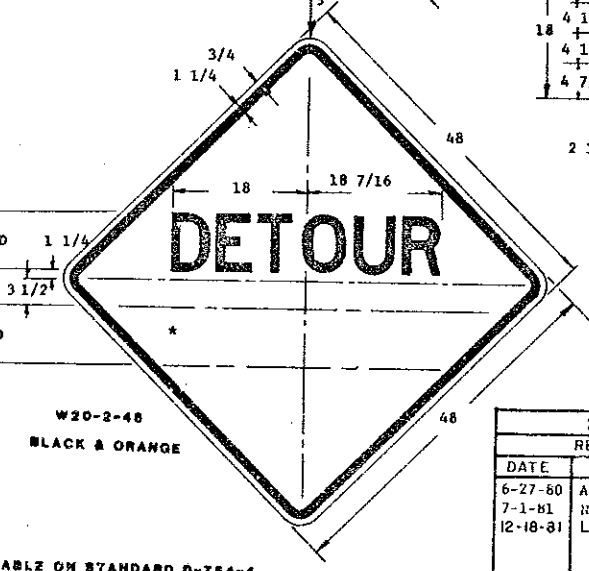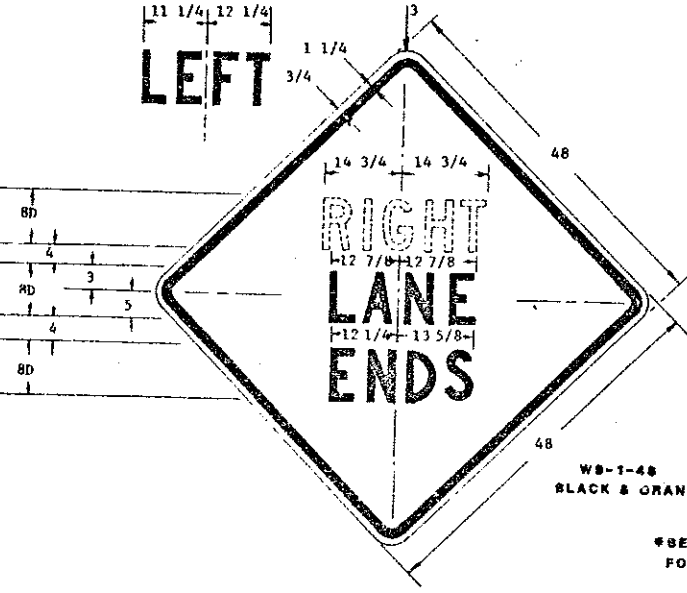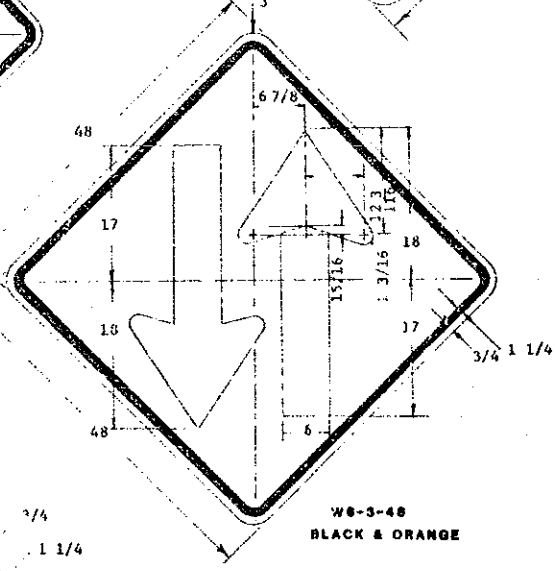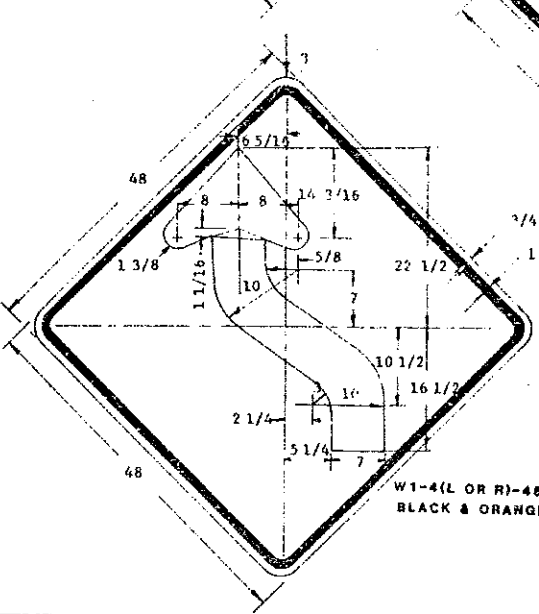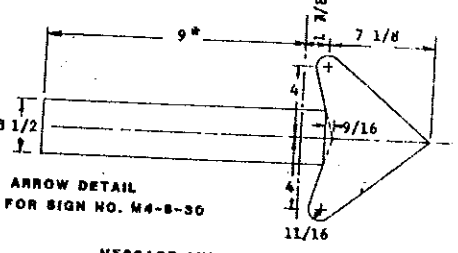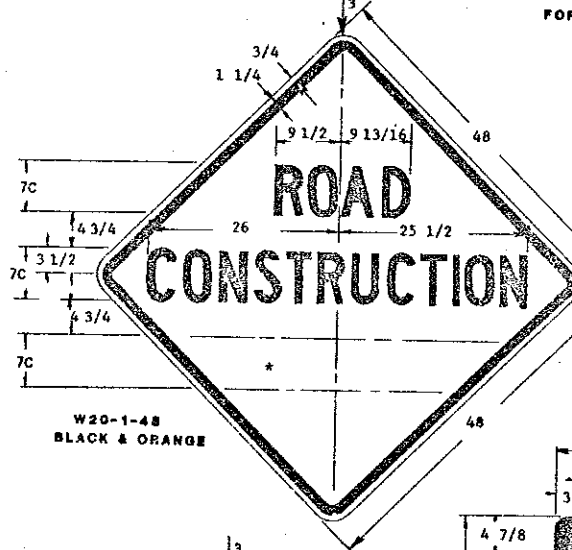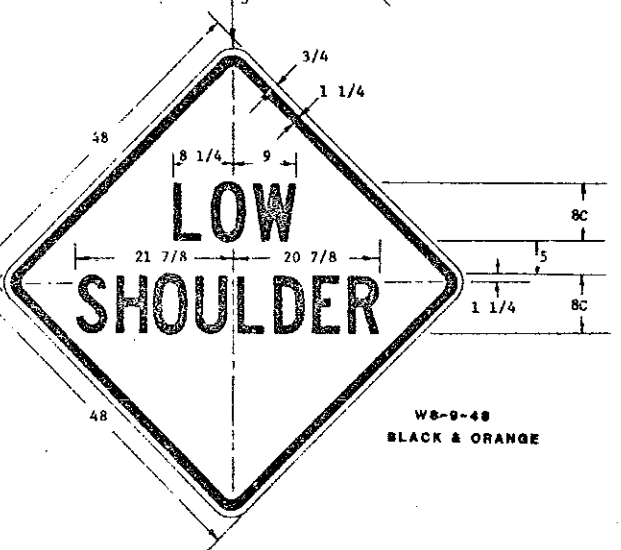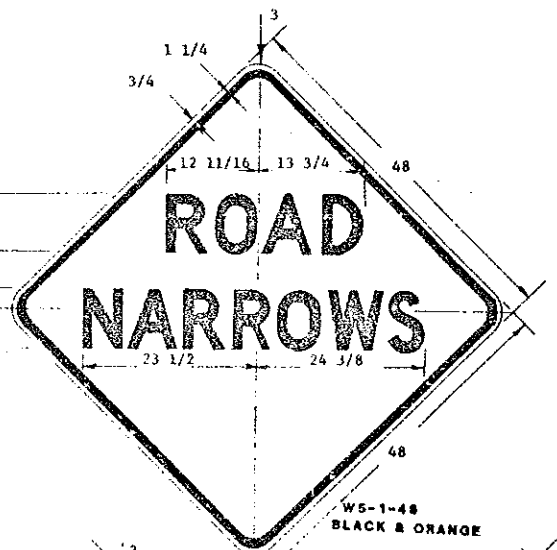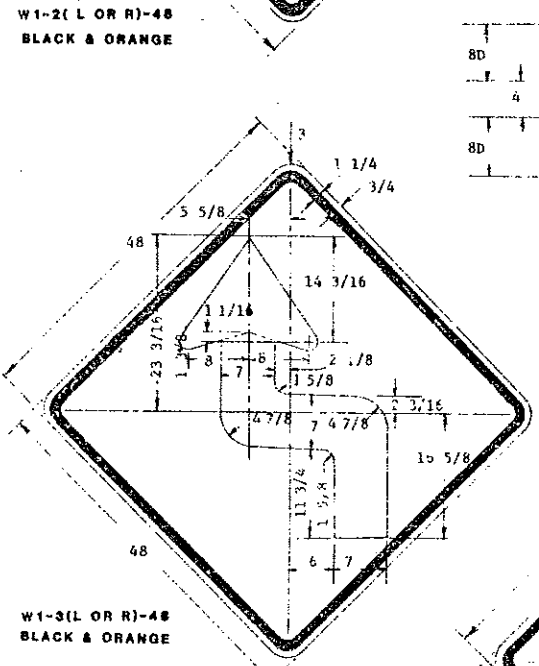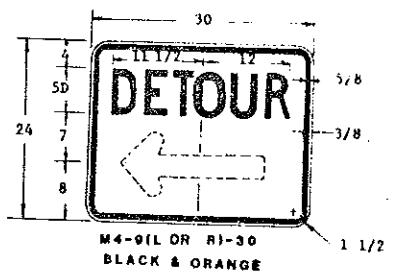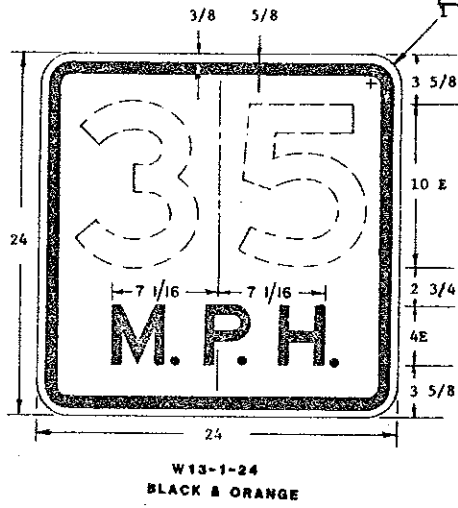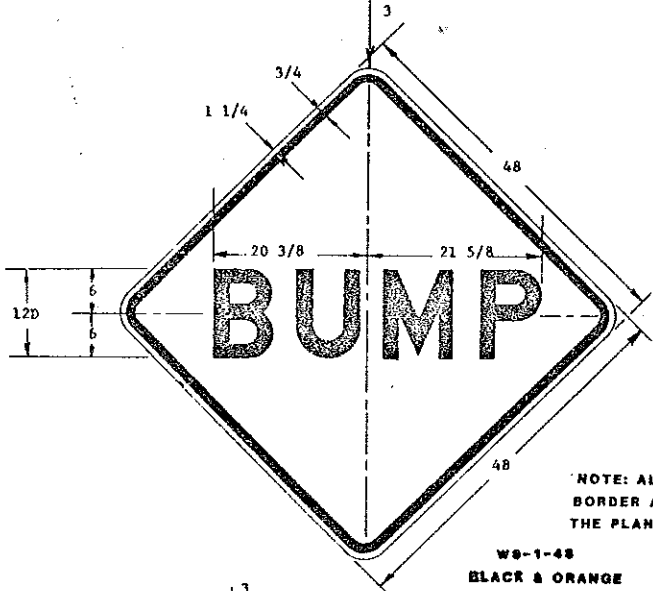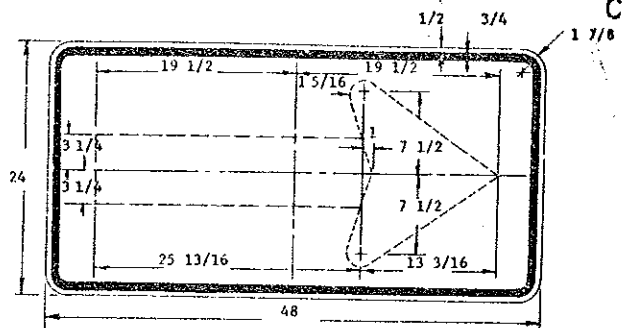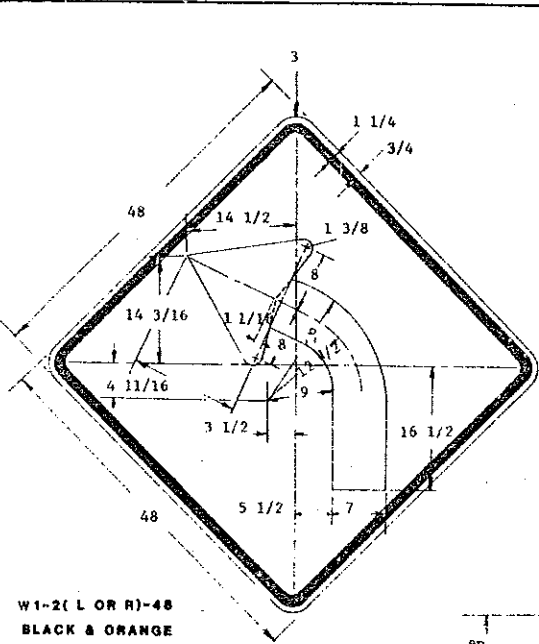

NOTE: ALL SIGNS SHALL HAVE REFLECTORIZED MESSAGE BORDER AND BACKGROUND, UNLESS SHOWN OTHERWISE ON THE PLANS. IN NO CASE IS THE COLOR BLACK REFLECTORIZED.

MESSAGE AND BORDER: THE MESSAGES AND BORDERS SHALL BE SCREENED ON REFLECTIVE SHEETING OR INSTALLED USING PIGMENTED PLASTIC FILM CONFORMING TO THE REQUIREMENT OF SEC. 694-3.8 OF THE STD. SPECIFICATIONS. THE PIGMENTED PLASTIC FILM SHALL BE INSTALLED IN ACCORDANCE WITH THE REFLECTIVE SHEETING MANUFACTURER'S RECOMMENDATIONS. THE BORDERS SHALL HAVE THE RADII AND WIDTH SHOWN ON THE PLANS. THE LETTERS SHALL BE FABRICATED IN ACCORDANCE WITH THE STANDARD LETTER GUIDE OF THE HEIGHT AND SERIES SHOWN ON THE PLANS. THE DETAILS OF THESE LETTERS MAY BE OBTAINED FROM THE STATE HIGHWAY DEPARTMENT OR THE SHEET MANUFACTURER.

\*DIMENSION SHALL BE 3" WHEN ARROW IS PLACED VERTICALLY.

2-17-78	
REVISIONS	
DATE	CHANGE
6-27-80	ADDED NOTE
7-1-81	NOTE ADDITION
12-18-81	LETTERING

NORTH DAKOTA  
STATE HIGHWAY DEPARTMENT  
Submitted: *[Signature]*  
Design Engineer  
Recommended: \_\_\_\_\_  
Asst. Chief Engineer, Pre - Constr  
Approved: *[Signature]*  
Chief Engineer











\*SEE TABLE ON STANDARD D-754-4 FOR MESSAGE AND DIMENSIONS.





CONSTRUCTION SIGN DETAILS

STATE REGION	N.D.	PROJECT NO.	BRF-1-006(02)066
		DATE	D 754-4

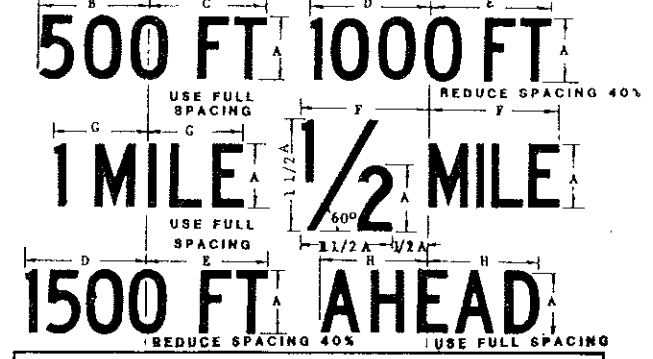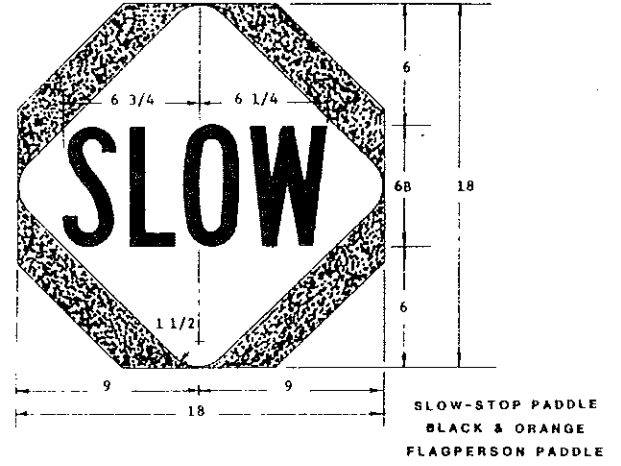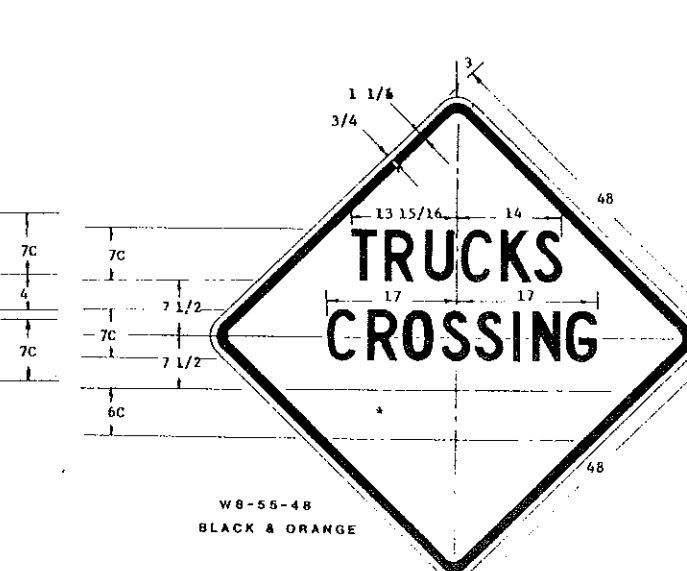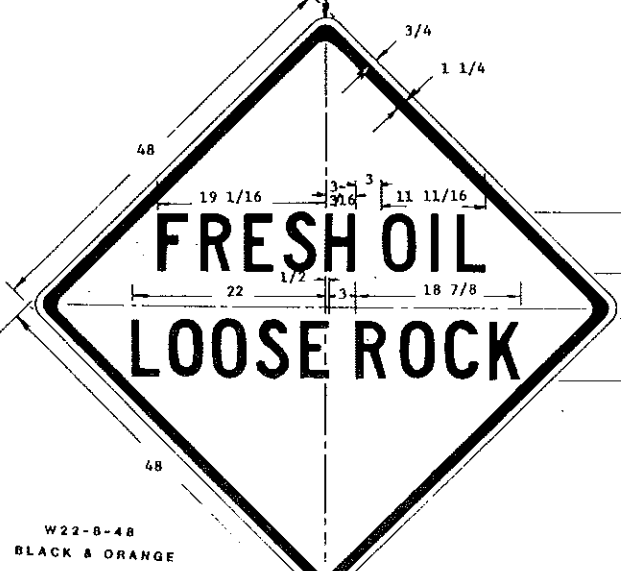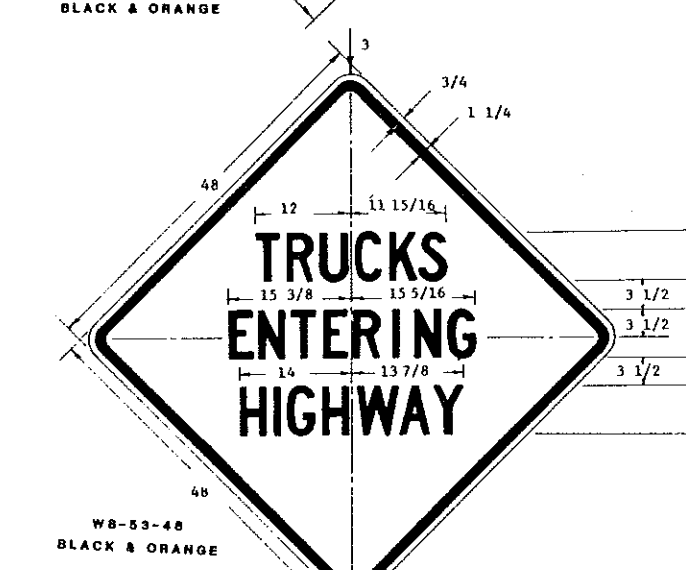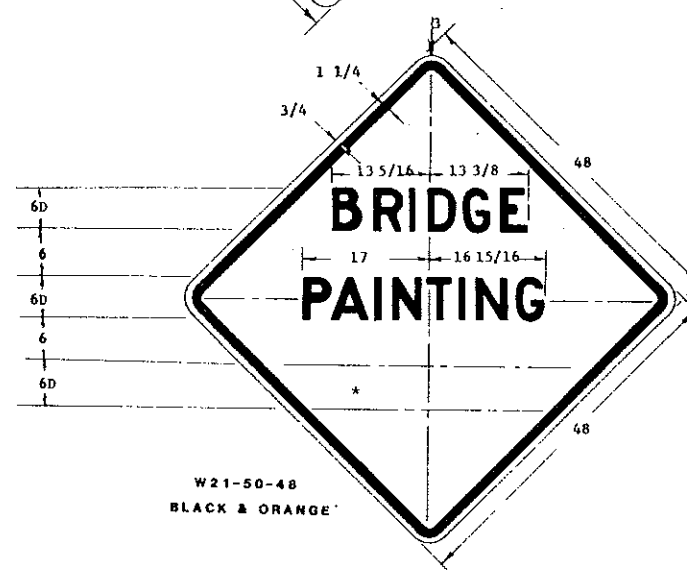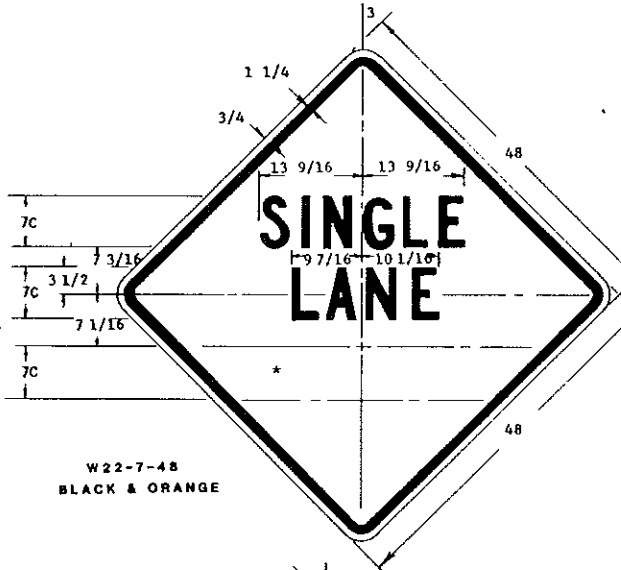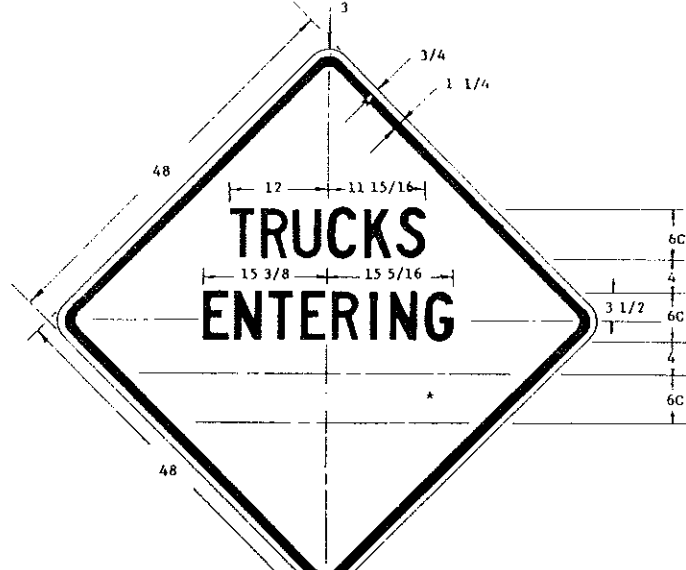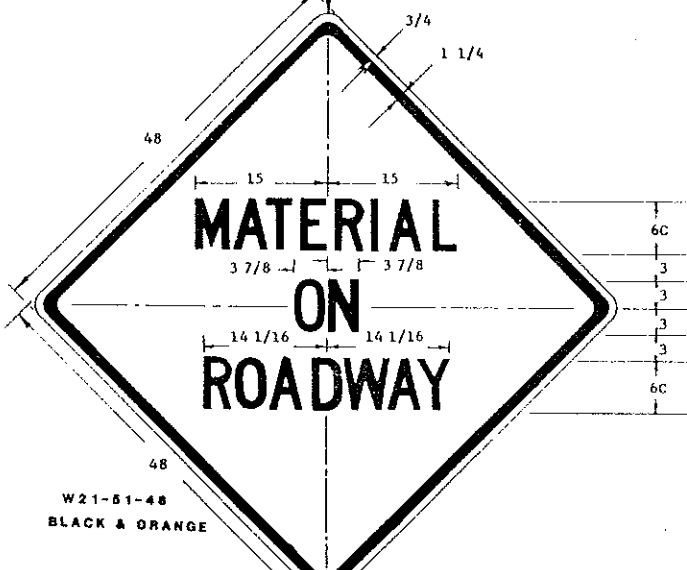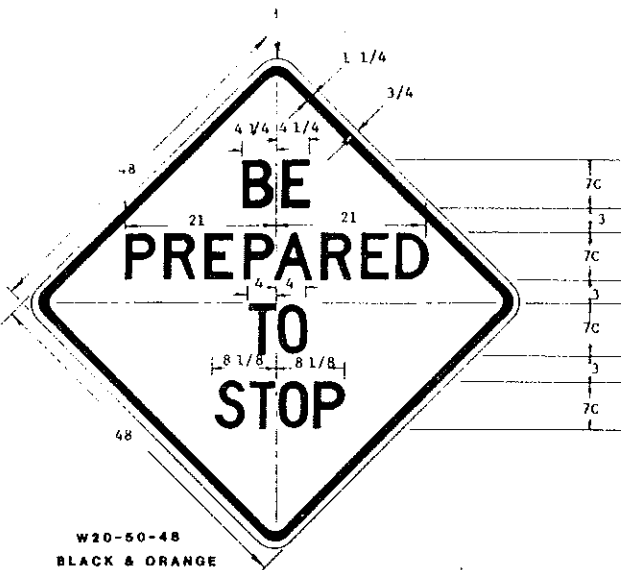

DIMENSIONS (INCHES)							
A	B	C	D	E	F	G	H
4C	6-7/8	7	7-1/2	8	8-5/16	6-1/16	7
5C	8-3/4	8-13/16	9-3/8	10	10-7/16	7-5/8	8-3/4
6C	10-3/8	10-1/2	11-1/4	12	12-1/2	9-1/8	10-1/2
7C	12	12-3/16	13-1/8	14	14-9/16	10-5/8	12-1/4
8C	13-3/4	14	16	16	16-5/8	12-1/8	14
4D	8-1/8	8-5/8	8-1/2	9	9	7-3/16	8-11/16
5D	10-3/16	10-13/16	11-5/8	11-1/4	11-1/4	9-1/2	10-7/8
6D	12-3/16	12-15/16	12-3/4	13-1/2	13-1/2	11-13/16	13-1/8
7D	14-1/4	15-1/8	14-7/8	15-3/4	15-3/4	13-1/16	15-1/2
8D	16-1/4	17-1/4	17	18	18	14-3/8	17-7/14

MESSAGES AND BORDERS: THE MESSAGES AND BORDERS SHALL BE SCREENED ON REFLECTIVE SHEETING OR INSTALLED USING PIGMENTED PLASTIC FILM CONFORMING TO THE REQUIREMENT OF SEC. 804-3.8 OF THE STD. SPECIFICATIONS. THE PIGMENTED PLASTIC FILM SHALL BE INSTALLED IN ACCORDANCE WITH THE REFLECTIVE SHEETING MANUFACTURERS RECOMMENDATION.

THE BORDERS SHALL HAVE THE RADII AND WIDTH SHOWN ON THE PLANS. THE LETTERS SHALL BE FABRICATED IN ACCORDANCE WITH THE STANDARD LETTER GUIDE OF THE HEIGHT AND SERIES SHOWN ON THE PLANS. THE DETAILS OF THESE LETTERS MAY BE OBTAINED FROM THE STATE HIGHWAY DEPARTMENT OR THE SHEETING MANUFACTURER.



NOTE: ALL SIGNS SHALL HAVE REFLECTORIZED MESSAGE BORDER AND BACKGROUND, UNLESS SHOWN OTHERWISE ON THE PLANS. IN NO CASE IS THE COLOR BLACK REFLECTORIZED.

STANDARD SIGNS THAT ARE SHOWN IN THE CONSTRUCTION SIGN AND BARRICADE LOCATION DETAILS SHALL BE FABRICATED IN THE SHAPE, COLOR AND DIMENSIONS AS SHOWN IN THE STANDARD SIGNS LAYOUT BOOKLET.



2-17-78		NORTH DAKOTA	
REVISIONS		STATE HIGHWAY DEPARTMENT	
DATE	CHANGE	Submitted	Design Engineer
6-27-80	REVISED SIGN SIZES	Recommended	Asst Chief Engineer, Pre-Constr
12-17-81	Notes	Approved	Chief Engineer




### BARRICADE DETAILS

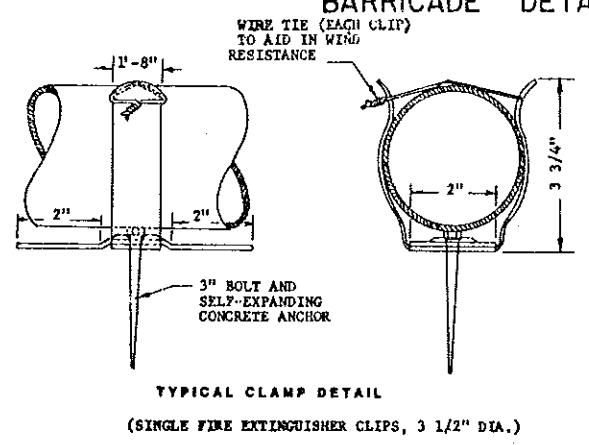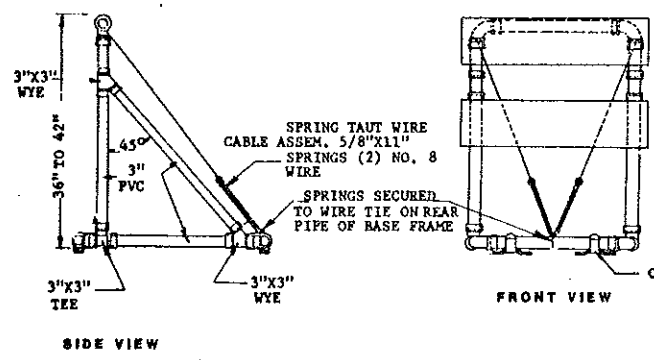



**DELINEATOR DRUMS**  
THE MARKINGS ON DRUMS SHALL BE ORANGE AND WHITE STRIPES 4 TO 8 INCHES WIDE. THERE SHALL BE AT LEAST THREE ORANGE AND TWO WHITE STRIPES. WHERE DRUMS HAVE RIBS OR INDENTATION THERE SHALL BE NO REFLECTORIZED SHEETING IN THIS AREA. THIS SPACE SHALL BE PAINTED ORANGE AND SHALL BE NO MORE THAN 2 INCHES WIDE. THE STRIPE COLOR SHALL BE CHANGED AT THESE POINTS (ORANGE ABOVE WHITE BELOW OR WHITE ABOVE AND ORANGE BELOW). THE DRUM SURFACE SHALL BE PREPARED AS RECOMMENDED BY THE SHEETING MANUFACTURER BEFORE REFLECTIVE SHEETING IS APPLIED.

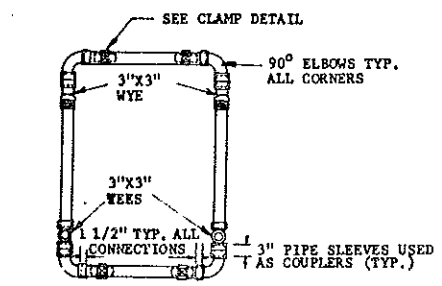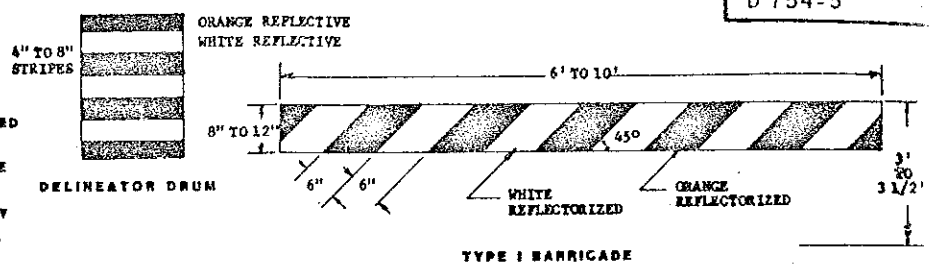

**NOTE:** THE PIPE, WYES, TEES AND ELBOWS USED TO CONSTRUCT TYPE II BARRICADES (SPECIAL) SHALL CONFORM TO THE REQUIREMENTS OF ASTM DESIGNATION: D2241 FOR PVC 1120 OR 1220, SDR 21. PRESSURE RATING 200 P.S.I. THE WYES, TEES, AND ELBOWS SHALL CONFORM TO THE REQUIREMENTS OF ASTM DESIGNATION: D-2486, TYPE II, GRADE 1. ALL JOINTS SHALL BE SLIP-FIT AND SHALL NOT BE THREADED OR CEMENTED.

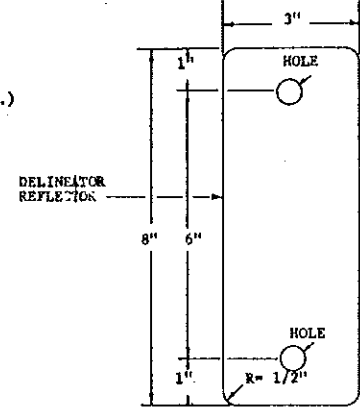


3" x 8" - 18 GAUGE GALVANIZED STEEL SHEETS, OR OR .080" ALUMINUM PLATE WITH WHITE REFLECTIVE SHEETING (TYPE III OR IV) AS SPECIFIED IN SECTION 804 OF THE STANDARD SPECIFICATIONS.

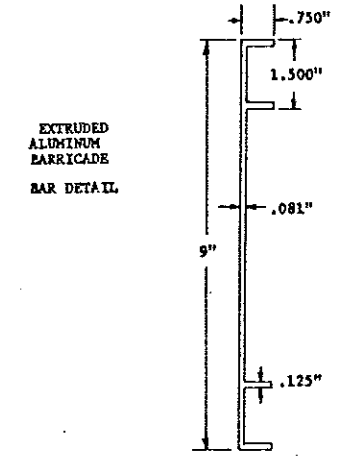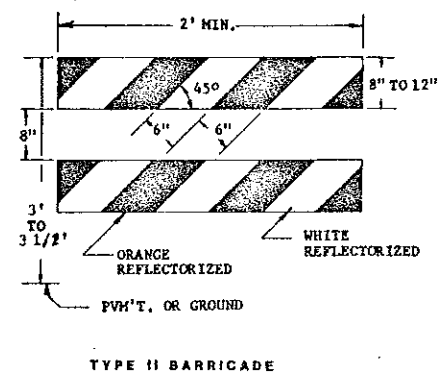


3" PVC PIPE CONFORMING TO ASTM D2885-DWV OR ASTM D2728 MAY BE USED AS AN ALTERNATE TO ASTM D2241-SDR 21.







THE 9" X 48" BARRICADE RAIL SHALL BE FABRICATED FROM 0.025" ANODIZED ALUMINUM AND SHALL BE ATTACHED WITH 1 INCH NO. 14 PAN BEAD METAL SCREWS. COLORS: REFLECTIVE ORANGE AND REFLECTIVE WHITE.

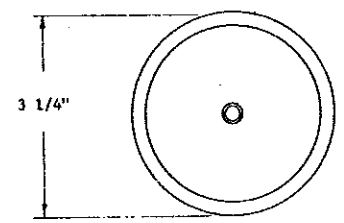

DELINEATOR REFLECTOR SHALL MEET THE REQUIREMENTS OF SECTION 804.

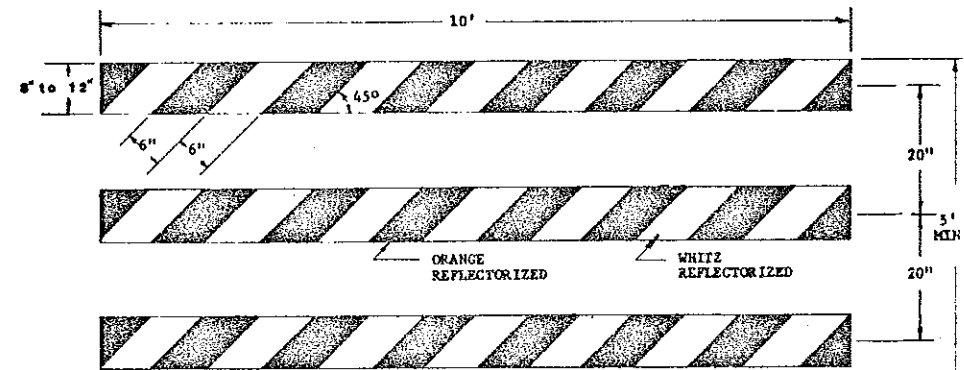

**NOTE:** EACH MOVABLE BARRICADE SHALL BE WEIGHTED DOWN BY A SUFFICIENT NUMBER OF SAND BAGS OR OTHER SUITABLE WEIGHT SO THAT IT WILL NOT BE BLOWN OVER BY THE WIND UNLESS THE MOVABLE SUPPORTING STRUCTURE IS CONSTRUCTED IN SUCH A MANNER THAT THE WIND CANNOT BLOW IT OVER. WEIGHT USED SHALL BE APPROVED BY THE ENGINEER IN THE FIELD. THE STRIPES SHALL SLANT DOWNWARD TOWARD THE SIDE WHICH TRAFFIC IS TO PASS. BARRICADES USED AT THE BEGINNING OF A PROJECT SHALL FACE TRAFFIC ENTERING THAT PROJECT.




















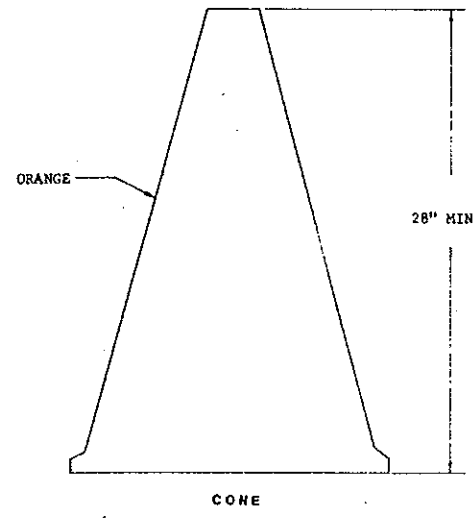
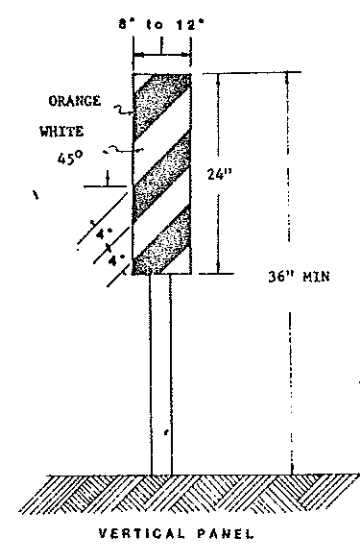
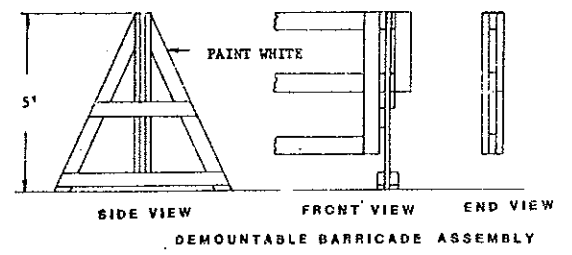
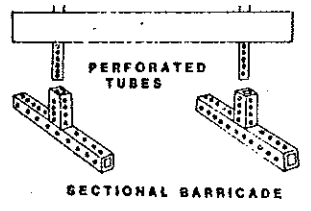
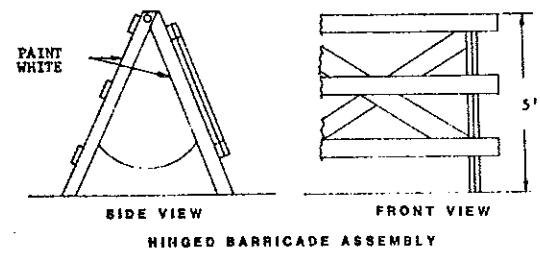
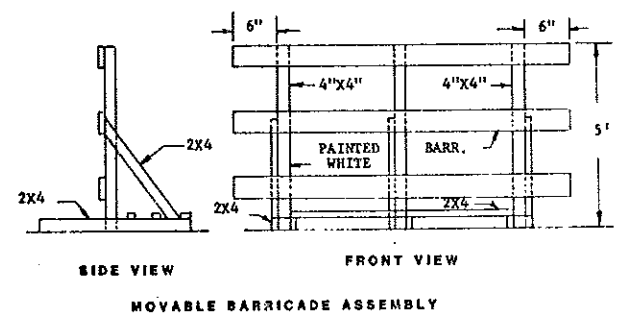


2-17-78		NORTH DAKOTA STATE HIGHWAY DEPARTMENT
REVISIONS		
DATE	CHANGE	Submitted: <i>[Signature]</i> Design Engineer Recommended: _____ Asst. Chief Engineer, Pre-Const Approved: <i>[Signature]</i> Chief Engineer
5-14-79	Delineator Drum Removed	
5-12-81	NOTE CHANGE	
9-1-81	NOTES	
1-18-82	Dimensions	
4-8-82	HEADING & PANEL	

CONSTRUCTION SIGN AND BARRICADE ASSEMBLY DETAILS

FHWA REGION	STATE	FED AID PROJ NO	SHEET NO.
8	N.D.		

D-754-5-A

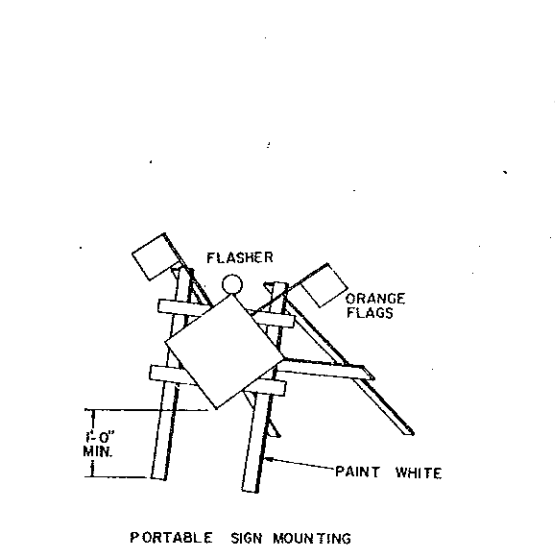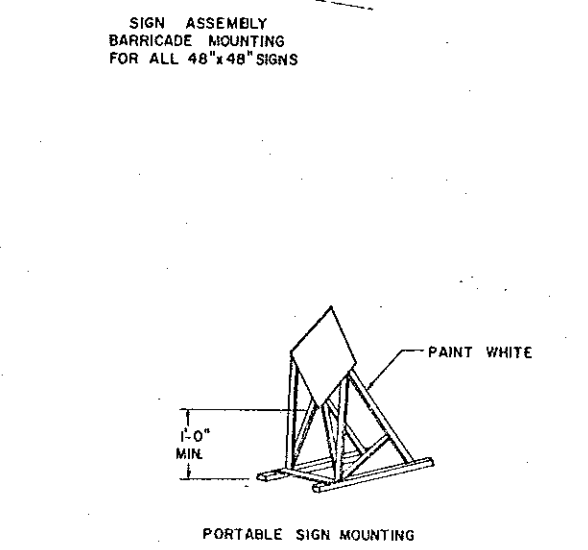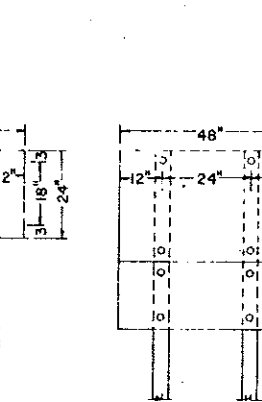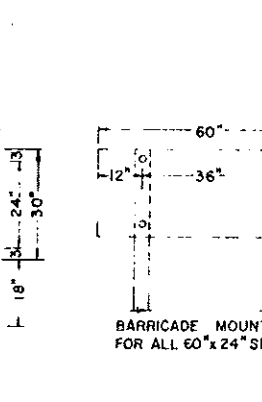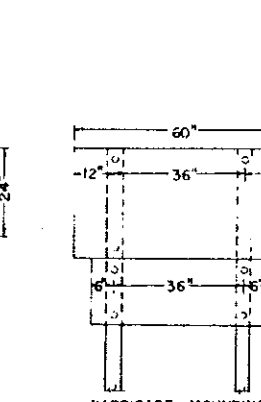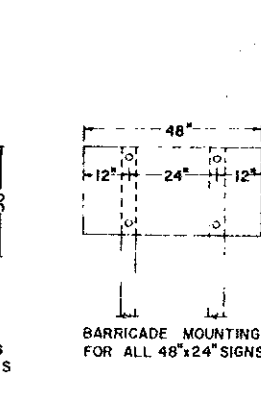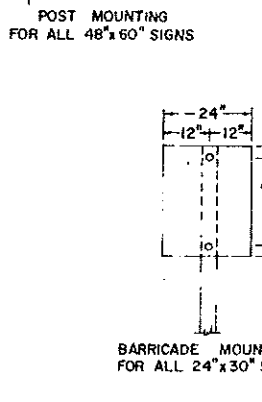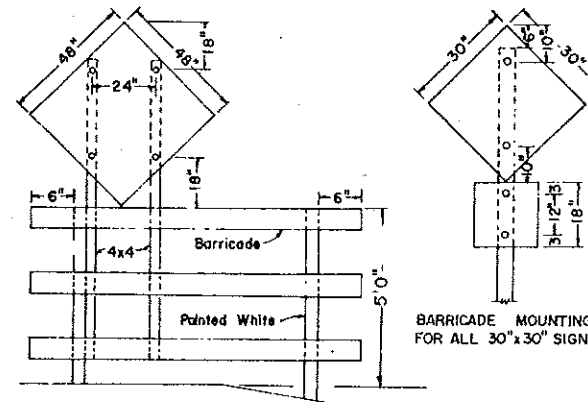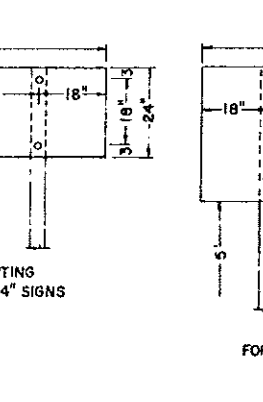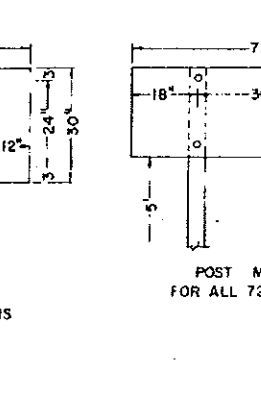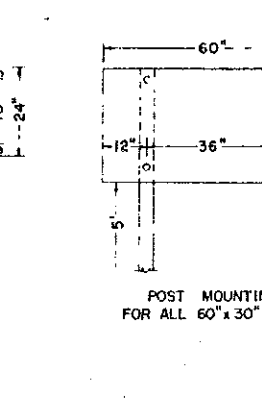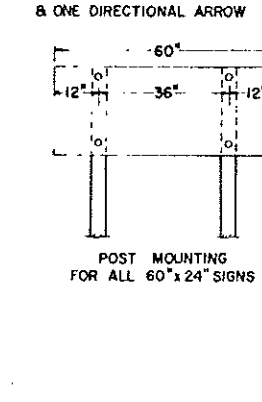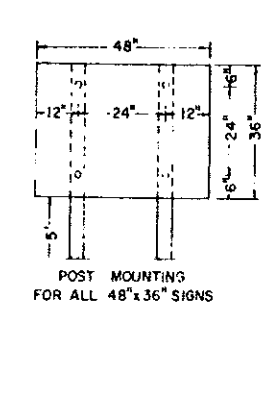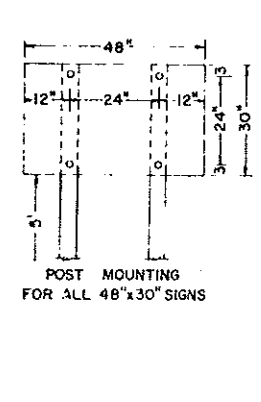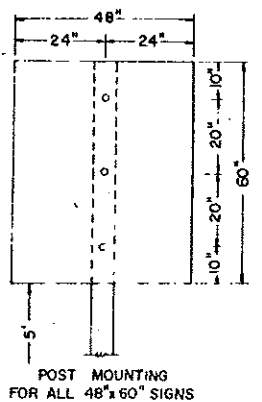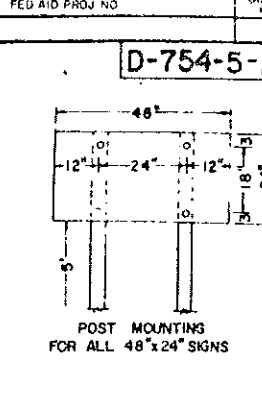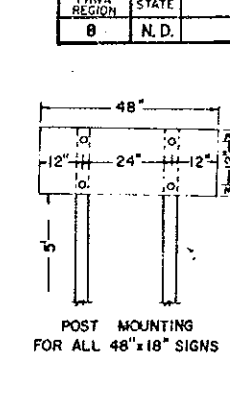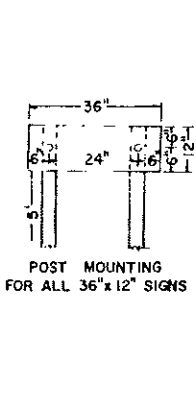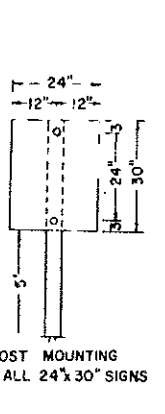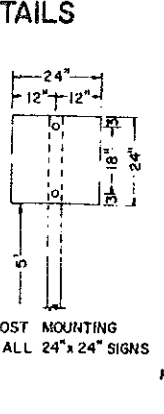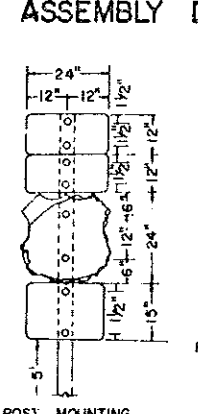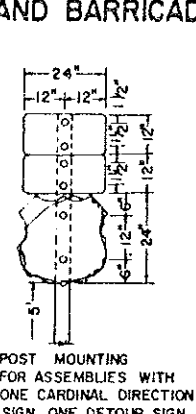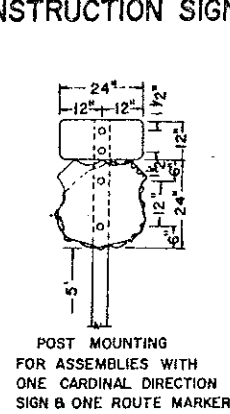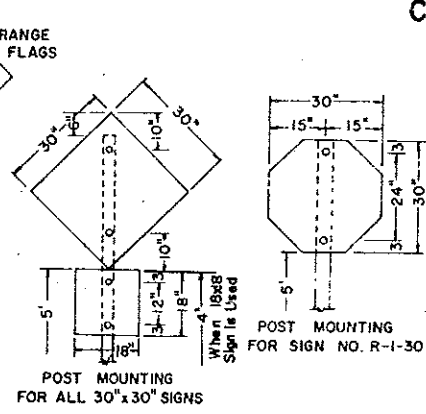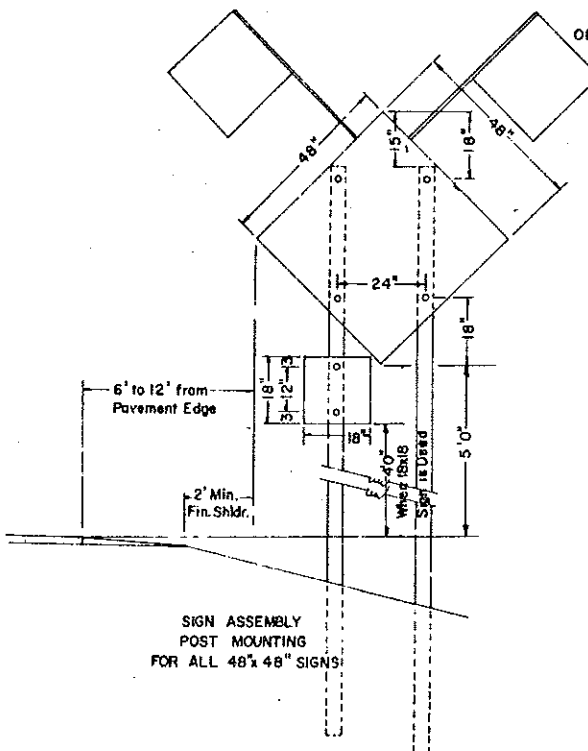

NOTES:  
Barricade and Sign Supports: Wooden supports shall be painted white. Steel supports shall be galvanized or painted.

NOTES:  
DELINEATOR POSTS: Typical fence post sections are shown in Attachment Details. Other types of metal fence posts may be substituted upon approval of the engineer. These substituted posts shall have reflectors attached similar to the ones shown.  
BARRICADE MOUNTING SIGNS: The bottom of the sign shall be flush with the top of the top rail. Wood sign posts shall be 4x4 min. SFS or equivalent steel posts. See Sids. D-754-5 thru D-754-9 for construction sign and barricade location details. All barricades and barricade mounted signs shall be assembled with 3/8" bolts.


SIGN SUPPORTS: The sign supports shall be imbedded to a sufficient depth so that the signs will remain plumb throughout duration of the project. It is suggested that the min. depth of imbedment be 5'-0".

MATERIAL: All signs shall be 100" aluminum, 12 gage galv. steel, 1/2" plywood or other approved mat'l.

HOLES: All holes to be punched round for 3/8" bolts.

ALTERNATE MESSAGES: The signs that have alternate messages may have these alternate messages placed on a reflectorized plate without a border and this plate installed and removed as required.

DELINEATOR ATTACHMENT AND POST MOUNTING DETAILS

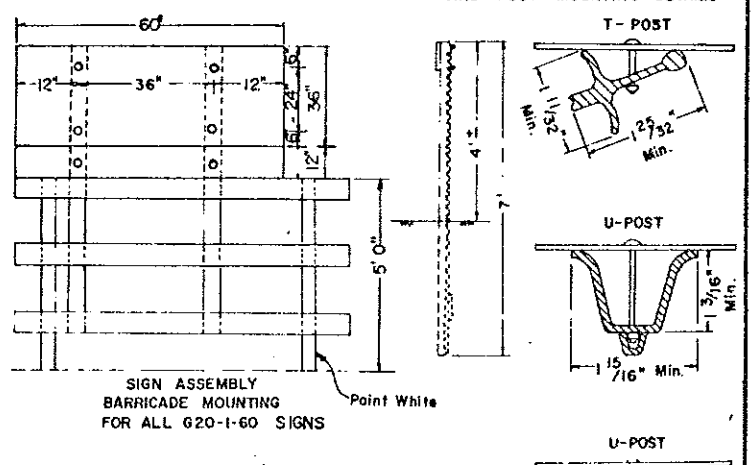

2-17-78	
DATE	REVISIONS
8-21-78	DETAIL ADDED
4-16-79	SIGN NO. CORRECTION
2-6-81	NOTE ADDED

NORTH DAKOTA STATE HIGHWAY DEPARTMENT

Submitted: *[Signature]*  
Design Engineer

Recommended: *[Signature]*  
Asst. Chief Engineer, Pre-Const.

Approved: *[Signature]*  
Chief Engineer



### CONSTRUCTION SIGN AND BARRICADE LOCATION DETAILS

**Lighting** - The flashers and steady burn lights shall be maintained as shown. If the danger exists at night and the work area is close to the traffic lane, the edge of the traffic lane on the work area side shall be illuminated by steady burn lights spaced at 100 ft. centers. The flashers shall be placed at the beginning and middle of the hazard. Where traffic is tapered into another lane, the flashers shall be placed at the beginning and middle of the taper, and the remaining tapering devices shall be illuminated by steady burn lights. The steady burn lamps shall be spaced at the dimension 3 used in calculating length of taper. Flashers shall be placed above the barricade bar and above all warning signs unless barricades and signs have encapsulated lens reflective sheeted faces.

**Mounting** - Barricade shown to be placed on roadway shall be on a movable Assembly. Sign to be mounted on barricades shall be mounted with the sign bottom on the top of the top barricade bar. Intermediate Sign shall be on a movable assembly. Sign show to be placed on roadway shall be placed on movable assemblies.

**FLAGS:** All advance warning signs shall have two orange warning flags 24" square mounted perpendicular to the edges of the diamond sign and at such a distance above the edges so that when flag is hung limp it will not touch the sign.

**Route Markers**

All route markers and assemblies shall be furnished by the State and shall be obtained from District offices and installed by the contractor


**State Maintained Detours**

The contractor shall furnish, install and maintain all barricades, signs & flares at beginning and ends of detour in accordance with the plans

**Contractor Maintained Detours**


The contractor shall furnish, install and maintain all construction signs and barricades in accordance with the plans

- KEY**
- Type I Barricades
  - Type II Barricades
  - Type III Barricades
  - Cones
  - △ Lighting Device
  - Flagman
  - Delineator Drums
  - Signs
  - Type A Delineator

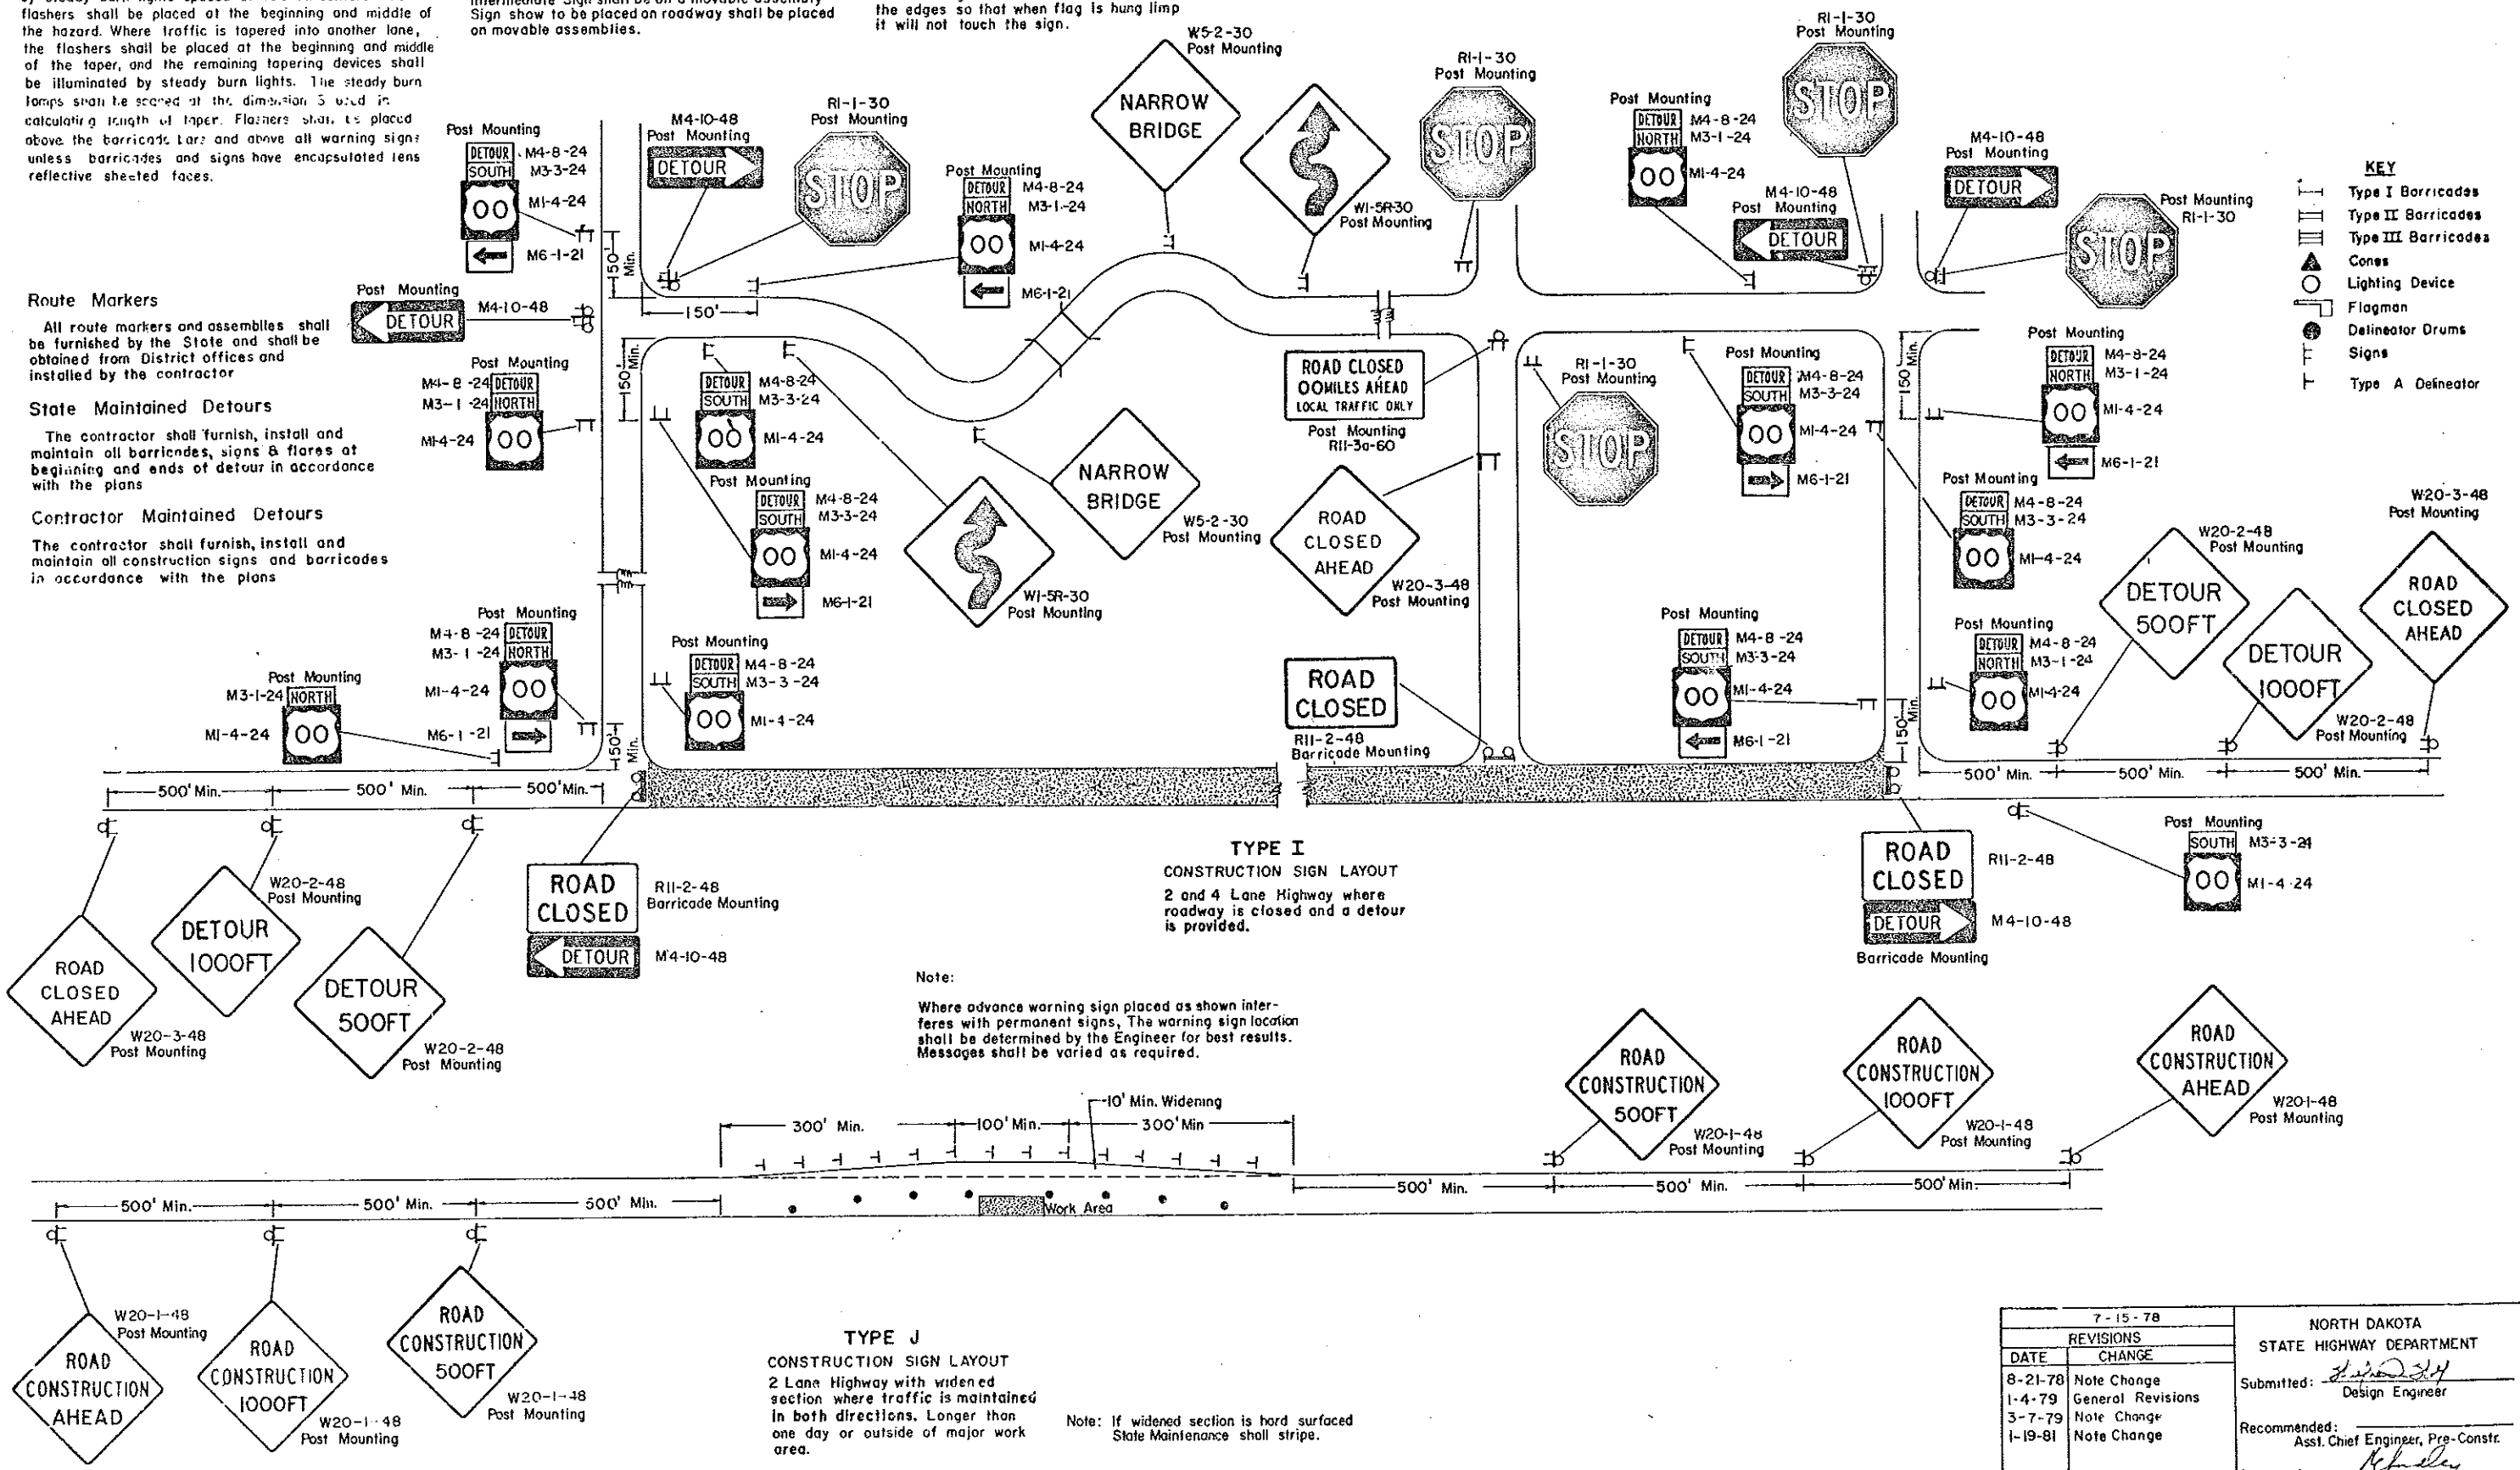

**TYPE I CONSTRUCTION SIGN LAYOUT**  
2 and 4 Lane Highway where roadway is closed and a detour is provided.

**Note:** Where advance warning sign placed as shown interferes with permanent signs, The warning sign location shall be determined by the Engineer for best results. Messages shall be varied as required.

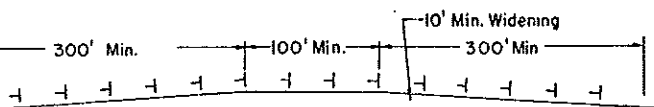


**TYPE J CONSTRUCTION SIGN LAYOUT**  
2 Lane Highway with widened section where traffic is maintained in both directions. Longer than one day or outside of major work area.

**Note:** If widened section is hard surfaced State Maintenance shall stripe.

7-15-78		NORTH DAKOTA STATE HIGHWAY DEPARTMENT
DATE	REVISIONS	
8-21-78	Note Change	Submitted: <i>[Signature]</i> Design Engineer
1-4-79	General Revisions	
3-7-79	Note Change	
1-19-81	Note Change	
Approved: <i>[Signature]</i> Chief Engineer		Recommended: Asst. Chief Engineer, Pre-Const.


CONSTRUCTION SIGN AND BARRICADE LOCATION DETAILS

FHWA REGION	STATE	FED. AID PROJ. NO.	SHEET NO.
8	N.D.	BRF-1-006(02)066	D-754-II

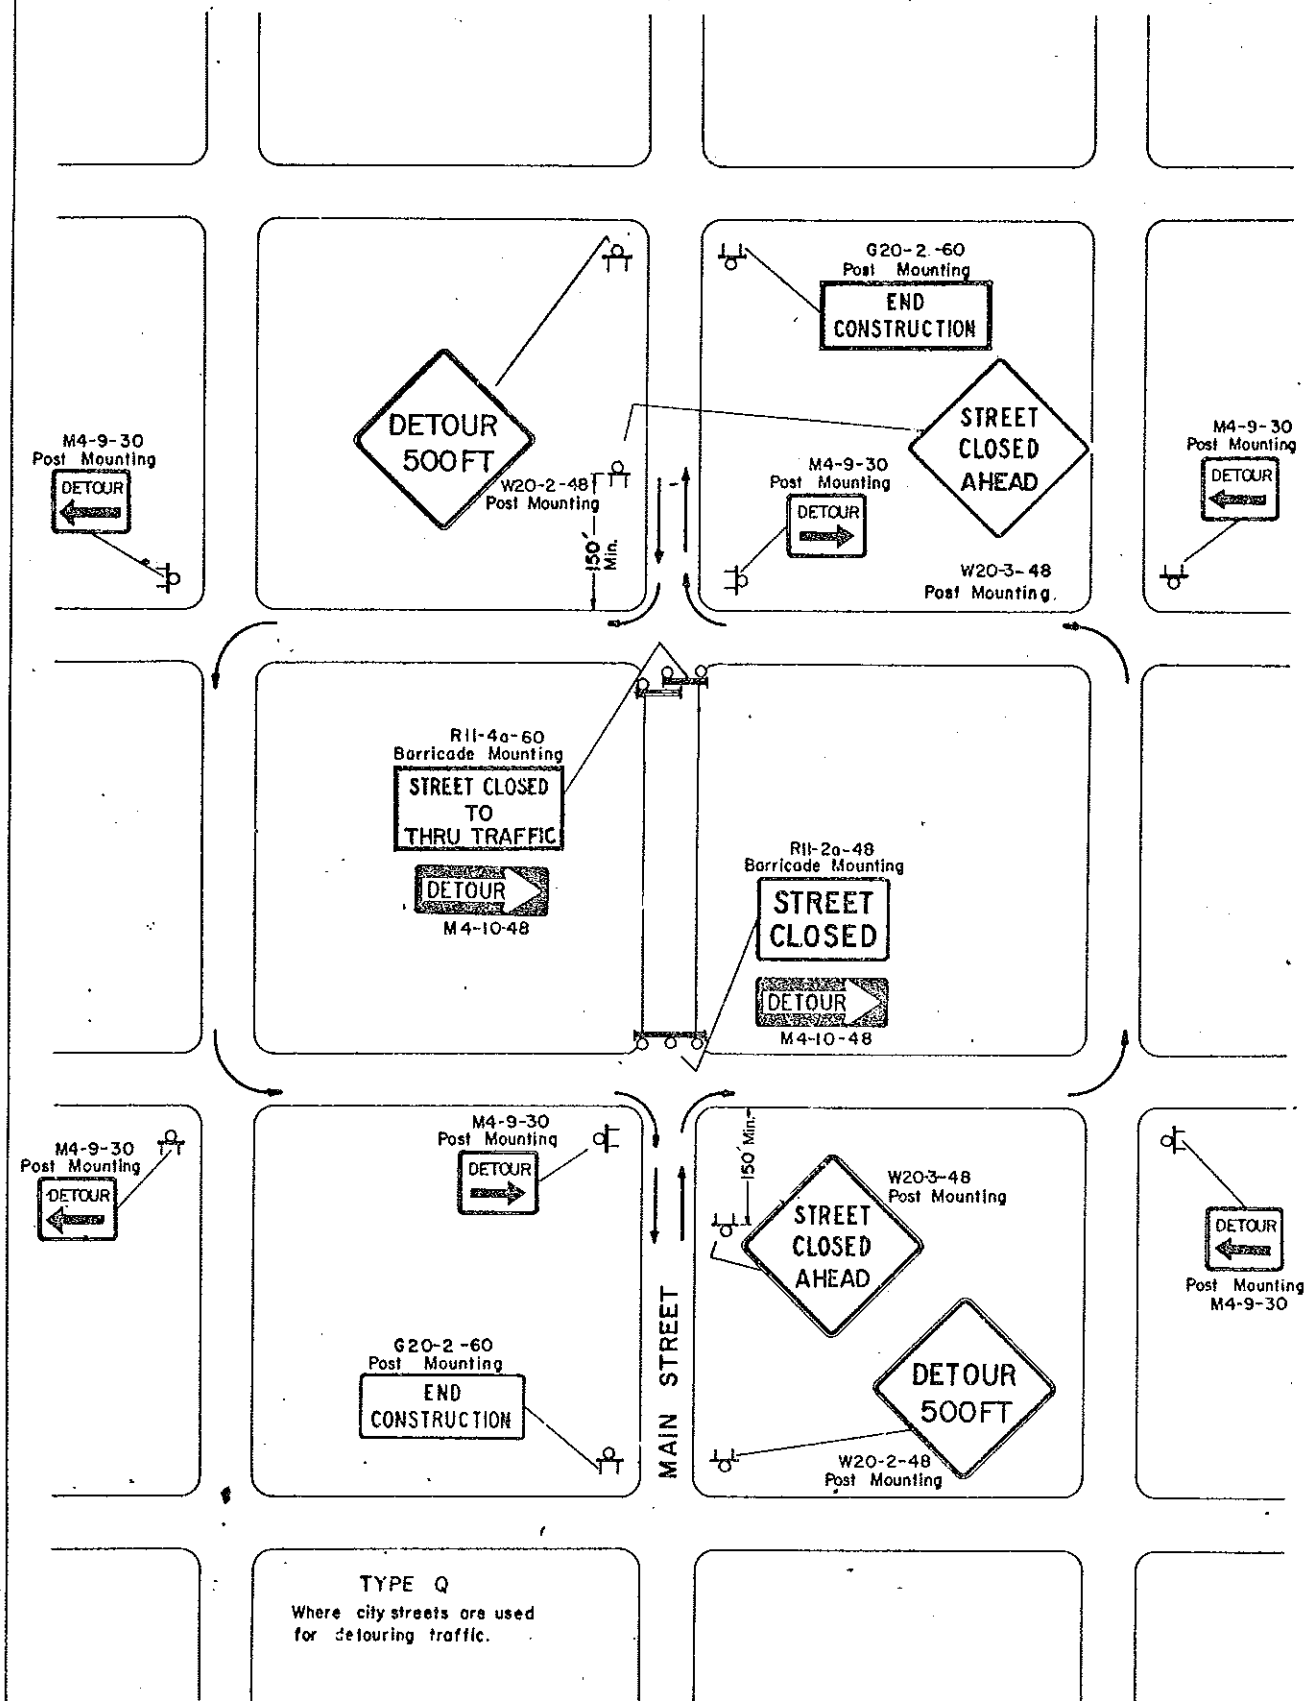

**TYPE Q**  
Where city streets are used for detouring traffic.

- KEY**
- Type I Barricades
  - Type II Barricades
  - Type III Barricades
  - ▲ Cones
  - Lighting Device
  - Flagman
  - Delineator Drums
  - Signs
  - Type A Delineator

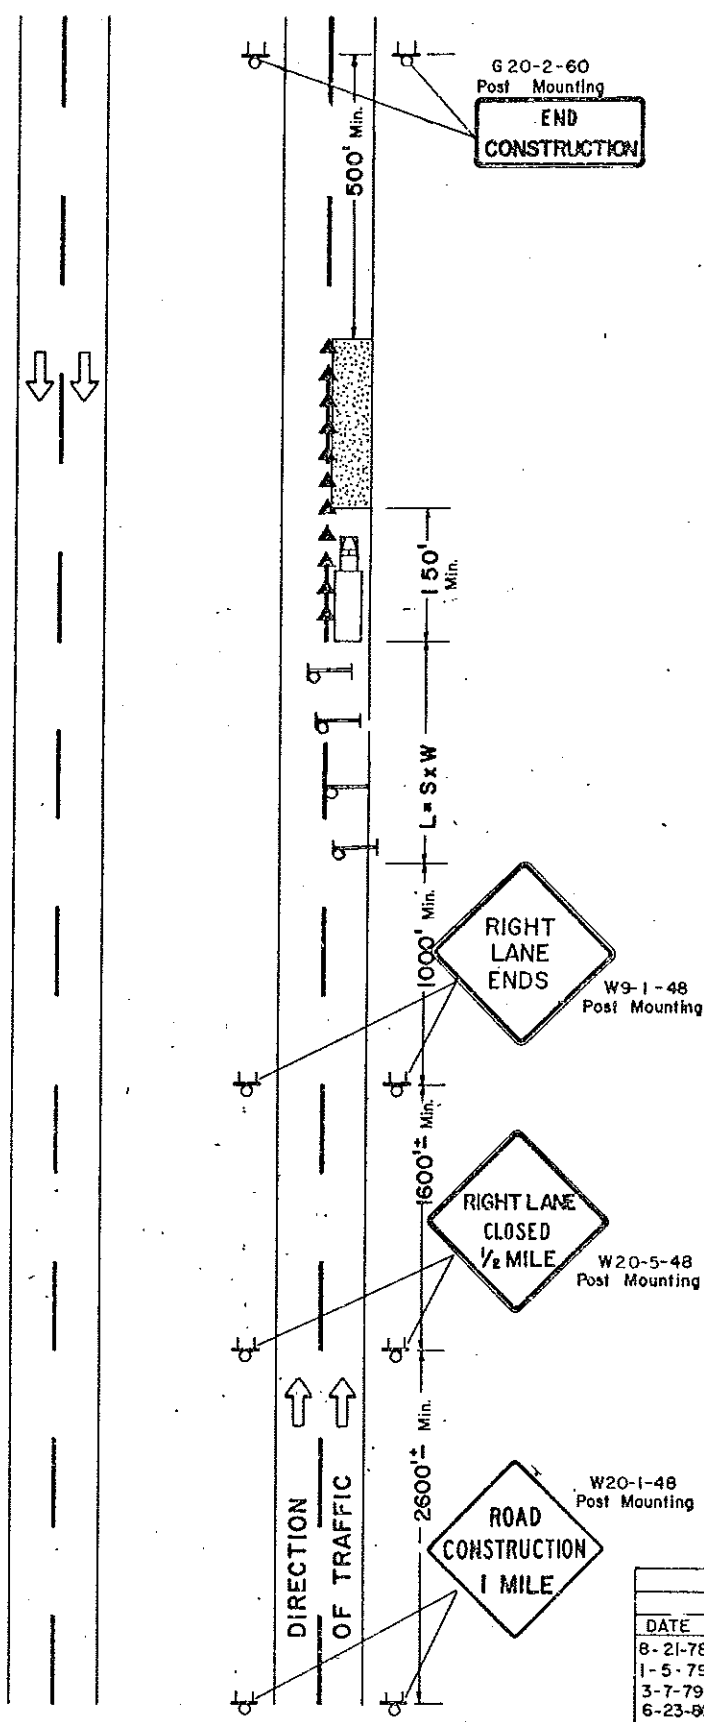

**NOTES:**

**FLAGS:** All advance warning signs shall have two orange warning flags 24" square mounted perpendicular to the edges of the diamond sign and at such a distance above the edges so that when flag is hung limp it will not touch the sign.

**Lighting -** The flashers and steady burn lights shall be maintained as shown. If the danger exists at night and the work area is close to the traffic lane, the edge of the traffic lane on the work area side shall be illuminated by steady burn lights spaced at 100 ft. centers. The flashers shall be placed at the beginning and middle of the hazard. Where traffic is tapered into another lane, the flashers shall be placed at the beginning and middle of the taper, and the remaining tapering devices shall be illuminated by steady burn lights. The steady beam light shall be spaced at the dimension S used in calculating length of tapes. Flashers shall be placed above the barricade bars and above all warning signs unless barricades and signs have encapsulated lens reflective sheeted faces.

**Mounting -** Barricade shown to be placed on roadway shall be on a movable Assembly. Sign to be mounted on barricades shall be mounted with the sign bottom on the top of the top barricade bar. Intermediate Sign shall be on a movable assembly. Sign show to be placed on roadway shall be placed on movable assemblies.

Where advance warning sign placed as shown interferes with permanent signs, The warning sign location shall be determined by the Engineer for best results. Message shall be varied as required.

**Note:**

- L = Minimum Length of Taper
- S = Numerical value of Speed, limit or 85 percent speed
- W = Width of offset
- L = S \* W for freeways, expressways, and all other roads with speeds of 45 mph or greater.
- L = WS<sup>2</sup>/60 for urban, residential, and other streets with speeds of 40 mph or less.


**TYPE P**

4 Lane Divided Roadway where half of roadway is closed. Longer than one day or outside of major work area.

7-15-78	
REVISIONS	
DATE	CHANGE
8-21-78	Note Change
1-5-79	General Revisions
3-7-79	Note Change
6-23-80	Sign Std. Numbers

NORTH DAKOTA  
STATE HIGHWAY DEPARTMENT  
Approved: *[Signature]*  
Design Engineer



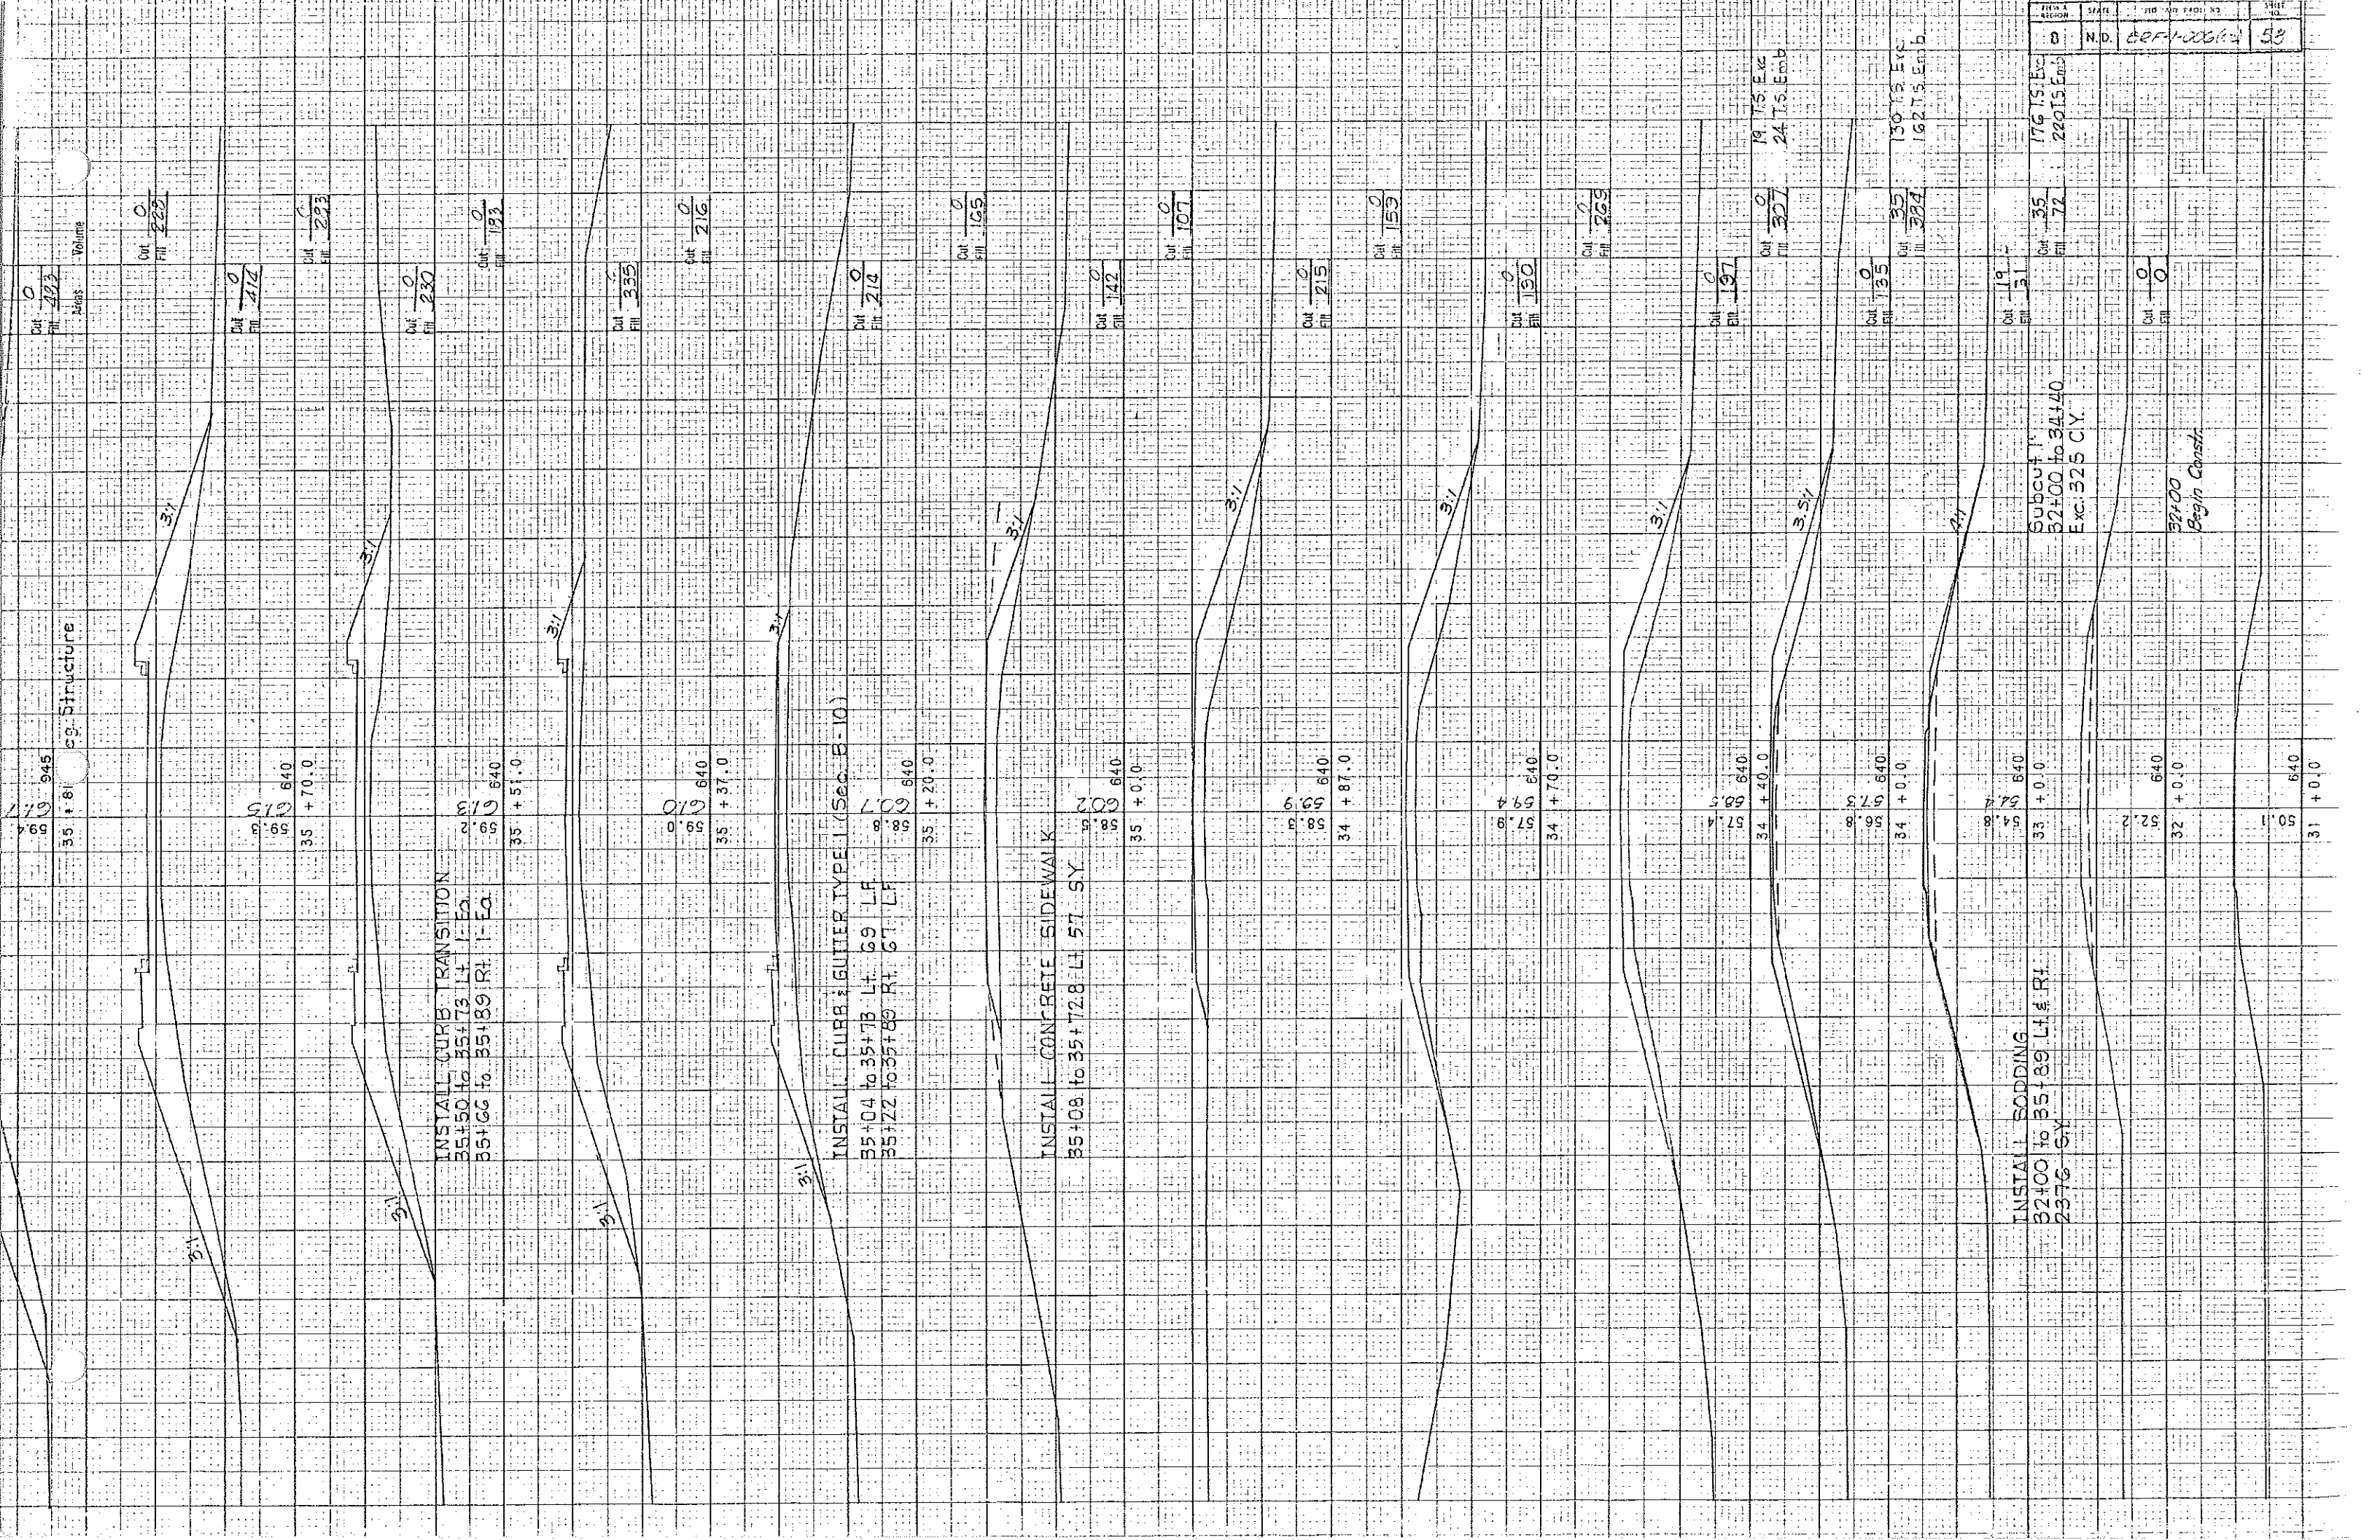

479 945  
 35+81 eg. Structure

Cut 0  
 Fill 403  
 Volume

Cut 0  
 Fill 229

Cut 0  
 Fill 412

Cut 0  
 Fill 223

Cut 0  
 Fill 230

Cut 0  
 Fill 192

Cut 0  
 Fill 335

Cut 0  
 Fill 216

Cut 0  
 Fill 214

Cut 0  
 Fill 125

Cut 0  
 Fill 142

Cut 0  
 Fill 107

Cut 0  
 Fill 159

Cut 0  
 Fill 215

Cut 0  
 Fill 130

Cut 0  
 Fill 269

Cut 0  
 Fill 197

Cut 0  
 Fill 327

Cut 0  
 Fill 135

Cut 19  
 Fill 31

Cut 35  
 Fill 72

Cut 0  
 Fill 0

Cut 19  
 Fill 31

Cut 35  
 Fill 72

Cut 0  
 Fill 0

INSTALL CURB & GUTTER TYPE I (Sec B-10)  
 35+04 to 35+73 Lt. 29 LF  
 35+22 to 35+89 Rt. 67 LF

INSTALL CONCRETE SIDEWALK  
 35+08 to 35+72 Lt. 57 SY

INSTALL SODDING  
 32+00 to 35+89 Lt. & Rt.  
 2376 SY

Subcut 1'  
 32+00 to 34+40  
 Exc: 325 CY

32+00  
 Begin Constr.

35+00

34+00

33+00

32+00

31+00

30+00

29+00

28+00

27+00

26+00

25+00


24+00

23+00


22+00

21+00

20+00

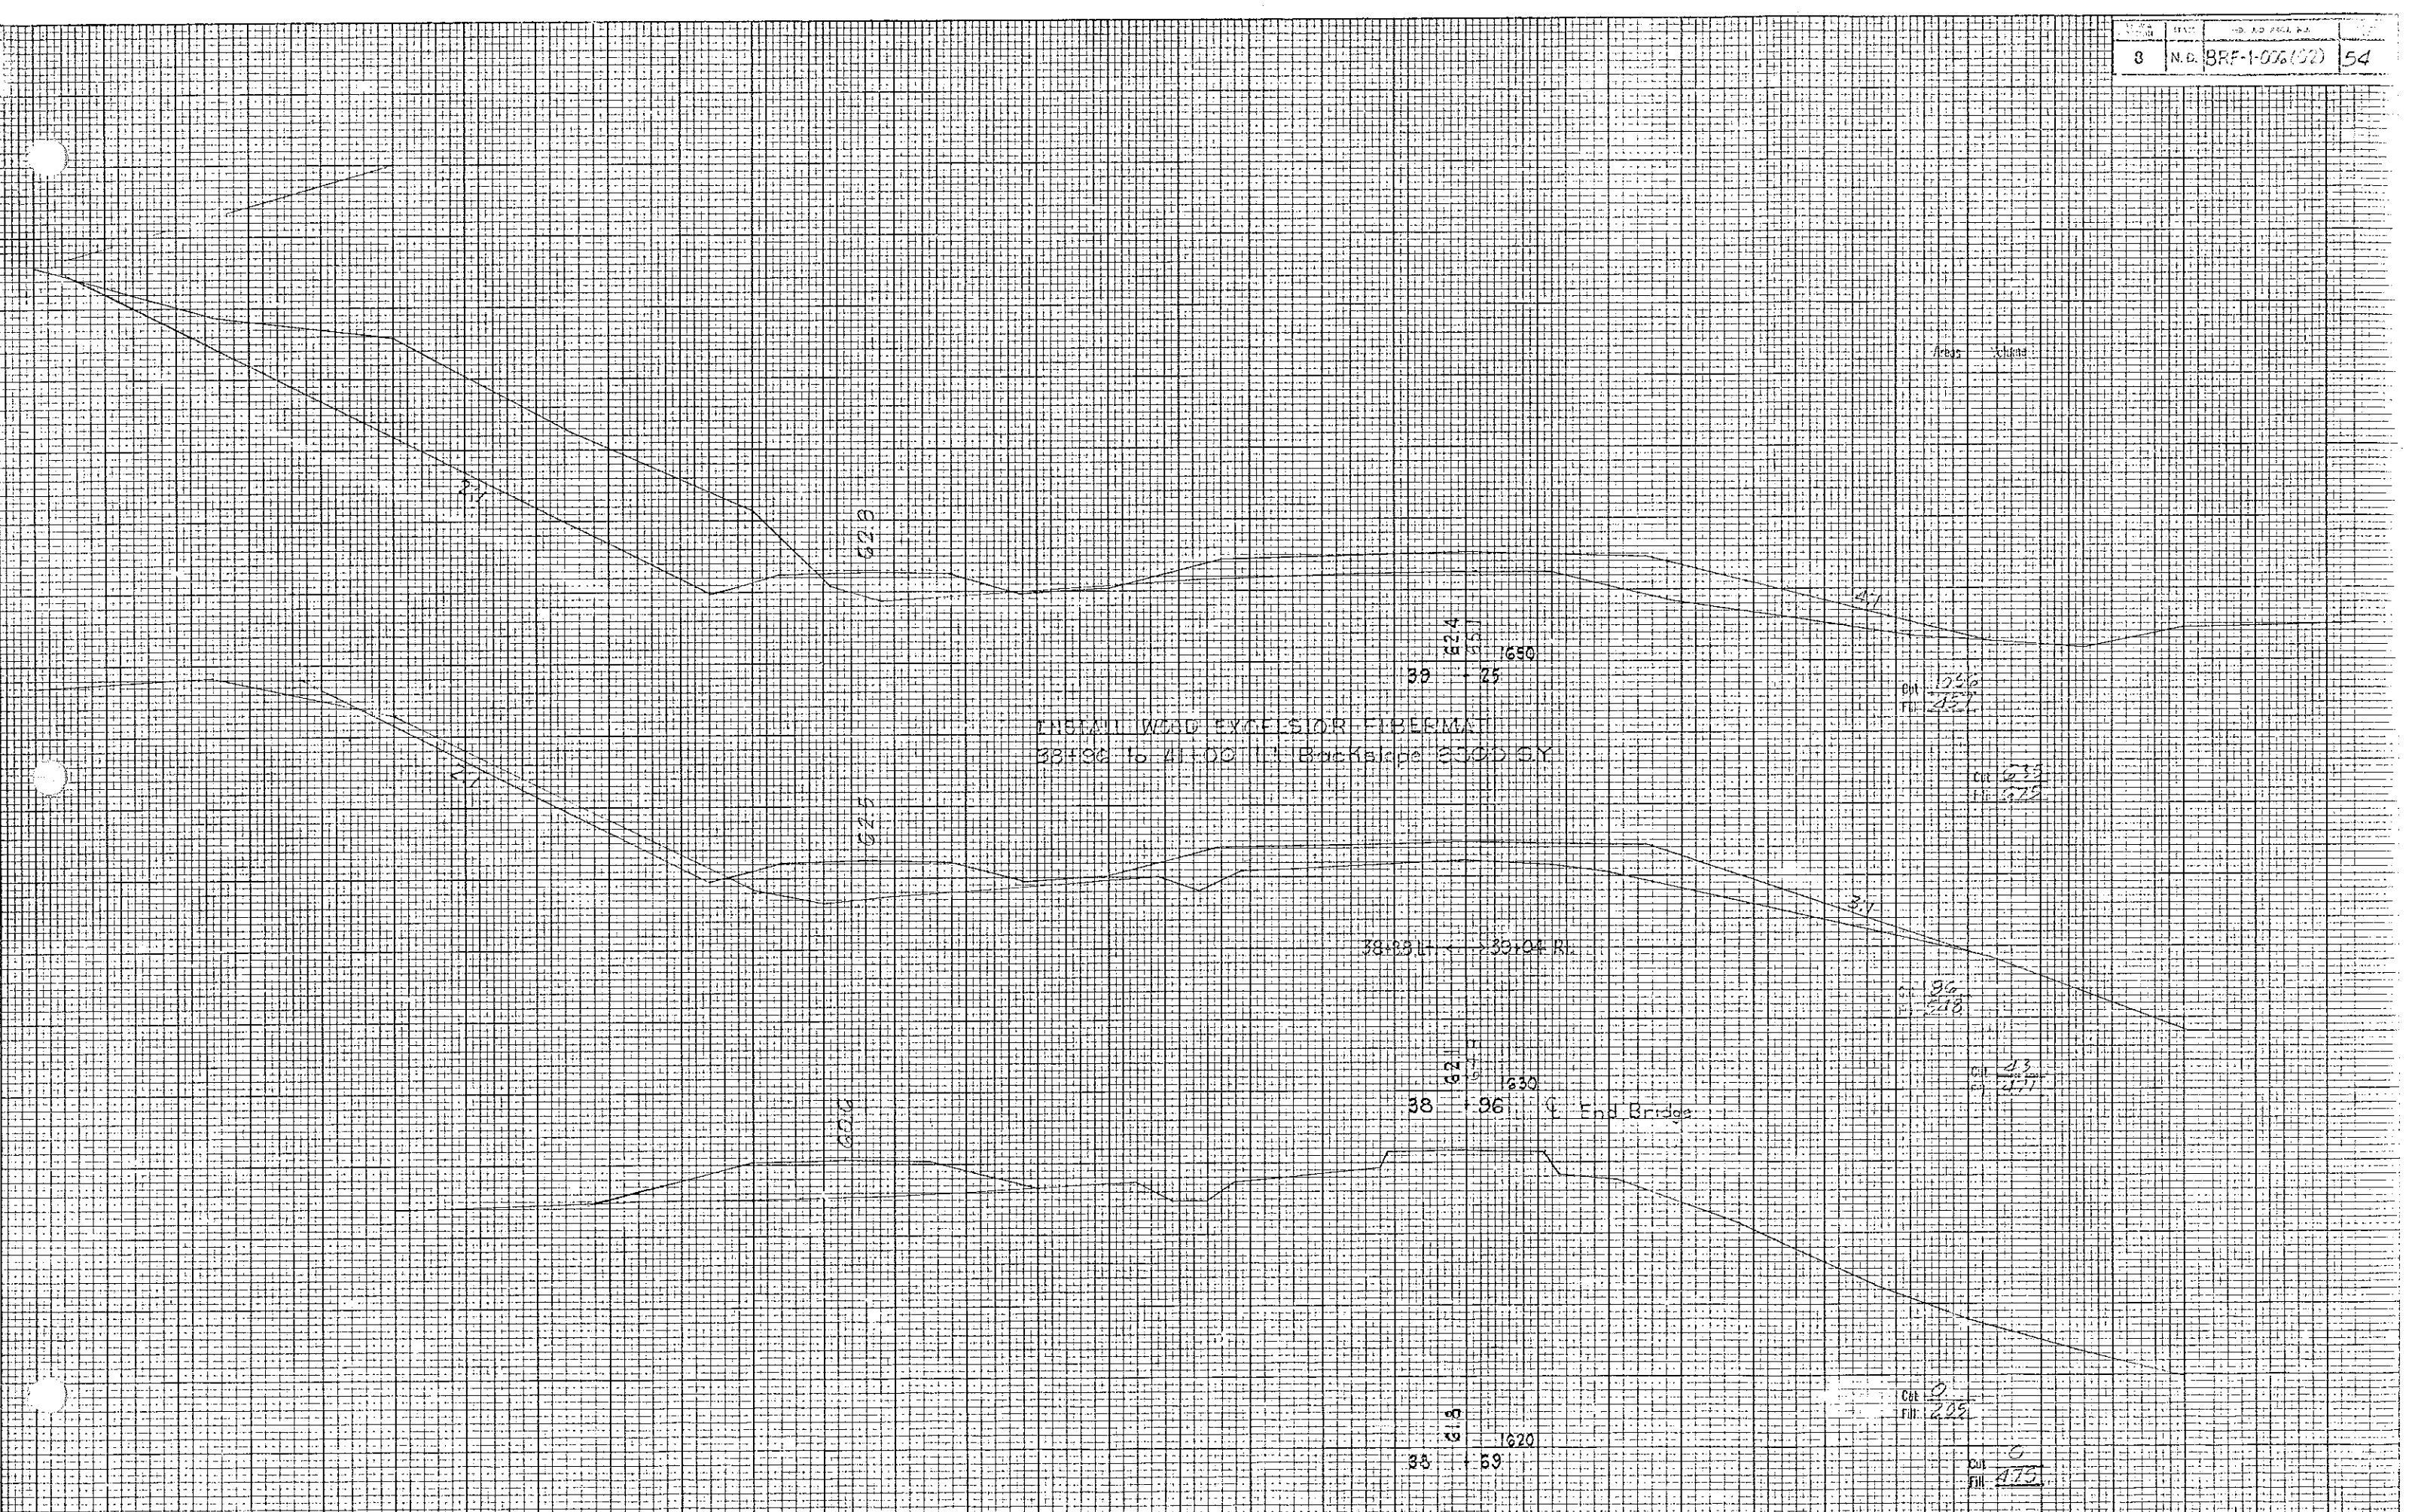




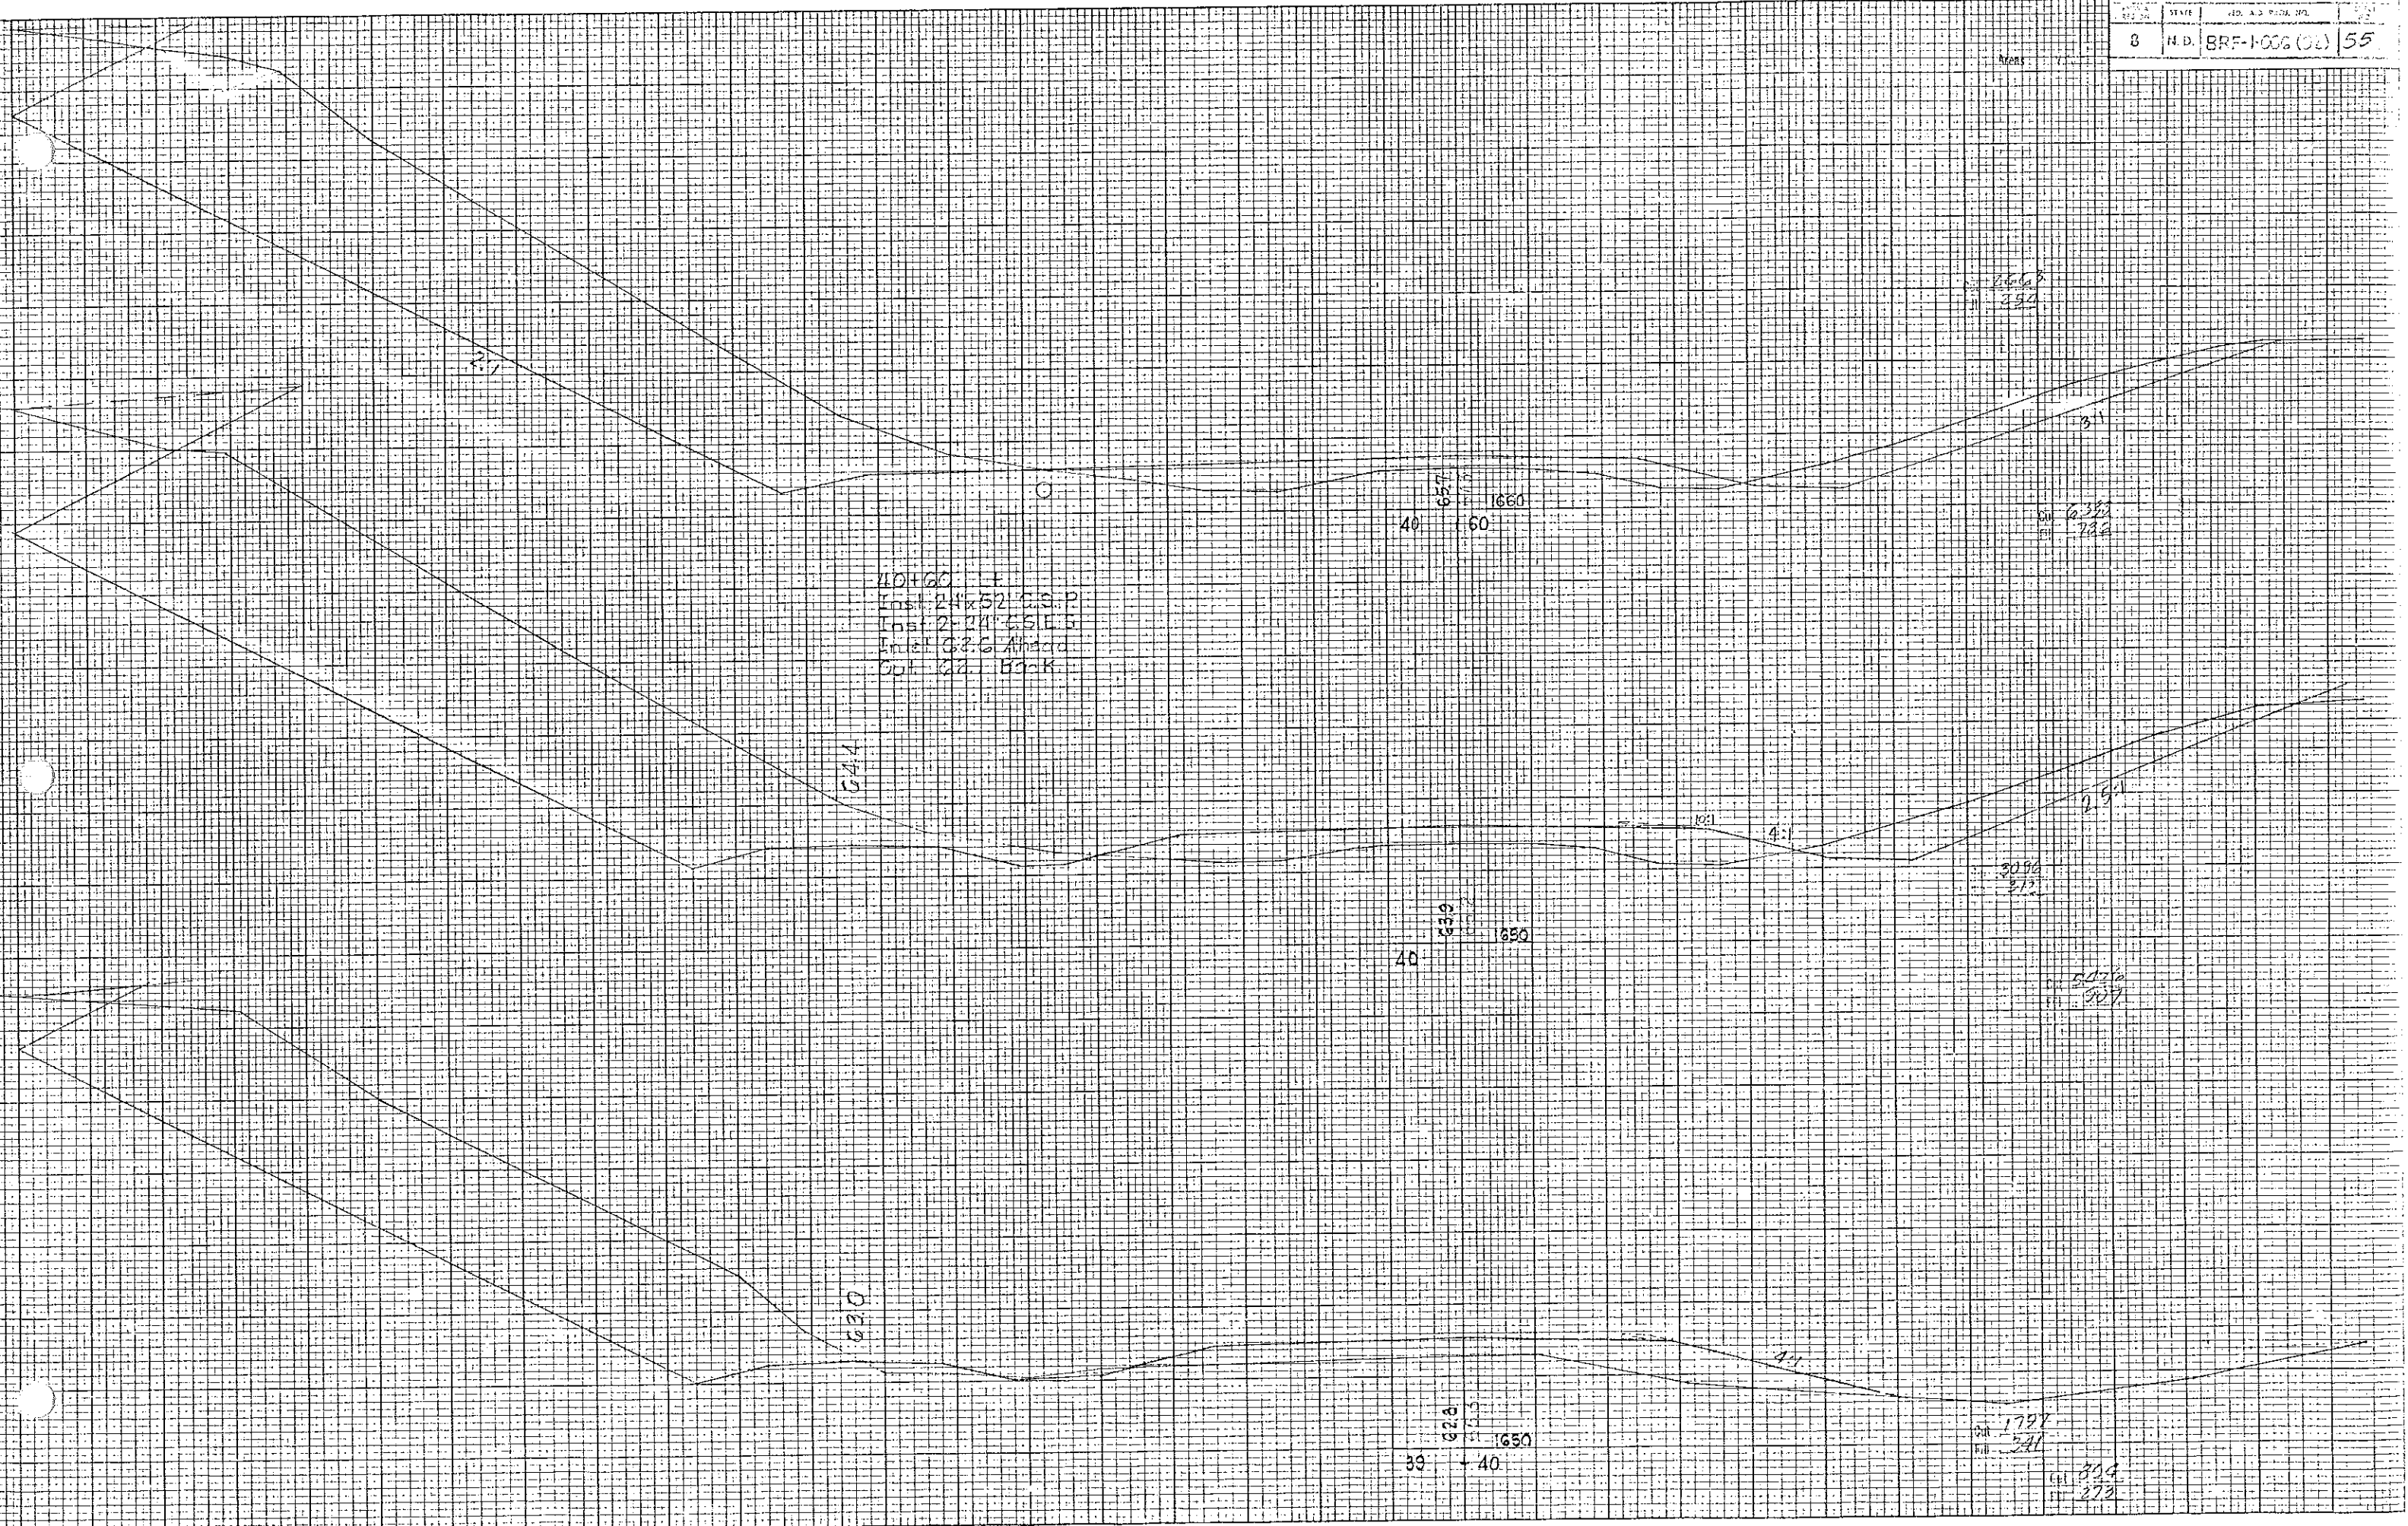



SURVEY NO. \_\_\_\_\_  
 PROJECT NO. \_\_\_\_\_  
 NOTE BOOK NO. \_\_\_\_\_  
 TEMPLATE AREA CHECKED \_\_\_\_\_  
 AREA CHECKED \_\_\_\_\_


SURVEY NO. \_\_\_\_\_  
 PROJECT NO. \_\_\_\_\_  
 NOTE BOOK NO. \_\_\_\_\_  
 TEMPLATE AREA CHECKED \_\_\_\_\_  
 AREA CHECKED \_\_\_\_\_

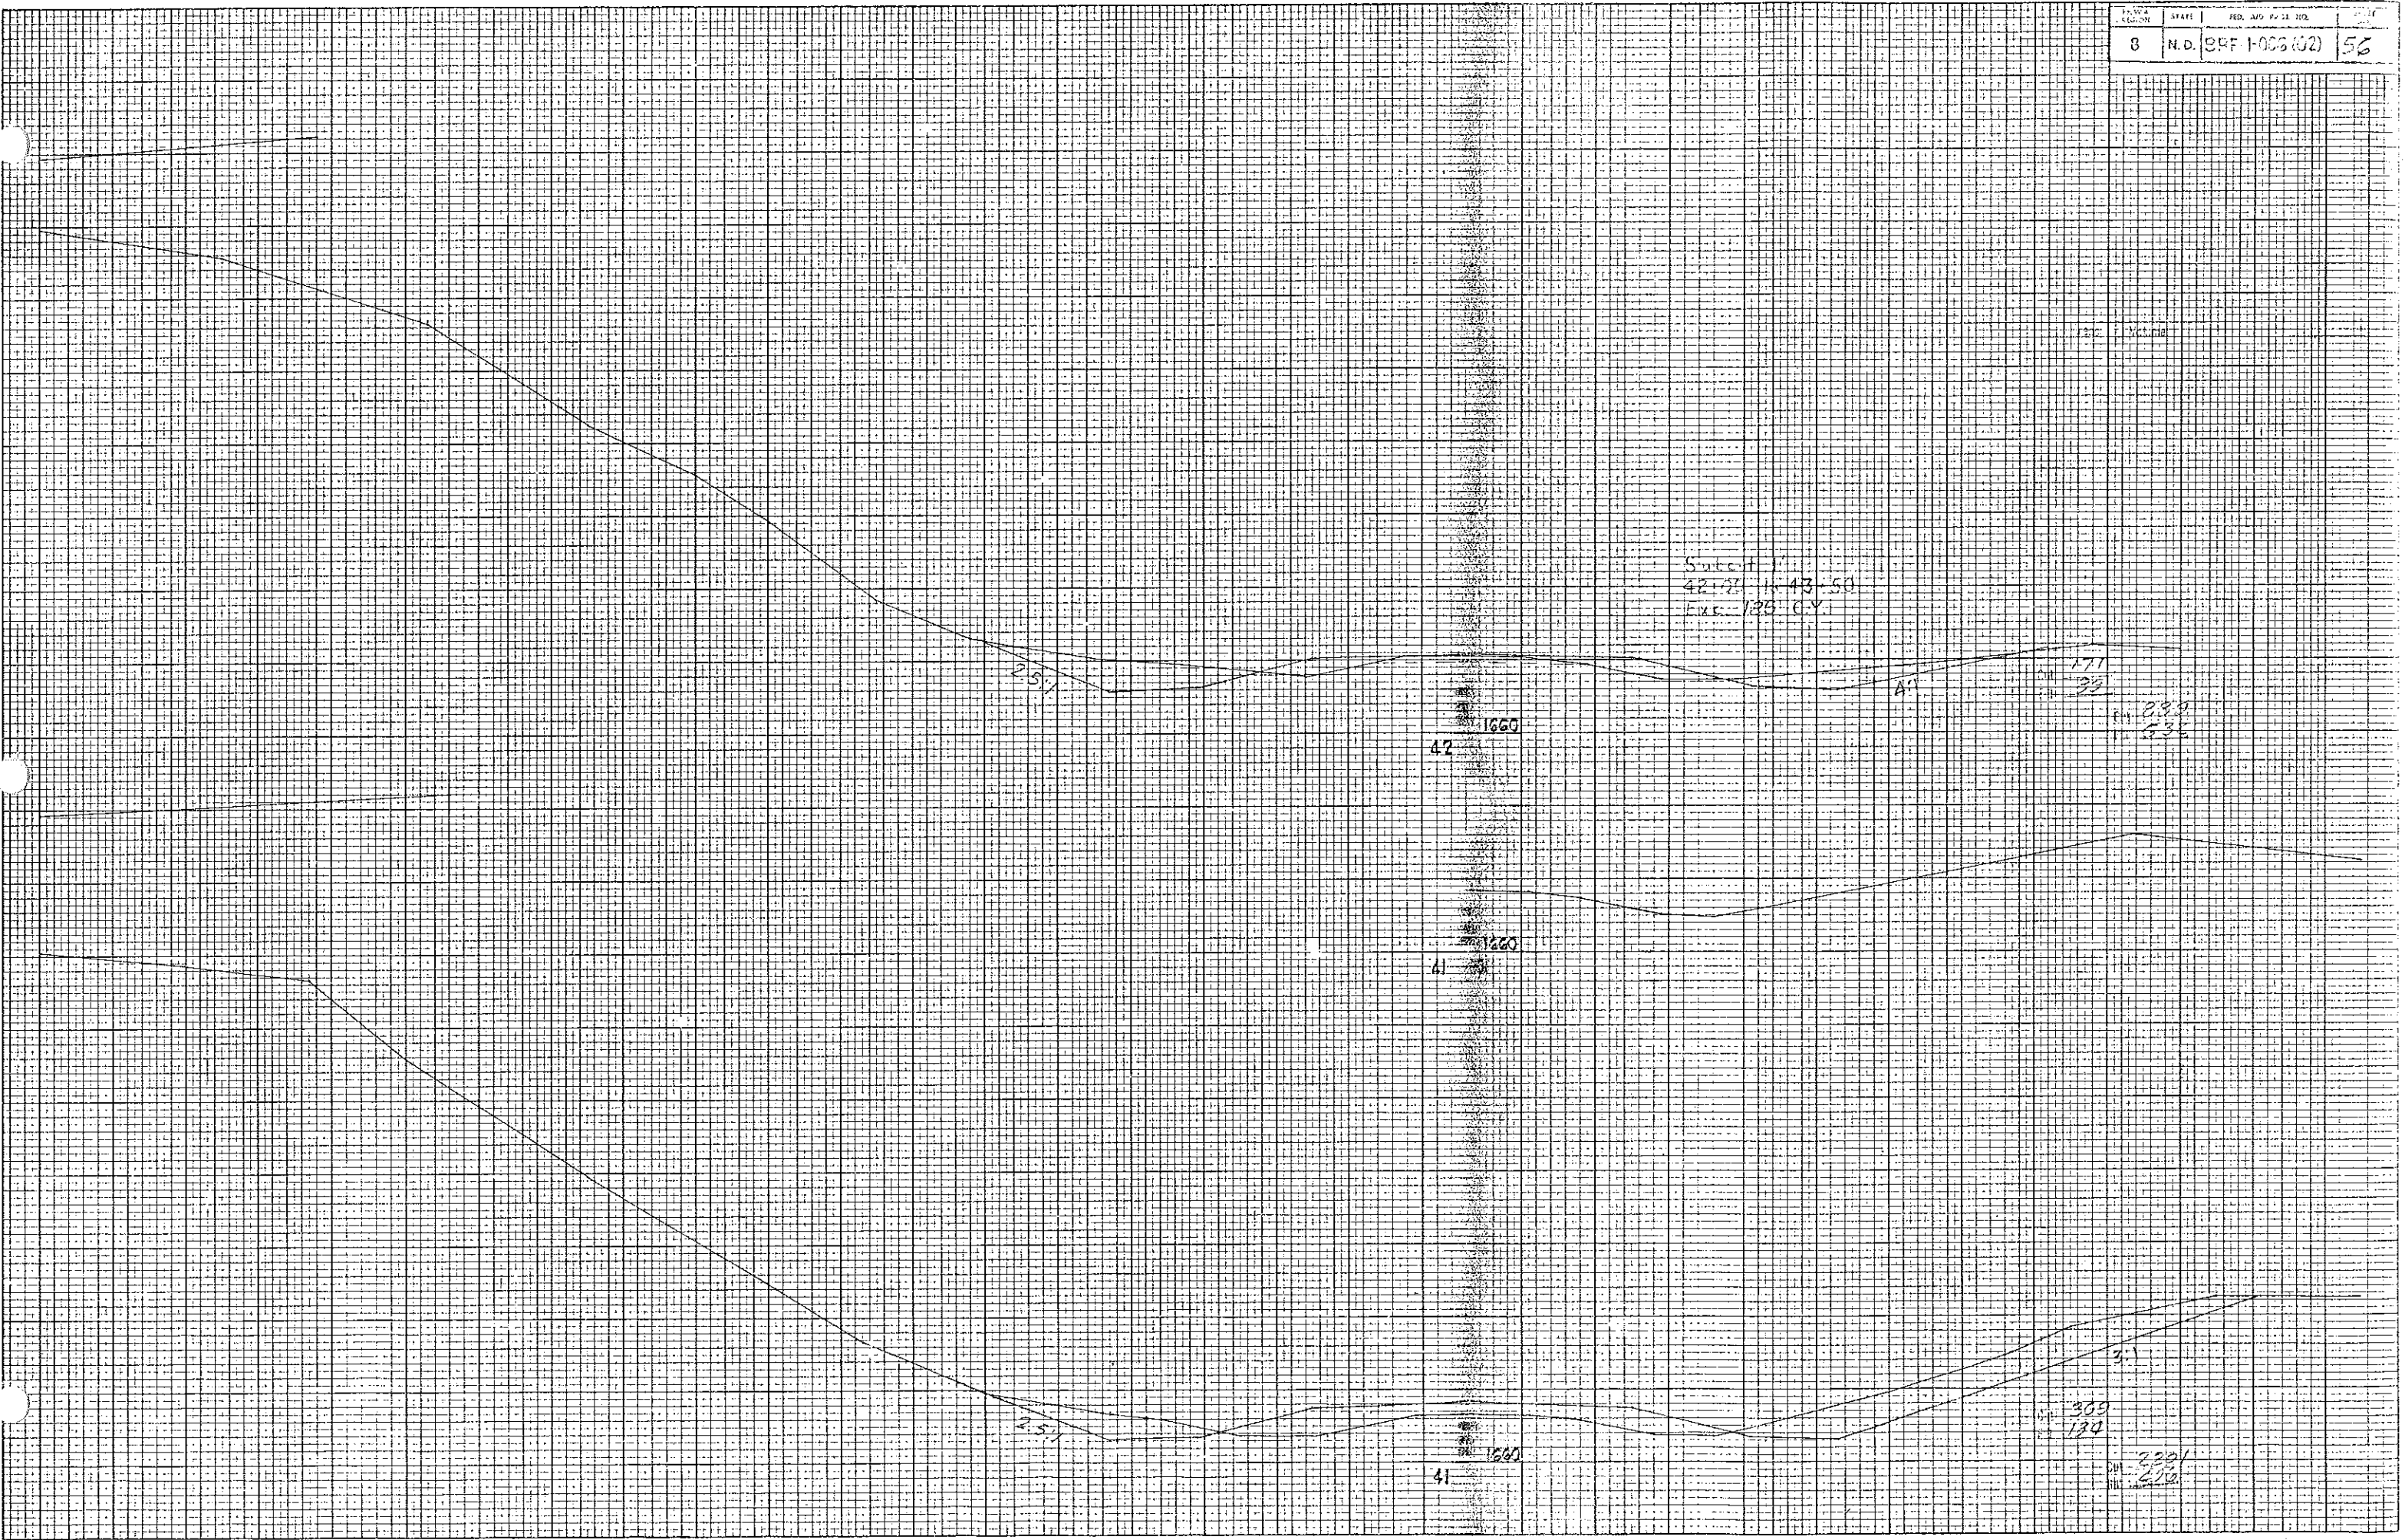



SURVEY SHOWN TO  
NOTE BOOK PLOTTED  
NO. TEMPLATE  
AREAS CHECKED

SURVEY SHOWN TO  
NOTE BOOK PLOTTED  
NO. TEMPLATE  
AREAS CHECKED

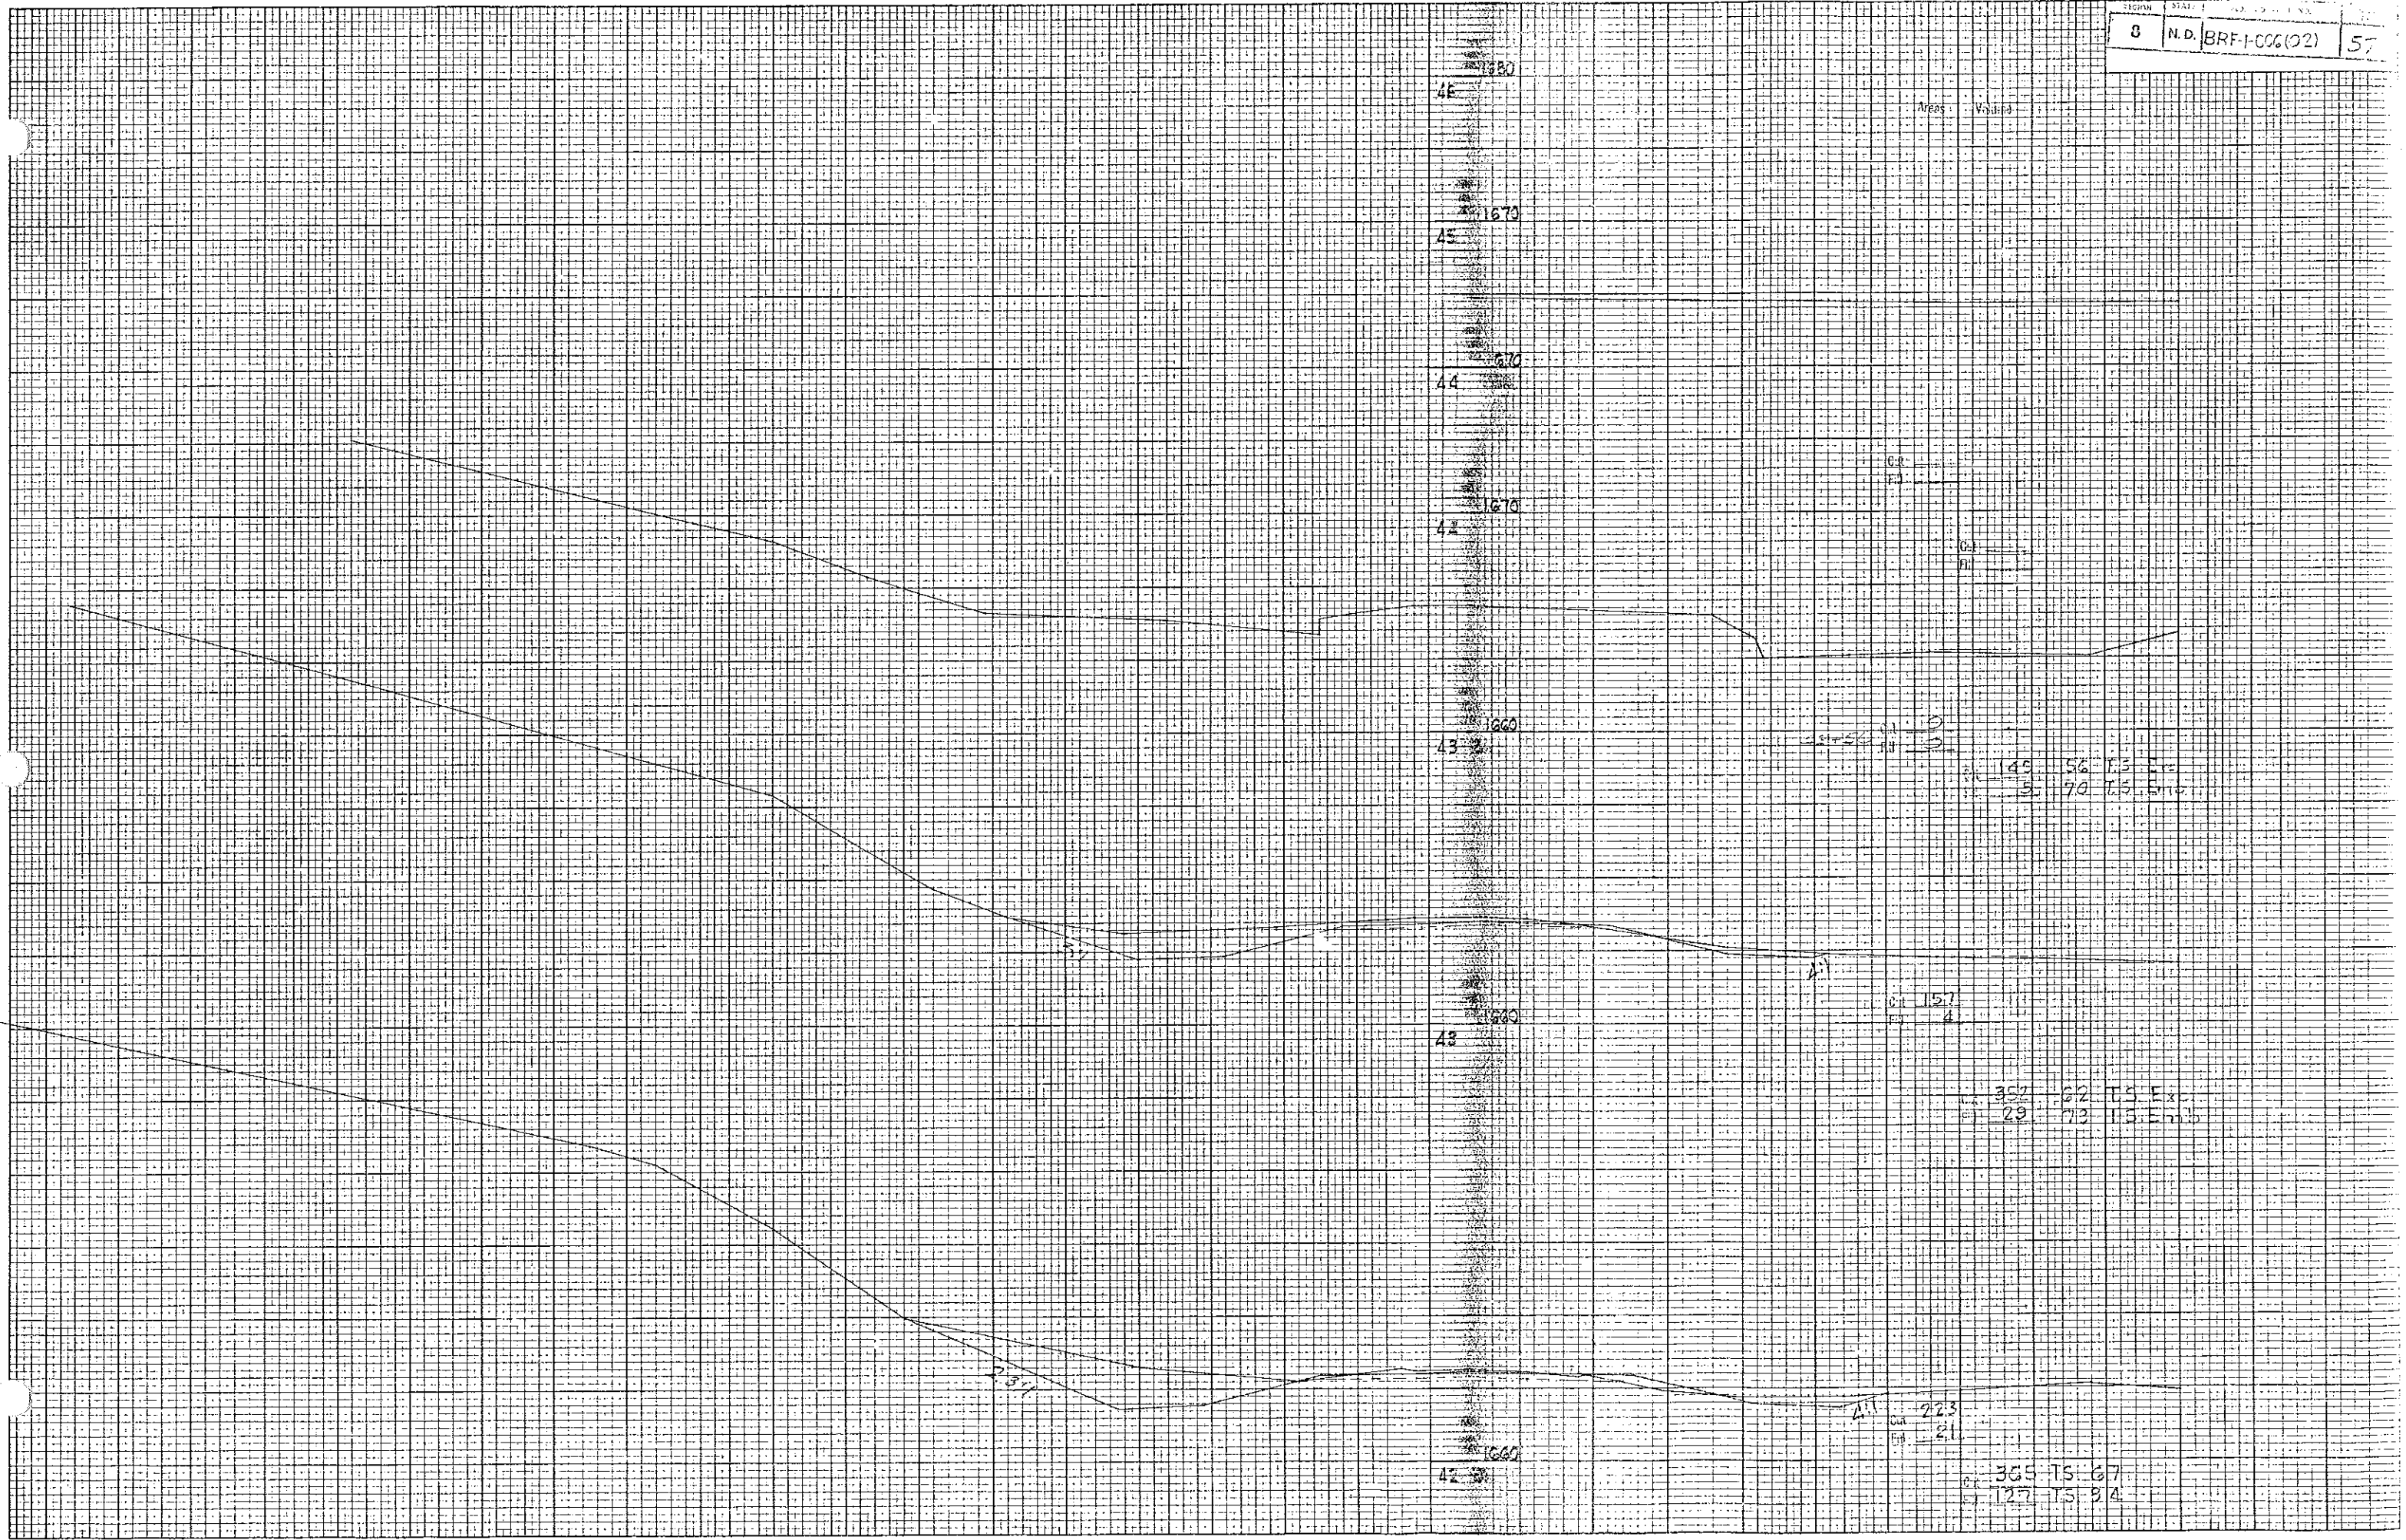

FHWA REGION	STATE	FED. AID PROJ. NO.	SHEET NO.
8	N.D.	BRF-1-006(02)066	

SIGN SUMMARY - PERFORATED TUBE

STATION	ASSEMBLY NUMBER	SIGN AREA		SIGN 1ST	SUPPORT 2ND	POST 3RD	LENGTHS 4TH	SIGN 1ST	SUPPORT 2ND	SLEEVE 3RD	LENGTH 4TH	ANCHOR LNG.	UNIT SIZE	NO	TOTAL SUPPORT WEIGHT	RESET SIGN		MAX. LNG. FOR SUP. SIZE
		FLAT TYPE 2	SHEET TYPE 3 OR 4													PAN.	SUP.	
40+60 LT	1 RS		5.18	12.1				2.19				4.0	2.19	1	55.13			12.1
42+23 LT	9 RS	5.00		12.0				2.19				4.0	2.19	1	54.91			12.5
42+40 RT	9 RS	5.00		12.0				2.19				4.0	2.19	1	54.91			12.5
SUBTOTAL NO.	1	10.00	5.18												164.95	0	0	
SUBTOTAL NO.	1	10.00	5.18												164.95	0	0	
TOTAL		10.00	5.18												164.95	0	0	

BASIS OF ESTIMATE  
Sign Support Lengths

The sign support lengths have been calculated using the following information:

Ultimate Pavement Depth . 12"

Inslopes

Lt. 3:1  
Rt. 3:1

Vertical Clearance

Signs viewed from mainline 60"  
Signs viewed from crossings 60"

Graded Roadway Widths


Mainline 50'  
Crossing roadways 50'

TRAFFIC CONTROL SYSTEM

SIGN SUMMARY


HWY. ND 6  
Heart Rr. Bridge-Mandan

FHWA REGION	STATE	FED. AID PROJ. NO.	SHEET NO.
8	N.D.	BRF-1-006(02)066	1

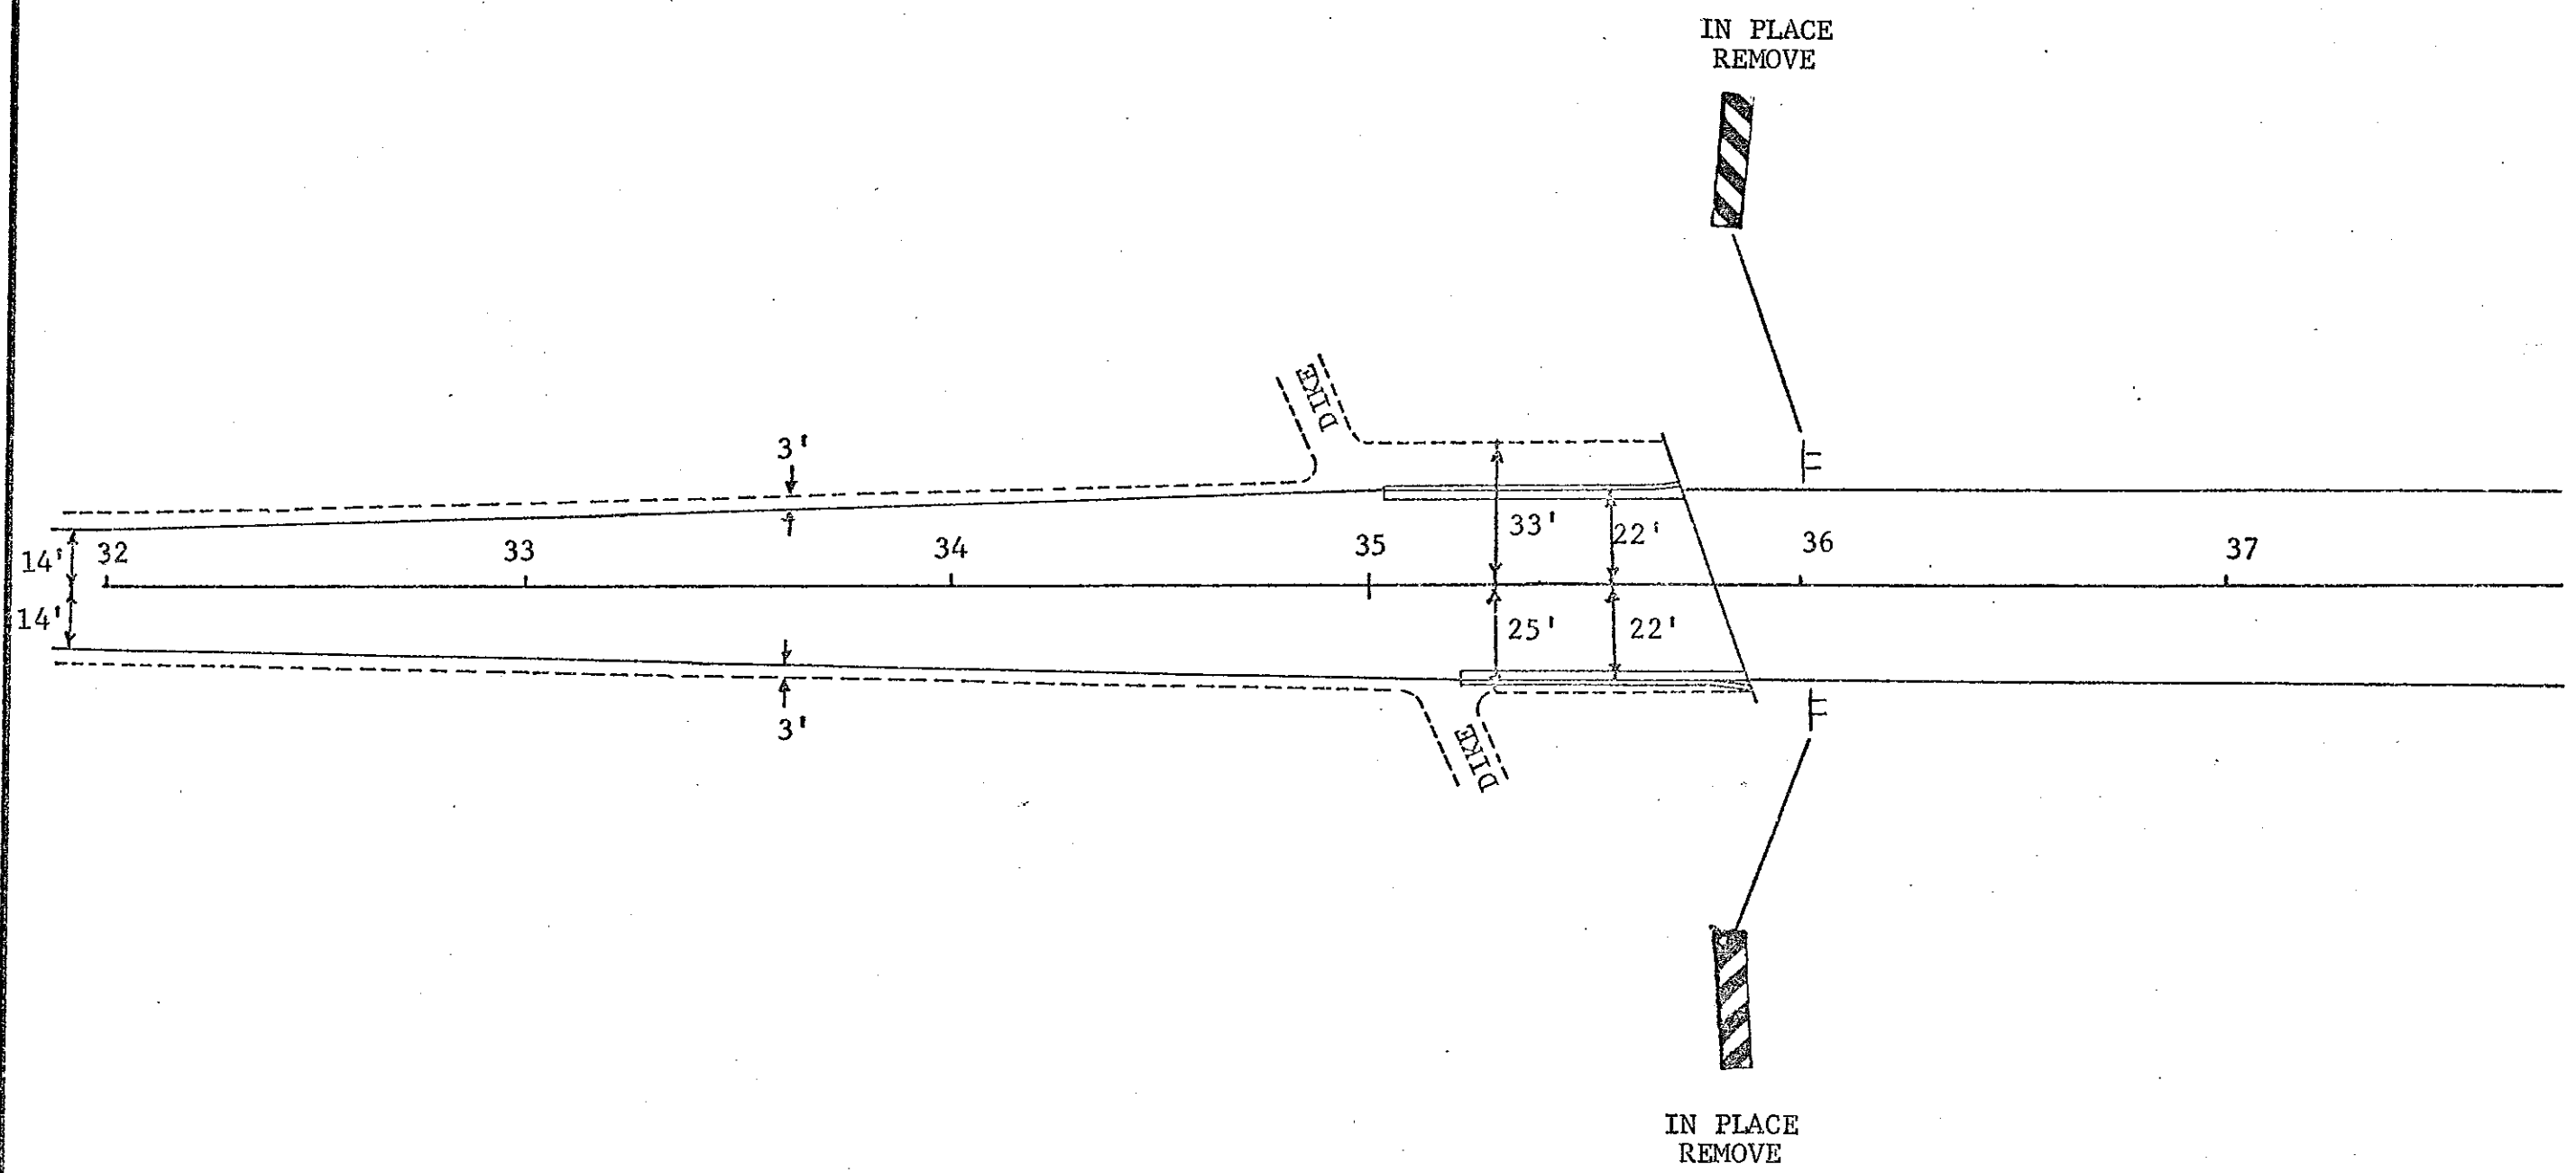

TRAFFIC CONTROL SYSTEM  
 SIGNING LAYOUT  
 HWY. ND 6  
 Heart Rr. Bridge-Mandan

FWA REGION	STATE	FED. AID PROJ. NO.	SHEET NO.
8	N.D.	BRF-1-006(02)066	

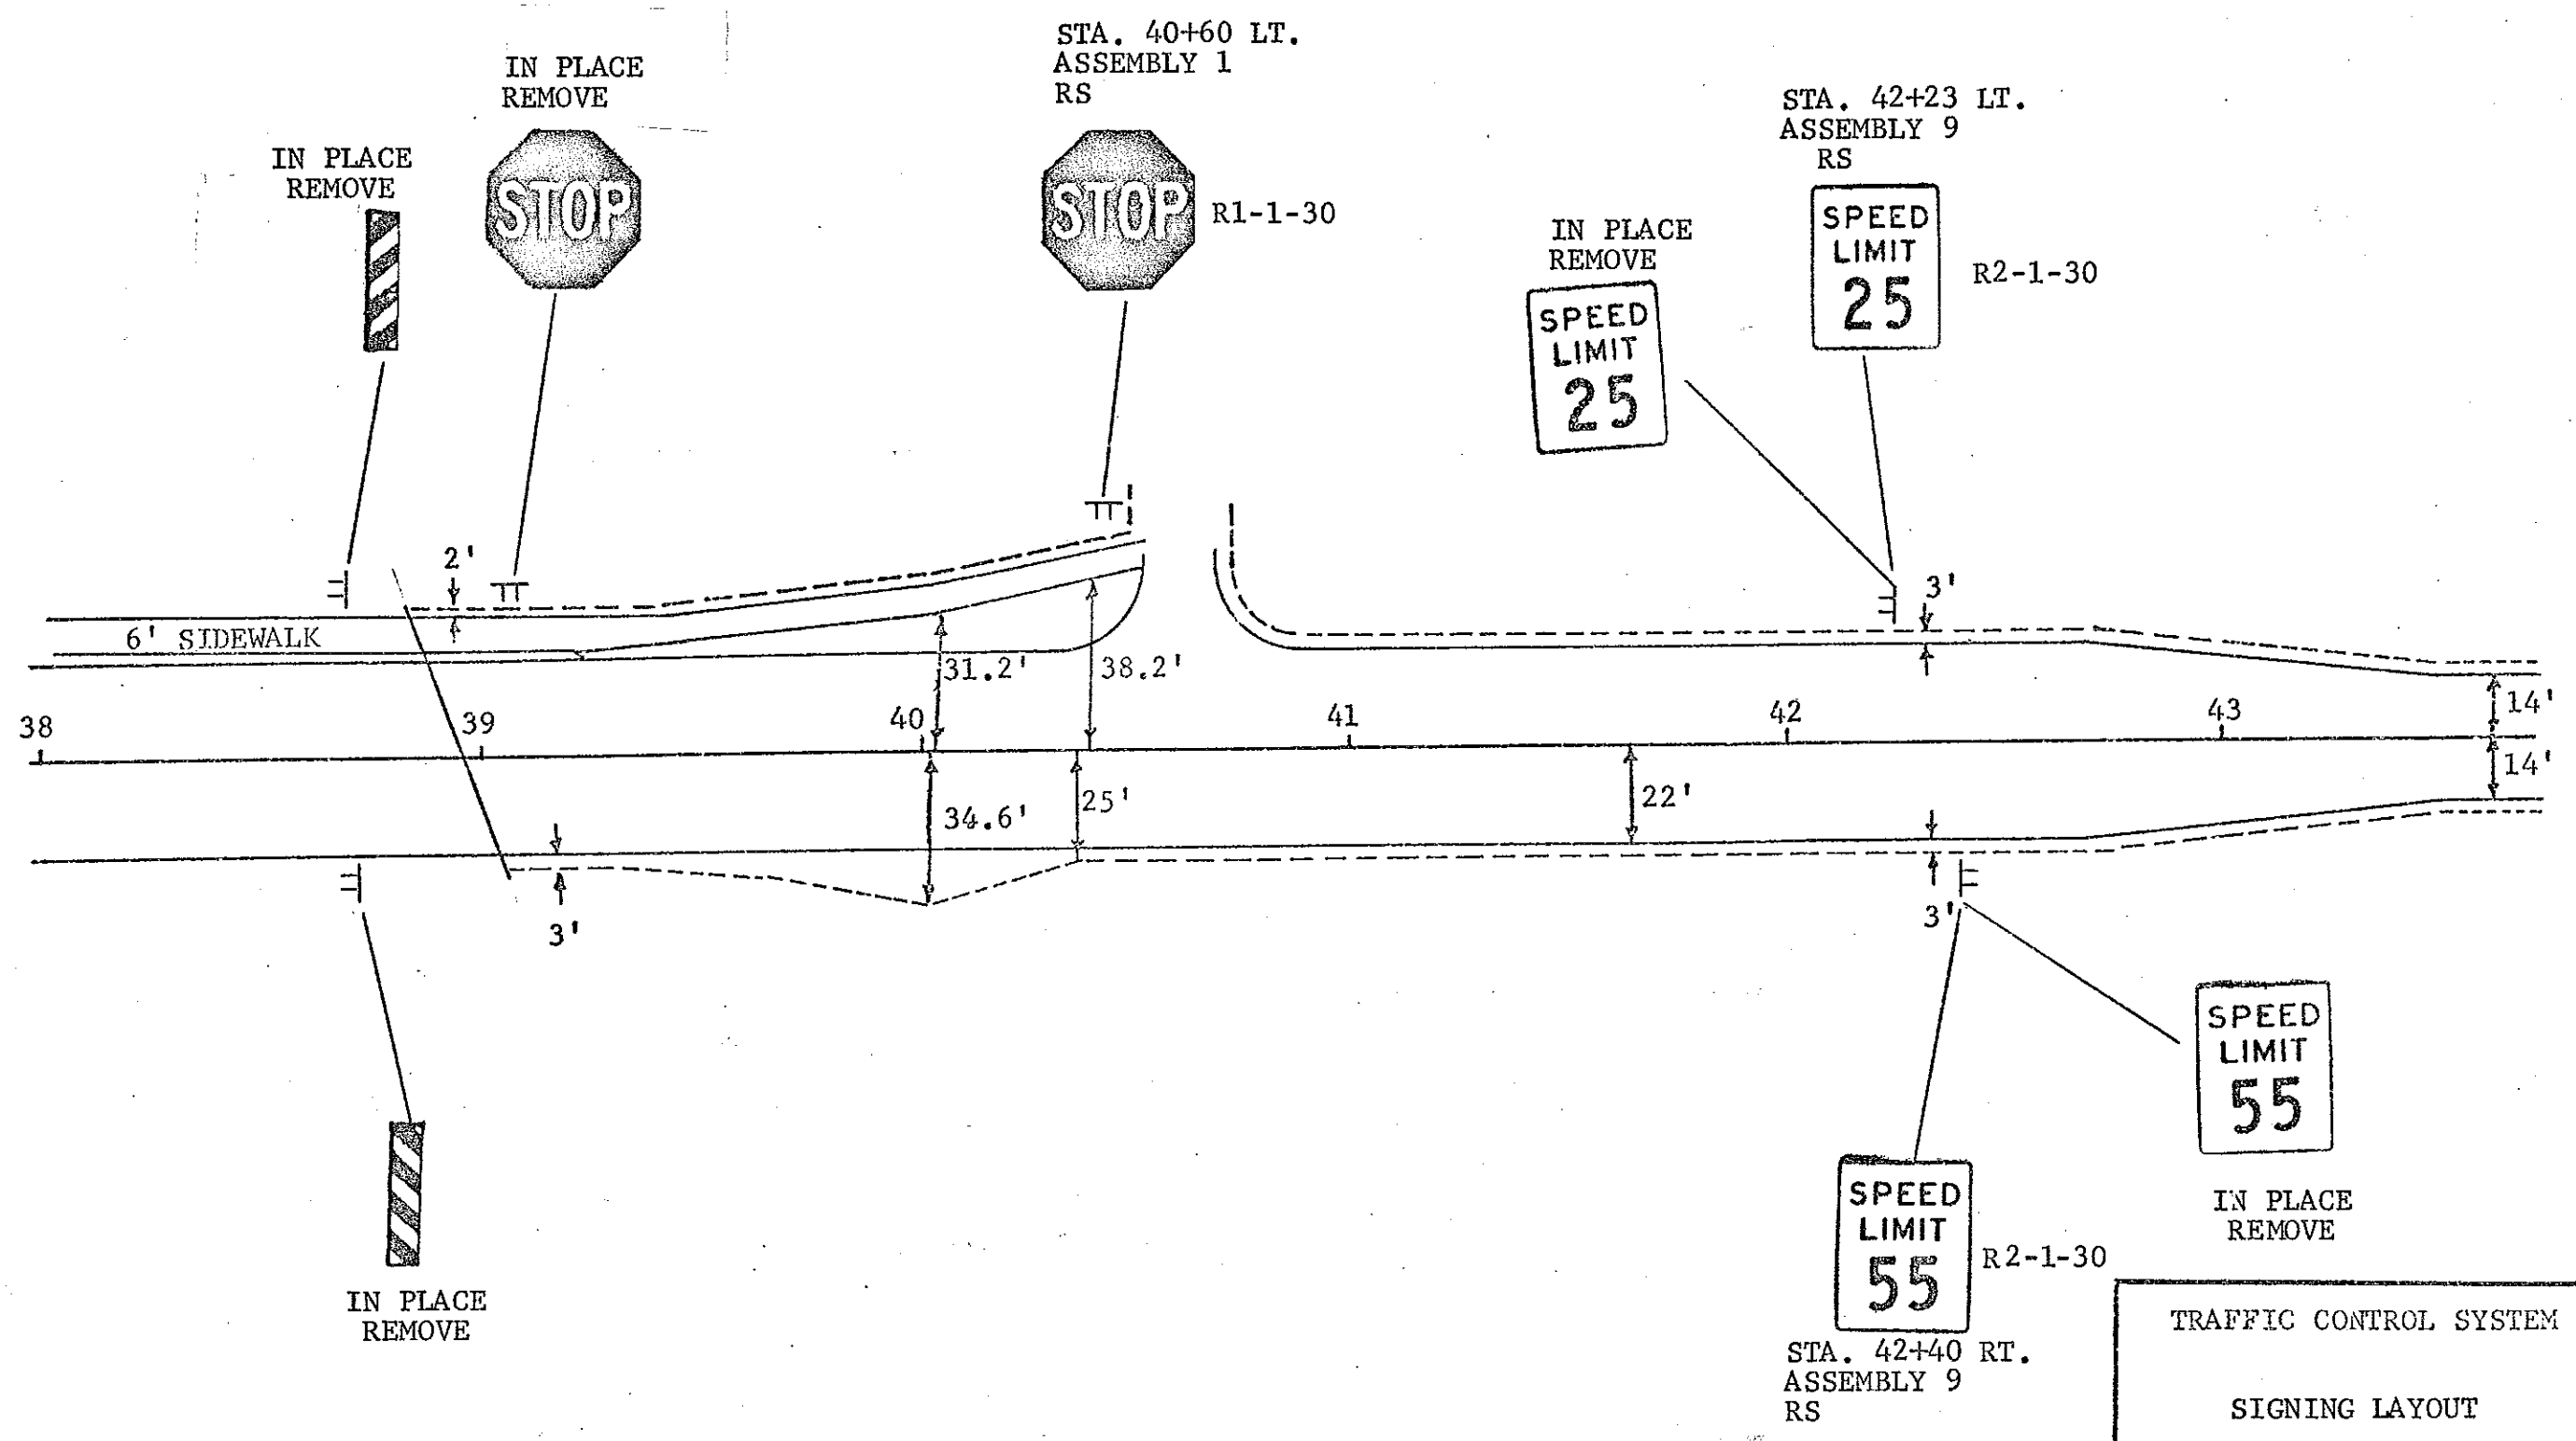

TRAFFIC CONTROL SYSTEM

SIGNING LAYOUT

Hwy. ND 6  
Heart Rr. Bridge-Mandan

STA. 40+60 LT.  
ASSEMBLY 1  
RS

STA. 42+23 LT.  
ASSEMBLY 9  
RS

STA. 42+40 RT.  
ASSEMBLY 9  
RS

# ASSEMBLY DETAILS

FHWA REGION	STATE	FED. AID PROJ. NO.	SHEET NO.
B	N.D.	BRF-1-006(02)066	


D754-23

**MINIMUM HORIZONTAL CLEARANCE**

THE 16' CLEARANCE FROM THE EDGE OF THE DRIVING LANE TO THE EDGE OF THE SIGN SHALL BE FOR ALL ROADWAYS WITHOUT CURBS. ALL CURBED ROADWAYS SHALL HAVE 3' HORIZONTAL CLEARANCE FROM THE FACE OF THE CURB TO THE EDGE OF THE SIGN UNLESS NOTED OTHERWISE ON THE PLANS. ALL BIKE ROUTE SHALL HAVE A 3' MINIMUM HORIZONTAL CLEARANCE FROM THE EDGE OF THE BIKE ROUTE TO THE EDGE OF THE SIGN.



**MINIMUM VERTICAL CLEARANCE**

5' RURAL ROADWAYS  
6' ON RURAL OR URBAN EXPRESSWAYS

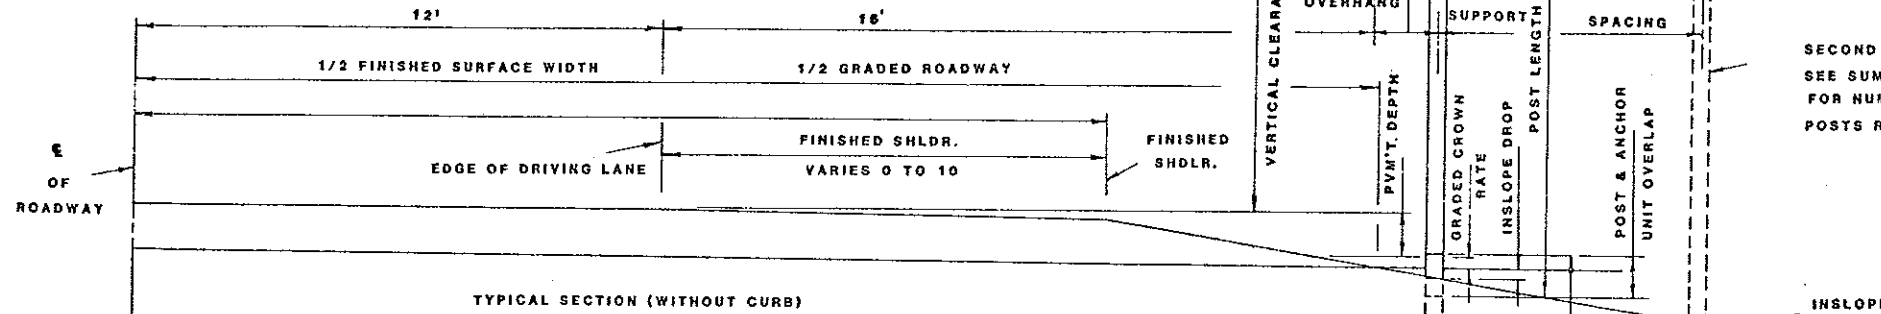

**MINIMUM VERTICAL CLEARANCE**

8' URBAN EXPRESSWAYS  
7' IN RESIDENTIAL AND BUSINESS DISTRICTS WHERE PARKING WILL OCCUR  
4' MIN. FOR BIKE ROUTES

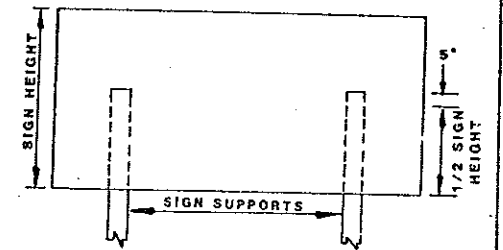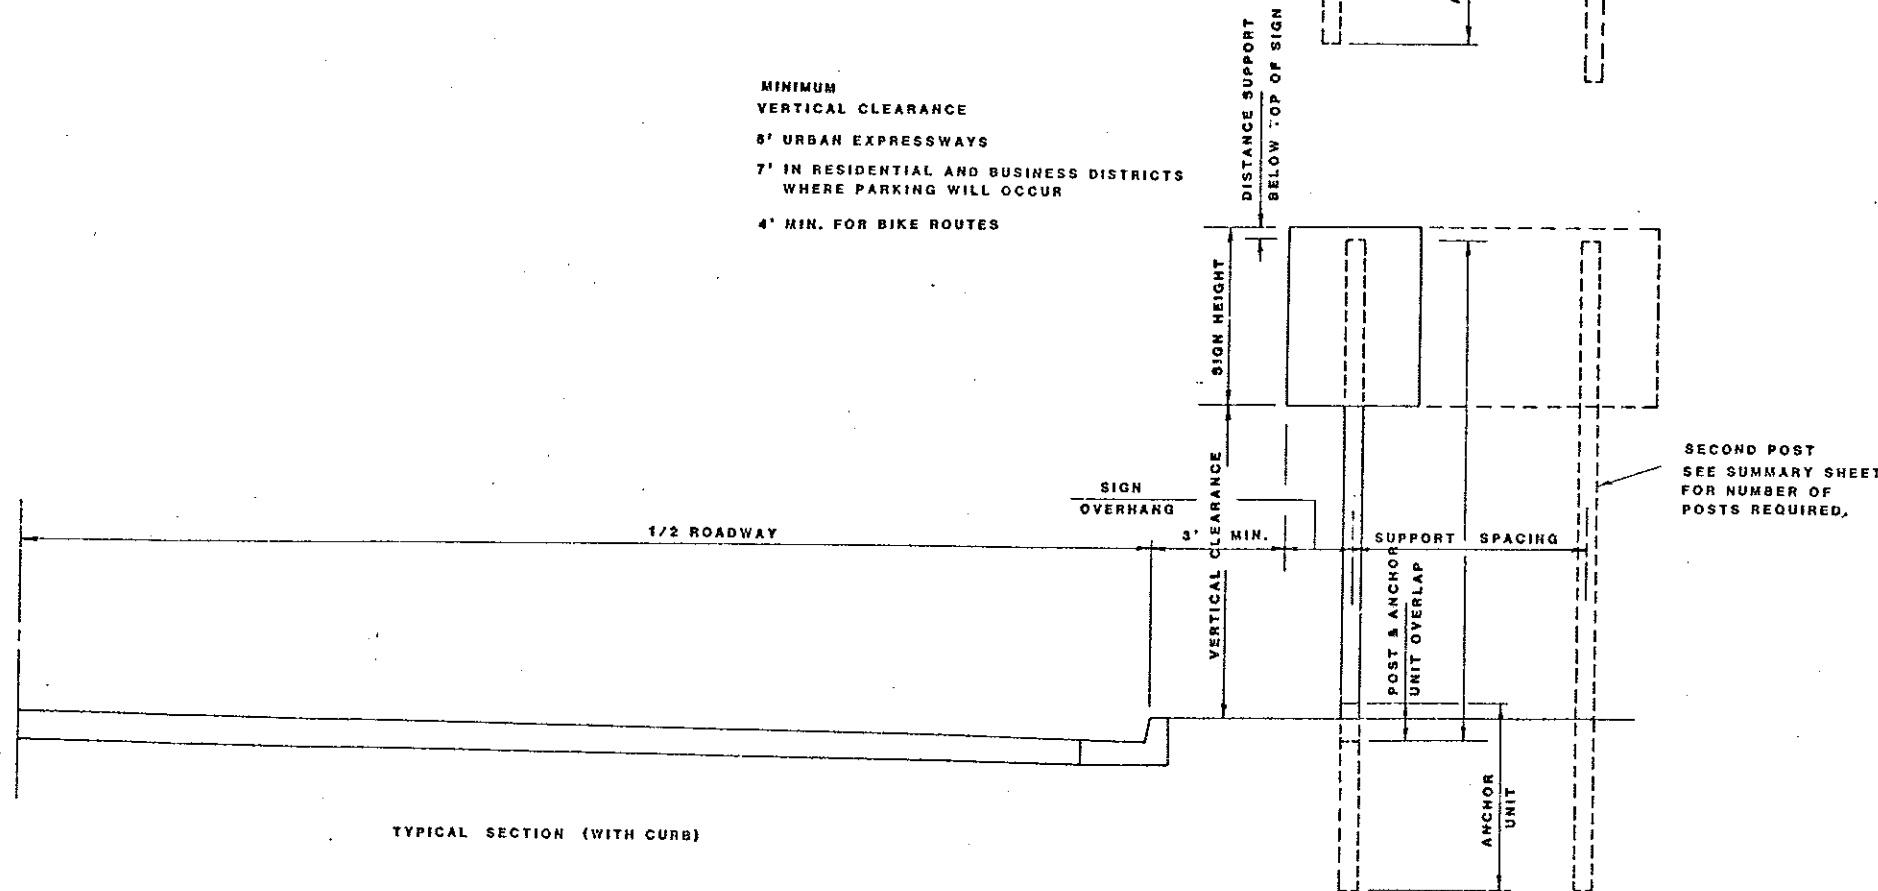

HINGE LOCATION DETAIL FOR 2 OR MORE POSTS ASSEMBLIES - WITH SLIP BASES.

SECOND POST SEE SUMMARY SHEET FOR NUMBER OF POSTS REQUIRED.


SECOND POST SEE SUMMARY SHEET FOR NUMBER OF POSTS REQUIRED.

**NOTE**

PAVEMENT DEPTH-THE PAVEMENT DEPTH USED TO DEVELOP SUMMARY SHEETS SHOULD BE THE ULTIMATE PAVEMENT DEPTH. SEE PLANS FOR SIGN NUMBERS AND ASSEMBLY NUMBERS. SIGN PUNCHING AND STRINGERS SHALL BE AS SHOWN ON STANDARDS. HORIZONTAL CLEARANCE: THE POST LENGTHS HAVE BEEN COMPUTED USING A HORIZONTAL CLEARANCE OF 16 FEET BETWEEN THE EDGE OF THE DRIVING LANE AND THE EDGE OF THE SIGN. FOR AN ULTIMATE SHOULDER WIDTH OF 10 FEET, THE DISTRICTS HAVE THE OPTION OF SETTING THE SIGNS OUT TO 18 FEET CLEARANCE. IF THE CLEARANCE IS TO BE INCREASED TO 18 FEET, THE NECESSARY ADJUSTMENT IN SUPPORT LENGTH SHALL BE MADE IN THE FIELD.

REVISIONS		NORTH DAKOTA STATE HIGHWAY DEPARTMENT
DATE	CHANGE	
		APPROVED: _____ Design Engineer

### MOUNTING DETAILS PERFORATED TUBE

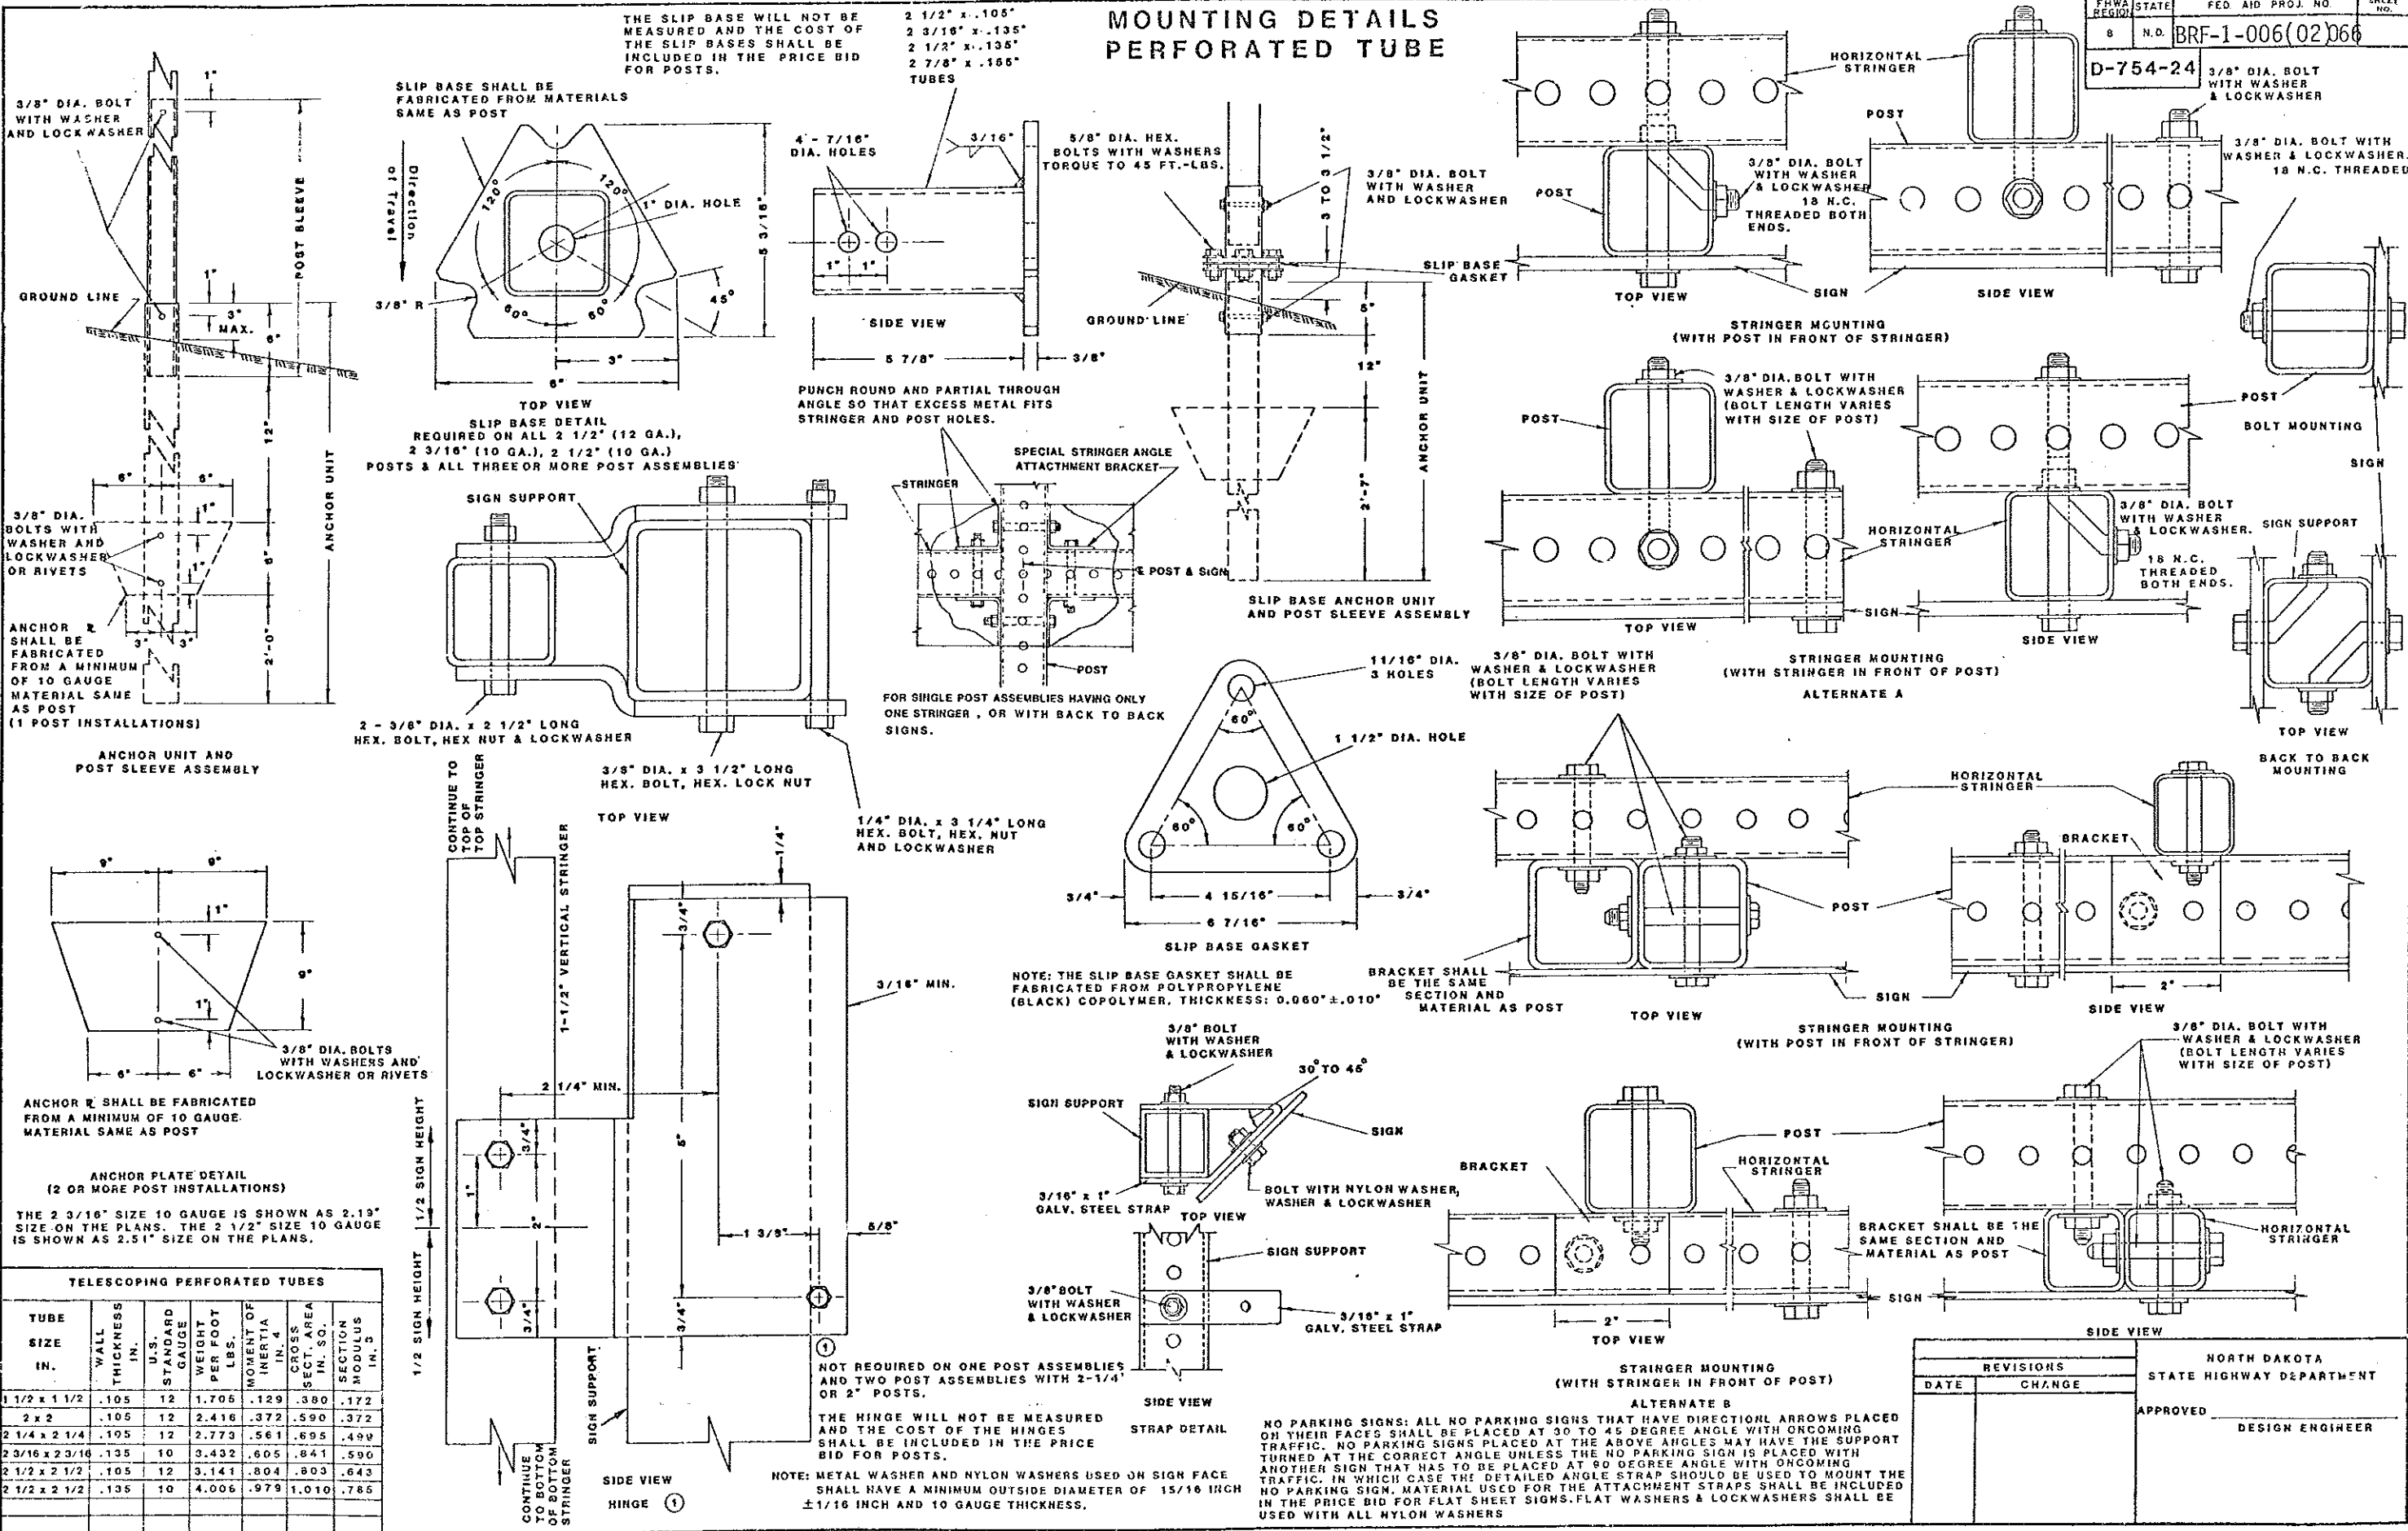

TELESCOPING PERFORATED TUBES							
TUBE SIZE IN.	WALL THICKNESS IN.	U.S. STANDARD GAUGE	WEIGHT PER FOOT LBS.	MOMENT OF INERTIA IN. 4	CROSS SECT. AREA IN. 2	SECTION MODULUS IN. 3	IN. 5
1 1/2 x 1 1/2	.105	12	1.705	.129	.380	.172	
2 x 2	.105	12	2.416	.372	.590	.372	
2 1/4 x 2 1/4	.105	12	2.773	.561	.695	.490	
2 3/16 x 2 3/16	.135	10	3.432	.605	.841	.590	
2 1/2 x 2 1/2	.105	12	3.141	.804	.803	.643	
2 1/2 x 2 1/2	.135	10	4.006	.979	1.010	.785	

REVISIONS		DATE	CHANGE	APPROVED	DESIGN ENGINEER


NORTH DAKOTA STATE HIGHWAY DEPARTMENT



**SIGN PUNCHING, STRINGER AND SUPPORT LOCATION DETAILS  
REGULATORY, WARNING, AND GUIDE SIGNS**


FHWA REGION	STATE	FED. AID PROJECT NO.	SHEET NO.
8	N.D.	BRF-1-006(02)066	

D-754-26

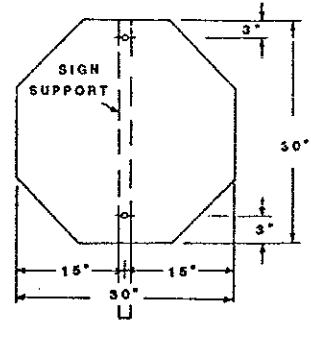


1 POST


ASSEMBLY NO. 1

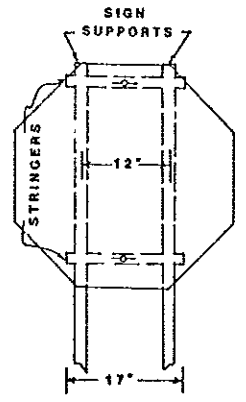

2 POSTS

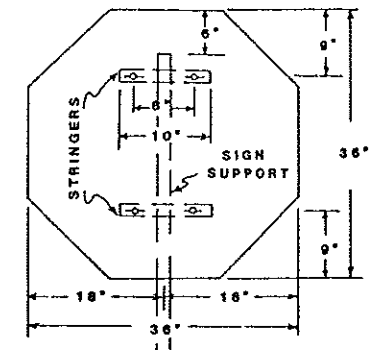


1 POST

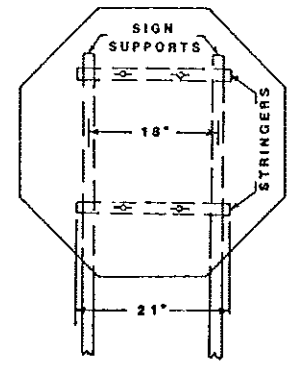


2 POSTS


ASSEMBLY NO. 2

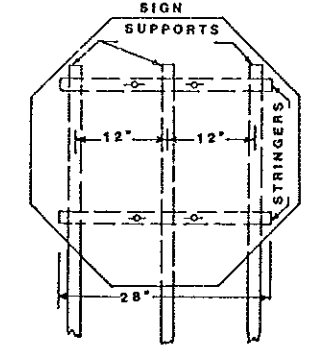

3 POSTS

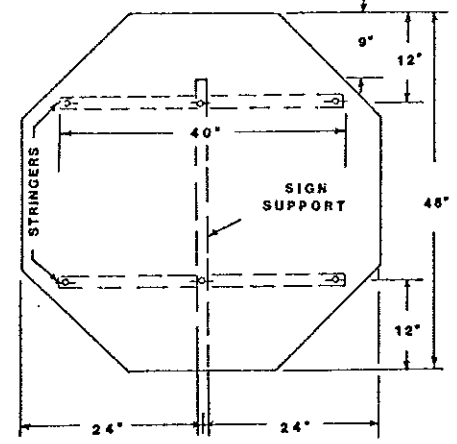


1 POST

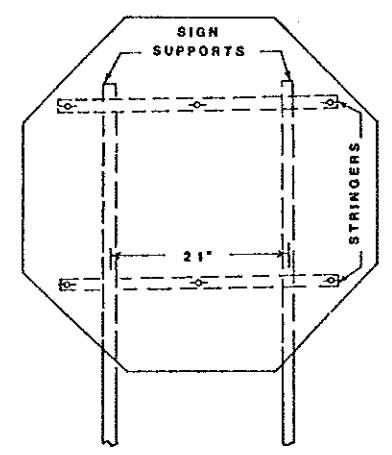


2 POSTS


ASSEMBLY NO. 3

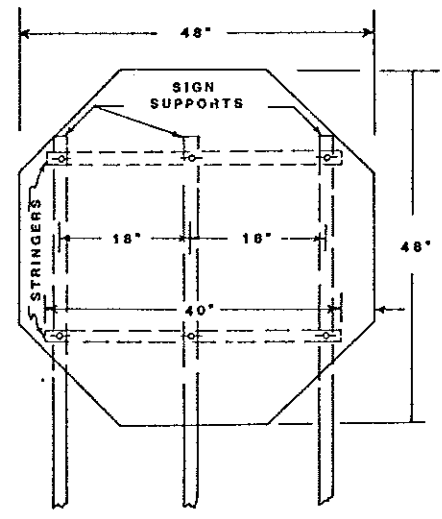

3 POSTS

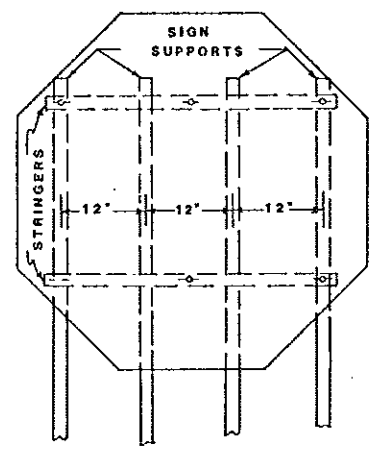


4 POSTS

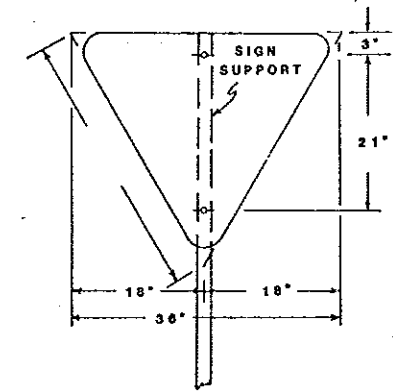

1 POST

ASSEMBLY NO. 4

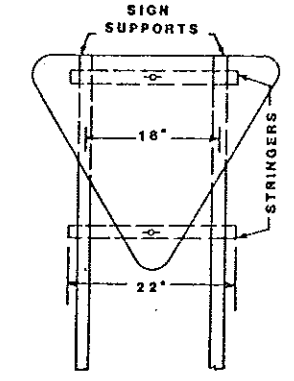

2 POSTS

**NOTE:**

**Material:**

Signing Backing: The sign backing material thickness shall be as follows.

Steel: Signs having a width of less than 30" shall use 14 gauge material. Signs 30" or more shall use 12 gauge material.

Aluminum: Aluminum Alloy 6061-T6 and 5052 -H38 shall have the following minimum thickness: All signs shall be 0.100 inch.

**Stringers:**

Flange Channel: All stringers shall be flange channel 1.12" per foot and of the length shown.

Square Tube, Perforated: All stringers shall be square tube, perforated 1 1/2" X 1 1/2" and of the length shown.

**Holes:**

Flange Channel: All holes shall be punched round for 3/8" diameter bolts.


Square Tube, Perforated: All holes shall be punched round for 3/8" diameter bolts.

**General:**


See plans for sign numbers to be used at each location.

See Std. D-754-24 square tube, perforated mounting details.

See Std. D-754-25 for flange channel mounting details.

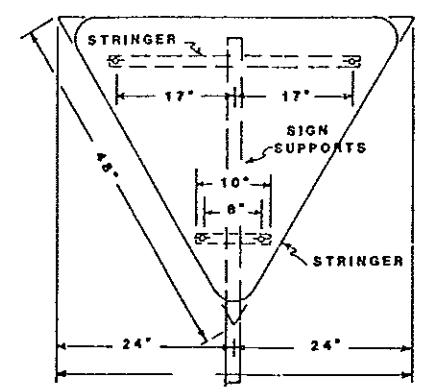


1 POST

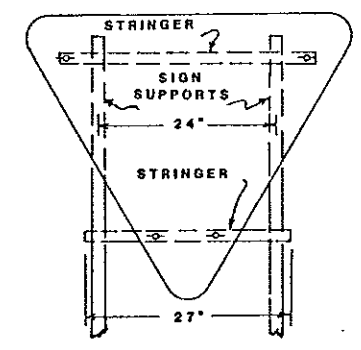

2 POSTS

ASSEMBLY NO. 5

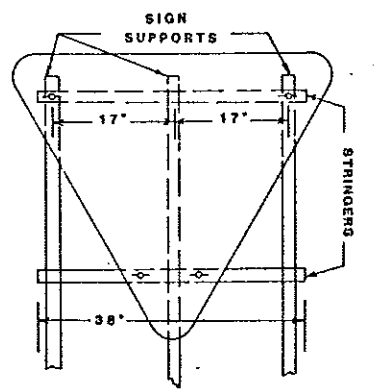


3 POSTS

REVISIONS		NORTH DAKOTA STATE HIGHWAY DEPARTMENT
DATE	CHANGE	
		SUBMITTED: _____ DESIGN ENGINEER
		RECOMMENDED: _____ ASST. CHIEF ENGINEER PRE-CONSTRUCTION
		APPROVED: _____ CHIEF ENGINEER




### SIGN PUNCHING, STRINGER AND SUPPORT LOCATION DETAILS REGULATORY, WARNING, AND GUIDE SIGNS


FHWA REGION	STATE	FED. AID PROJECT NO.	SHEET NO.
8	N.D.	BRF-1-006(02)066	D-754-27

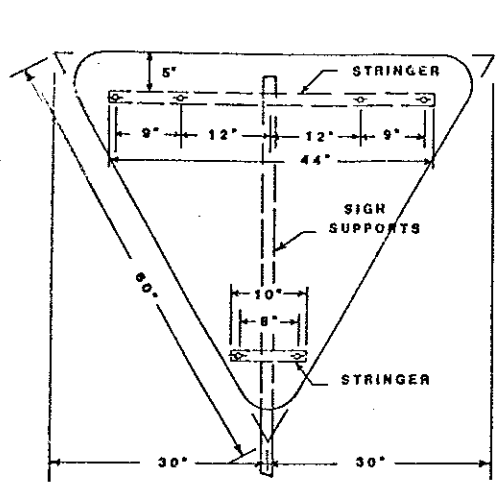


1 POST

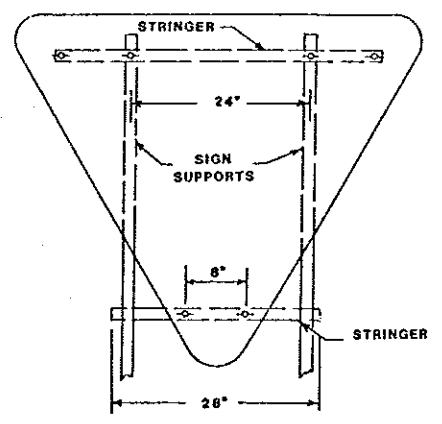


2 POSTS

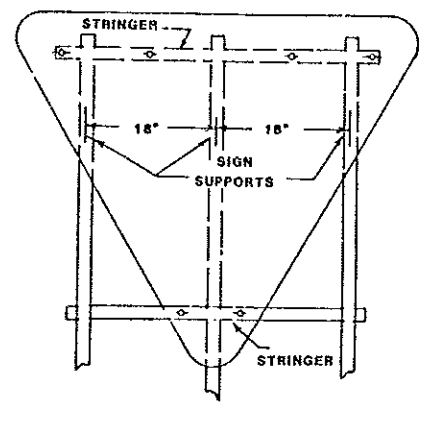

3 POSTS

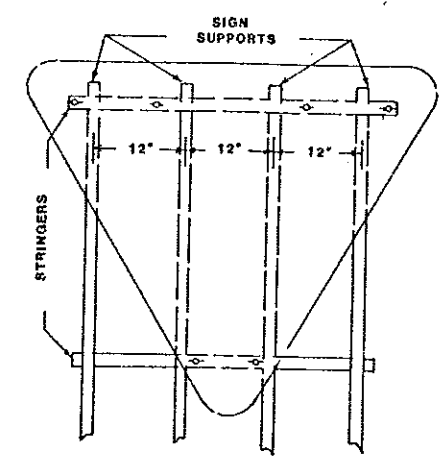


4 POSTS

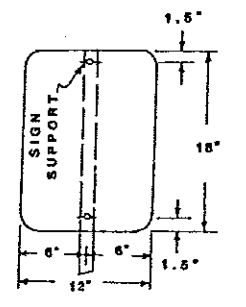

1 POST


ASSEMBLY NO. 7

ASSEMBLY NO. 6

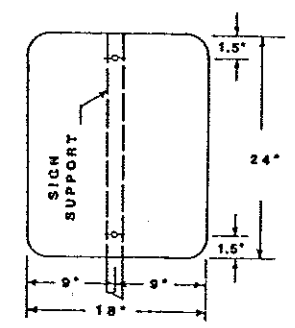


1 POST

ASSEMBLY NO. 8

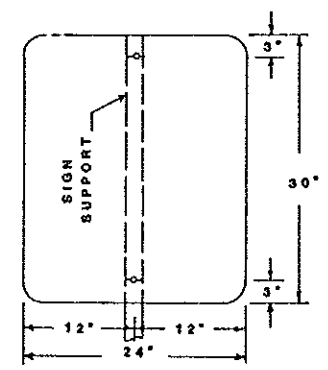


1 POST

ASSEMBLY NO. 9

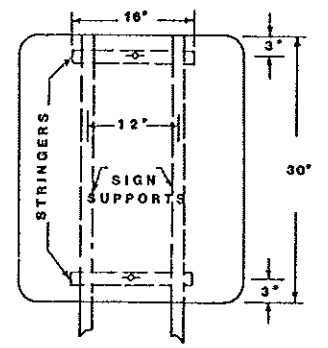


2 POSTS

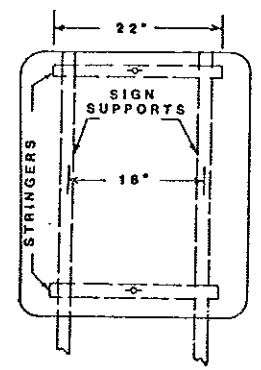

1 POST

ASSEMBLY NO. 10

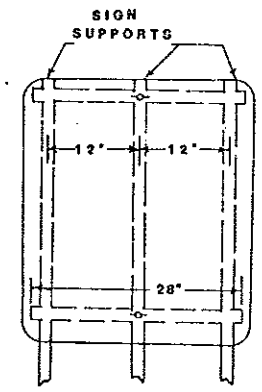

3 POSTS

**NOTE:**

**Material:**

Sign Backing: The sign backing material thickness shall be as follows.  
 Steel: Signs having a width of less than 30" shall use 14 gauge material. Signs 30" or more shall use 12 gauge material.  
 Aluminum: Aluminum Alloy 6061-T6 and 5052-H38 shall have the following minimum thickness: All signs shall be 0.100 inch.

**Stringers:**


Flange Channel: All stringers shall be flange channel 1.12# per foot and of the length shown.  
 Square Tube, Perforated: All stringers shall be square tube, perforated 1 1/2" X 1 1/2" and of the length shown.

**Holes:**


Flange Channel: All holes shall be punched round for 3/8" diameter bolts.  
 Square Tube, Perforated: All holes shall be punched round for 3/8" diameter bolts.

**General:**

See plans for sign numbers to be used at each location.  
 See Std. D-754-24 for square tube, perforated mounting details.  
 See Std. D-754-25 for flange channel mounting details.


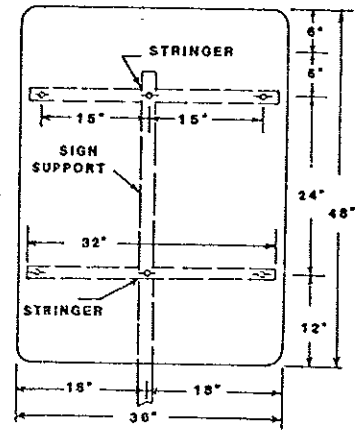


1 POST

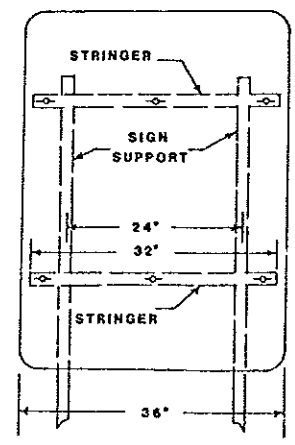

2 POSTS

ASSEMBLY NO. 11

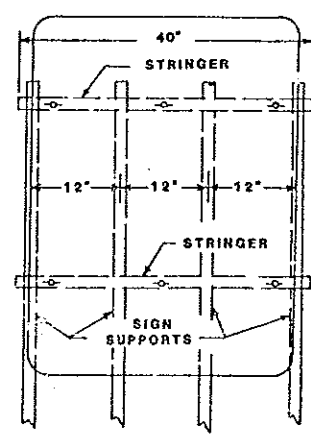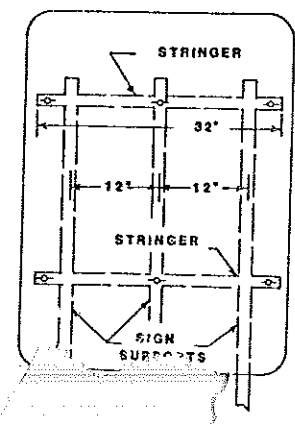

4 POSTS

REVISIONS		NORTH DAKOTA STATE HIGHWAY DEPARTMENT
DATE	CHANGE	
APPROVED: _____		DESIGN ENGINEER