

JOB #

FHWA REGION	STATE	PROJECT	SHEET NO.
8	N.D.	F-RRS-1-006 (004)067	1

DESIGN DATA

Traffic	Main Street	Average Daily	Est. 30th Max, Hr.
Current Traffic (1988)	7290 Pass.	510 Trucks	7800 Total
Traffic Forecast (2010)	14,440 Pass.	1010 Trucks	15,450 Total
	Hwy. #6		
Current Traffic (1988)	5820 Pass.	280 Trucks	6100 Total
Traffic Forecast (2010)	7630 Pass.	370 Trucks	8000 Total
Design Speed	35 MPH		
Traffic Classification "M"			
Minimum Sight Distance (Stopping)	250'		
Bridge Hs	25		

NORTH DAKOTA  
STATE HIGHWAY DEPARTMENT


MORTON COUNTY  
F-RRS-1-006(004)076  
GRADING, SURFACING, SEWER,  
LIGHTING, SIGNALS & INCIDENTALS

**GOVERNING SPECIFICATIONS**  
Standard Specifications adopted by the North Dakota State Highway Department, November 1986. Standard Drawings currently in effect, and other Contract Provisions submitted herein.

LENGTH OF PROJECT

	Miles-Gross	Miles-Net
RRS-1-006 (004)067	0.6877	0.6144
F-1-006 (004)067	0.4195	0.4195

Construction:  
Bridge - 1990  
Roadway - 1991

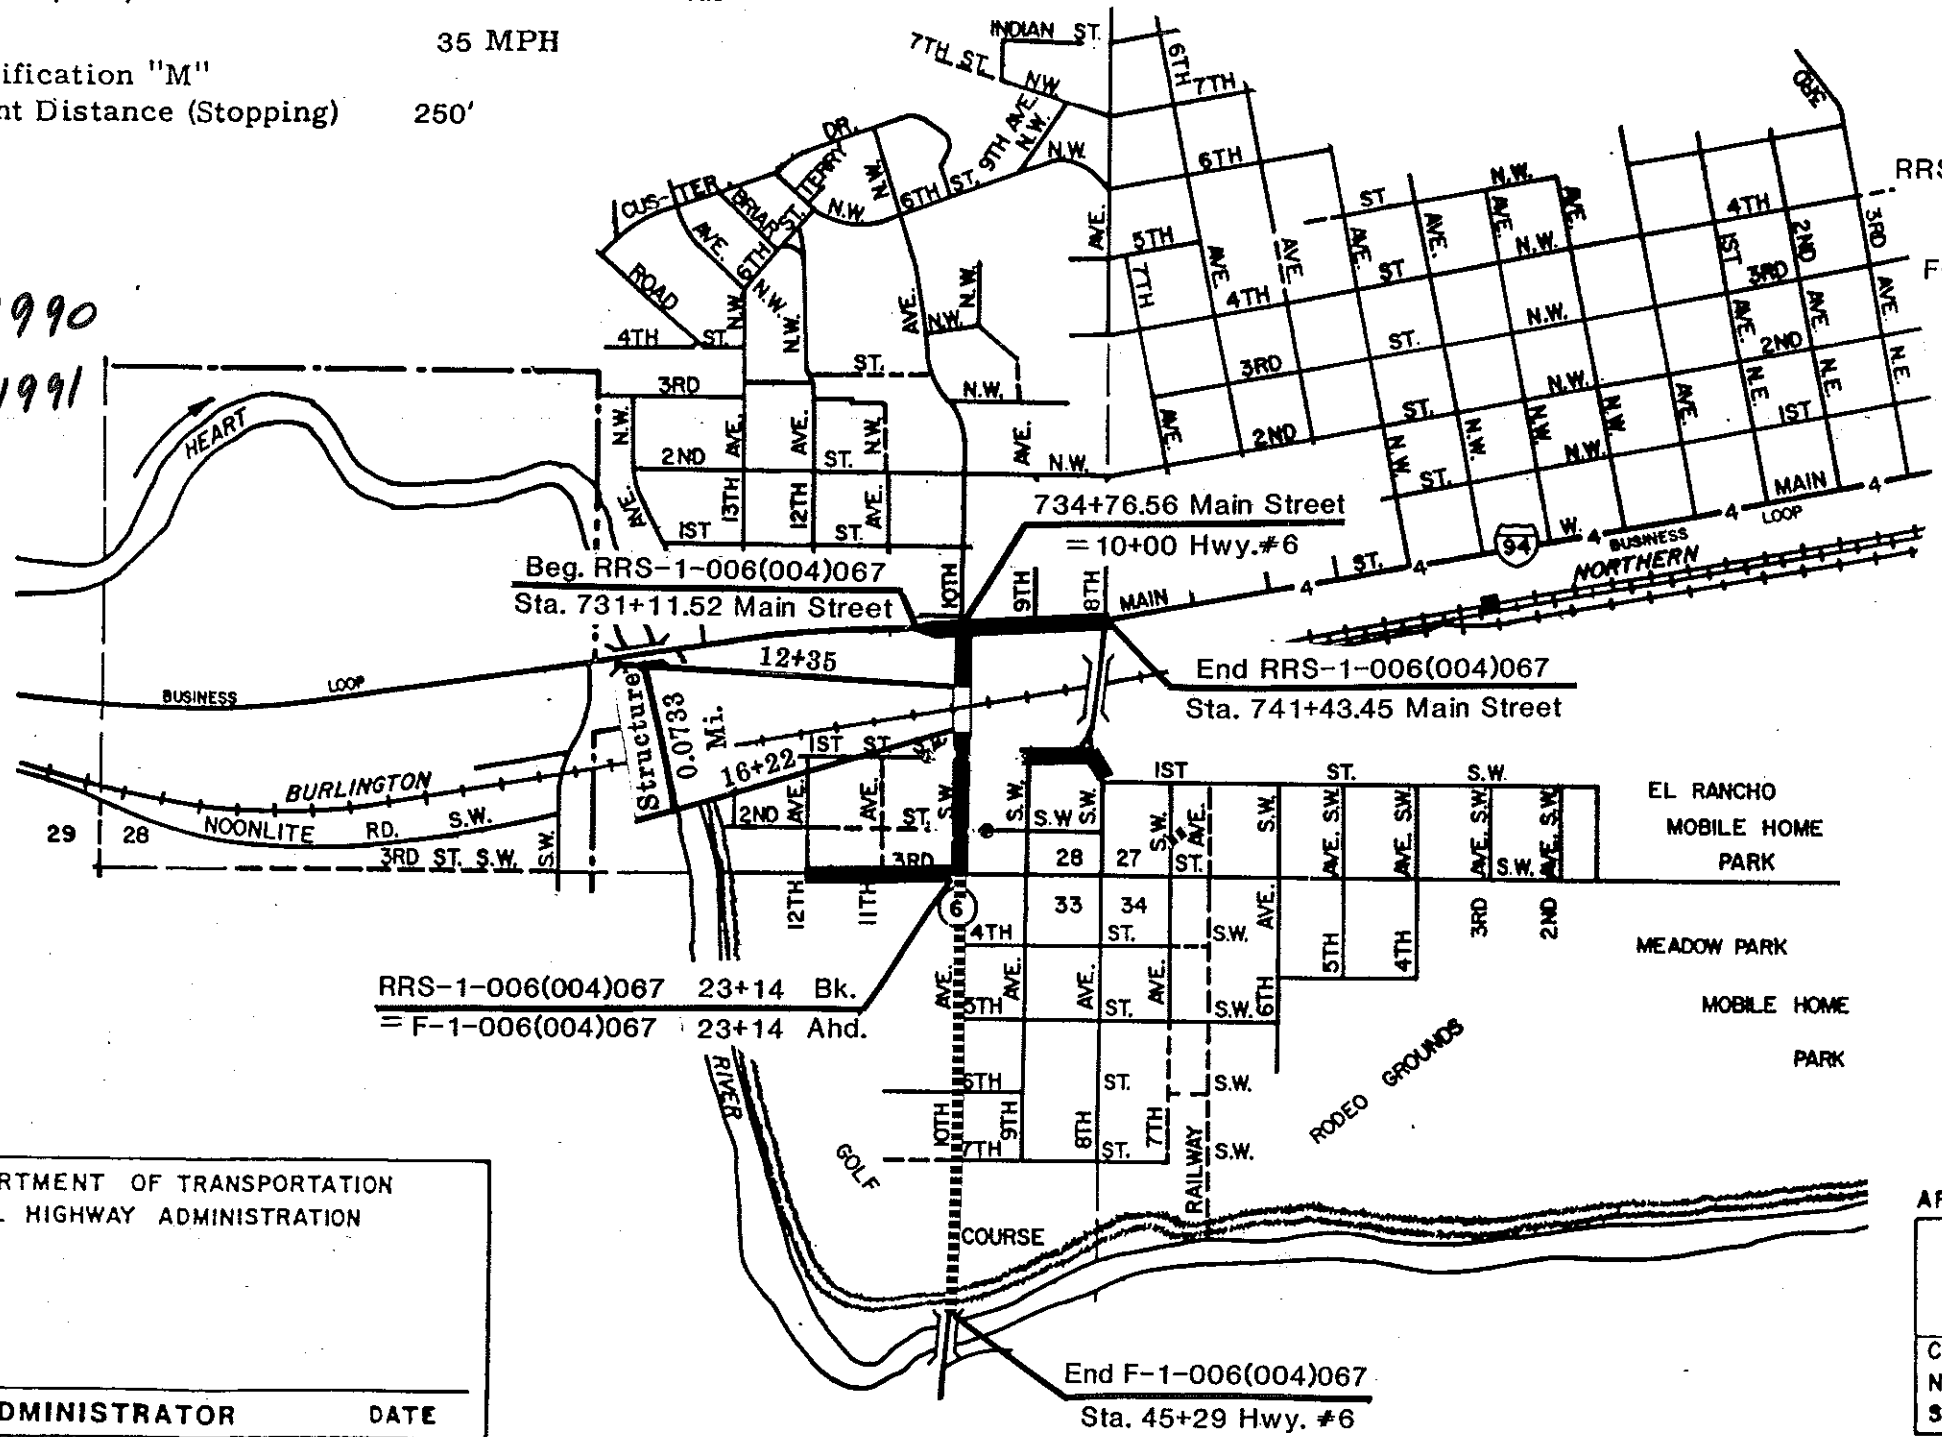

MANDAN



Section 28,  
Twp. 139 N.  
Rge. 81 W.

U.S. DEPARTMENT OF TRANSPORTATION  
FEDERAL HIGHWAY ADMINISTRATION

APPROVED \_\_\_\_\_


DIVISION ADMINISTRATOR      DATE \_\_\_\_\_

APPROVED \_\_\_\_\_ DATE \_\_\_\_\_

CHIEF ENGINEER  
NORTH DAKOTA  
STATE HIGHWAY DEPARTMENT

22

FHWA REGION	STATE	FED. AID PROJ. NO.	SHEET NO.
8	N.D.	F-1-806(015)069	187

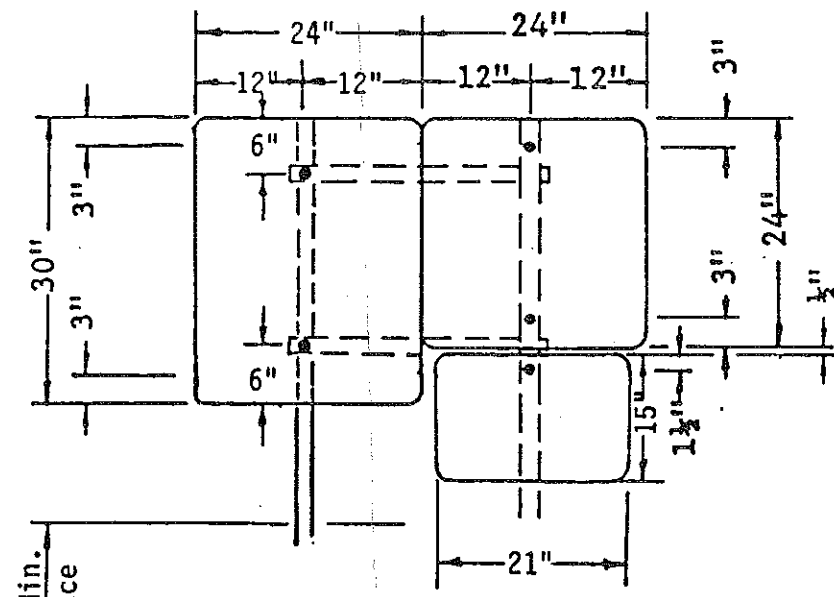


7'-0" Min.  
Clearance



Assembly E  
Sta. 61+80 Rt.  
Area: 11.19 Sq. Ft.

TRAFFIC CONTROL SYSTEM  
Sign Detail Sheet  
ND 1806 Hwy.  
Mandan, N.D.


FHWA DIST.	STATE	PR. AID PROJ. NO.	SHEET NO.
0	N.D.	506-1-1-1061965	199

Soils Profile on 1806 From Main St. South to Heart River Bridge.

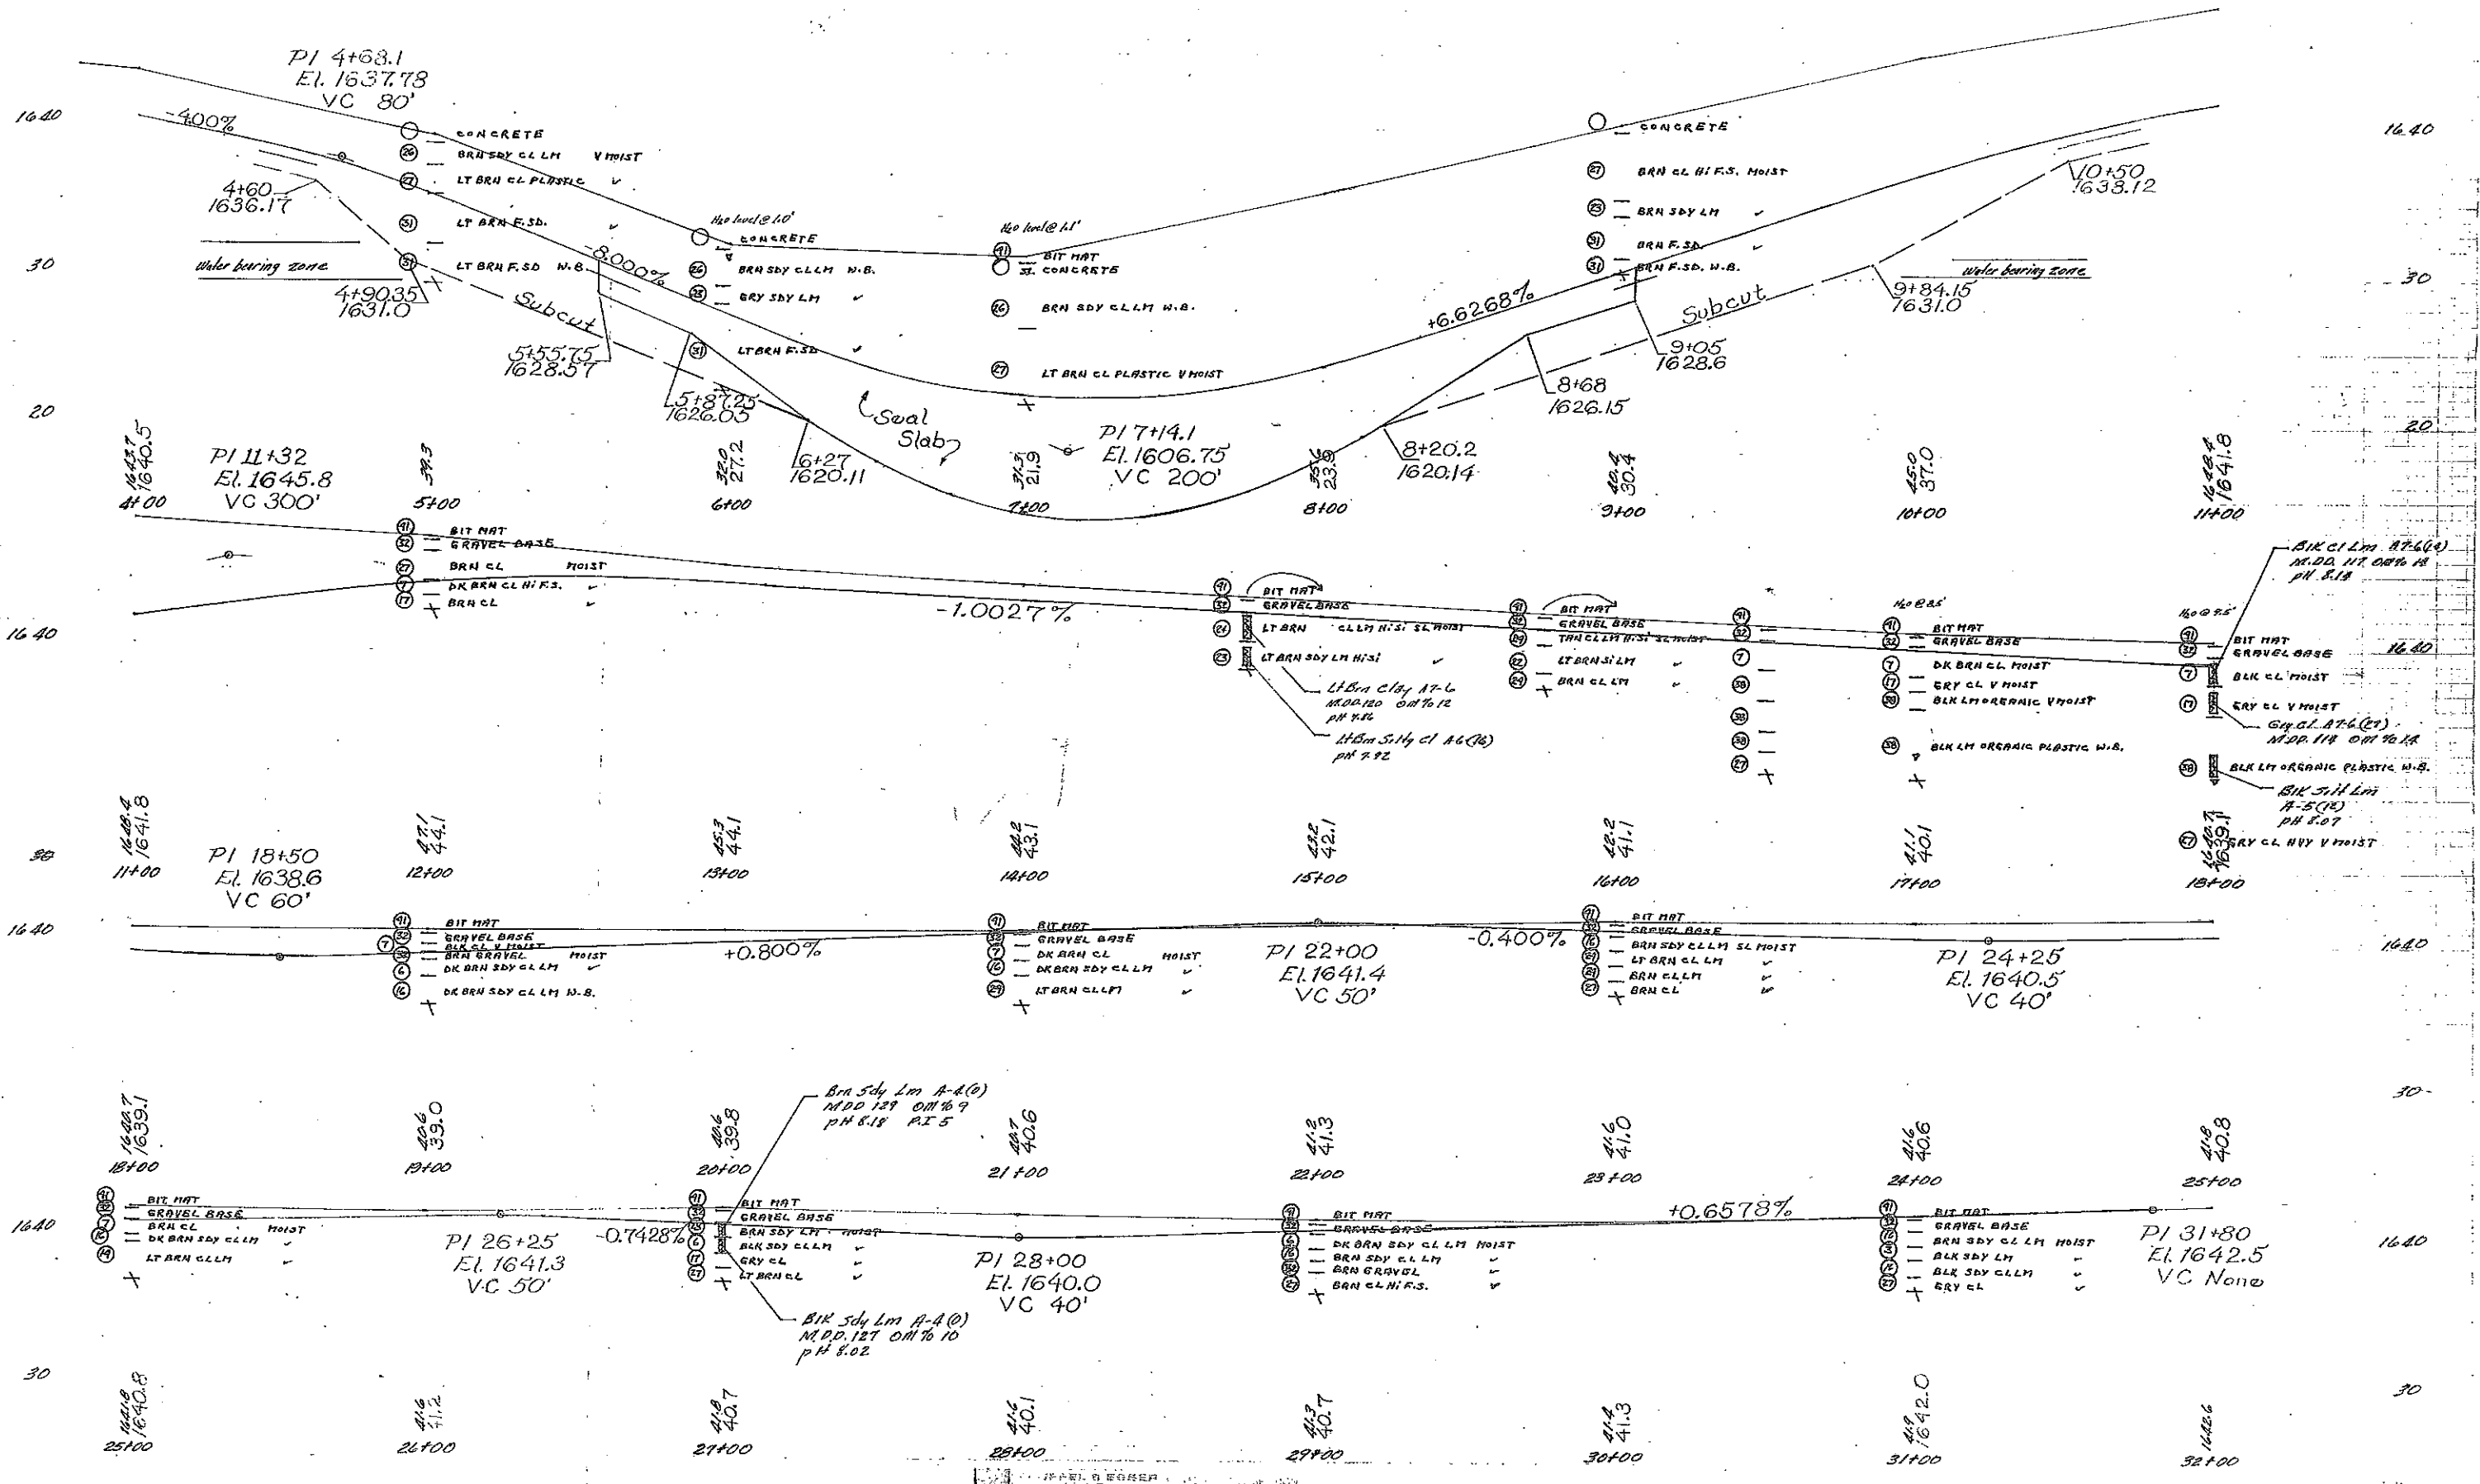


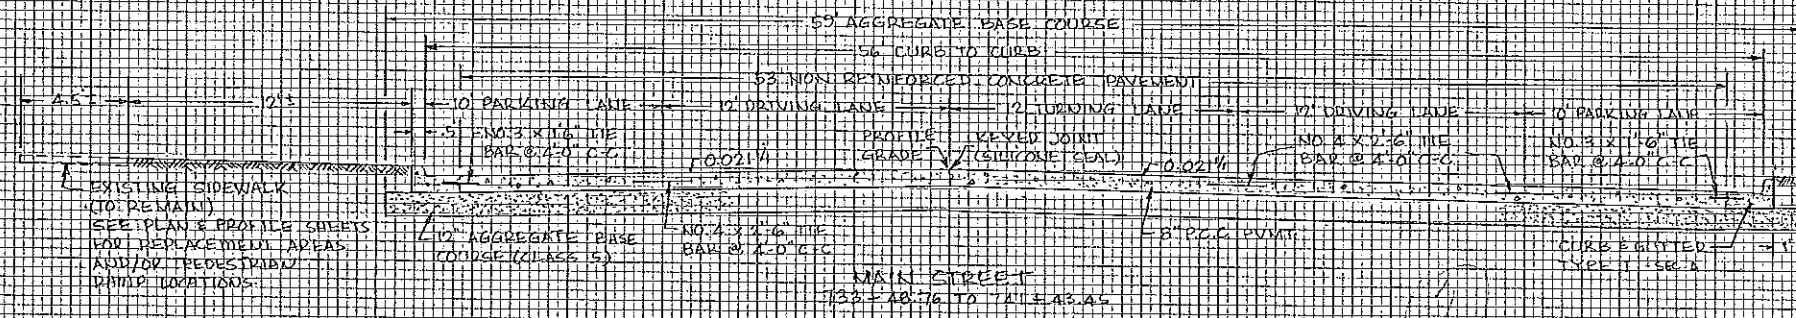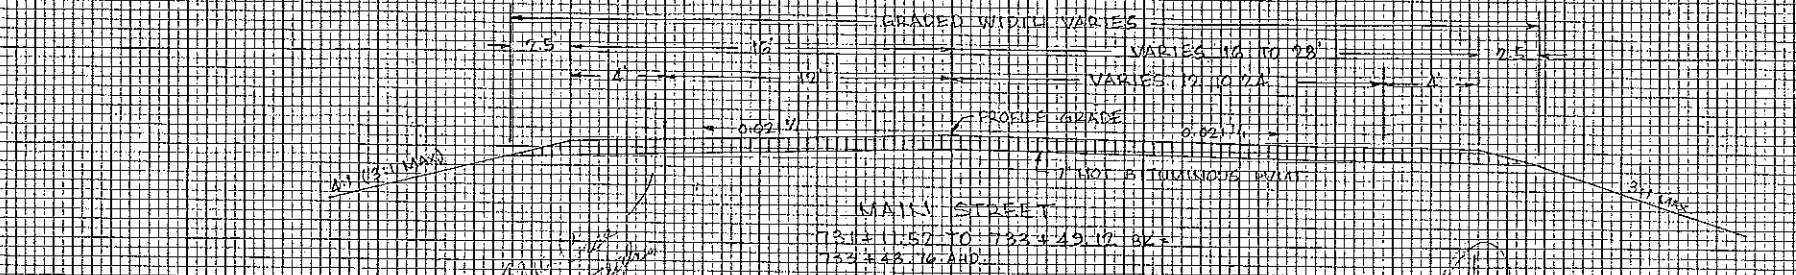

REMOVE EXISTING SORBERING  
(AND REPLACE WITH 12" HOT BIT  
POUM AS REQUIRED)  
EXISTING SORBERING  
BEHIND THE CURB TO  
BE REMOVED.  
SEE DETAIL SHEET FOR CURB  
HEADER CURB TYPE 1  
TABLES 45.10.10.4 TO 10.10.11

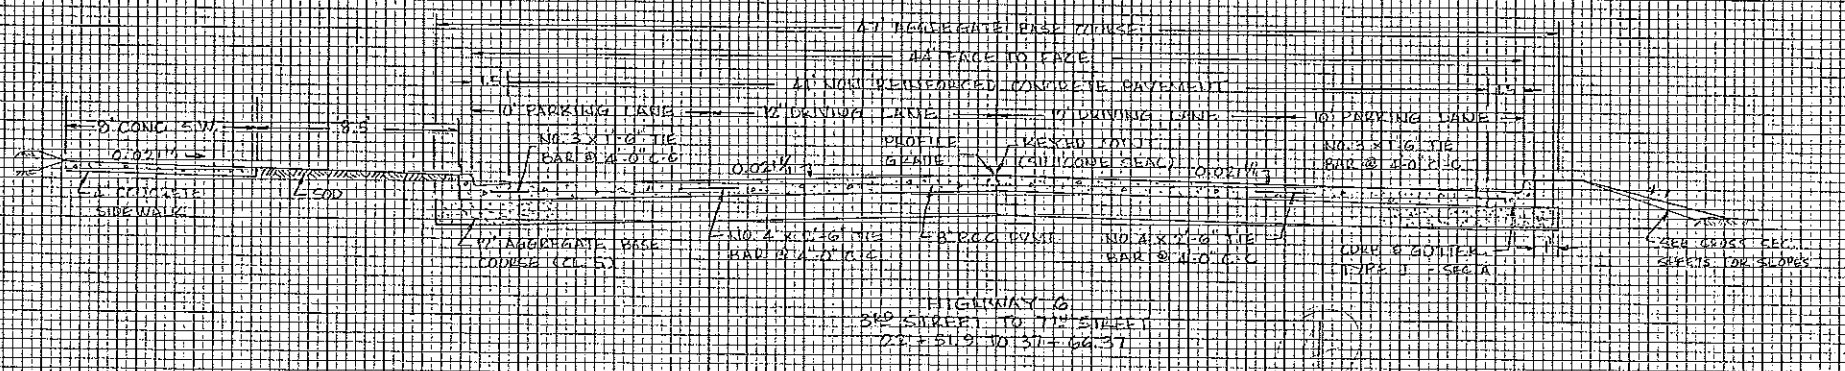





SEE CROSS SEC  
SLOPES

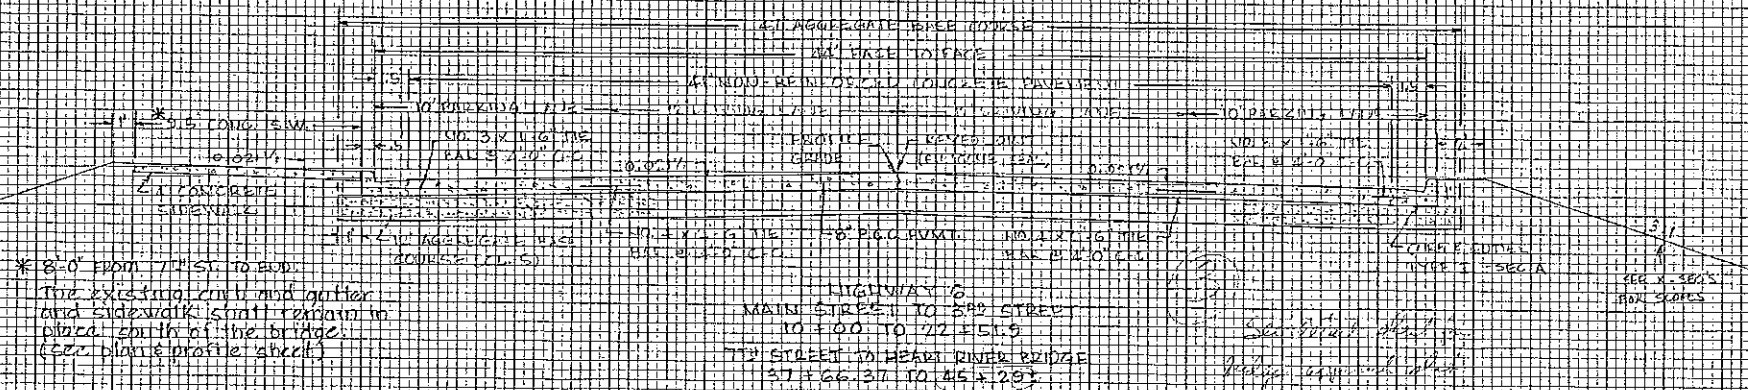





\* 8'-0" FROM 774 ST. TO END  
The existing curb and gutter  
and sidewalks shall remain in  
place south of the bridge.  
(see plan & profile sheet)


See detail sheet for  
heavy curb and  
guard of road

SEE X-SECS  
FOR SLOPES

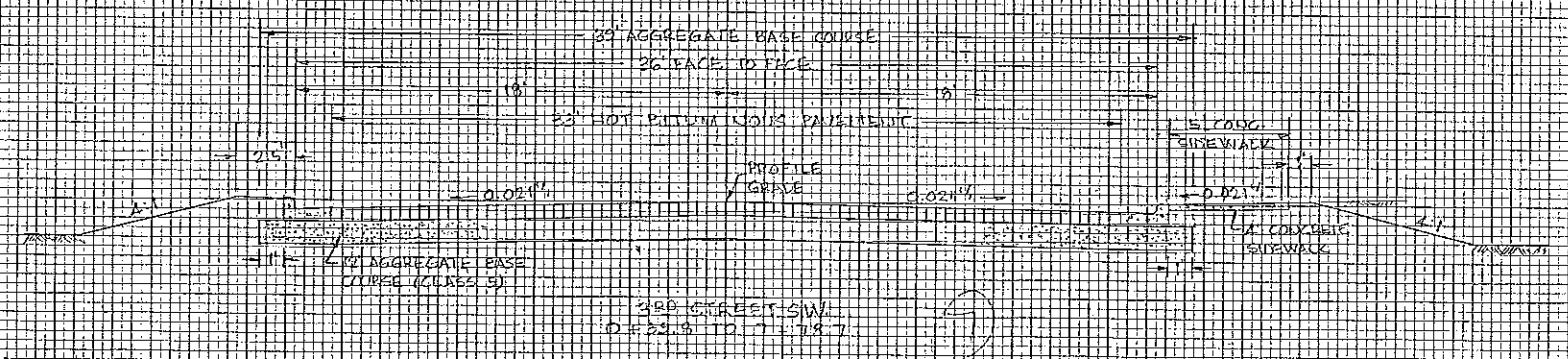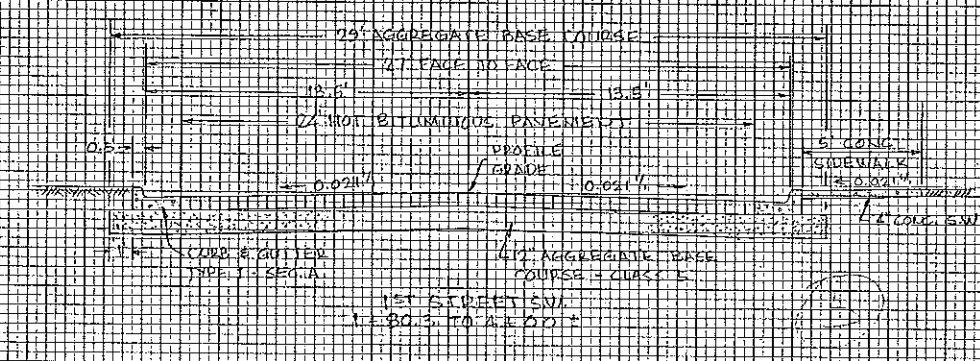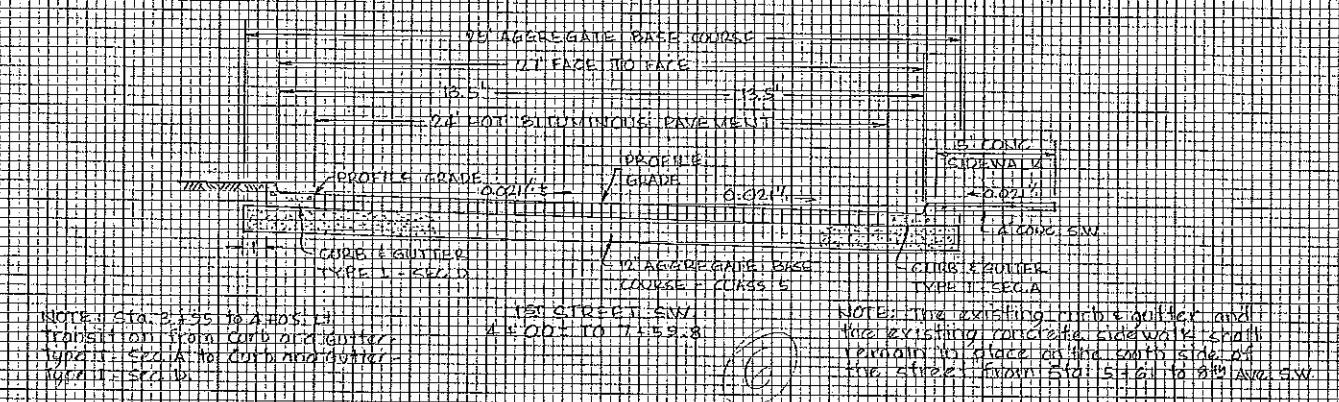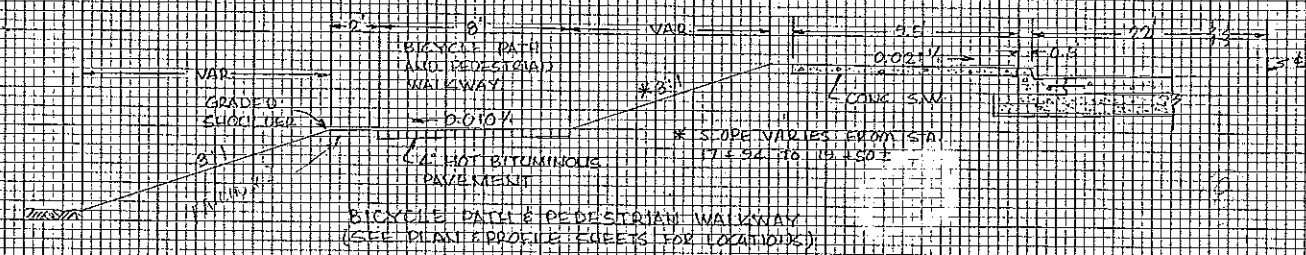

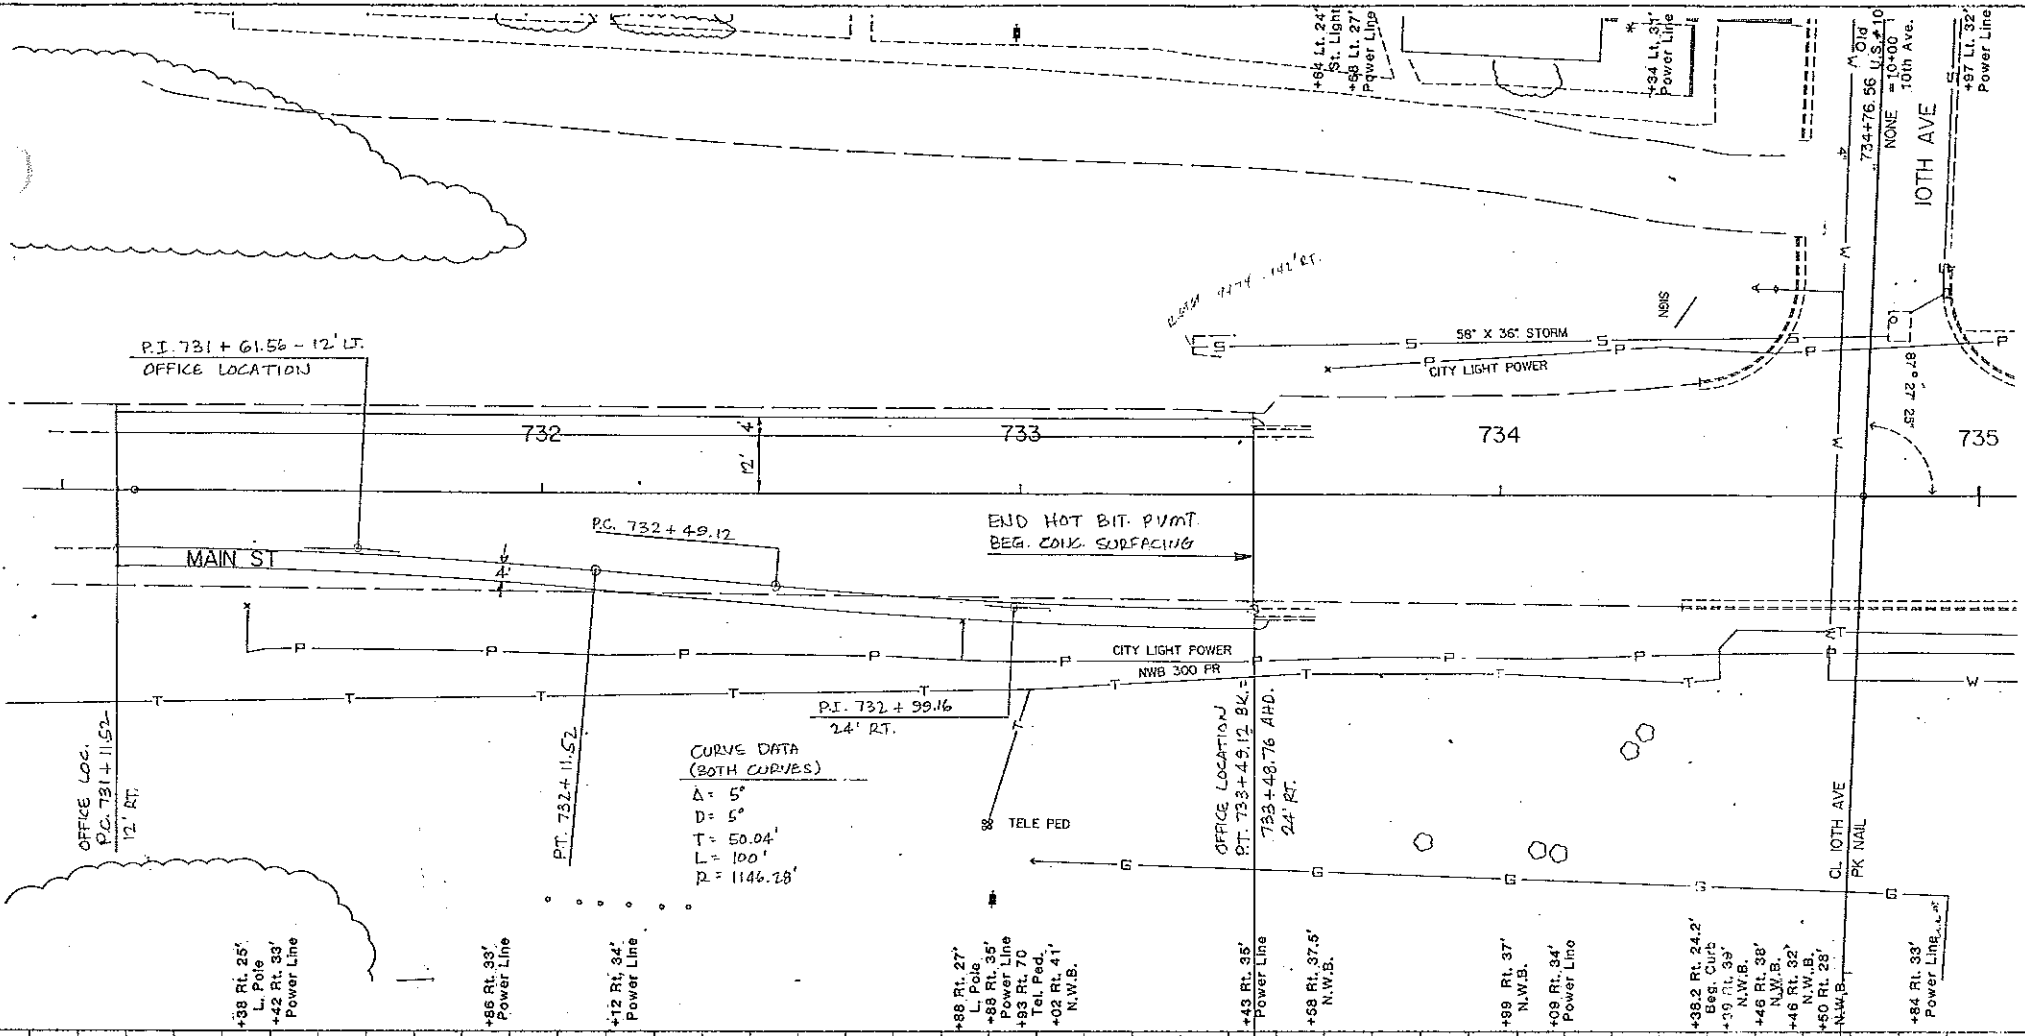

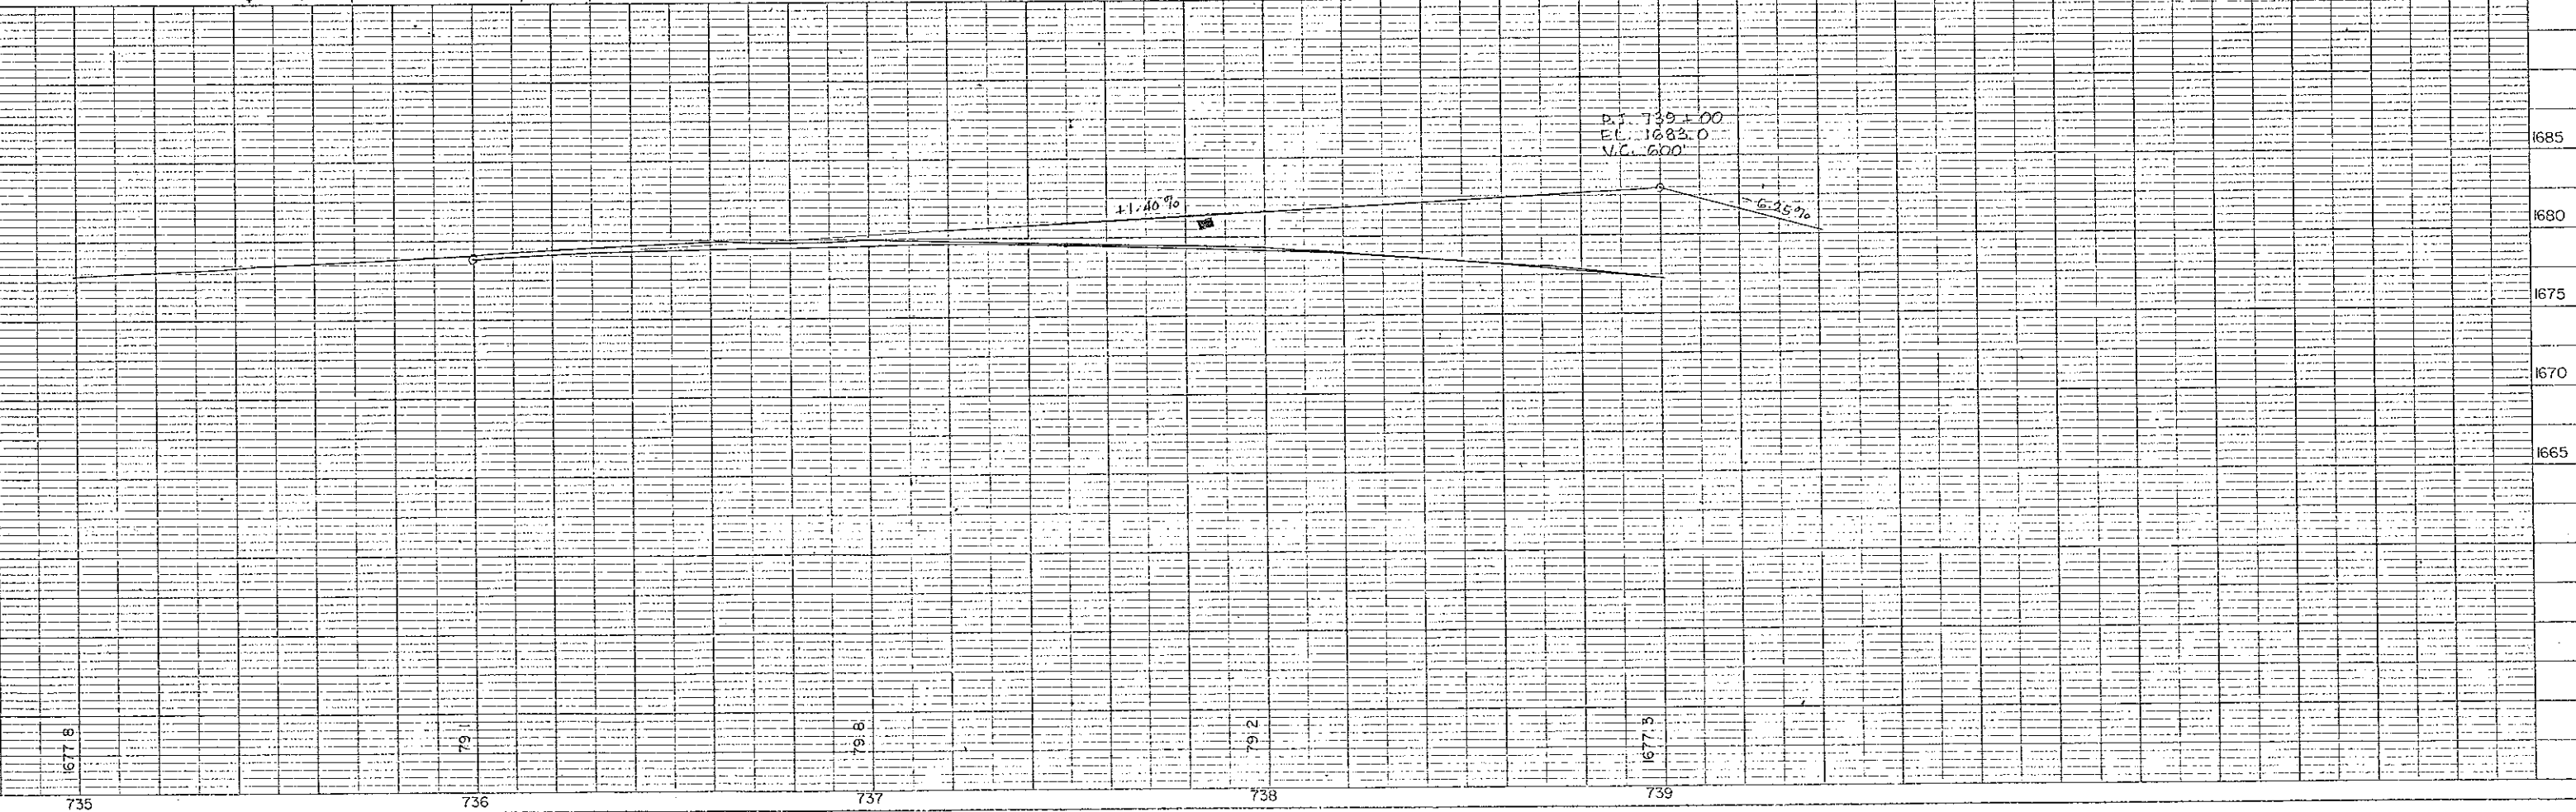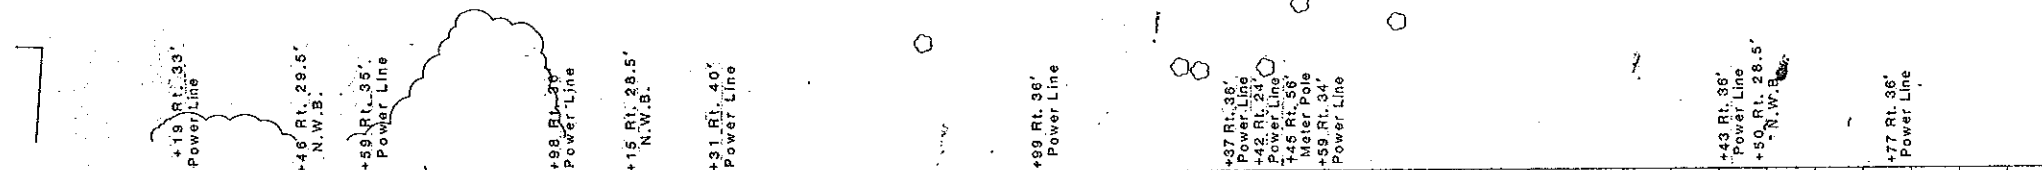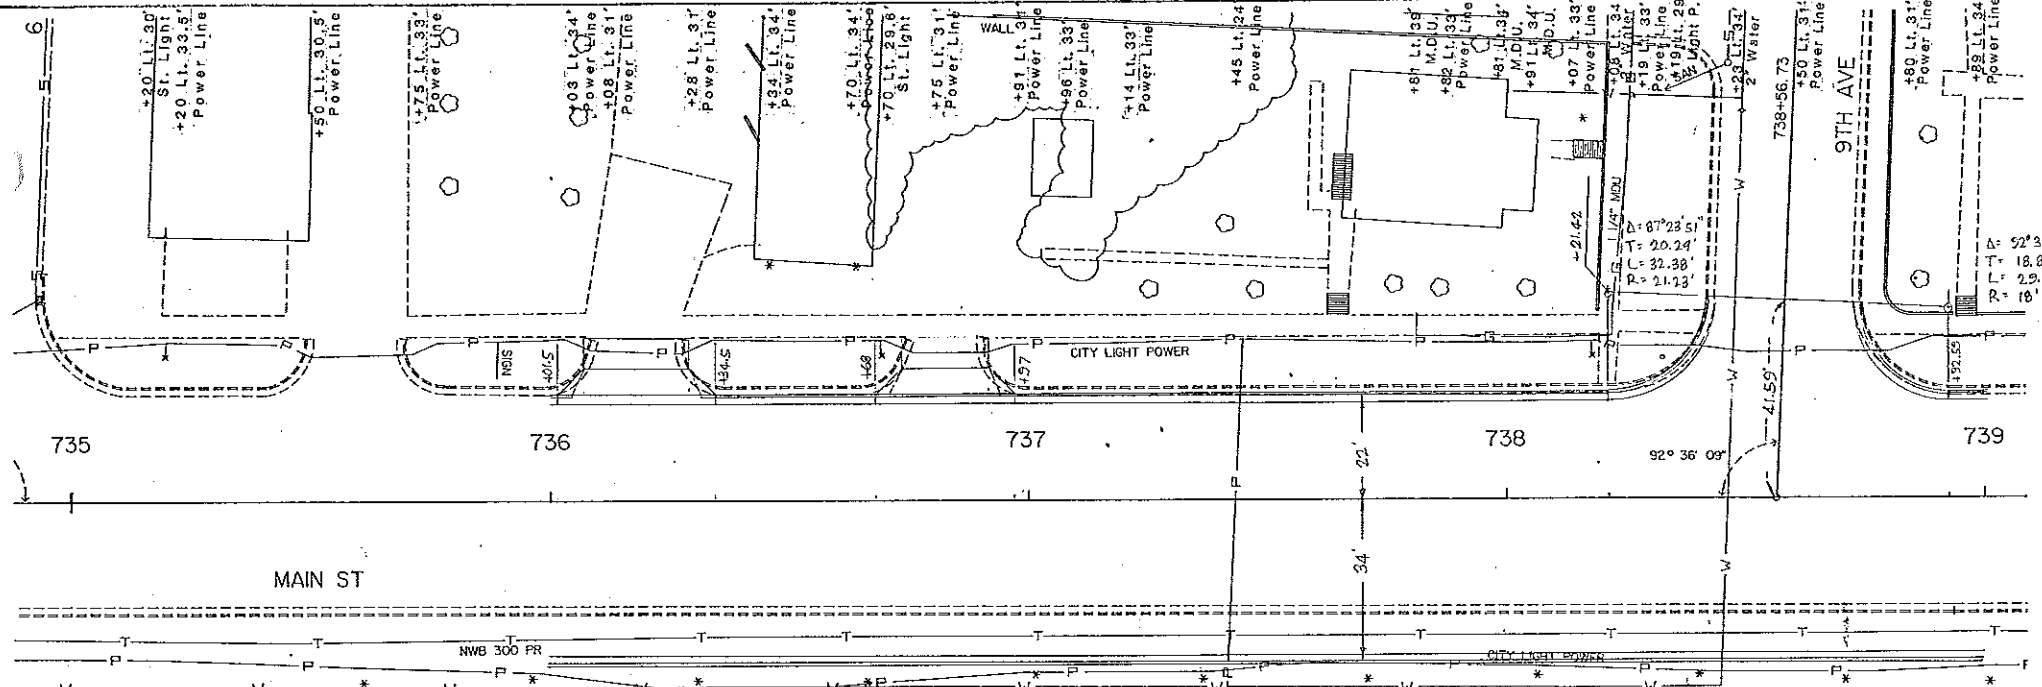

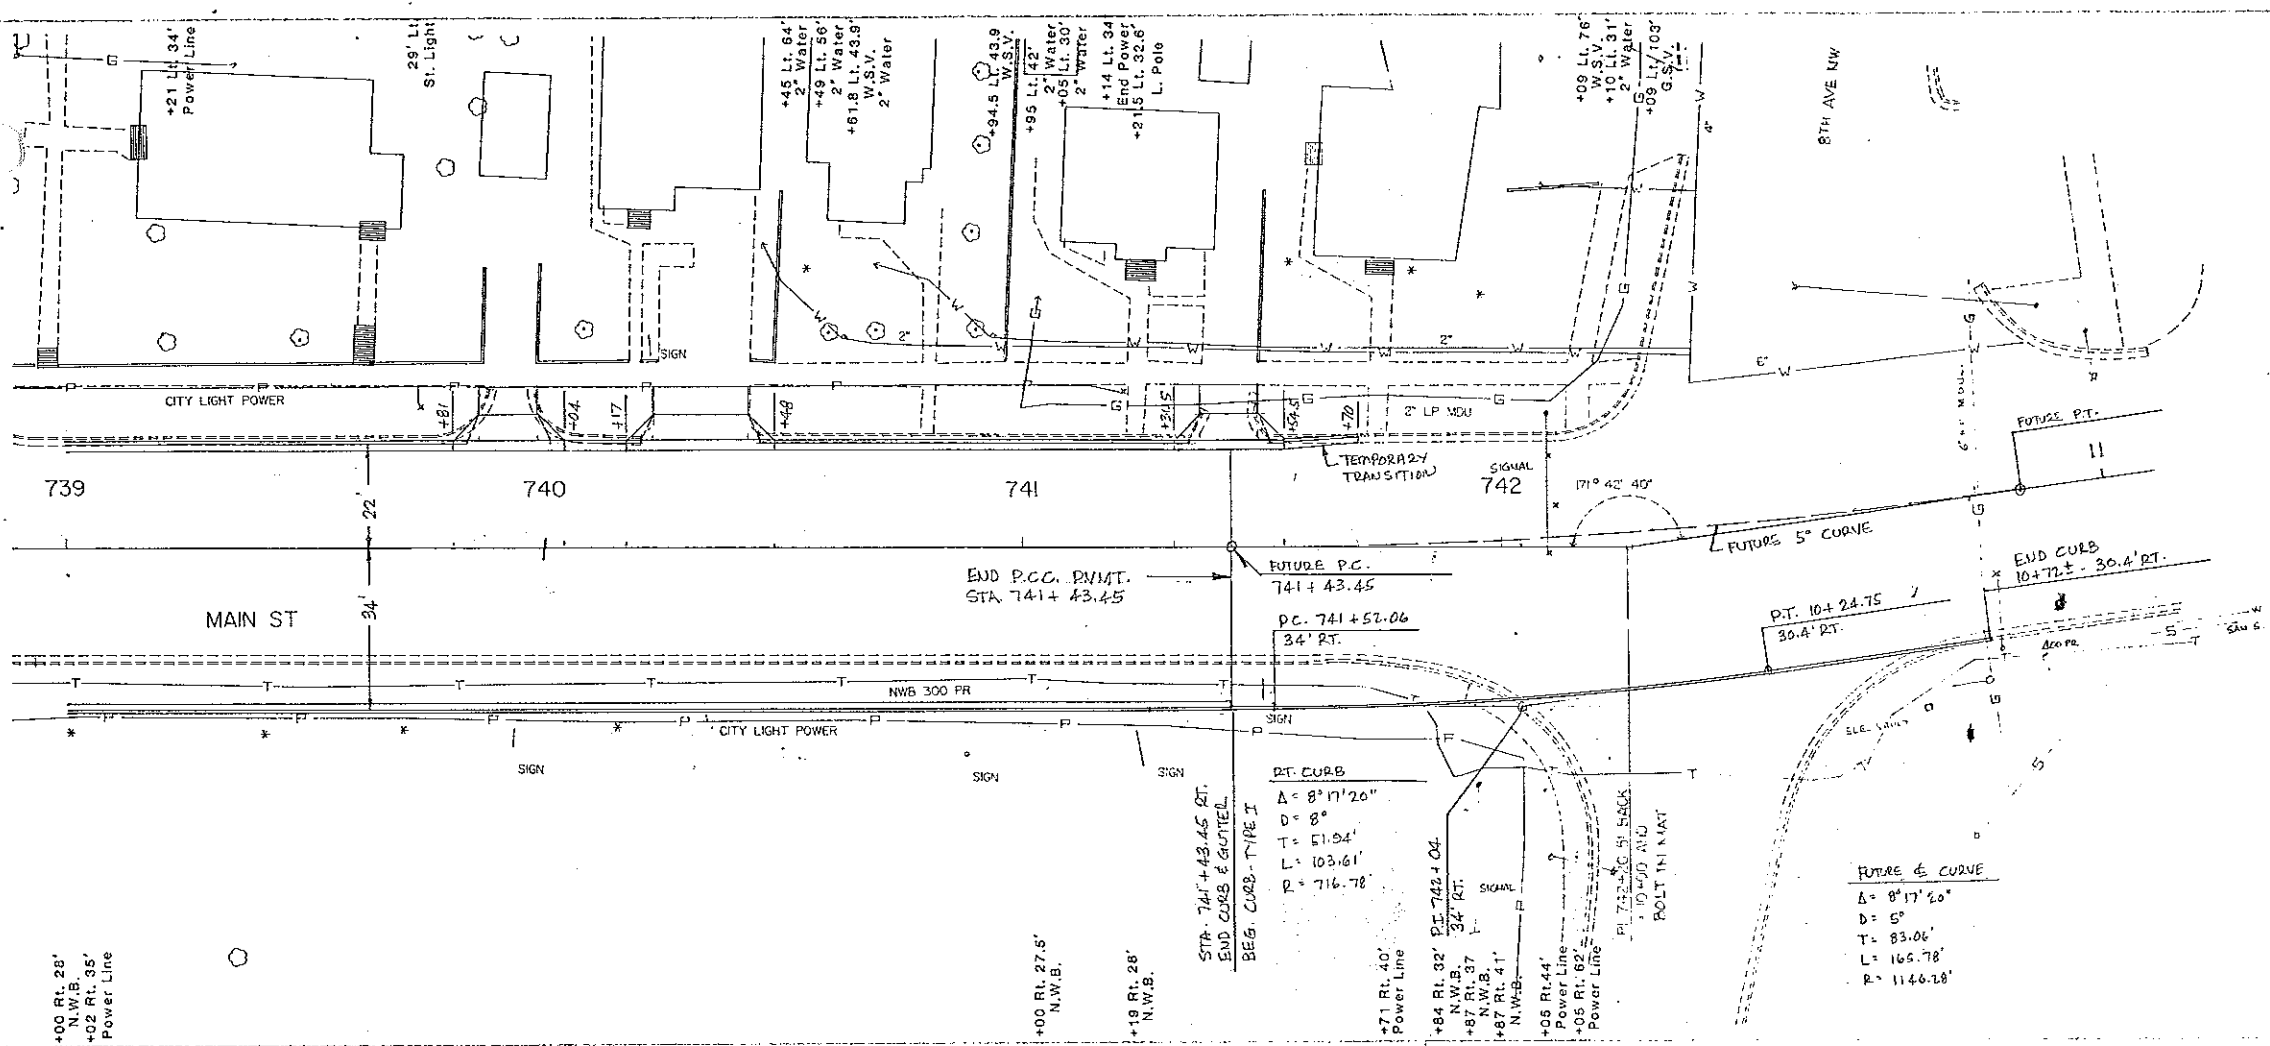

+00 Rt. 28'  
N.W.B.  
+02 Rt. 35'  
Power Line

22'  
34'

END P.C.C. PAVT.  
STA. 741 + 43.45

FUTURE P.C.  
741 + 43.45  
P.C. 741 + 52.06  
34' RT.

P.T. 10 + 24.75  
30.4' RT.

END CURB  
10 + 72 ± - 30.4' RT.

STA. 741 + 43.45 RT.  
END CURB & GUTTER  
BEG. CURB - TYPE I

RT. CURB  
A = 8° 17' 20"  
D = 8'  
T = 51.94'  
L = 103.61'  
P = 716.78'

FUTURE 5° CURVE  
A = 8° 17' 20"  
D = 5'  
T = 83.06'  
L = 165.78'  
P = 1146.28'

+00 Rt. 27.5'  
N.W.B.

+19 Rt. 28'  
N.W.B.

+71 Rt. 40'  
Power Line


+84 Rt. 32'  
N.W.B.  
+8 N.W.B.  
+87 Rt. 41'  
N.W.B.

+05 Rt. 44'  
Power Line

+05 Rt. 62'  
Power Line

742 + 26.51, 8k.  
10' x 100' AHD.



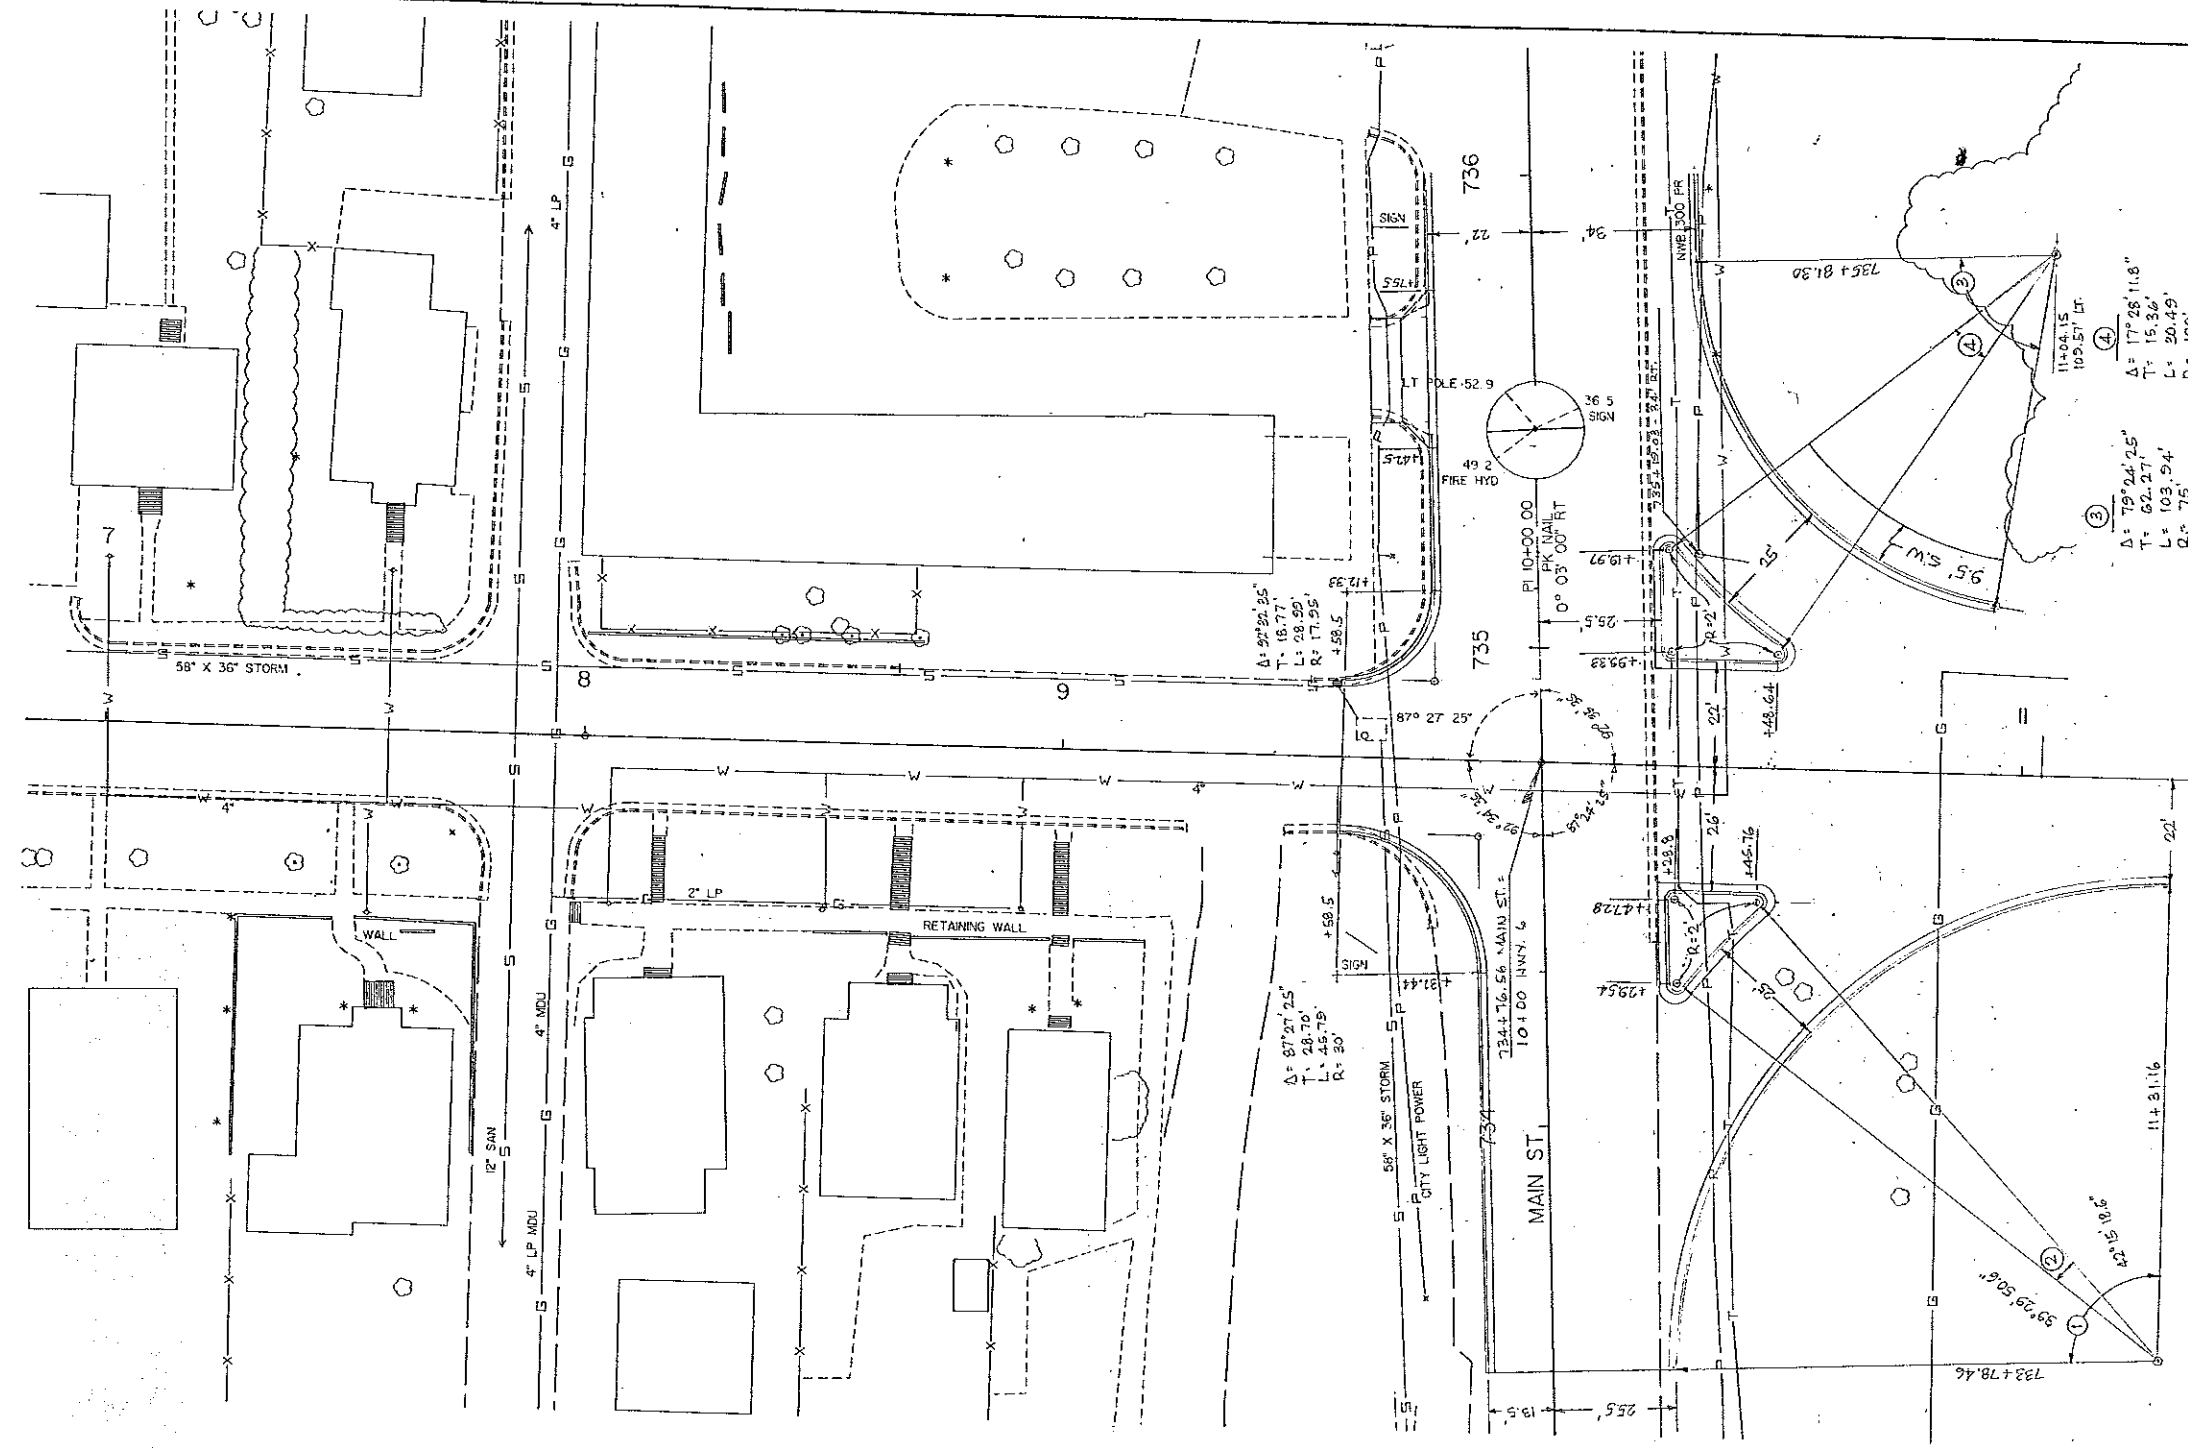

$\Delta = 87^{\circ} 27' 25''$   
 $T = 26.70'$   
 $L = 45.75'$   
 $R = 30'$










$\Delta = 97^{\circ} 20' 25''$   
 $T = 16.77'$   
 $L = 28.99'$   
 $R = 17.95'$


①  
 $\Delta = 97^{\circ} 35' 35''$   
 $T = 104.63'$   
 $L = 161.61'$   
 $R = 100'$

②  
 $\Delta = 107^{\circ} 50' 25.8''$   
 $T = 11.86'$   
 $L = 23.125'$   
 $R = 12.5'$


③  
 $\Delta = 79^{\circ} 24' 25''$   
 $T = 62.27'$   
 $L = 103.94'$   
 $R = 75'$


④  
 $\Delta = 17^{\circ} 28' 11.8''$   
 $T = 15.36'$   
 $L = 20.49'$   
 $R = 100'$

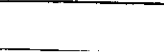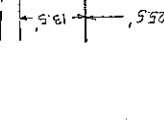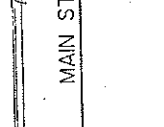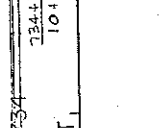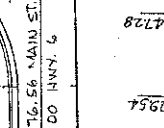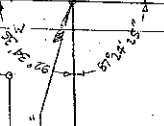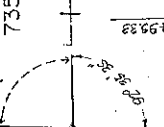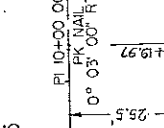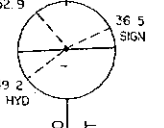

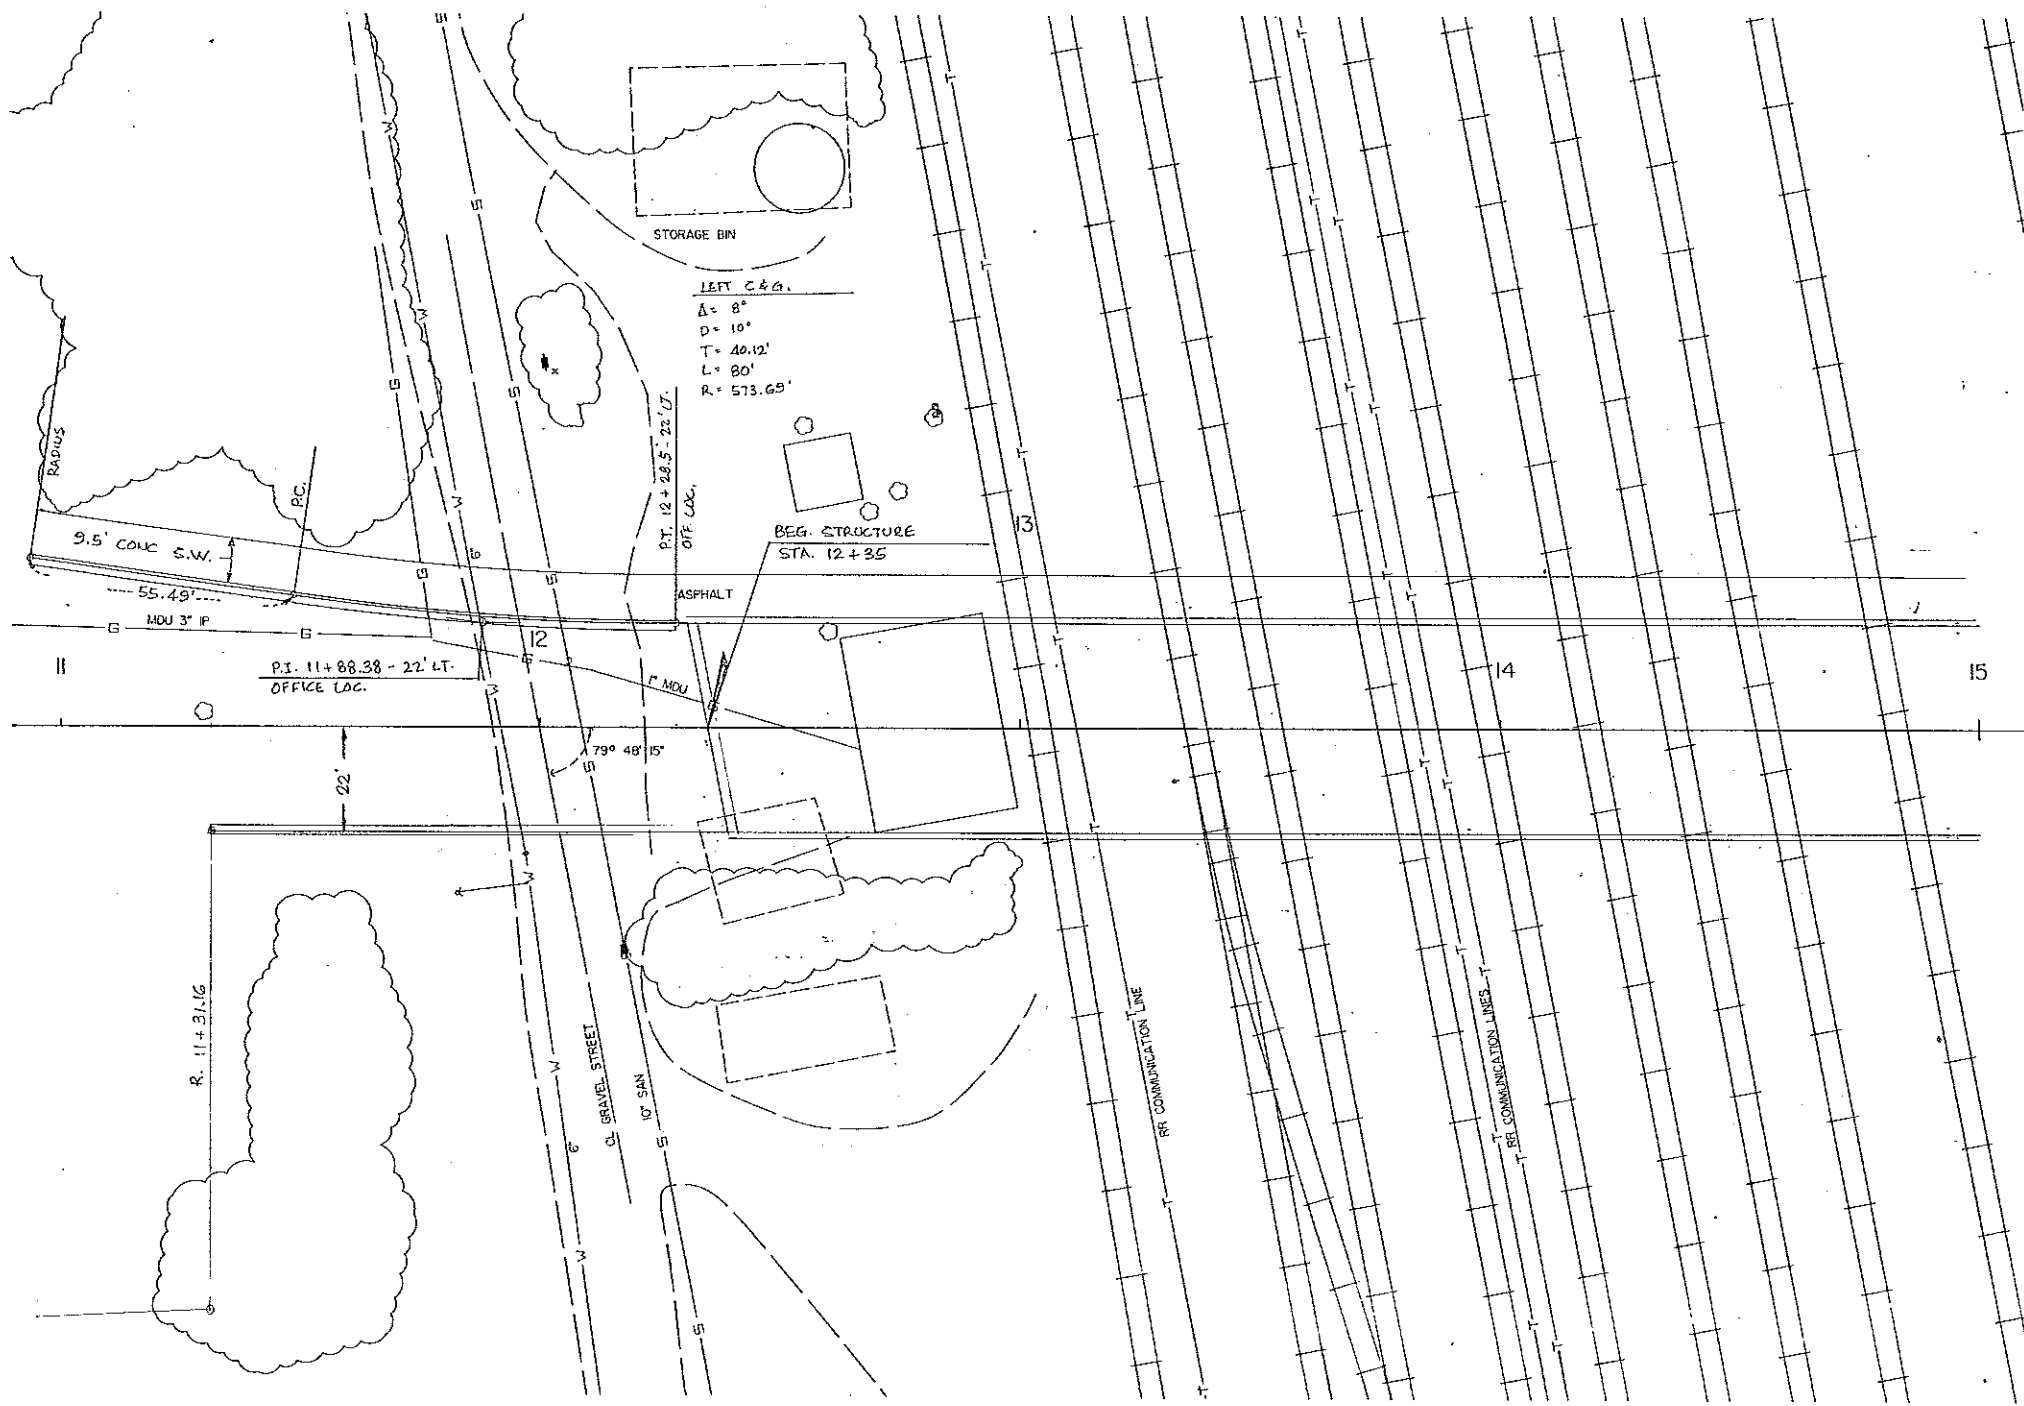

FHWA REGION	STATE	FED. AID PROJ. NO.	SHEET NO.
8	N.D.		

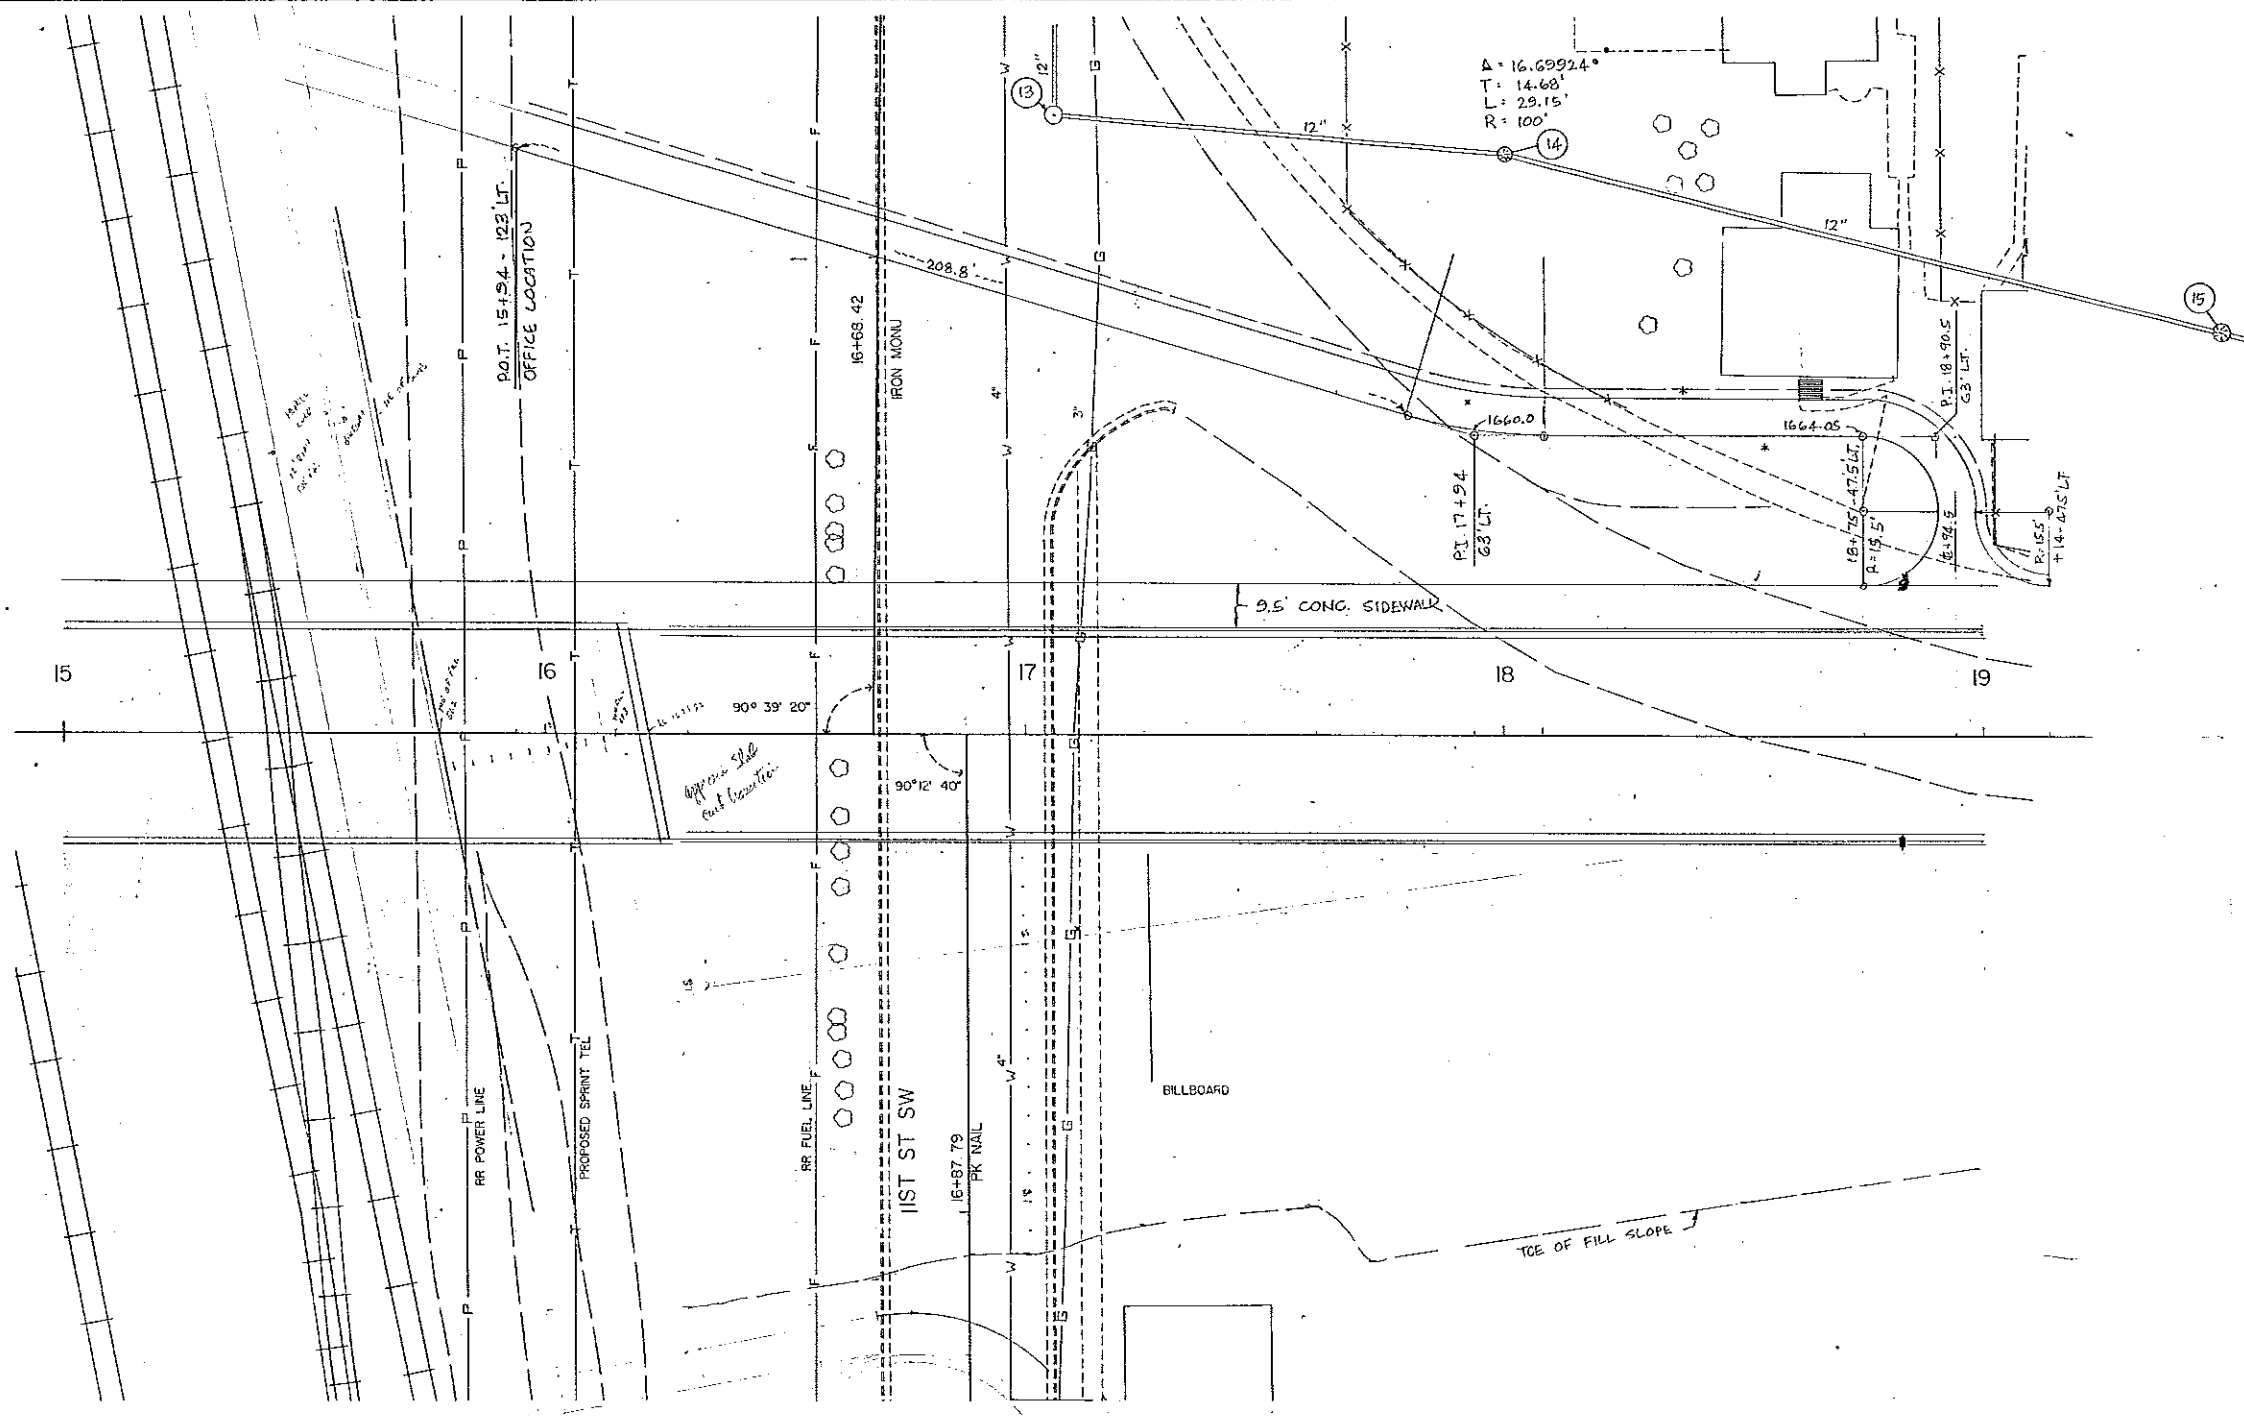

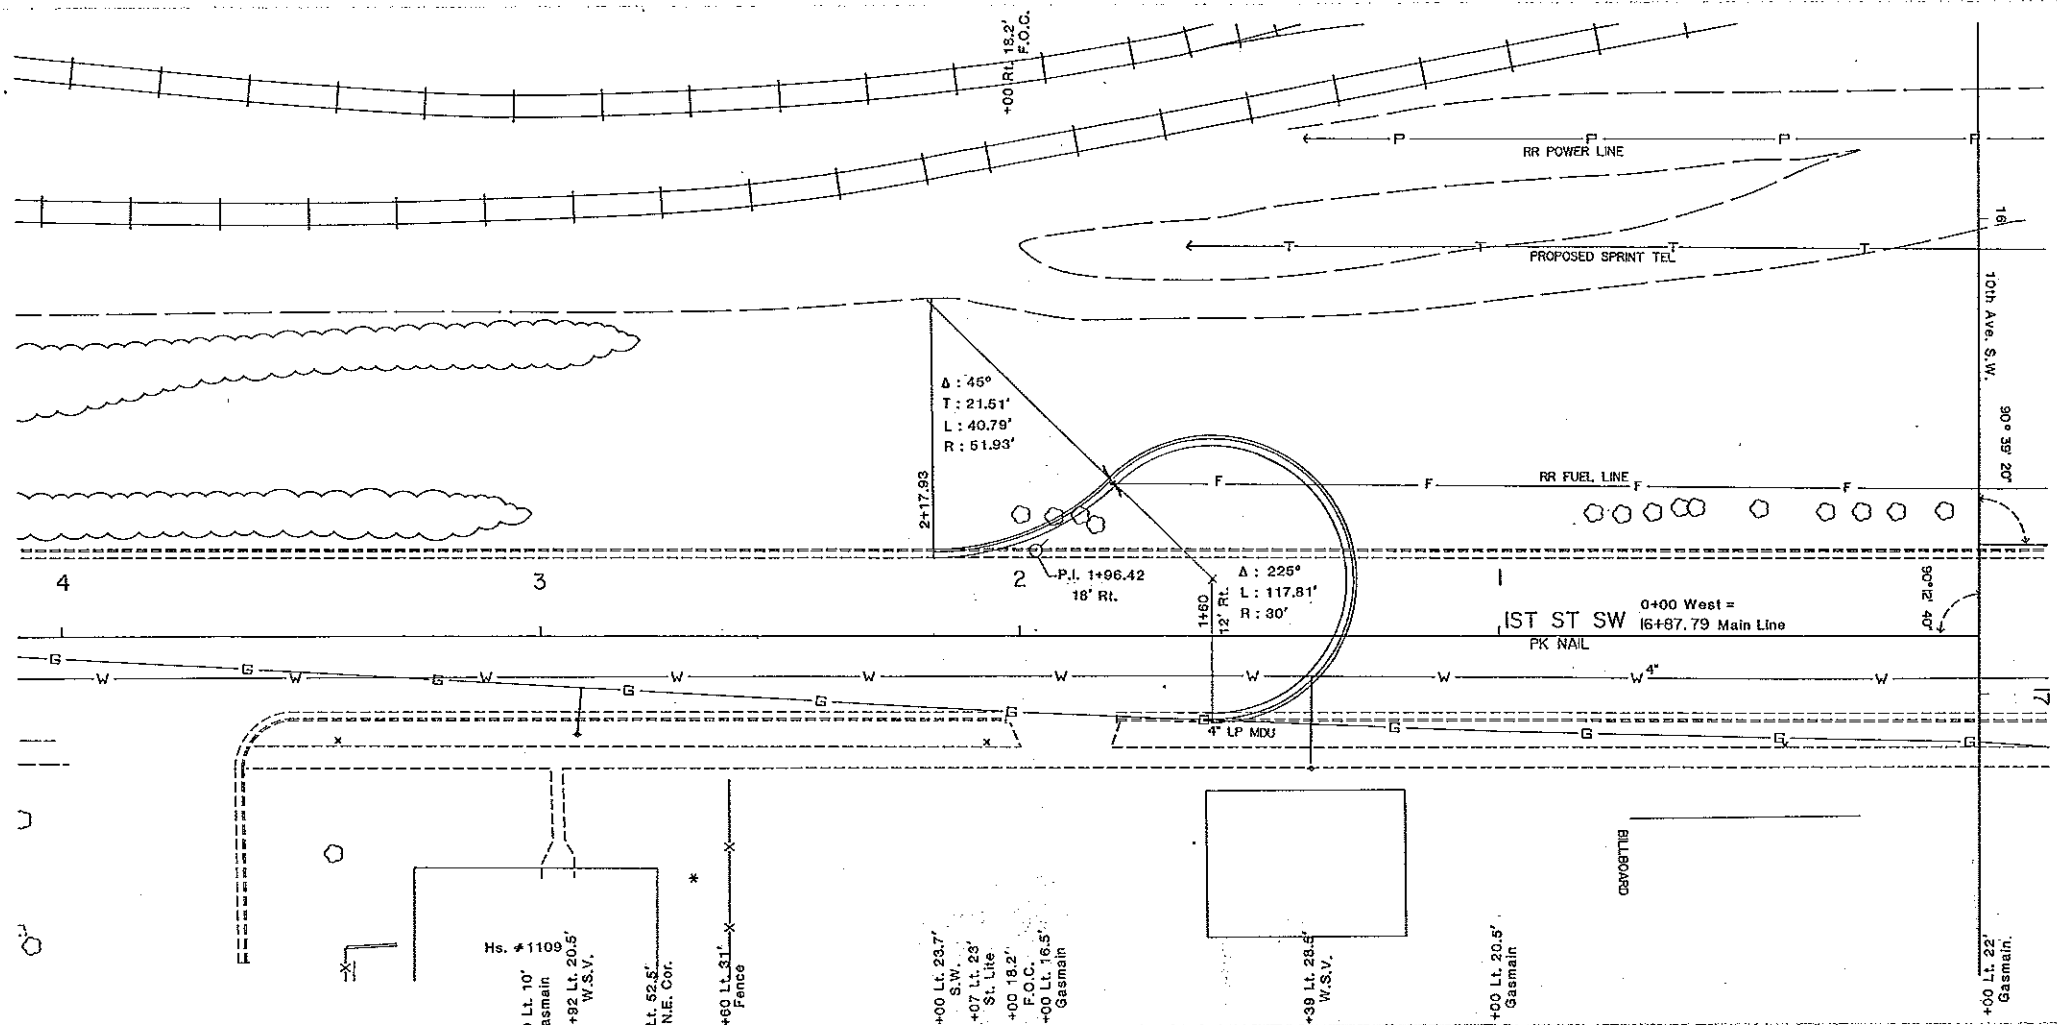

$\Delta: 45^\circ$   
 $T: 21.51'$   
 $L: 40.79'$   
 $R: 51.93'$

$\Delta: 225^\circ$   
 $L: 117.81'$   
 $R: 30'$

Hs. #1109.5'  
 +00 Lt. 10' Gasmain  
 +82 Lt. 20.5' W.S.V.  
 Lt. 52.5' N.E. Cor.


+00 Lt. 23.7' S.W.  
 +07 Lt. 23' St. Lite  
 +00 18.2' F.O.C.  
 +00 Lt. 16.5' Gasmain

+39 Lt. 28.5' W.S.V.

+00 Lt. 20.5' Gasmain

+00 Lt. 22' Gasmain

Gradients on New Curb & Gutter shall be established in the field as required to drain West.

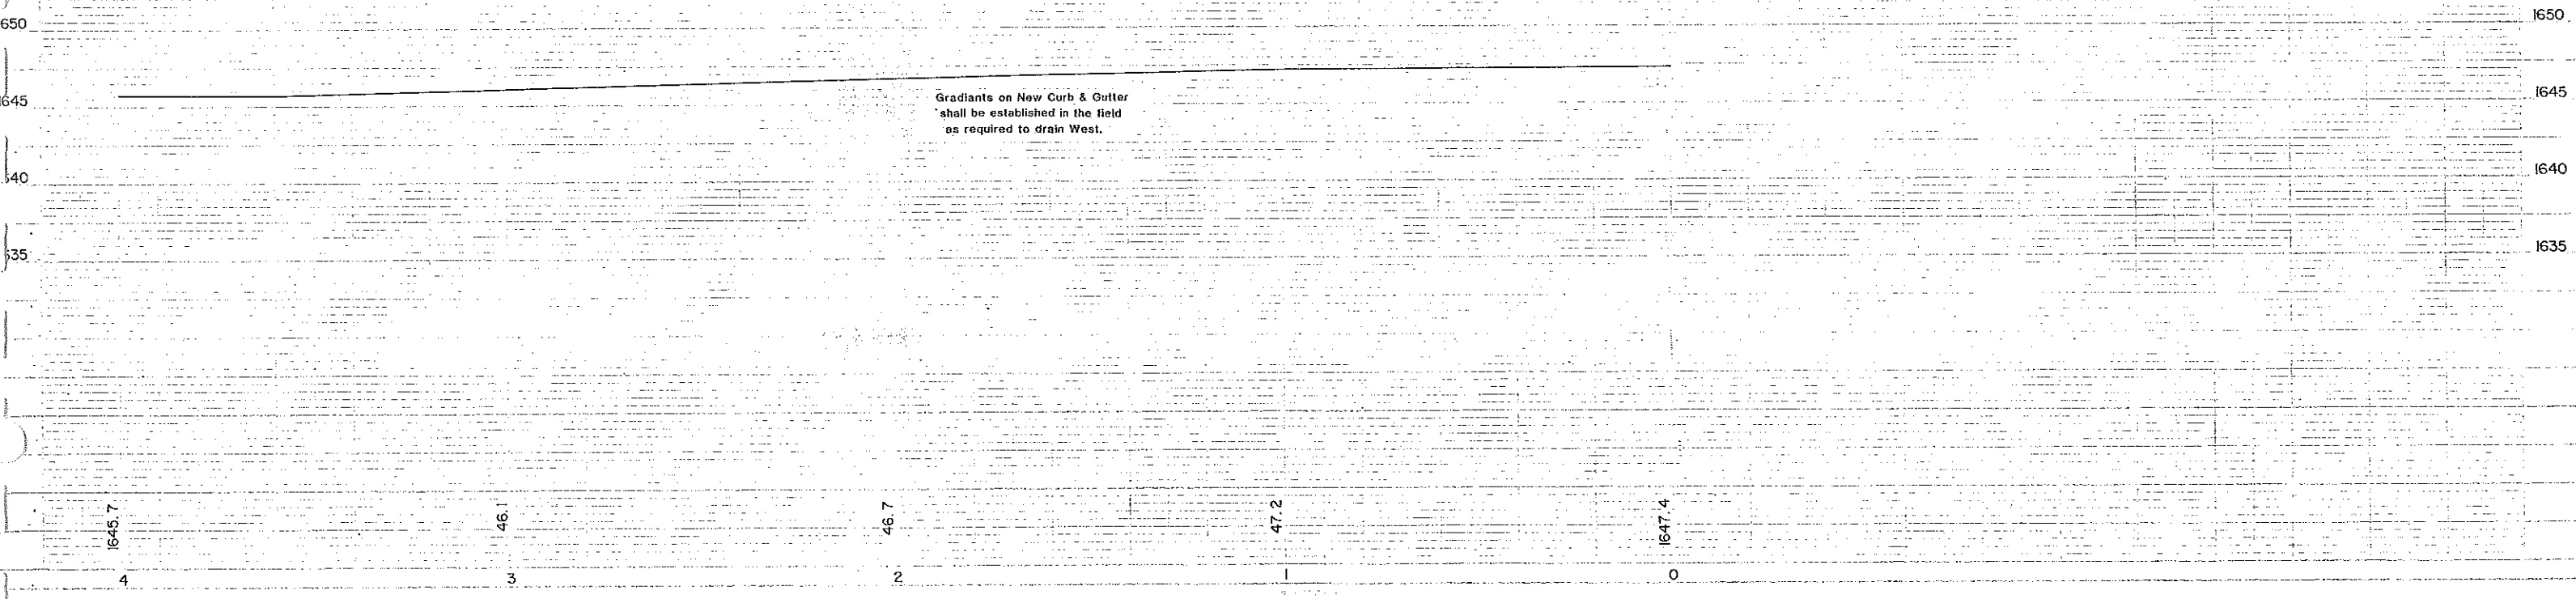


1645.7

146.1

146.7


147.2

1647.4

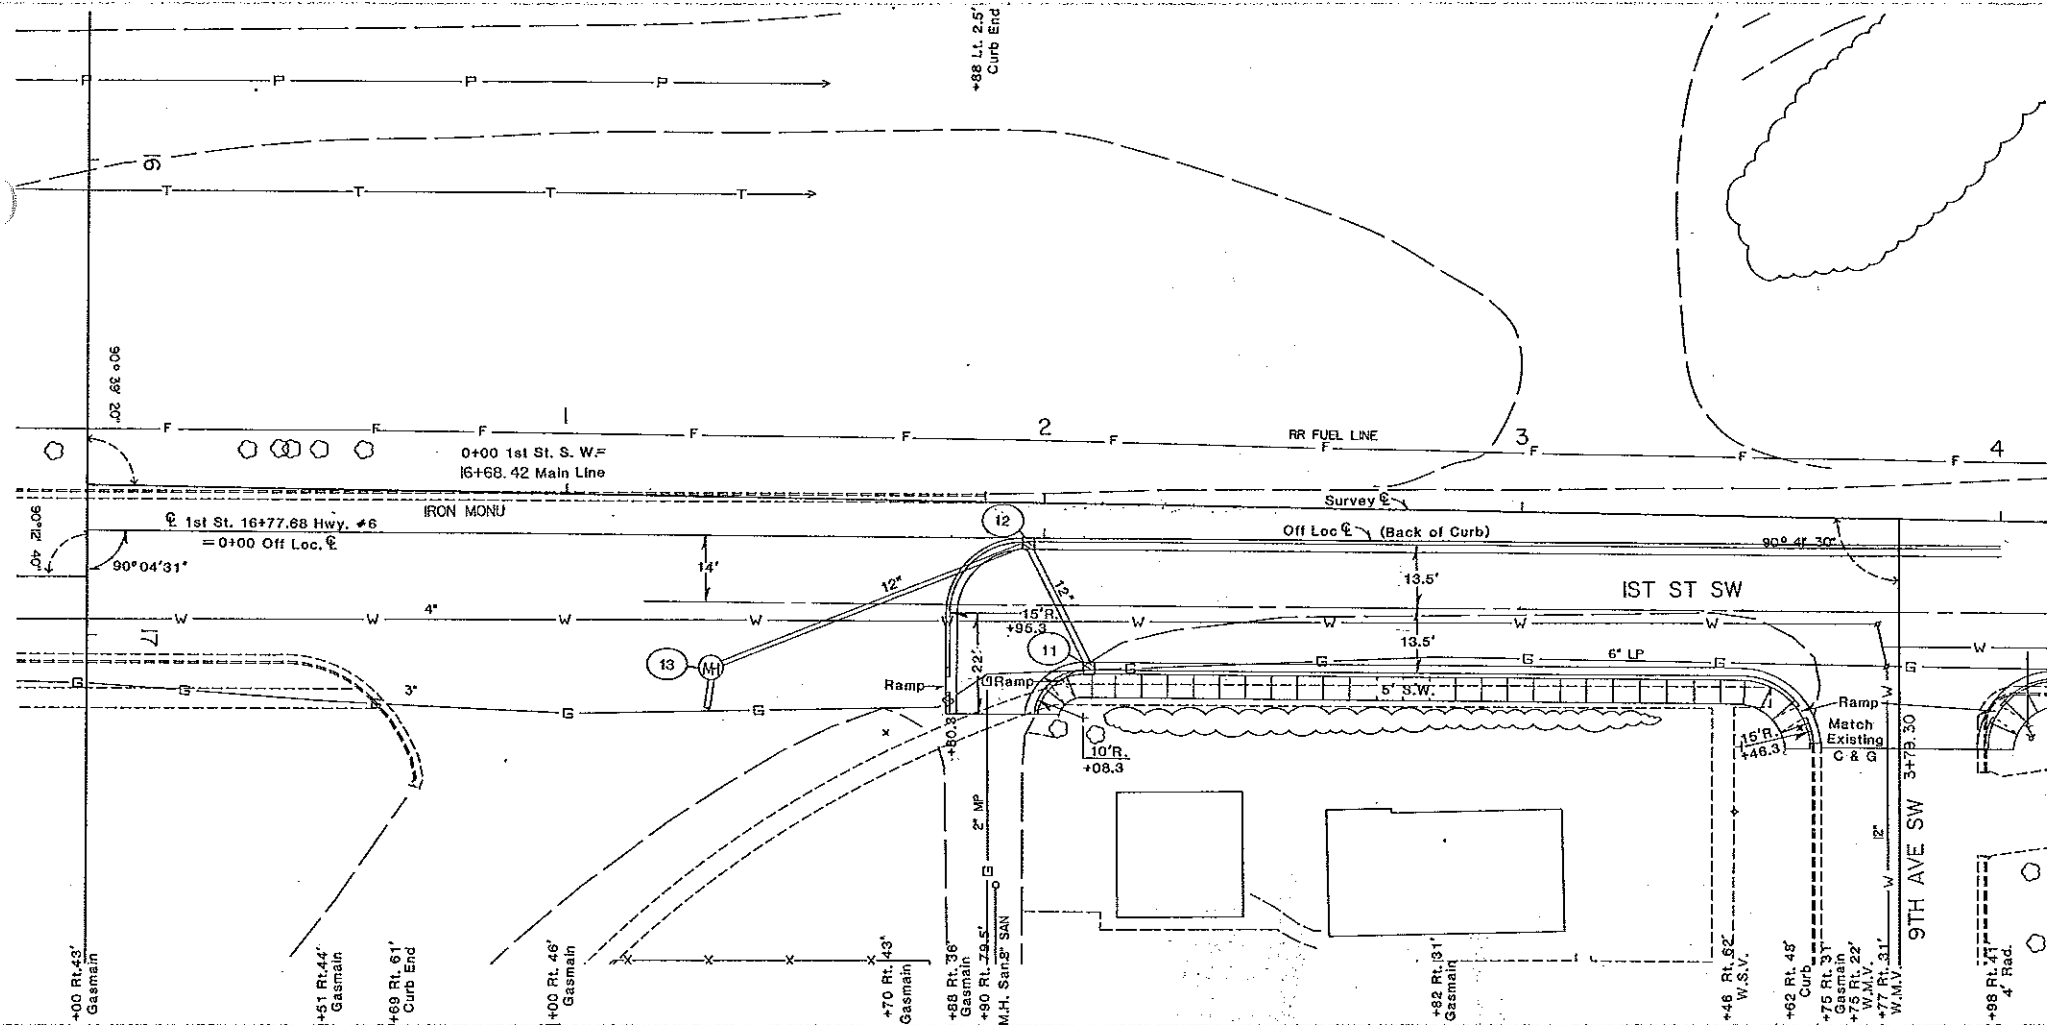

P.I. 1+81.8  $\phi$   
 (Edge of Gutter)  
 El. 1647.1  
 V.C. None

P.I. 3+79  $\phi$   
 El. 1648.6  
 V.C. 40'

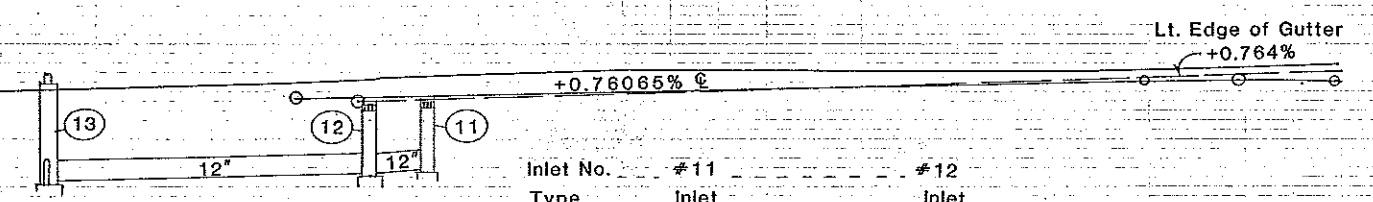



Lt. Edge of Gutter  
 P.I. 1+95.3  
 El. 1646.95  
 V.C. None



Inlet No.	#11	#12
Type	Inlet	Inlet
Station	2+09.3 Rt. Gutter	1+96.3 Lt. Gutter
Grate	1646.97	1646.87
Base	1643.28	1643.08
Invert	1643.45	1643.25
Outlet	1643.25	1642.79
"H"	3.1'	3.2'



FED. DIST. REGION	STATE	FED. AID PROJ. NO.	SHEET NO.
8	N.D.		


P.I. 4+56.14  
P.I. 5+27.77  
A : 4°  
D : 6°  
T : 33.36'  
L : 66.67'  
R : 955.37'

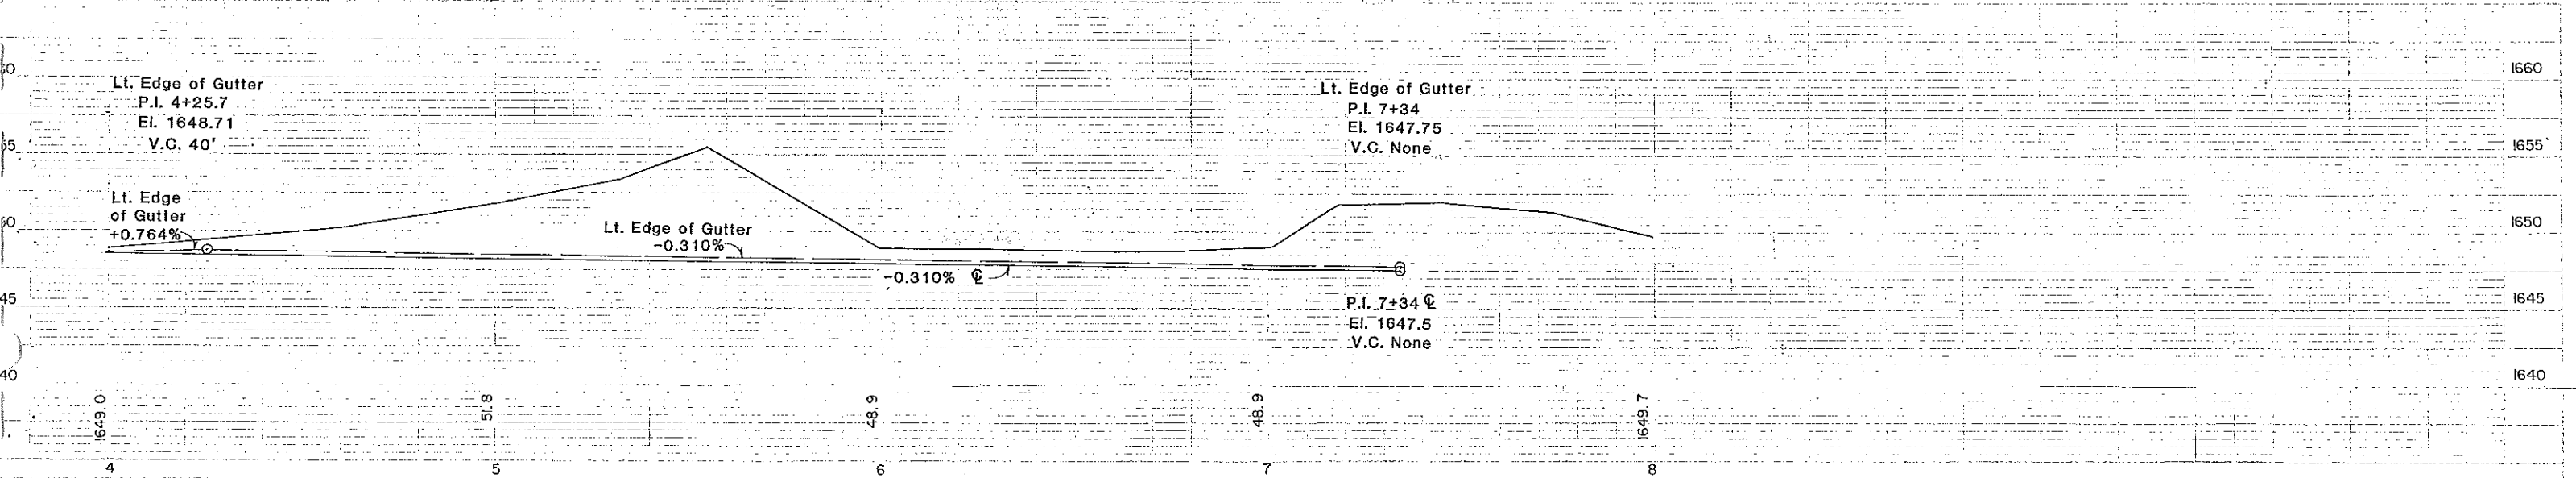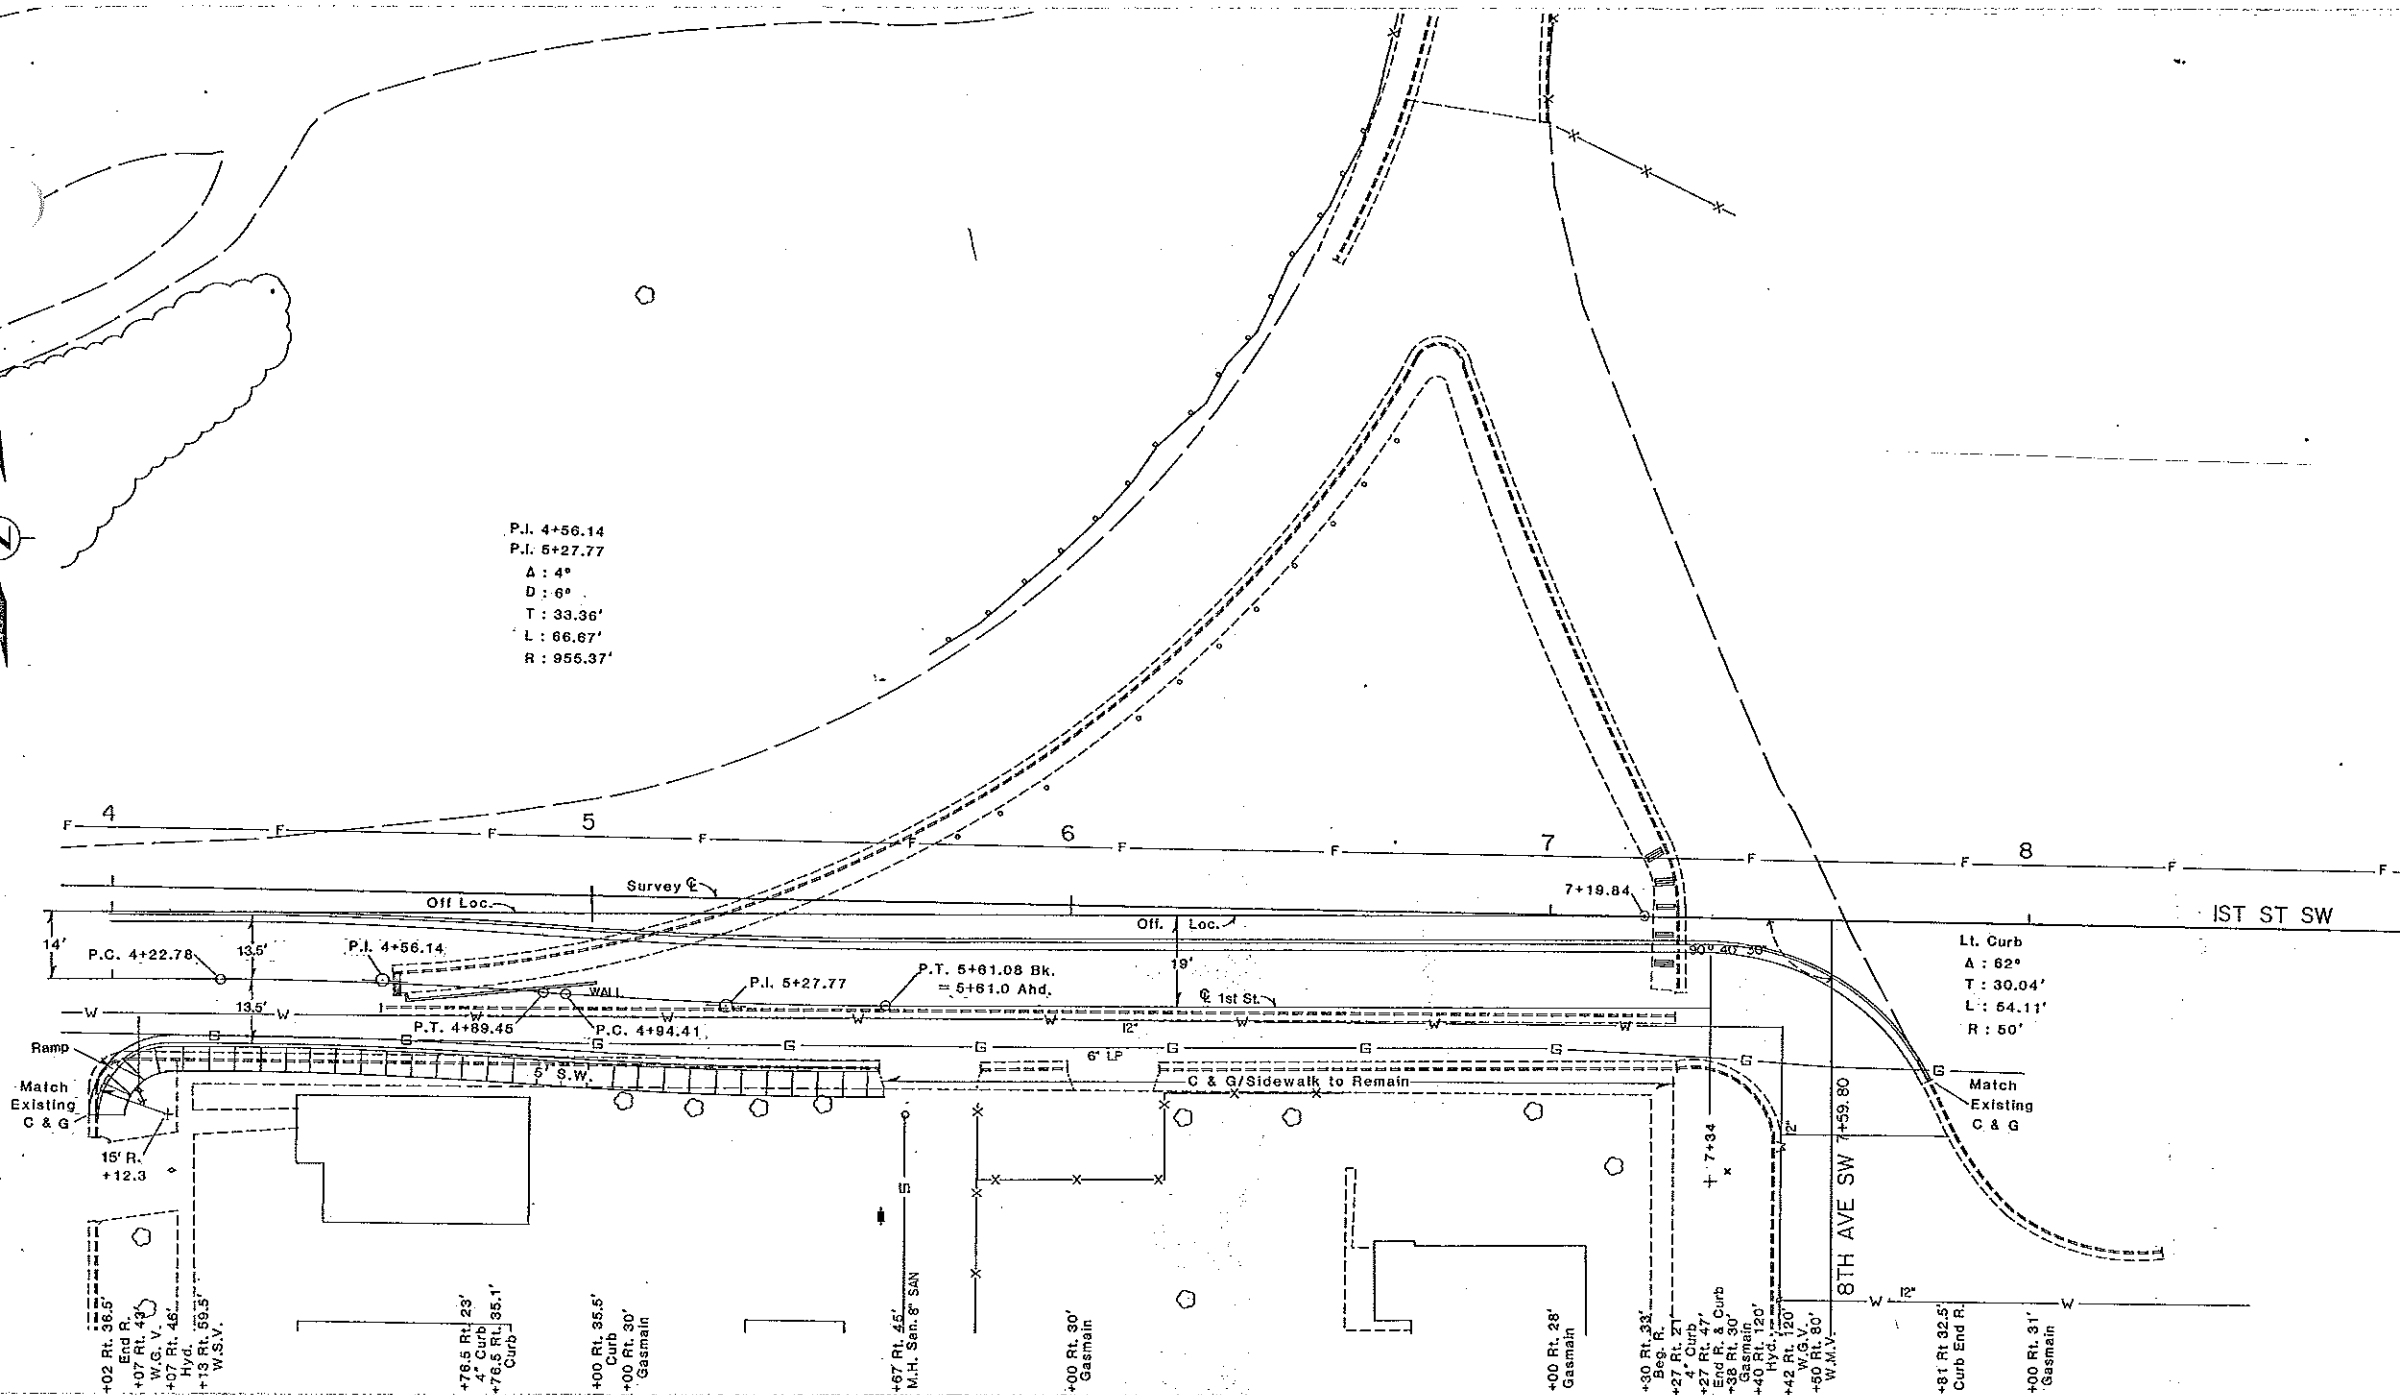

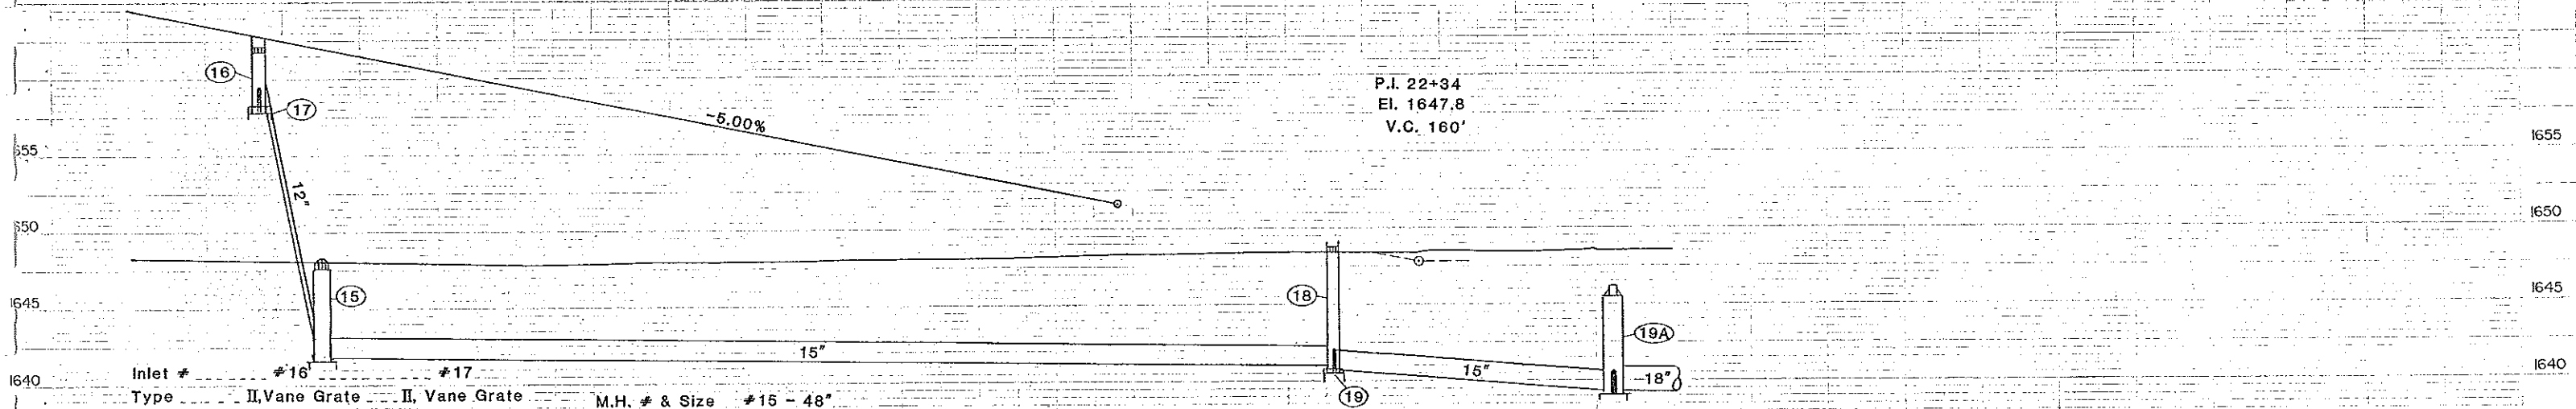
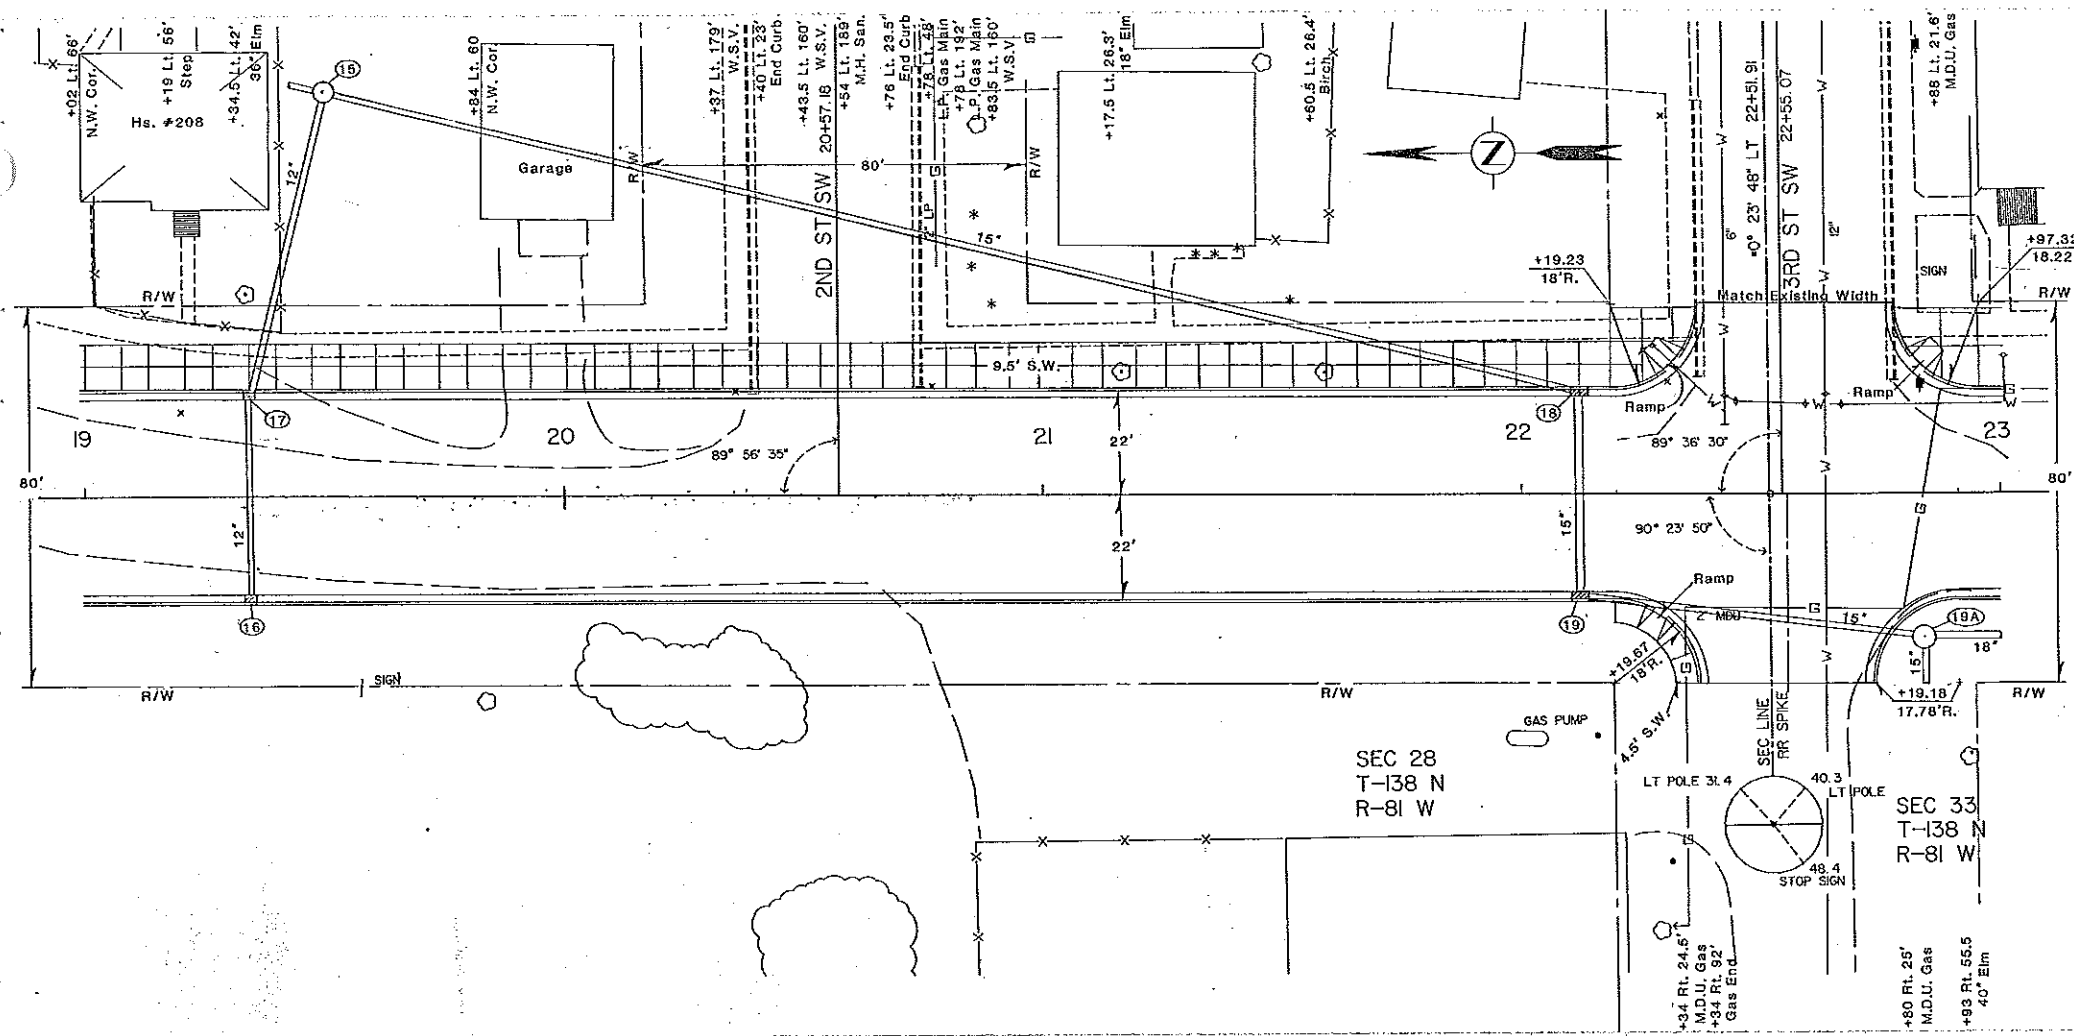


Inlet #	Type	Station	Grate	Base	Invert	Outlet	"H"	M.H. # & Size	Station	Top	Base	Invert	Outlet	Riser	Inlet #	Type	Station	Grate	Base	Invert	Outlet	"H"	M.H. # & Size	Station	Top	Base	Invert	Outlet	Riser								
#16	II, Vane Grate	19+34 Rt.	1662.19	1658.26	1658.43	1658.03	3.6'	#15 - 48"	19+50 Lt. 85'	1648.3 (Bee Hive Top)	1641.6	1641.79	1641.02	4.7'	#18	II, Vane Grate	22+12 Lt.	1648.86	1640.83	1641.02	1640.72	7.7'	#19	II, Vane Grate	22+12 Rt.	1648.86	1640.53	1640.72	8.0'	#19A - 60"	II, Vane Grate	22+83.9 Rt. 30'	1646.2	1639.1	1639.31	1639.21	5.35'



FHWA REGION	STATE	FED. AID PROJ. NO.	SHEET NO.
8	N. D.		

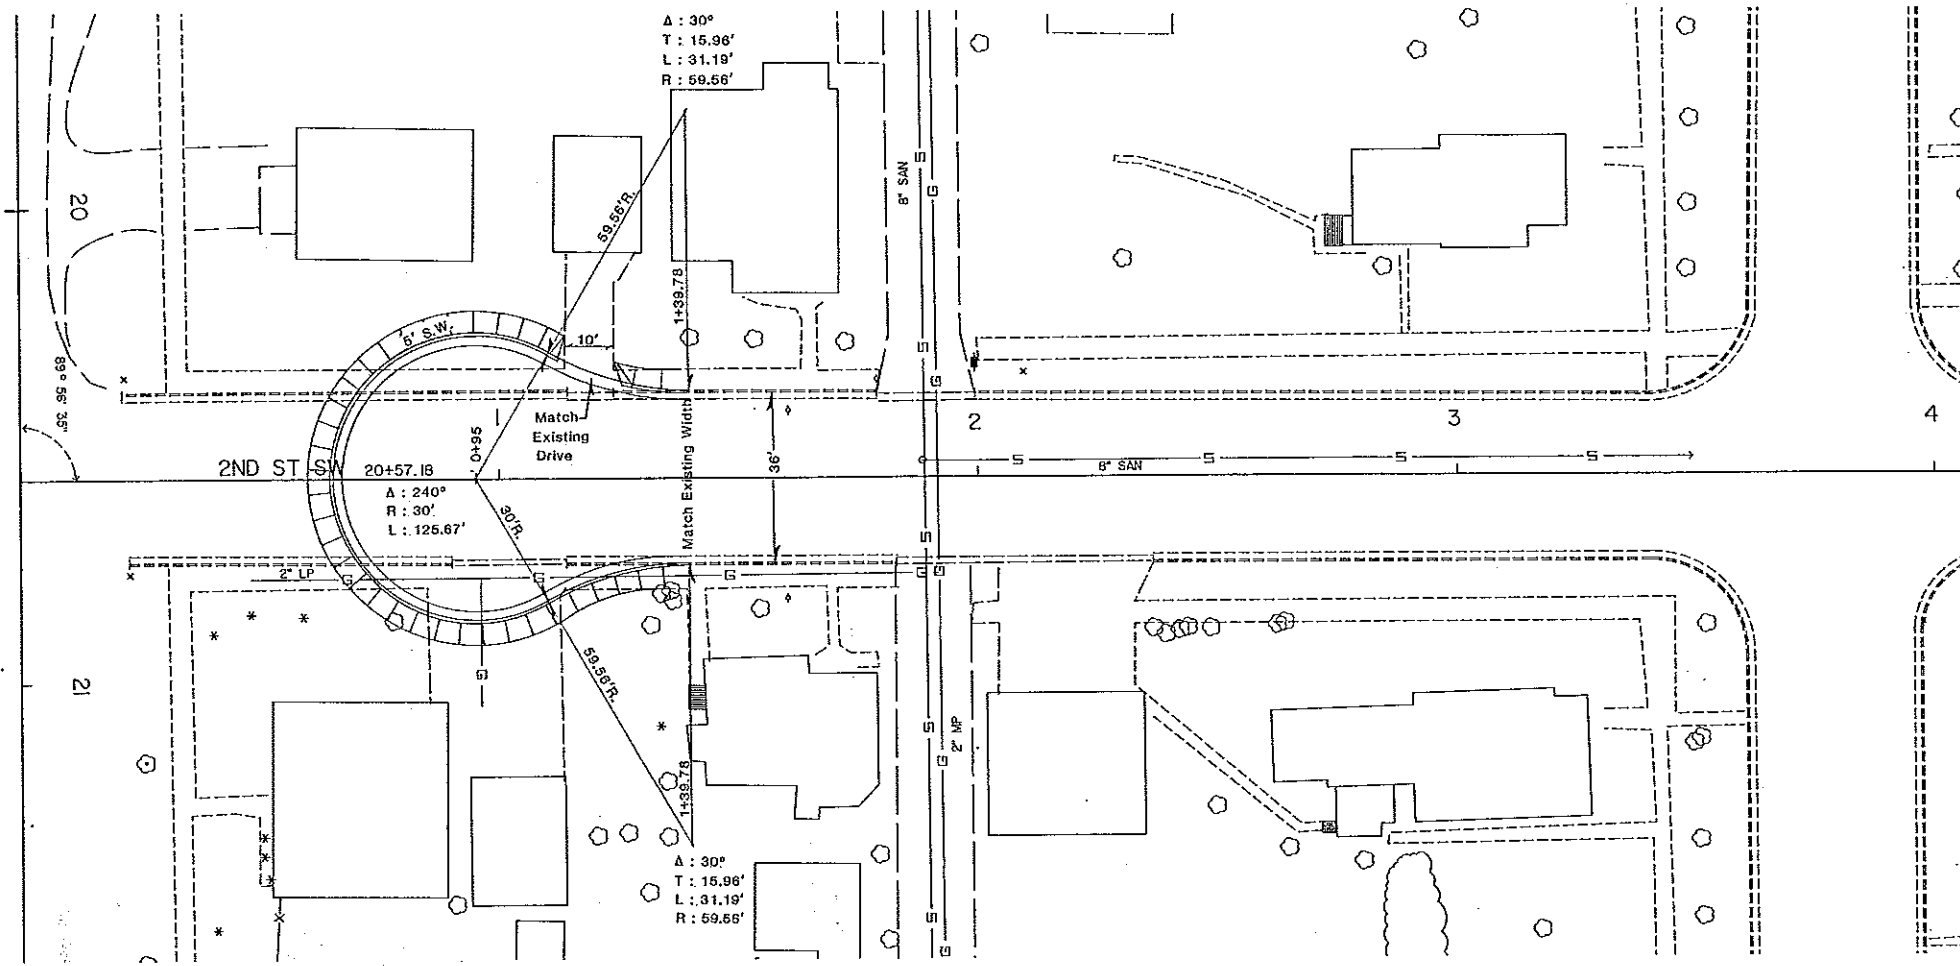




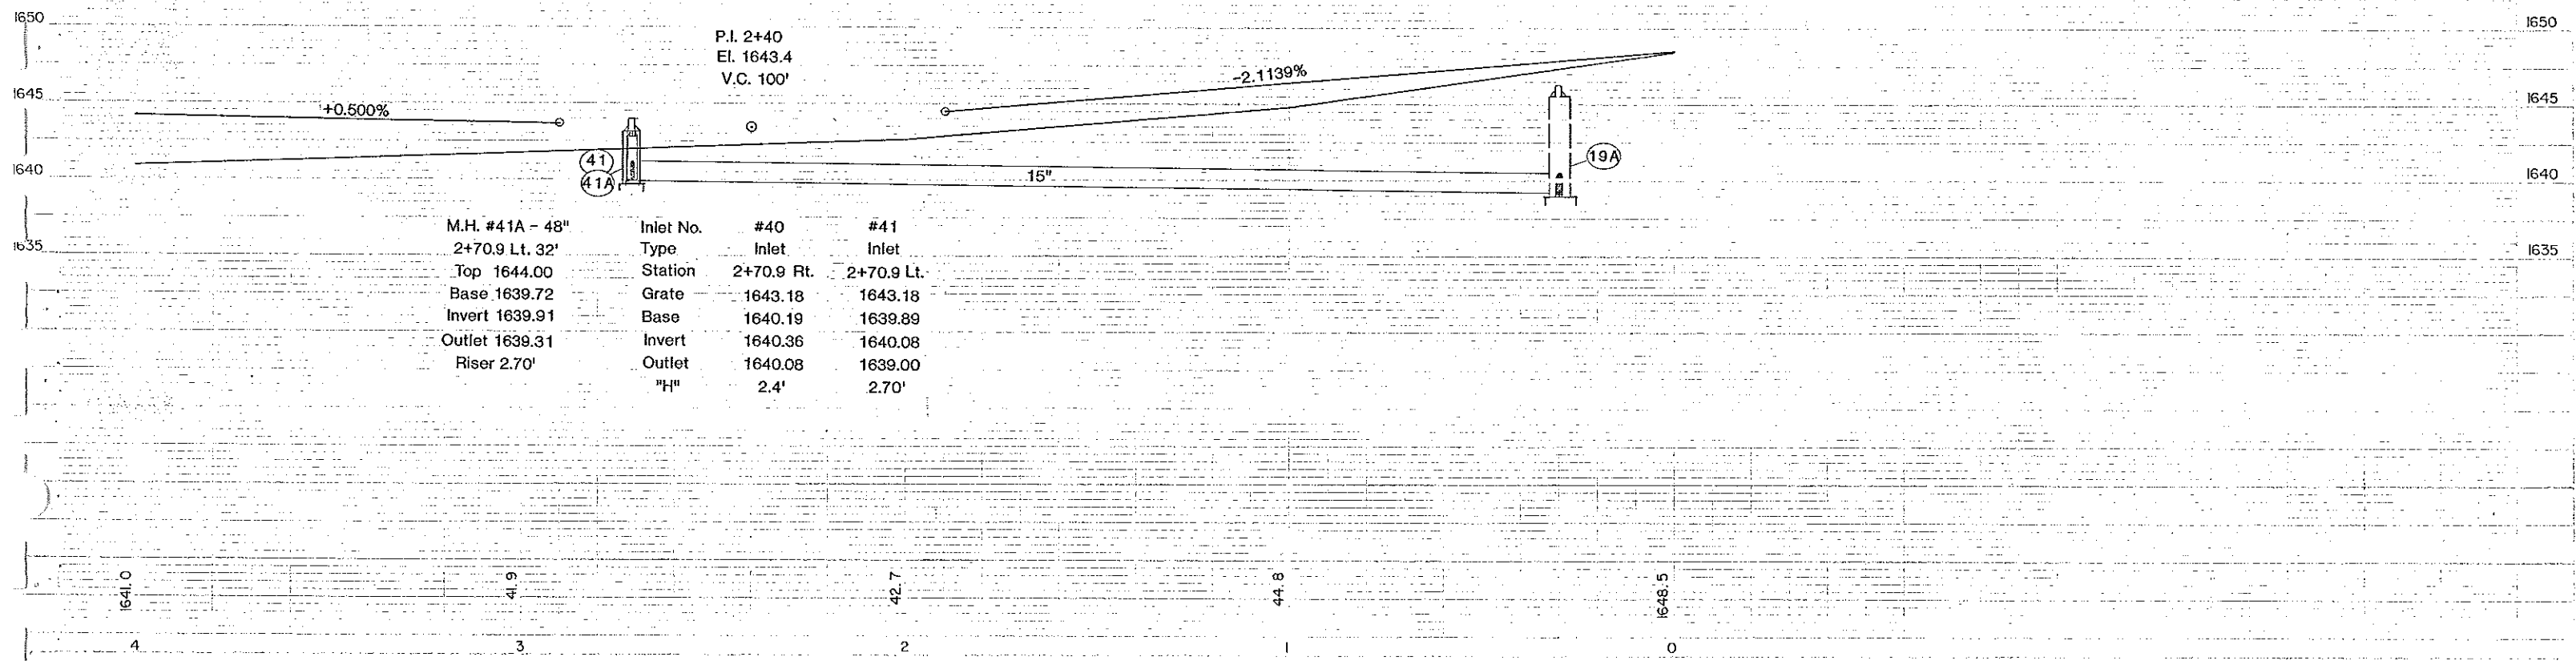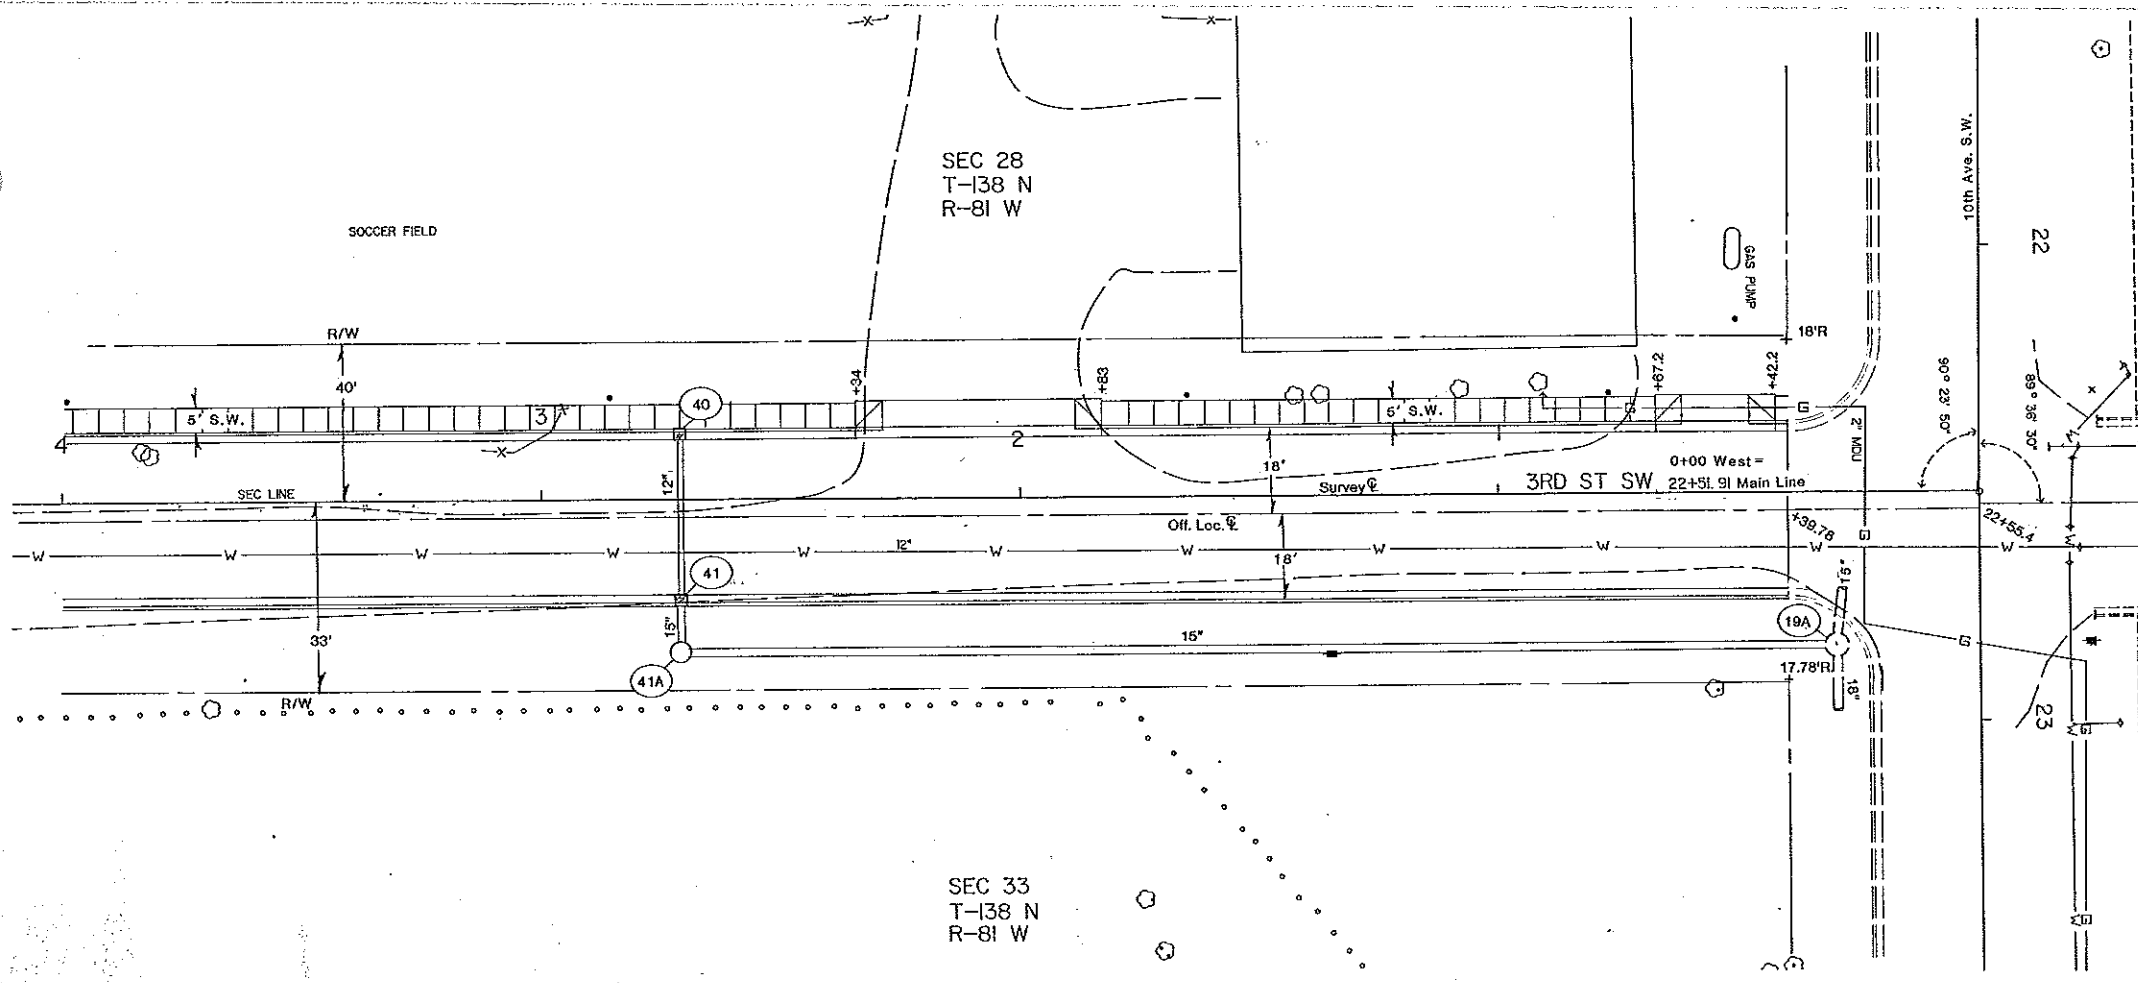


FHWA REGION	STATE	FED. AID PROJ. NO.	SHEET NO.
8	N.D.		

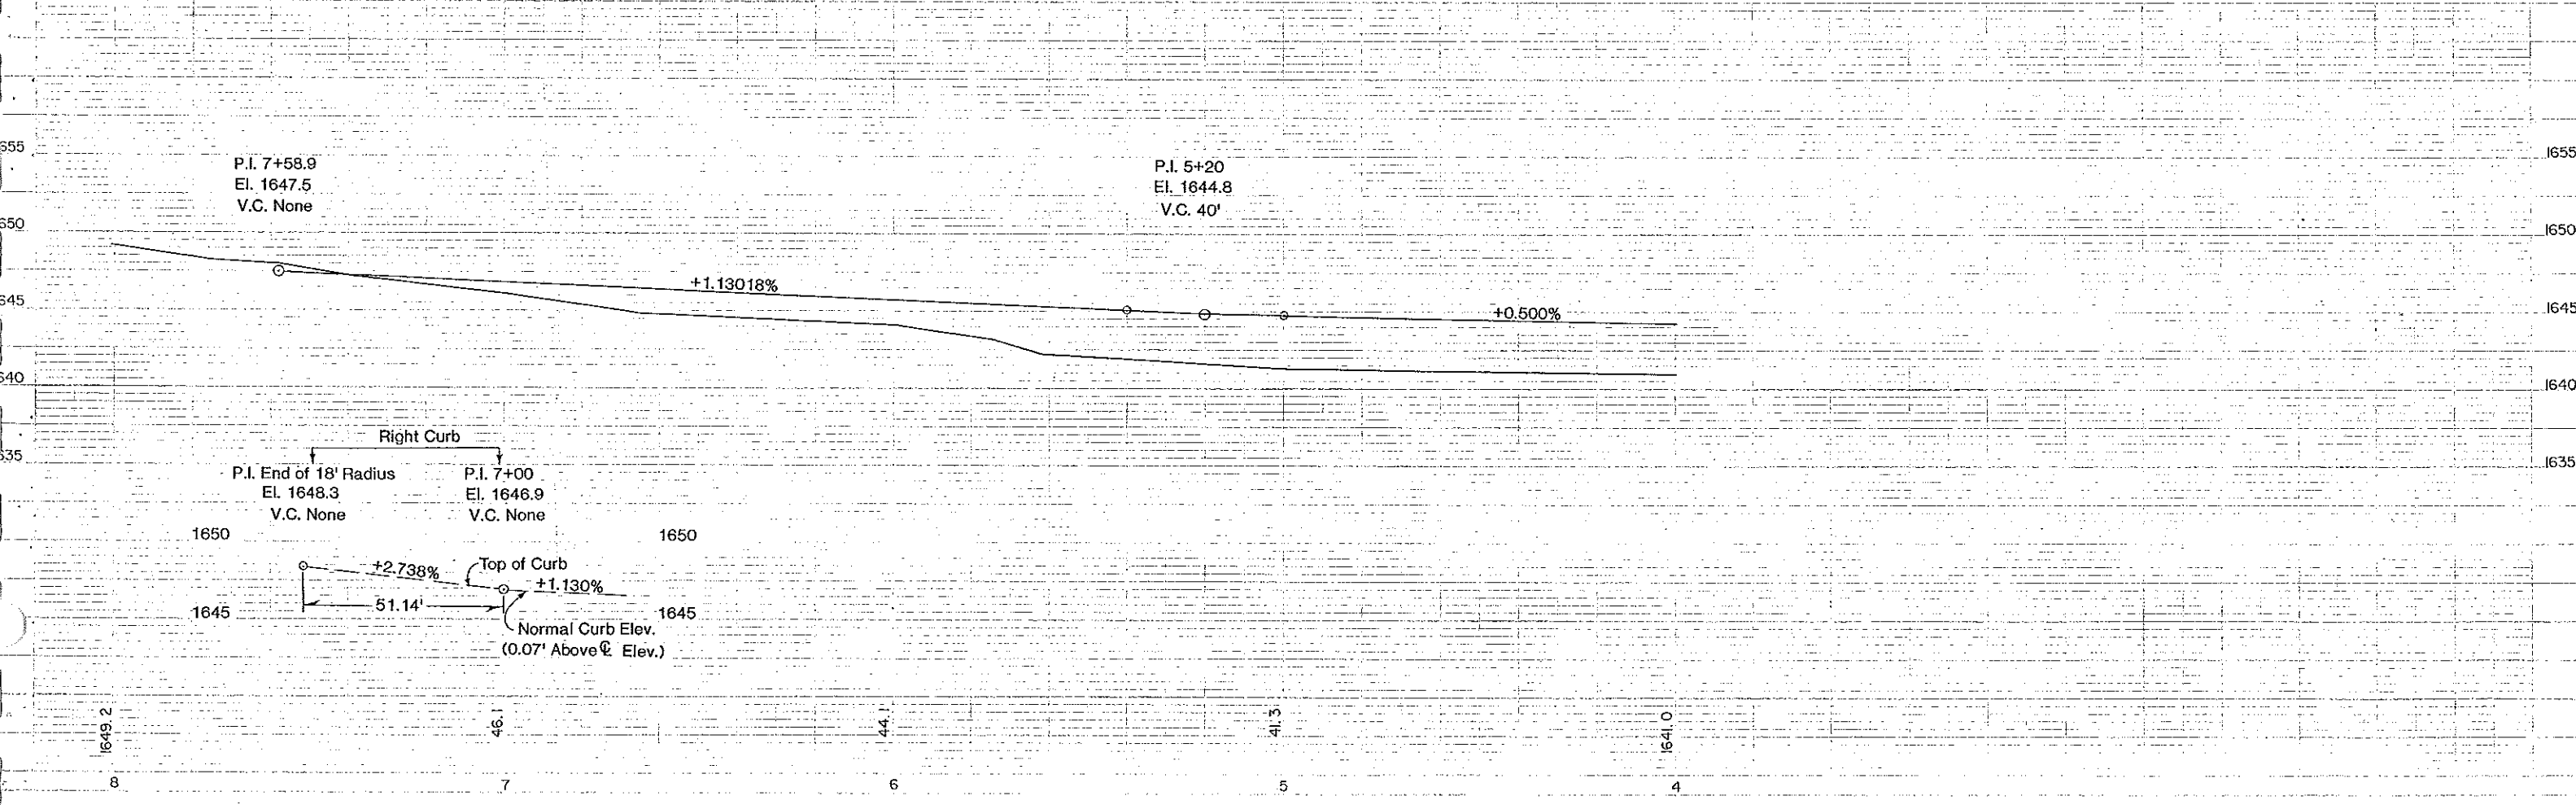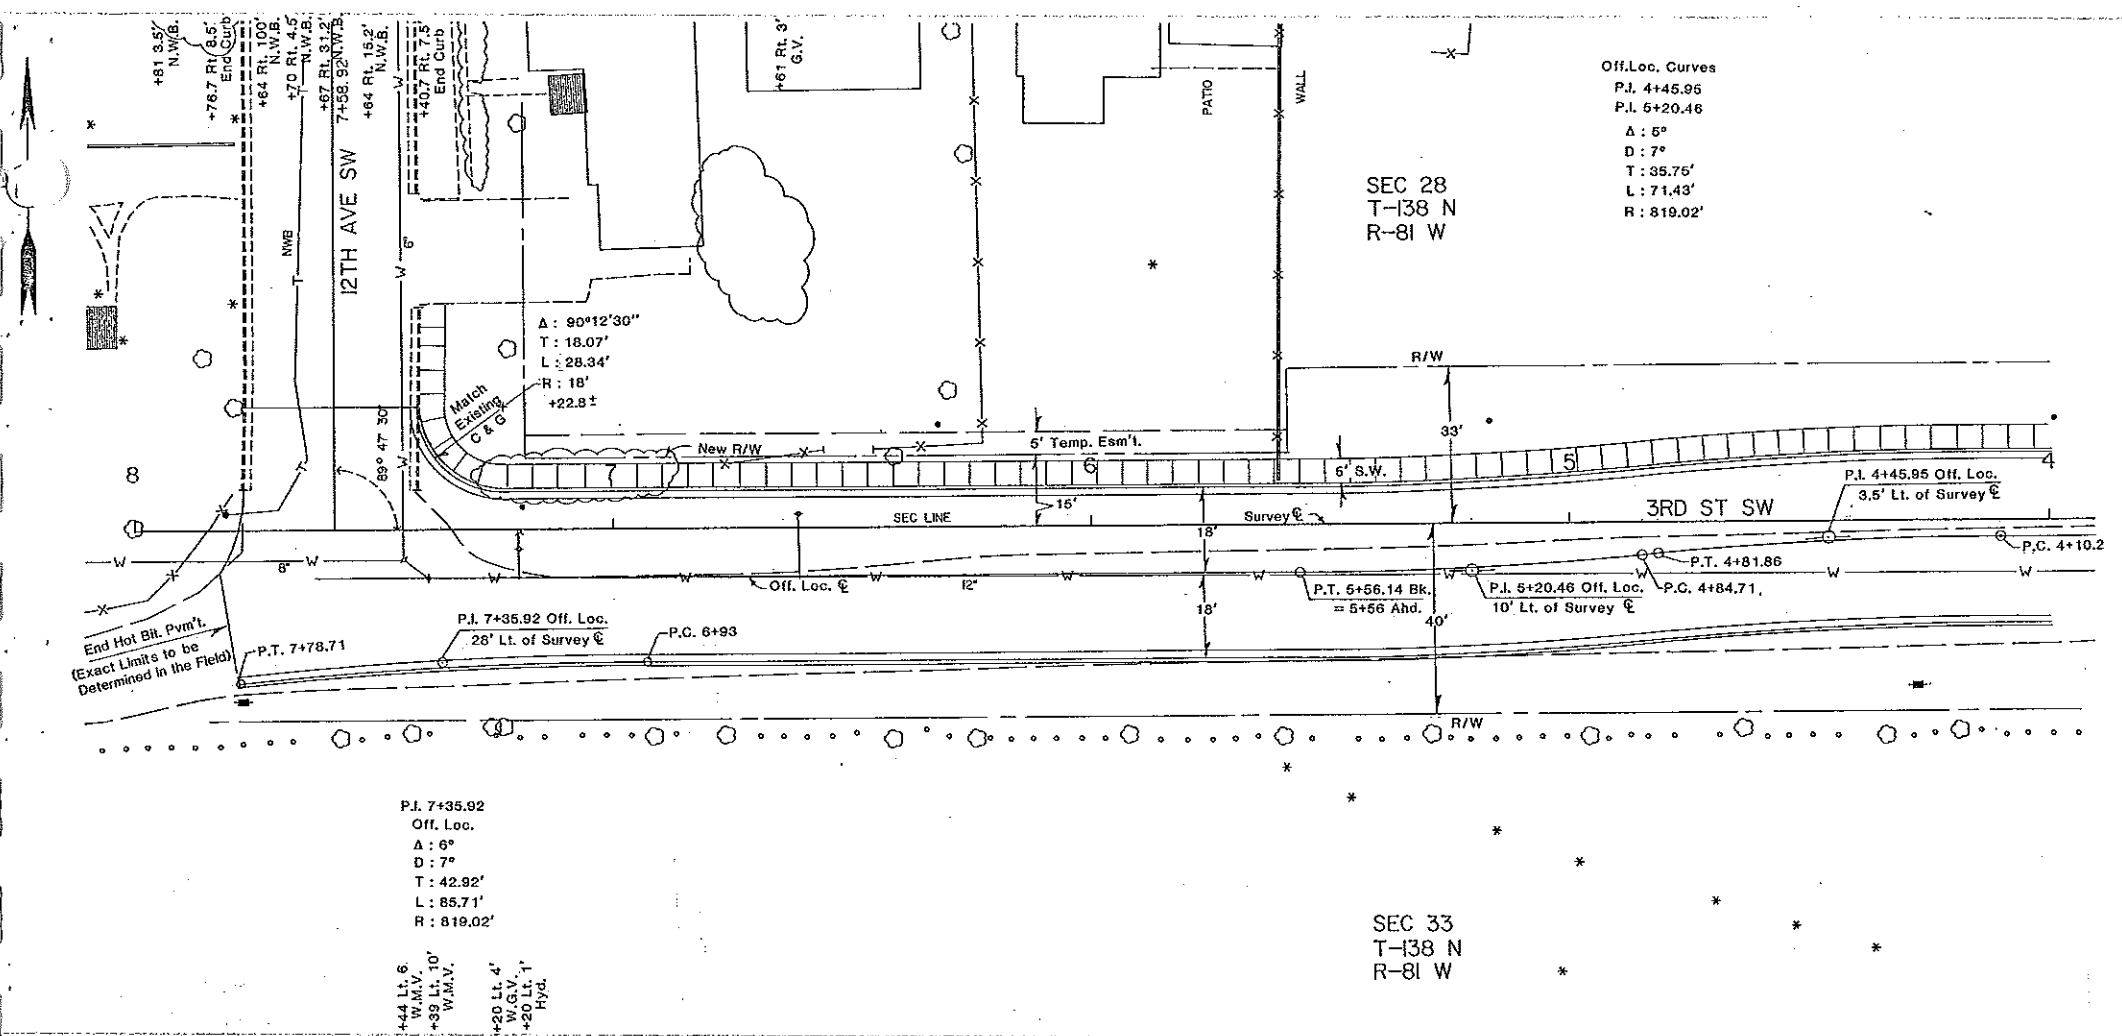

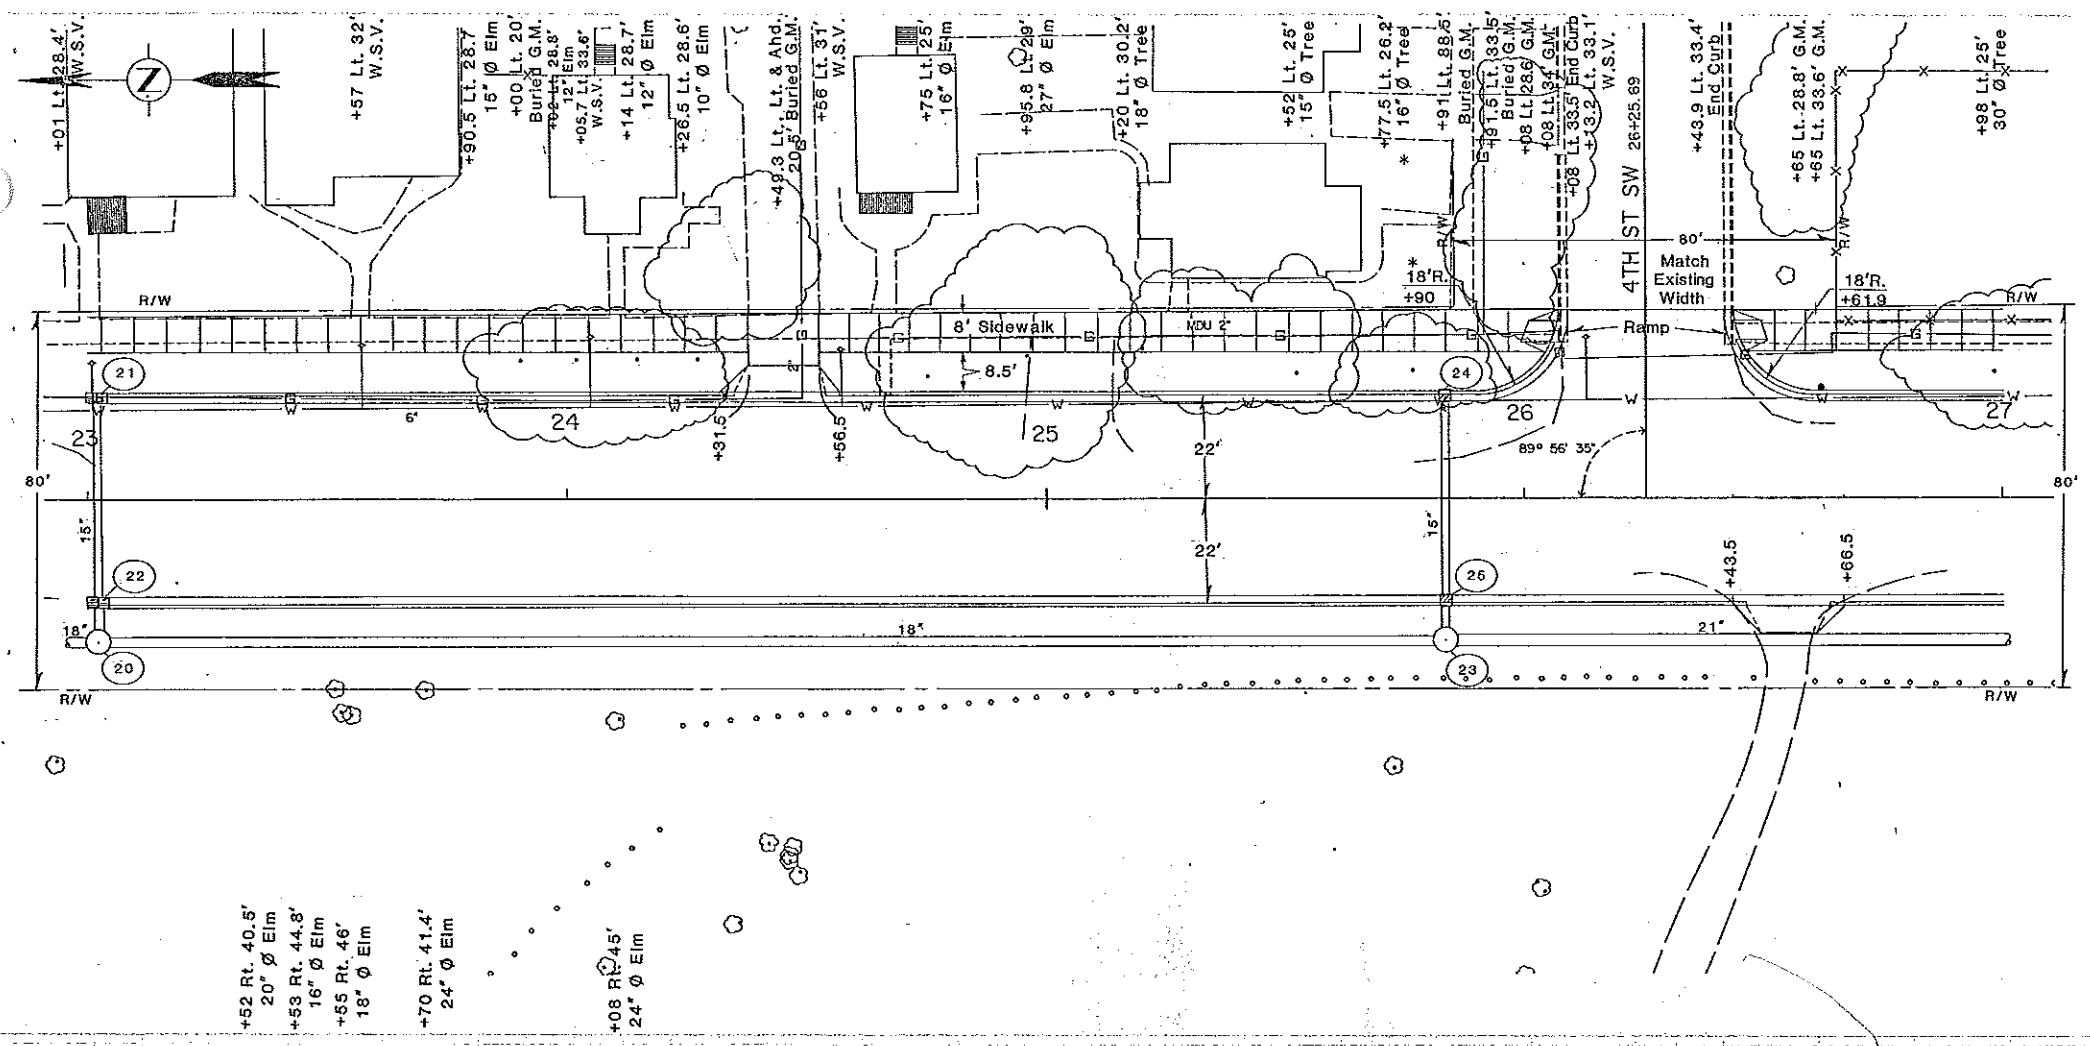

P.I. 24+75  
 El. 1648.8  
 V.C. 40'

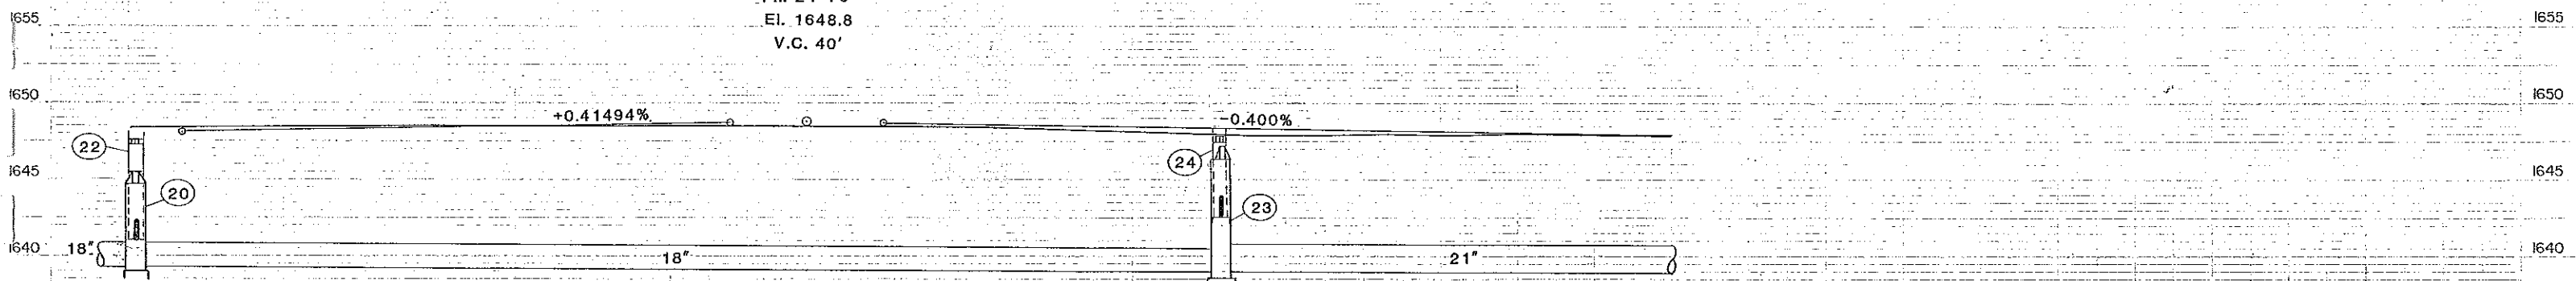


Inlet No.	#21	#22	M.H. #20 - 60"
Type	Double	Double	23+02 Rt. 30'
Station	23+02 Lt.	23+02 Rt.	Top 1645.5
Grate	1647.6	1647.6	Base 1639.0
Base	1642.14	1641.14	Invert 1639.21
Invert	1642.33	1641.33	Outlet 1638.52
Outlet	1641.33	1641.0	Riser 4.75'
"H"	5.0'	6.0'	

Inlet No.	#24	#25	M.H. #23 - 60"
Type	Inlet, Vane Grate	Inlet, Vane Grate	25+83 Rt. 30'
Station	25+83 Lt.	25+83 Rt.	Top 1647.2
Grate	1647.86	1647.86	Base 1638.29
Base	1643.27	1642.77	Invert 1638.52
Invert	1643.46	1642.96	Outlet 1637.67
Outlet	1642.96	1642.6	Riser 7.16'
"H"	4.0'	4.5'	

1648.5      48.6      48.5      47.9      1647.8


23      24      25      26      27

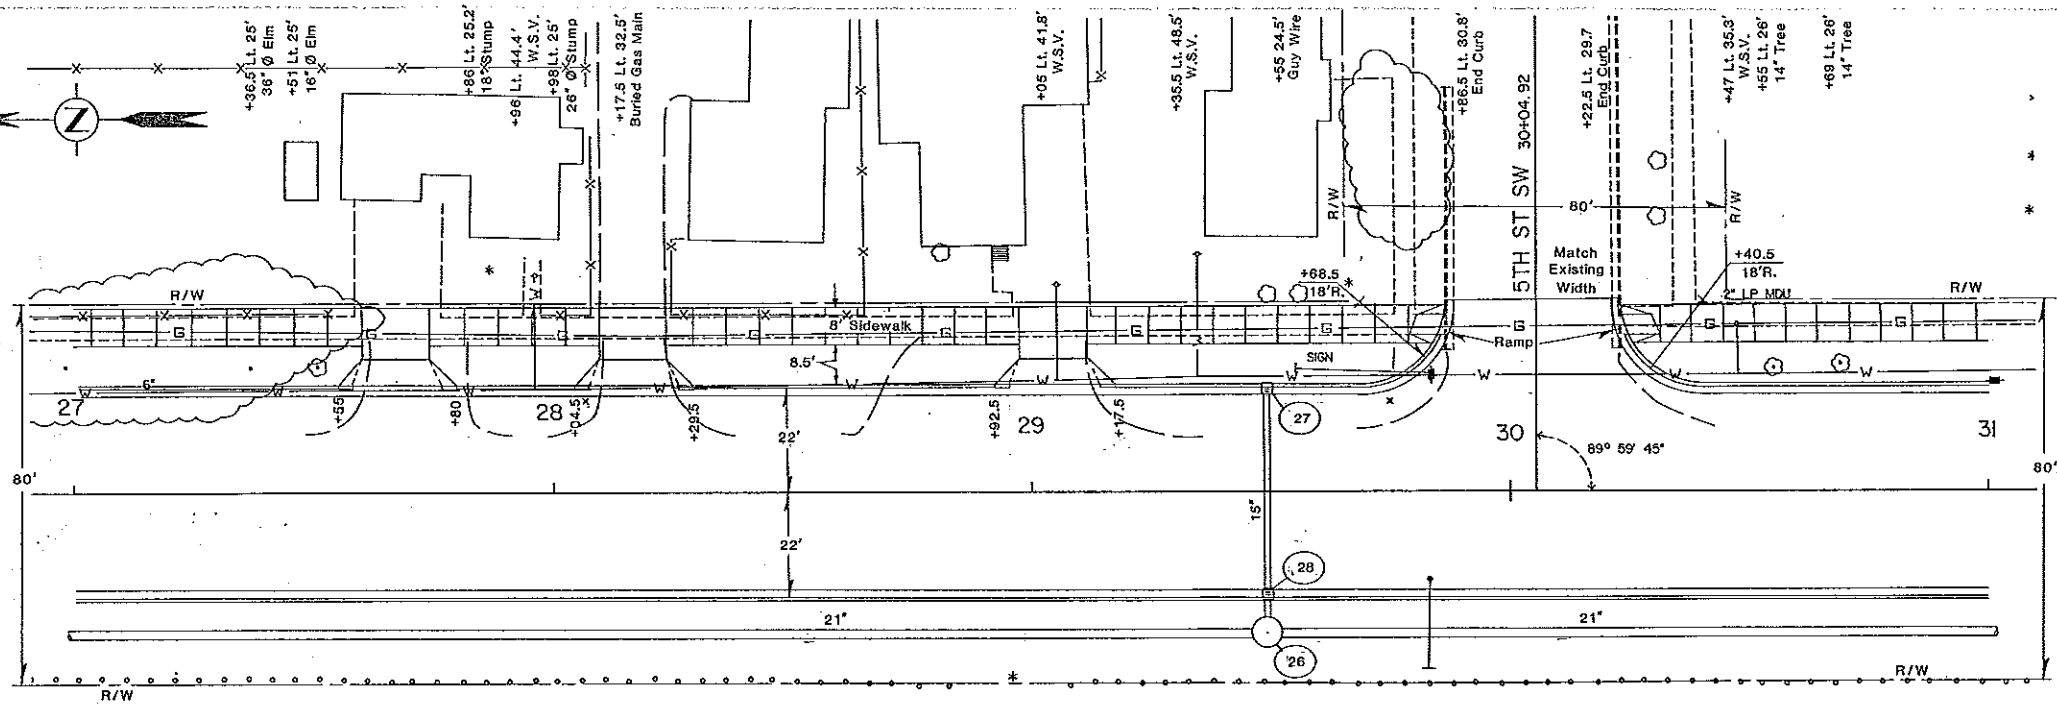


+55.39.4' 18" Spruce  
 +82.4 Rt. 36' Guy Wire  
 +82.4 Rt. 37' Guy Wire

P.I. 29+50  
 El. 1646.9  
 V.C. 40'

P.I. 30+40  
 El. 1647.3  
 V.C. 40'

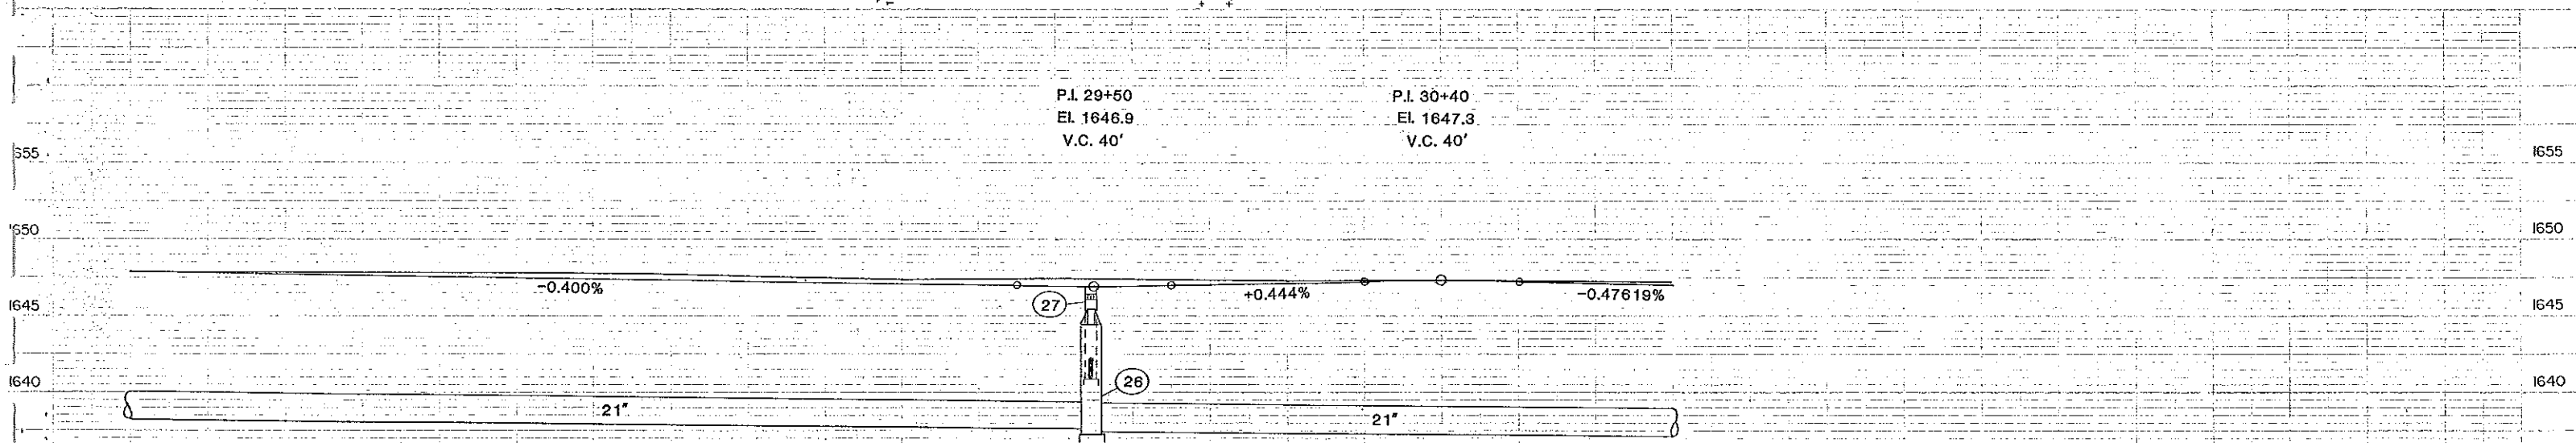


M.H. #26 - 60"	Inlet No.	#27	#28
29+49 Rt. 30'	Type	Single	Single
Top 16465.4	Station	29+49 Lt.	29+49 Rt.
Base 1637.25	Grate	1646.43	1646.43
Invert 1637.48	Base	1641.84	1641.04
Outlet 1636.74	Invert	1642.03	1641.23
Riser 6.4'	Outlet	1641.23	1640.9
	"H"	4.0'	4.8'

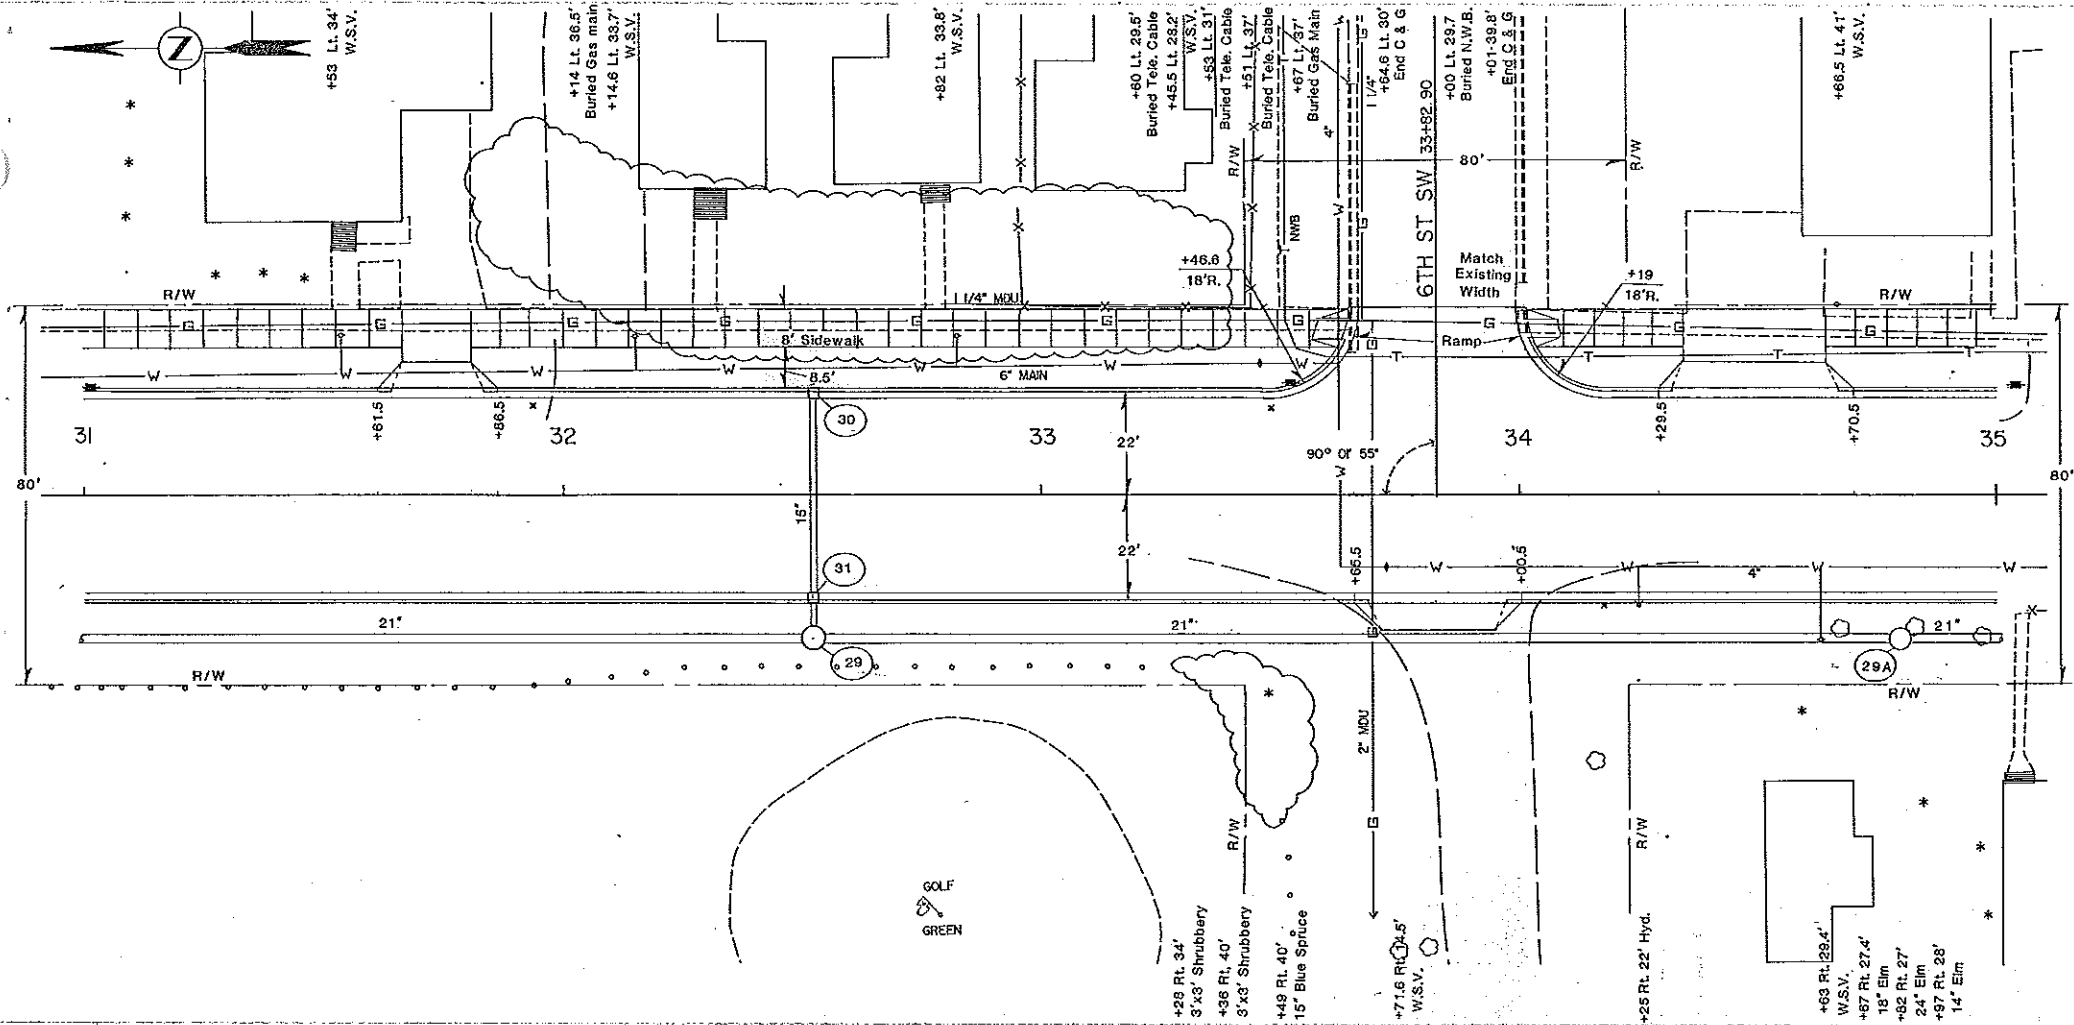


P.I. 32+50  
El. 1646.3  
V.C. 40'

P.I. 34+50  
El. 1647.1  
V.C. 60'

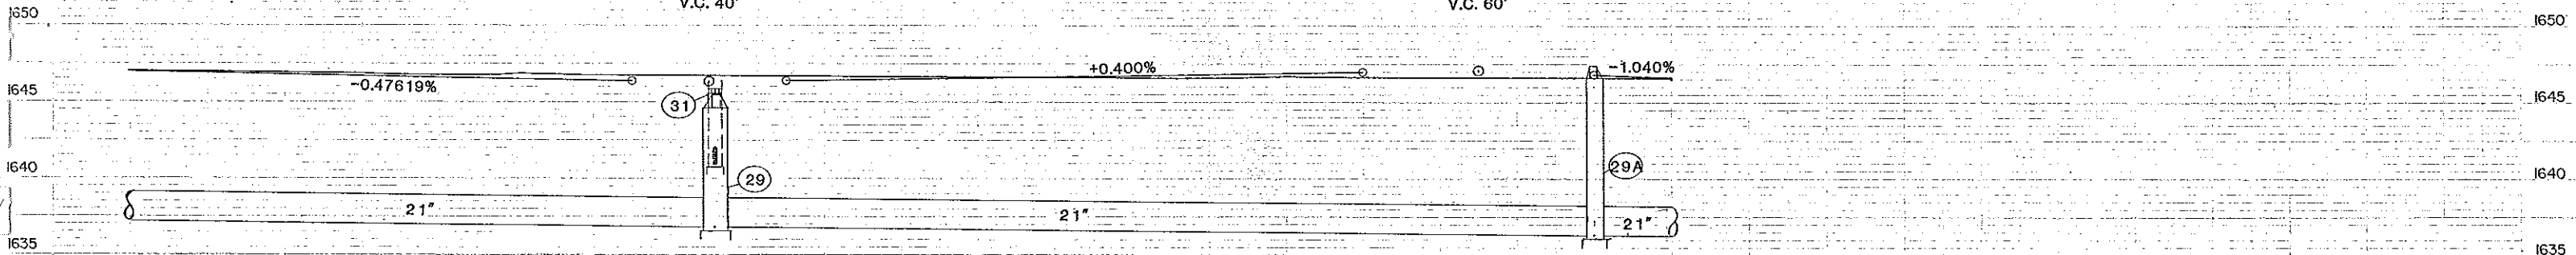


Inlet No.	#30	#31	M.H. No. - Size	#29 - 60"	#29A - 48"
Type	Single	Single	Station	32+52 Rt. 30'	34+80 Rt. 30'
Station	32+52 Lt.	32+52 Rt.	Top	1645.46	1647.40
Grate	1645.83	1645.83	Base	1636.651	1636.01
Base	1641.24	1640.74	Invert	1636.74	1636.24
Invert	1641.43	1640.93	Outlet	1636.24	1635.74
Outlet	1640.93	1640.6	Riser	7.2'	9.81'
"H"	4.0'	4.5'			



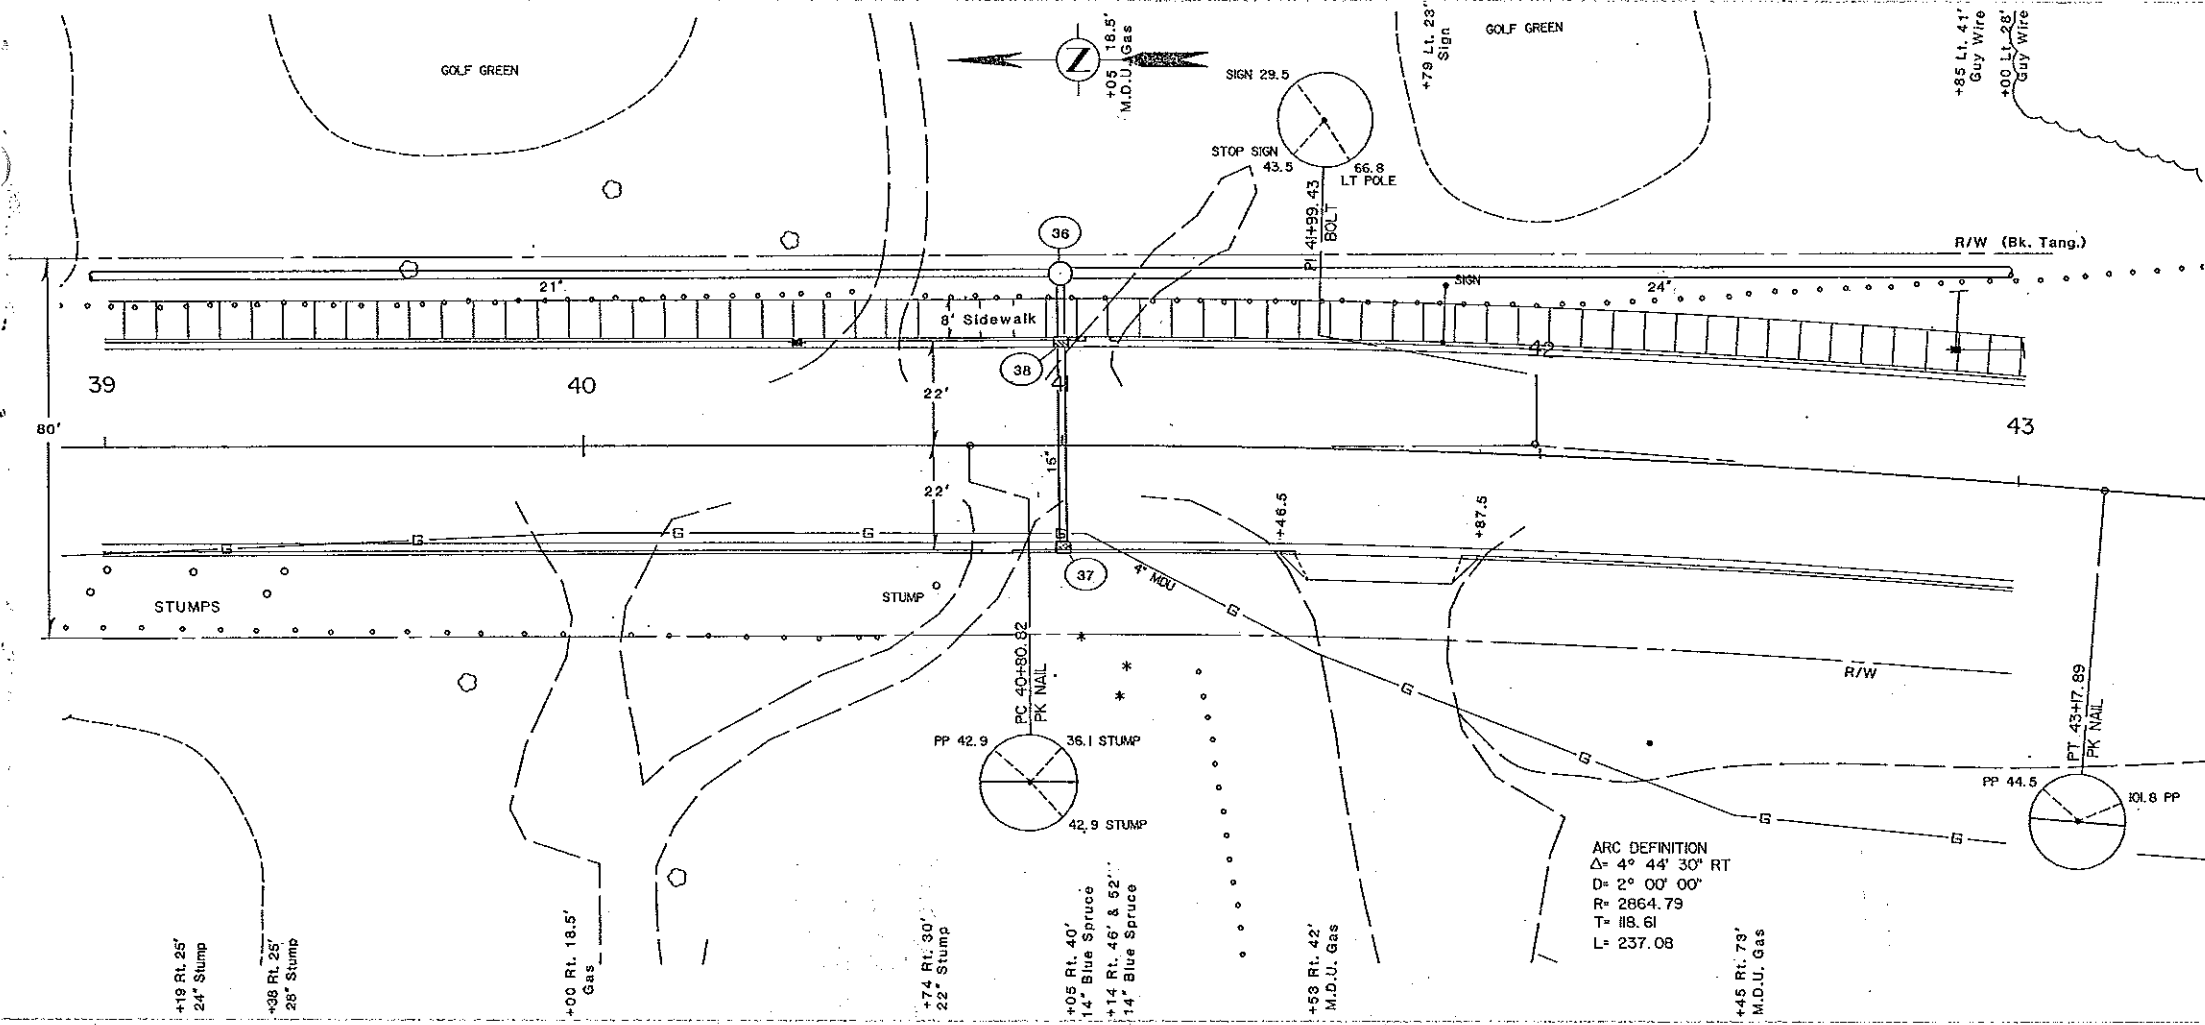

ARC DEFINITION  
 $\Delta = 4^{\circ} 44' 30''$  RT  
 $D = 2^{\circ} 00' 00''$   
 $R = 2864.79$   
 $L = 118.61$   
 $L = 237.08$

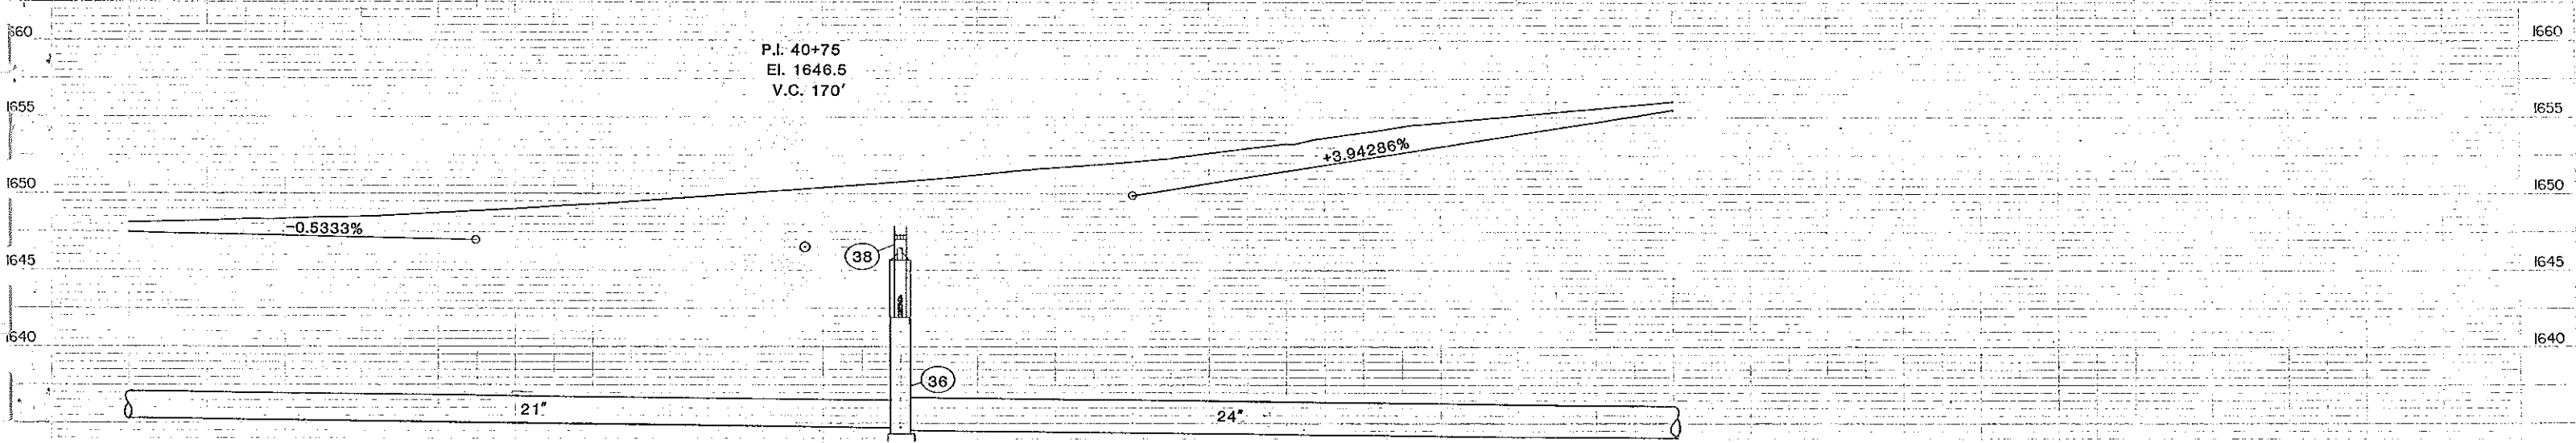

P.I. 40+75  
 El. 1646.5  
 V.C. 170'

M.H. #36 - 60"	Inlet No. #37	#38
41+00 Lt. 36'	Type II - Vane Grate	II - Vane Grate
Top 1646.40	Station 41+00 Rt.	41+00 Lt.
Base 1634.30	Grate 1647.24	1647.24
Invert 1634.55	Base 1642.91	1641.91
Outlet Lift Station	Invert 1643.10	1642.10
Riser 10.45'	Outlet 1642.10	1641.70
	"H" 4.0'	5.0'

1648.2      49.1      50.8      53.5      1656.0

39      40      41      42      43