

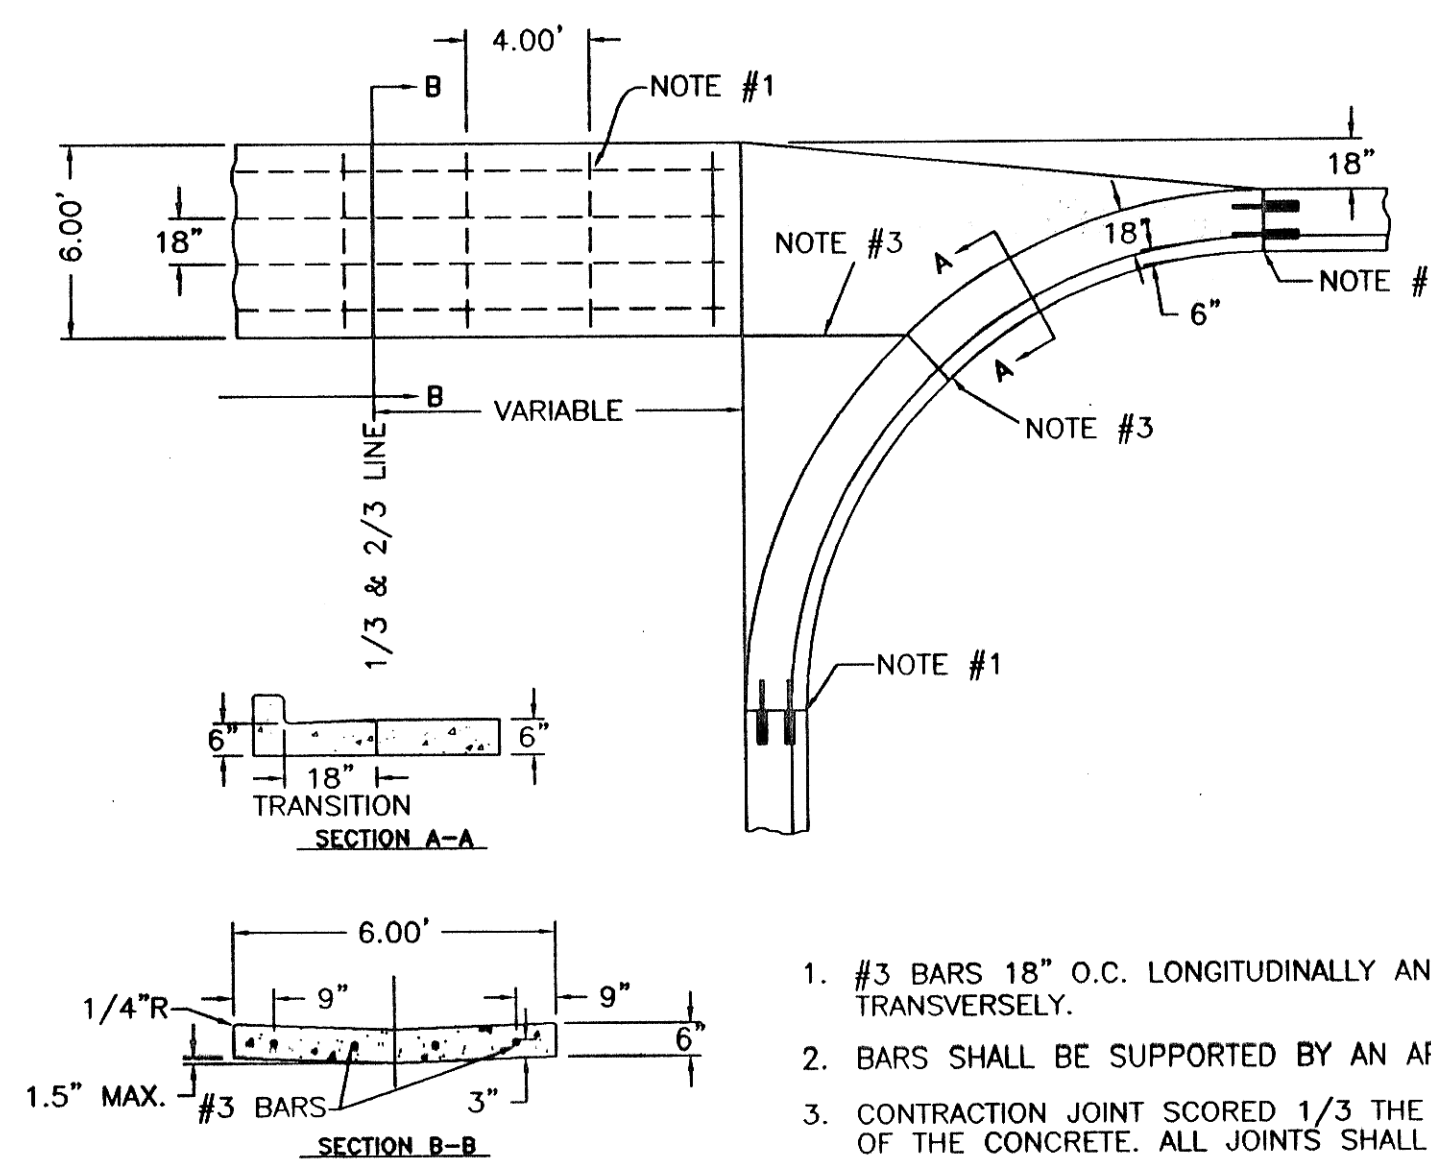


TYPE III BARRICADE
NO SCALE

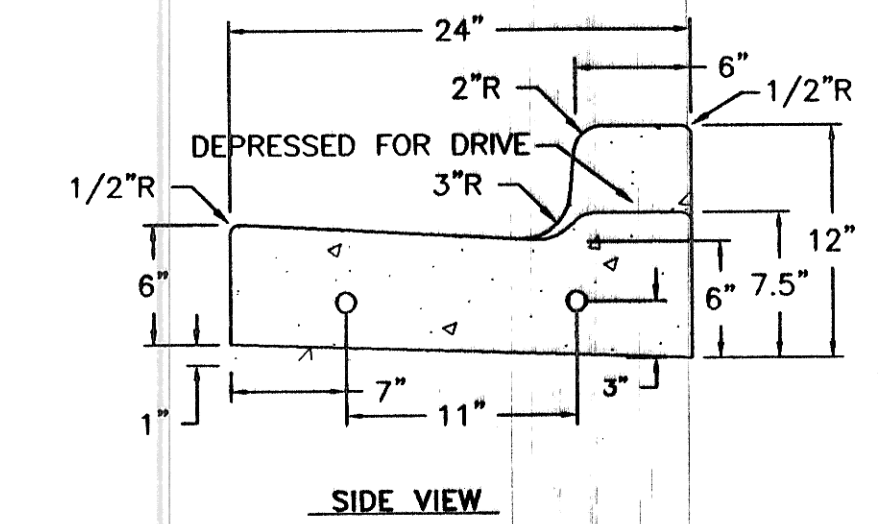


6" REINFORCED CONCRETE VALLEY GUTTER DETAIL
NO SCALE

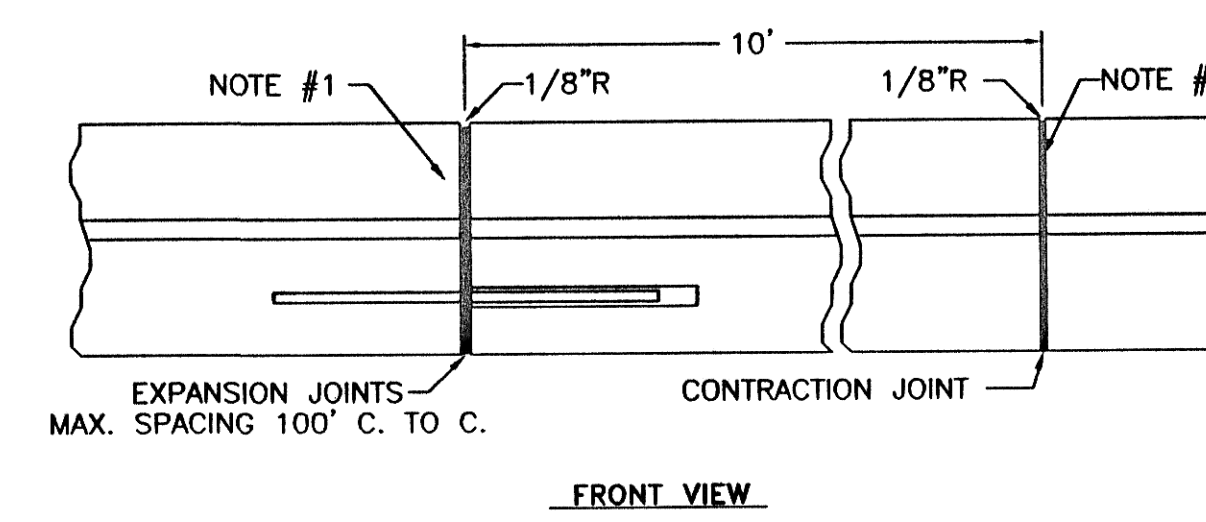


STANDARD CURB & GUTTER DETAIL
NO SCALE


- 3/4" EXPANSION JOINT WITH 3/4"-24" SMOOTH DOWELS & 16" PAPER TUBES. DOWELS SHALL BE GREASED THE FULL LENGTH. ALL PAPER TUBES SHALL BE PLUGGED OR CRIMPED ON ONE END. ALL JOINTS SHALL BE SEALED.
- DOWELS SHALL BE SUPPORTED BY AN APPROVED SUPPORT
- CONTRACTION JOINT SCORED 1/3 THE DEPTH OF THE CONCRETE. ALL JOINTS SHALL BE SEALED

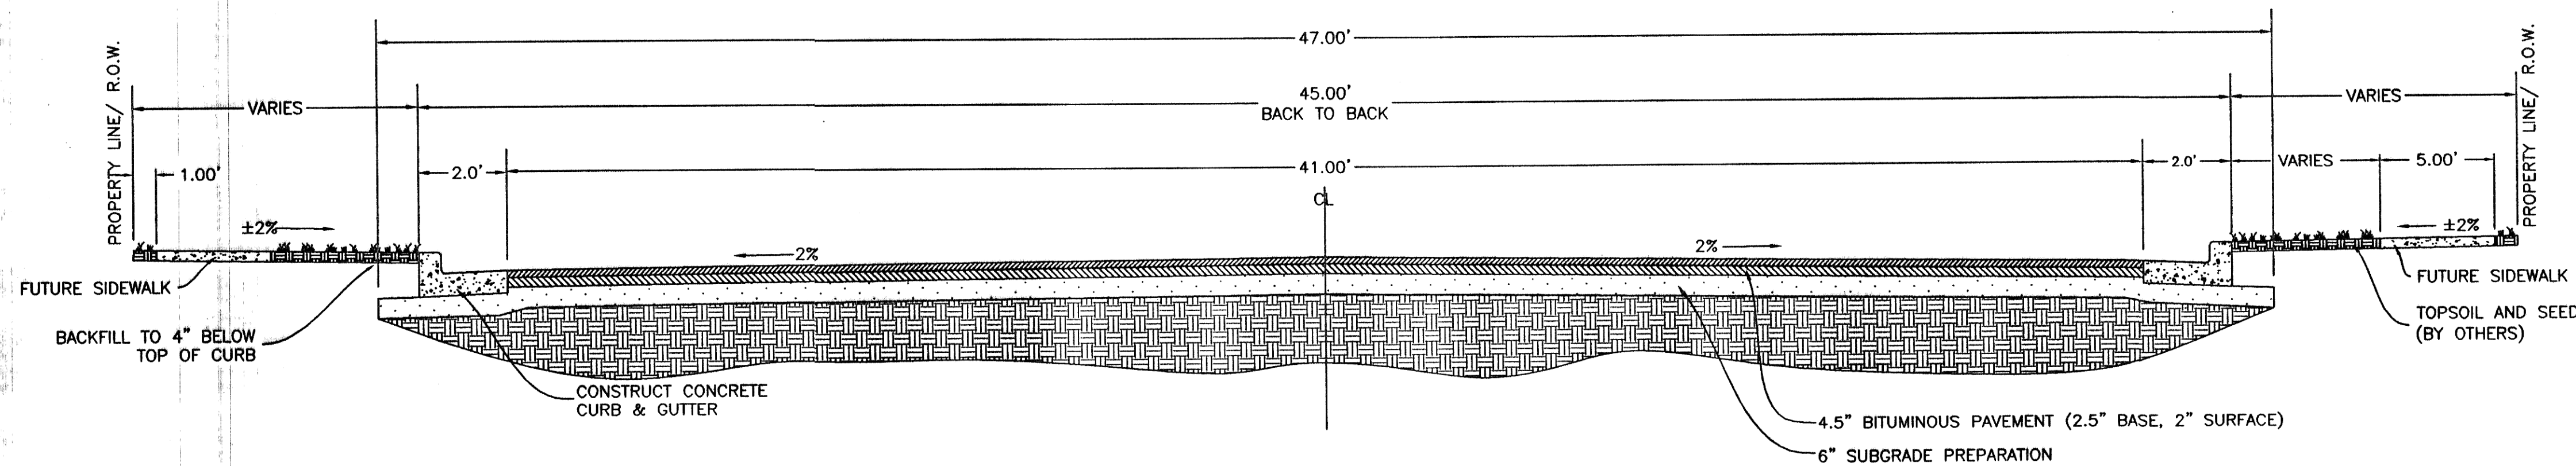

37TH AVENUE SECTION
NO SCALE

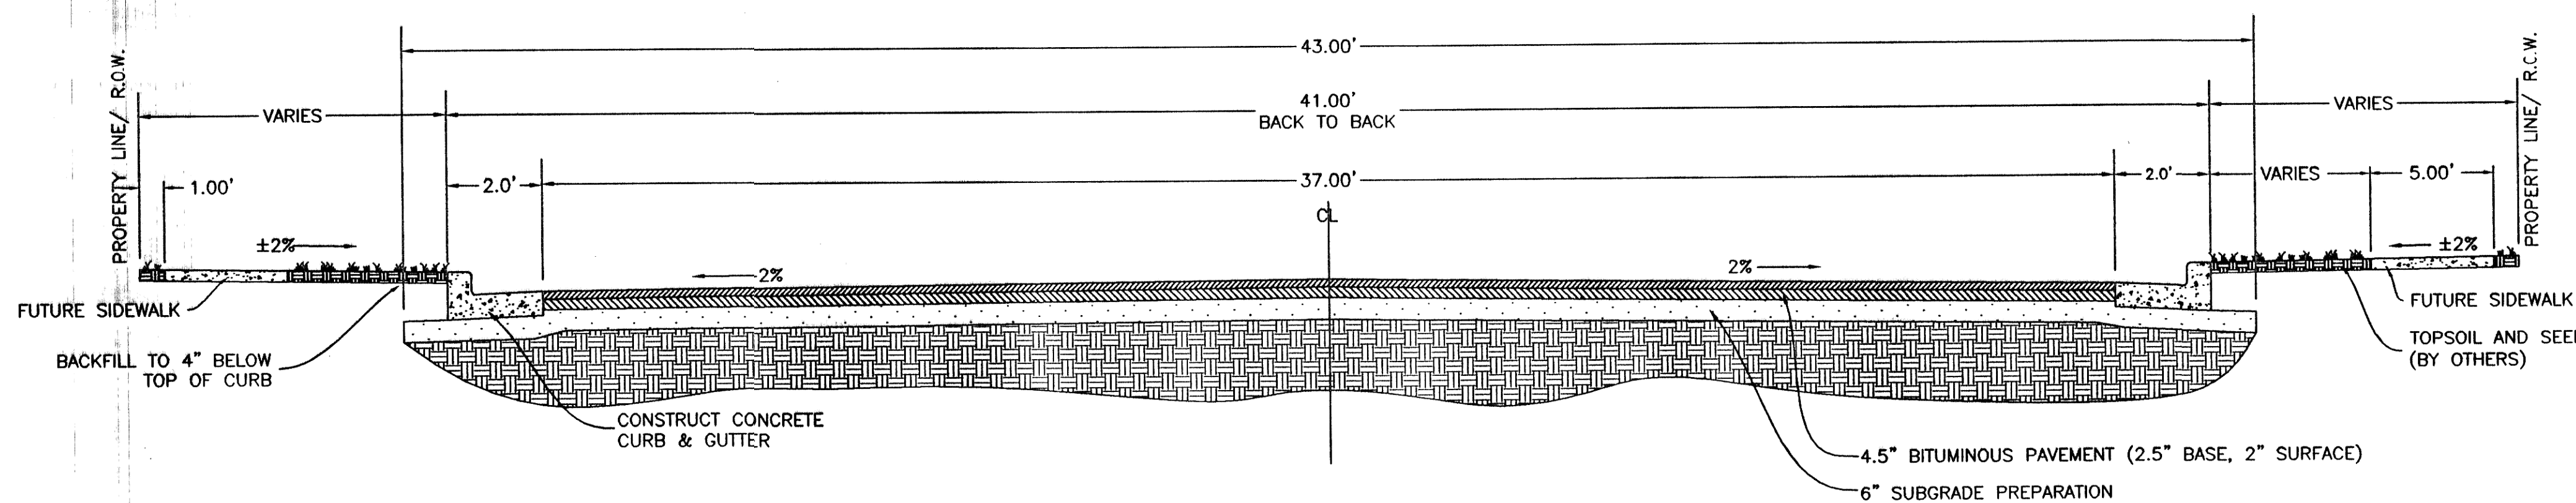

34TH AVE. AND 45TH ST. SECTION
NO SCALE

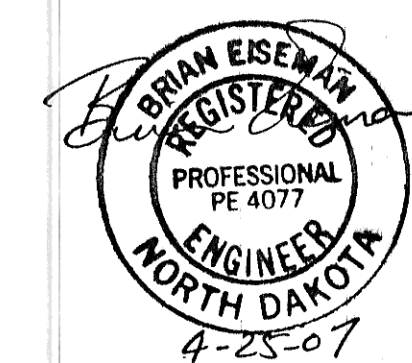

Rev'd.	MEADOWS 2ND ADDITION STREET IMPROVEMENT DISTRICT NO. 2005-28 MANDAN, NORTH DAKOTA	SHEET NO. 2
Kadmas Lee & Jackson Engineers Surveyors Planners		DETAILS
DRWN. BY ADA	CHKD. BY BE	CMP. NO. 1406103
J:\municipa\1406103 - Meadows Streets\CADD\EP\1406103bose.dwg		DATE 04/28/08
© Kadmas, Lee & Jackson, Inc. 2006		

RECORD DRAWING