

CONSTRUCTION PLANS FOR:

# PLAINVIEW TENTH ADDITION

## 8TH AVENUE SE, 27TH STREET SE AND PLAINVIEW DRIVE


### STREET IMPROVEMENT PROJECT 2006-01 DIST. NO. 137 - AREA A

CITY OF MANDAN, NORTH DAKOTA

MAY 2006


**SHEET INDEX**

1. COVER SHEET
- 2-3. DETAILS
4. GENERAL AREA LAYOUT
5. 8TH AVENUE SE PLAN AND PROFILE
6. 27TH STREET SE PLAN AND PROFILE
7. PLAINVIEW DRIVE PLAN AND PROFILE
8. STORMWATER EASEMENT PLAN AND PROFILE

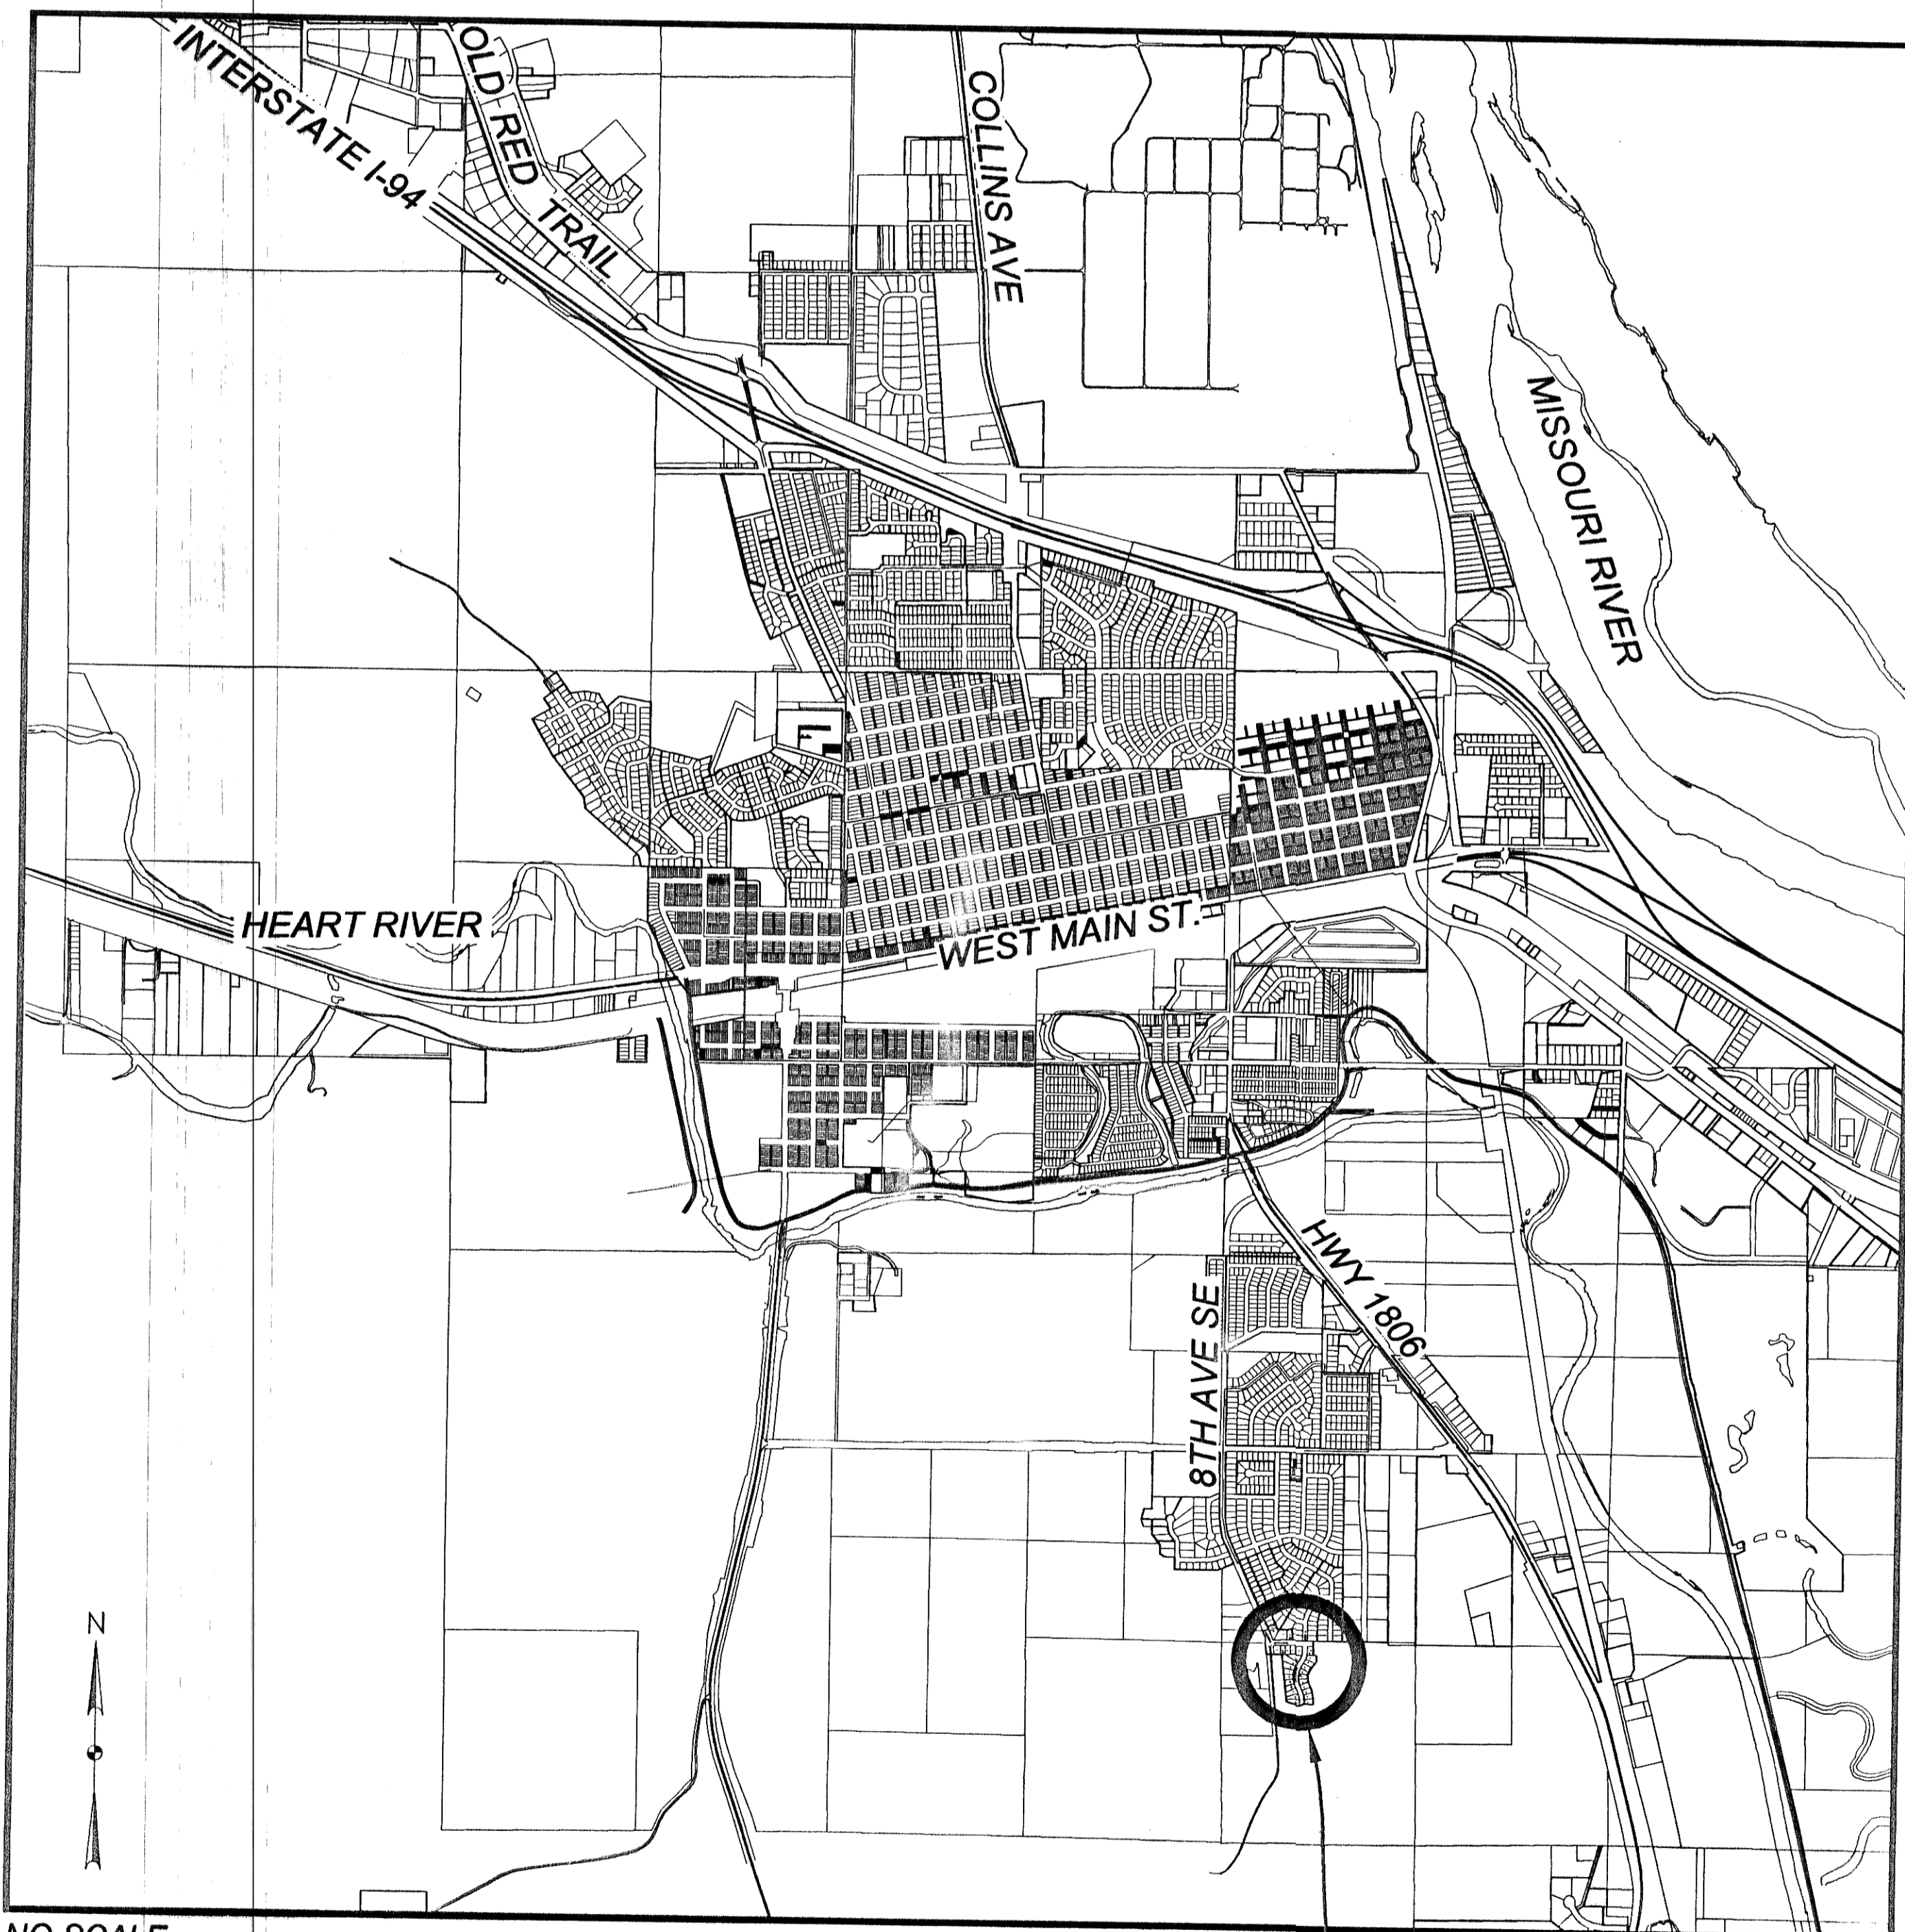

NO SCALE

PROJECT LOCATION

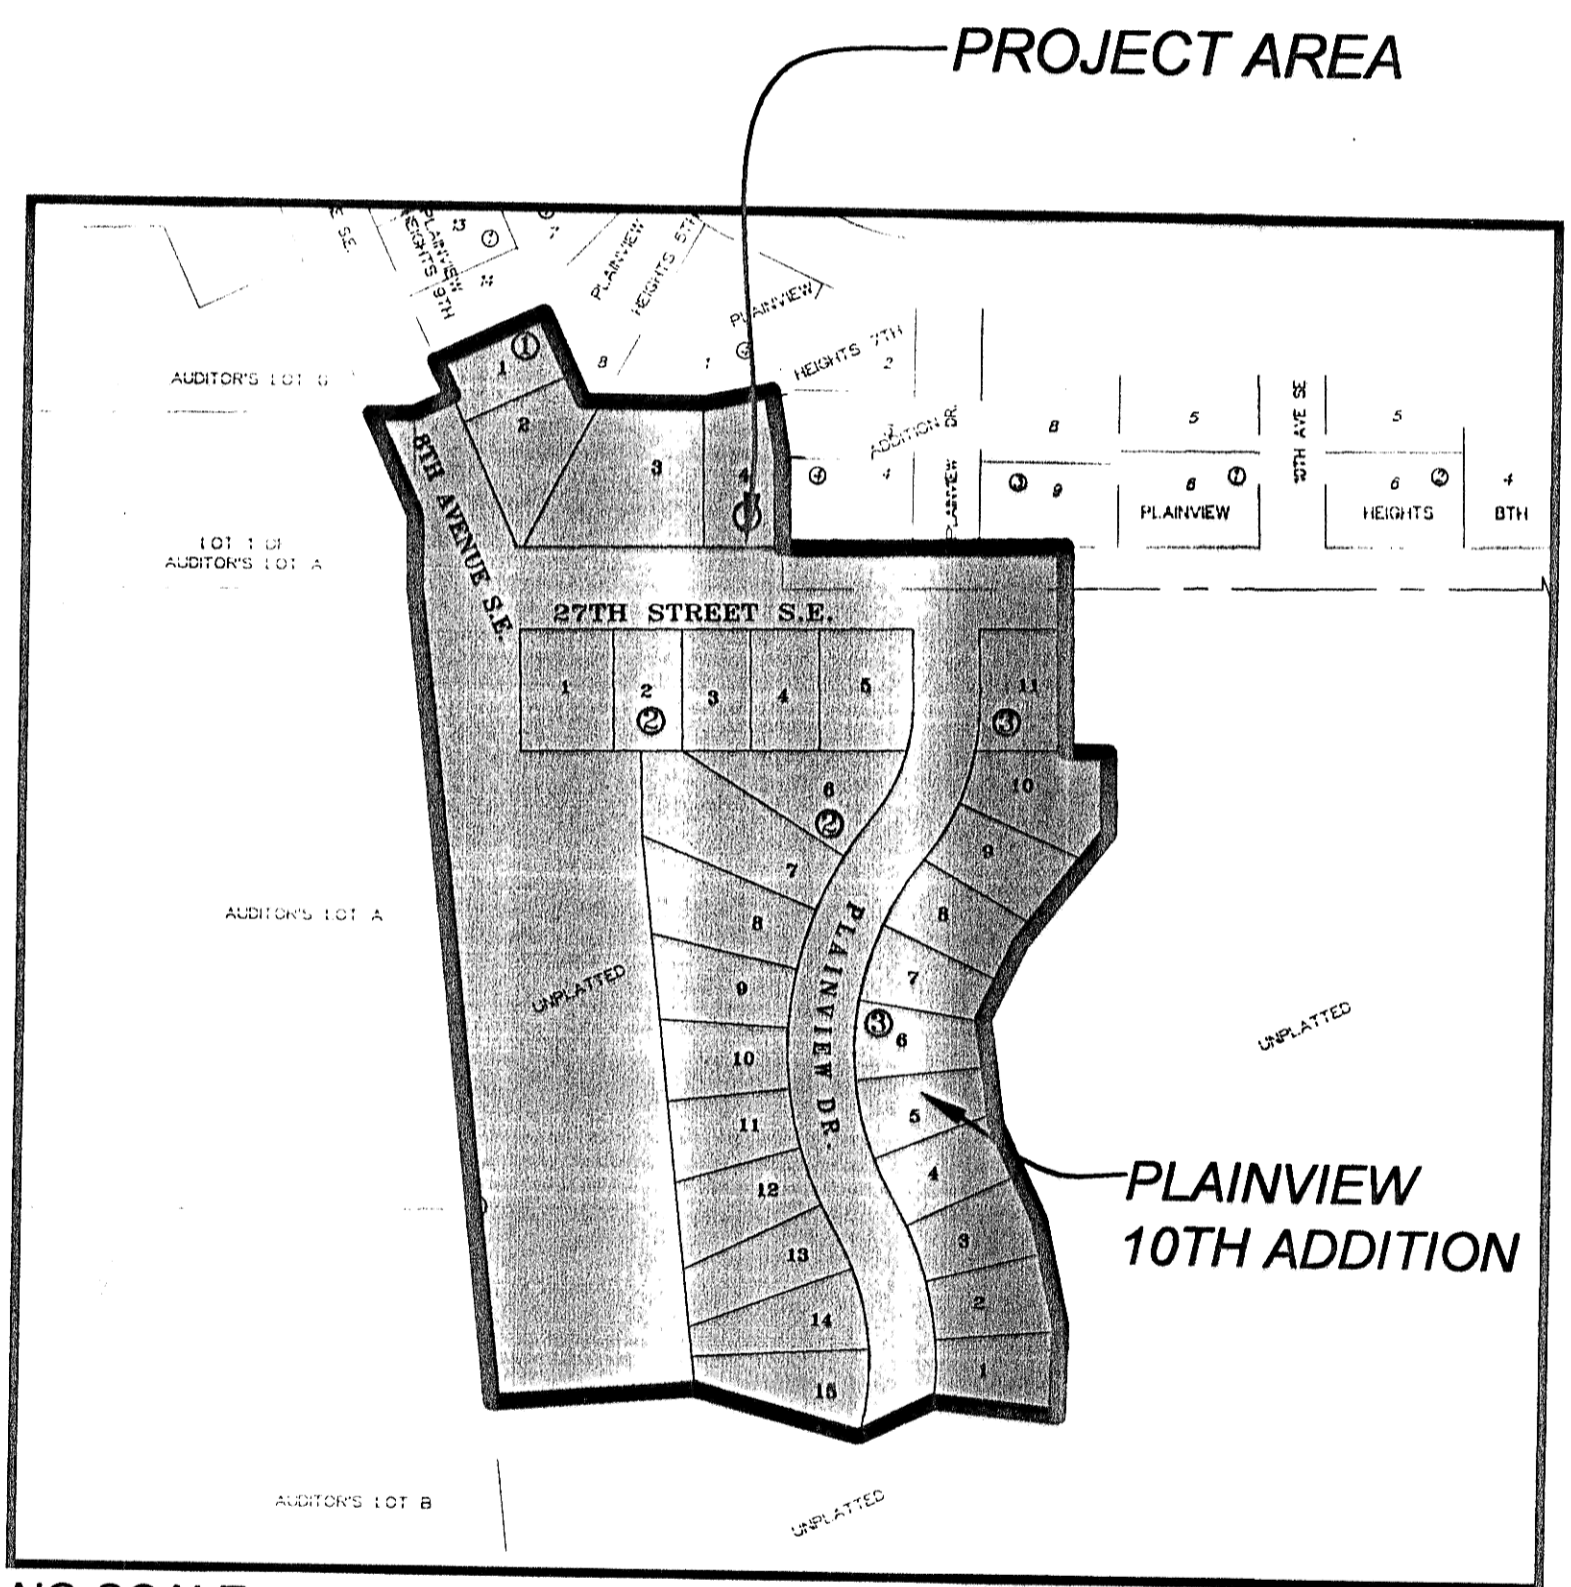

NO SCALE

PROJECT AREA

PLAINVIEW 10TH ADDITION

**CERTIFICATION**

I HEREBY CERTIFY THAT THESE PLANS AND SPECIFICATIONS WERE PREPARED BY ME OR UNDER MY DIRECT SUPERVISION, AND THAT I AM A DULY REGISTERED ENGINEER IN THE STATE OF NORTH DAKOTA.

*Brian Eiseman* DATE 4-25-07 REG. NO. 4077  
Brian Eiseman, P.E.



**APPROVAL OF CITY ENGINEER**

I, THOMAS LITTLE, CITY ENGINEER FOR THE CITY OF MANDAN, NORTH DAKOTA HEREBY APPROVE THESE PLANS FOR STREET IMPROVEMENTS AS SHOWN ON THE ACCOMPANYING PLANS.

DATE \_\_\_\_\_  
Thomas Little, P.E. - City Engineer

prepared for:  
CITY OF MANDAN

prepared by:  
KADRNAS, LEE & JACKSON, INC.  
128 Soo Line Drive  
Box 1157  
Bismarck, ND 58502  
Ph. (701)-355-8400

**Kadrmas  
Lee &  
Jackson**  
Engineers Surveyors  
Planners

RECORD DRAWING

06-01 D137A

1406104