

STREET IMPROVEMENTS RIVERWOOD COMMERCIAL PARK AS-BUILT MANDAN, NORTH DAKOTA

CITY NO. 2004-25 DISTRICT #124 AREA "B"
AUGUST, 2004



INDEX OF DRAWINGS


SHEET NO.	TITLE
1	TITLE SHEET
2	PROJECT LAYOUT
3	RIVERWOOD AVE SE PLAN & PROFILE BEGIN TO 11+20
4	RIVERWOOD AVE SE PLAN & PROFILE 11+20 TO END
5	STORM SEWER PLAN & PROFILE
6	DETAIL SHEET
7	STREET LIGHT DETAIL SHEET

APPROVED: _____ DATE: _____
THOMAS LITTLE, R.P.E. CITY ENGINEER, MANDAN, NORTH DAKOTA

PREPARED BY:
TOMAN ENGINEERING

Ronald W. Manchester DATE: Jan 24, 2007
RONALD MANCHESTER R.P.E. 3252

CONTRACTOR: NORTHERN IMPROVEMENT CO
ADDRESS: 3320 E. CENTURY AVE BISMARCK, ND
PHONE: 701-223-6695

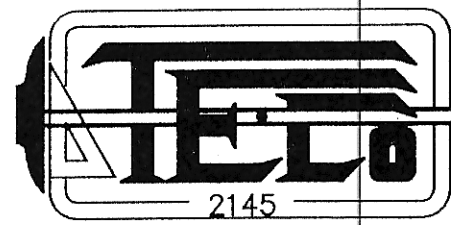

TOMAN ENGINEERING COMPANY
CONSULTING CIVIL ENGINEERS
906 2ND ST. N.W. • MANDAN, NORTH DAKOTA 58554 • 701-663-6483



SCANNED: 2-15-07

* ALL ELEVATIONS ARE NGVD29

FOLDER: 2004 2145 Asbuilt

FILE NAME: Riverwood Commercial Park

SHEET 1 OF 7 SHEETS

04-25 D124 B