












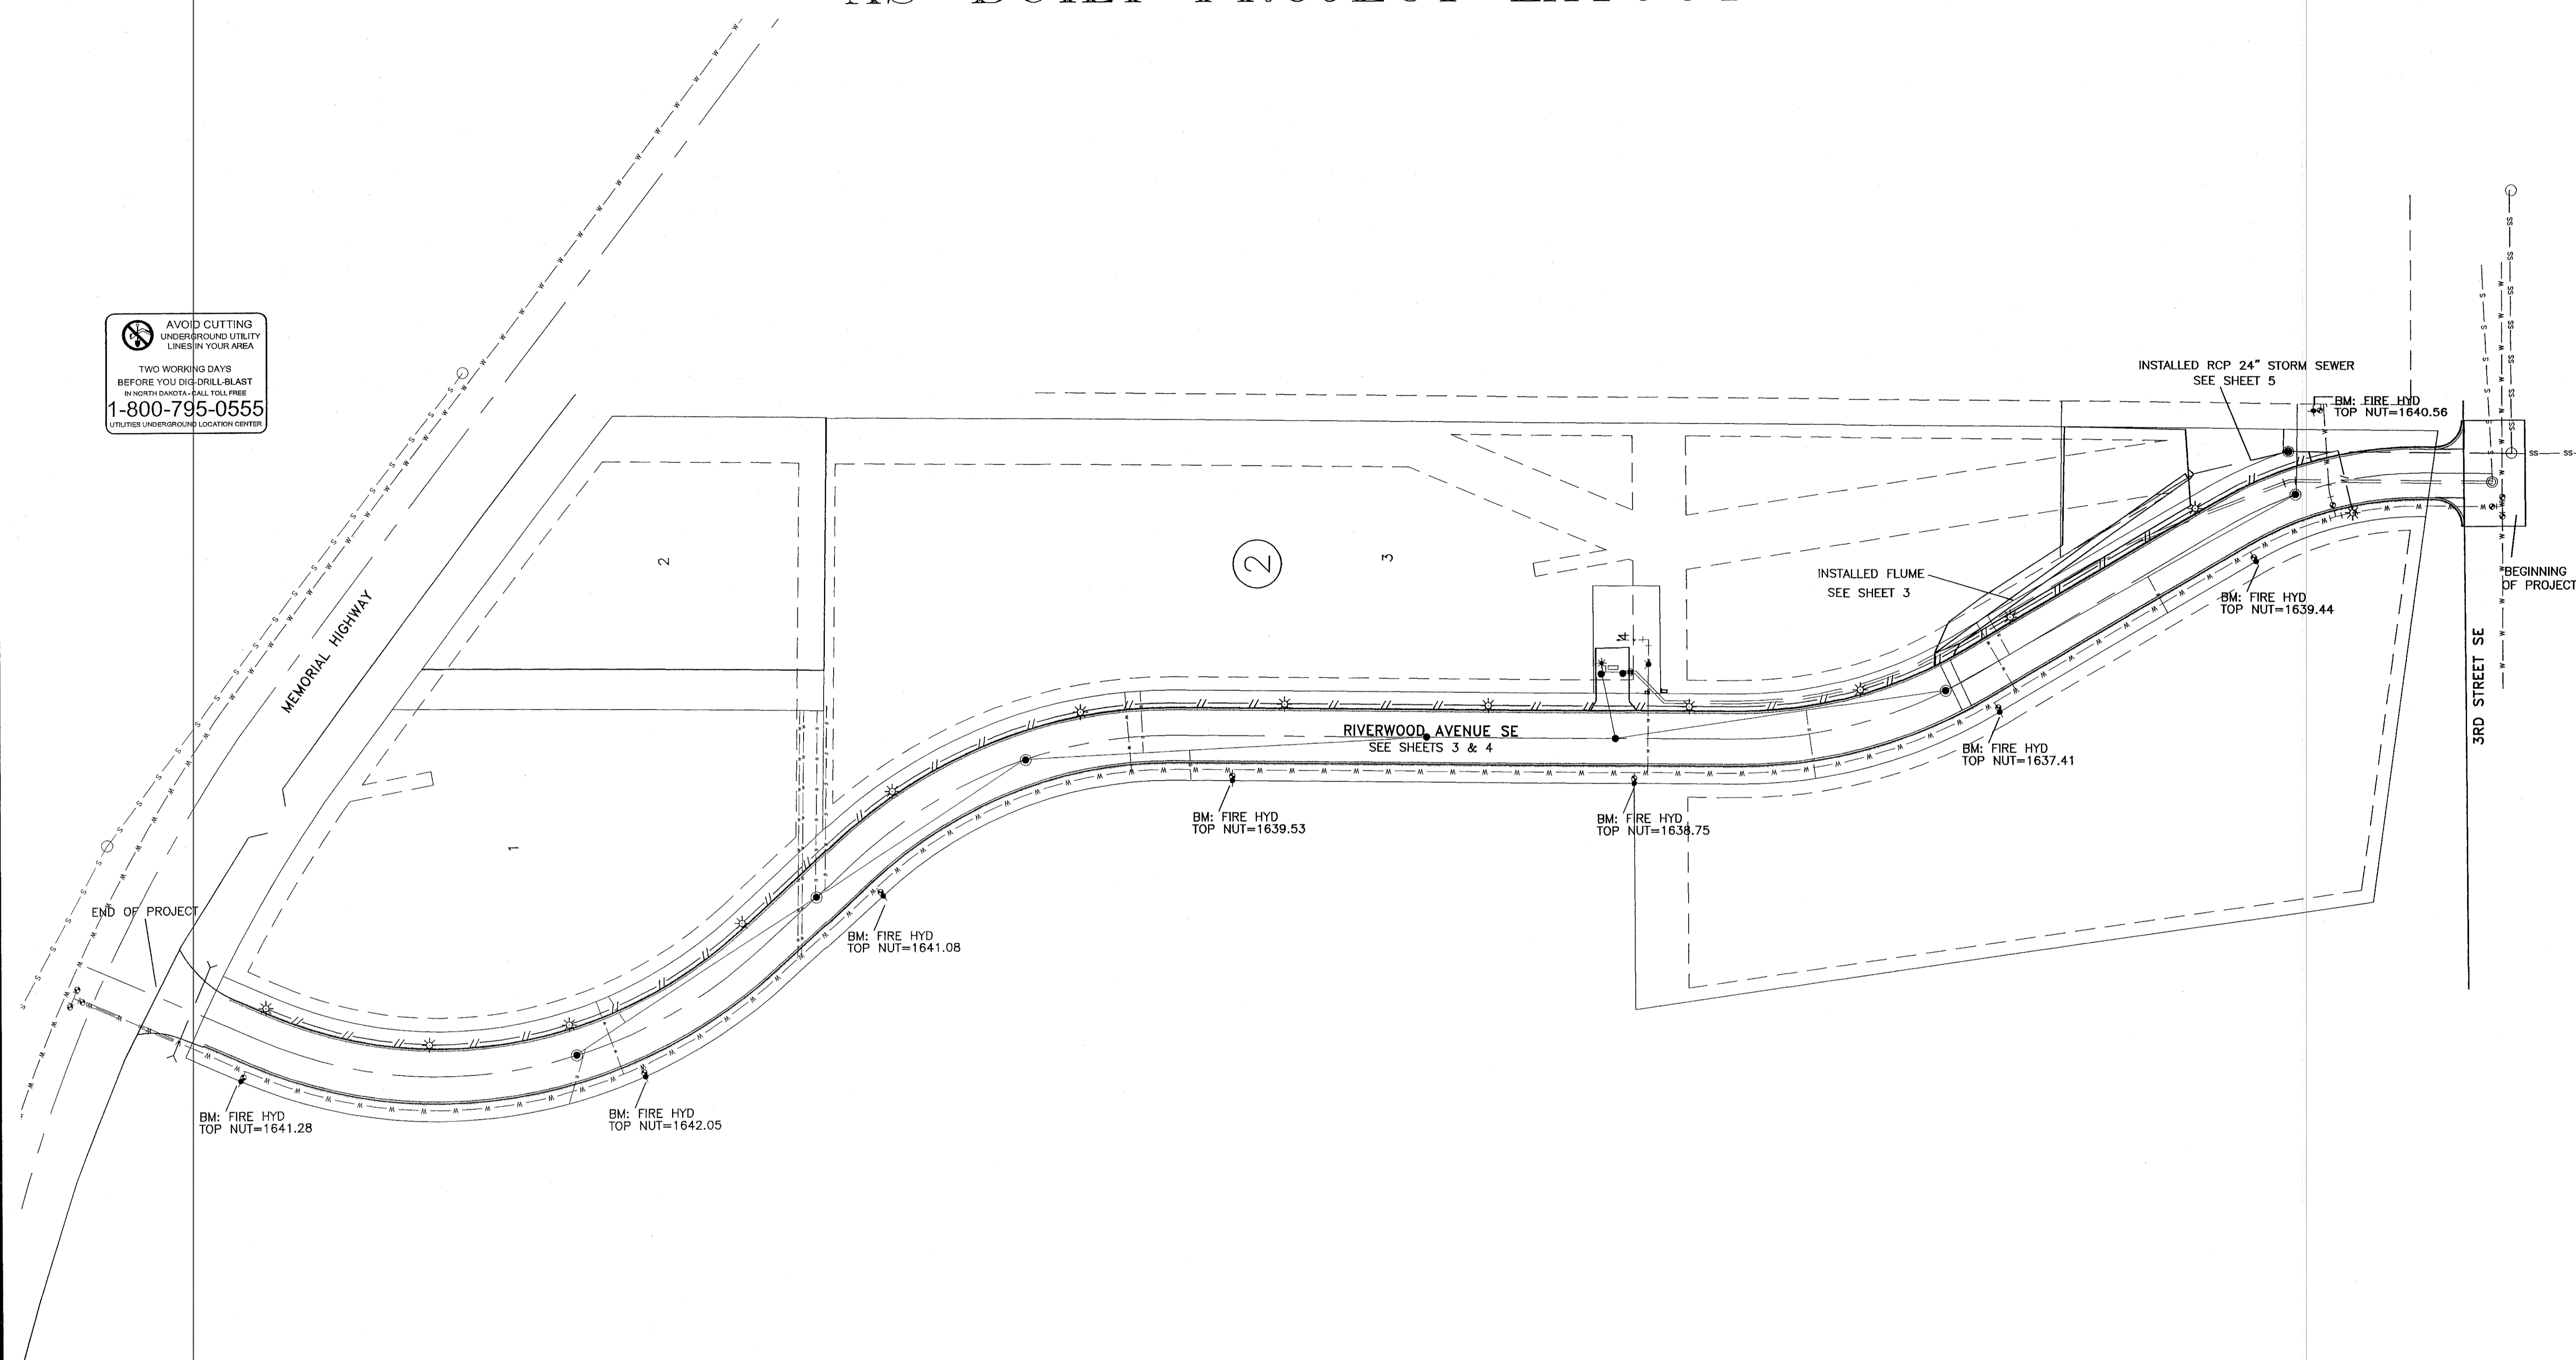


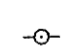
AS-BUILT PROJECT LAYOUT

 AVOID CUTTING UNDERGROUND UTILITY LINES IN YOUR AREA
 TWO WORKING DAYS BEFORE YOU DIG-DRILL-BLAST IN NORTH DAKOTA - CALL TOLL FREE 1-800-795-0555
 UTILITIES UNDERGROUND LOCATION CENTER



-  EXISTING LIGHT POLE
-  EXISTING ELECTRICAL BOX
-  EXISTING ELECTRIC POLE
-  EXISTING SANITARY SEWER MANHOLE
-  EXISTING STORM SEWER MANHOLE
-  EXISTING TELEPHONE PEDESTAL
-  INSTALLED SANITARY SEWER MANHOLE
-  INSTALLED STORM SEWER MANHOLE
-  INSTALLED FIRE HYDRANT
-  INSTALLED GATE VALVE
-  INSTALLED CURB STOP
-  INSTALLED 1\"/>

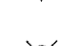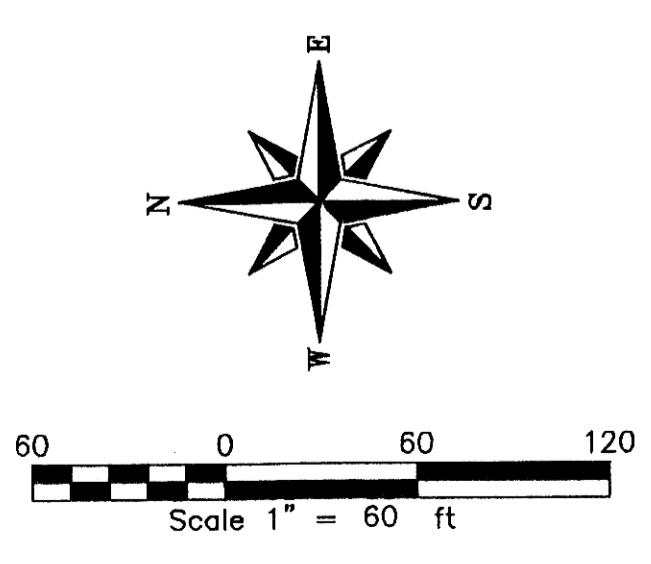

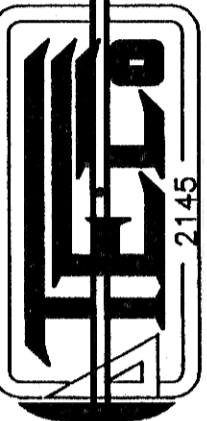TOMAN ENGINEERING COMPANY
 CONSULTING CIVIL ENGINEERS
 908 2ND ST. N.W. • BISMARCK, NORTH DAKOTA 58504 • 701-683-6483
 2145

PROJECT: STREET IMPROVEMENTS DIST. #124 AREA "B"
 RIVERWOOD COMMERCIAL PARK
 PROJECT LAYOUT AS-BUILT

NO.	DATE	BY	REVISIONS

TITLE: STREET IMPROVEMENT DIST. #124 AREA "B"
 SHEET NUMBER
2
 OF 7 SHEETS