

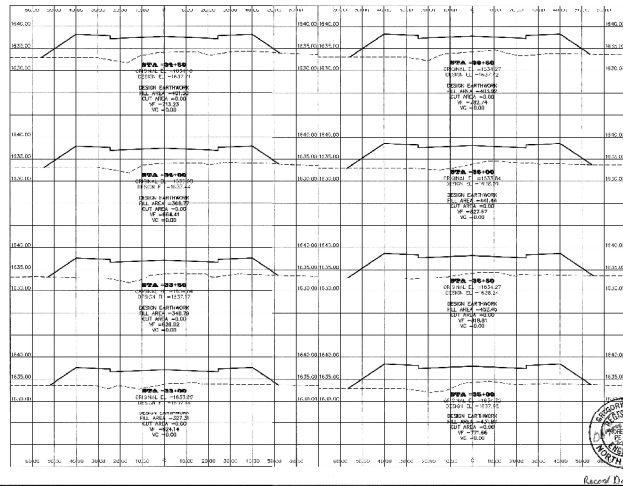
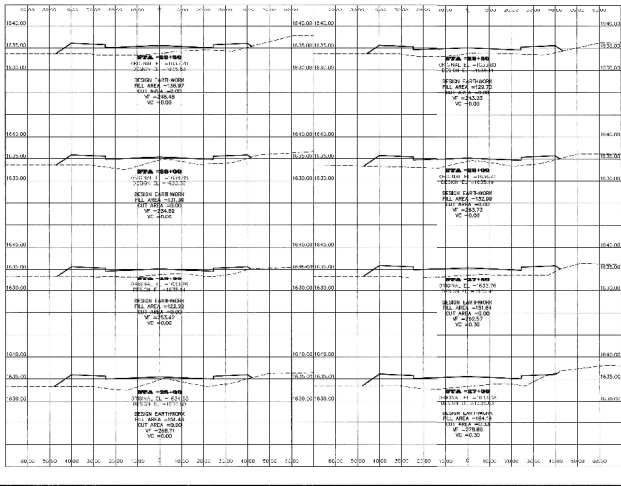


CROSS SECTIONS ON 49TH AVENUE SE
DISTRICT 133 PROJECT 2005-16

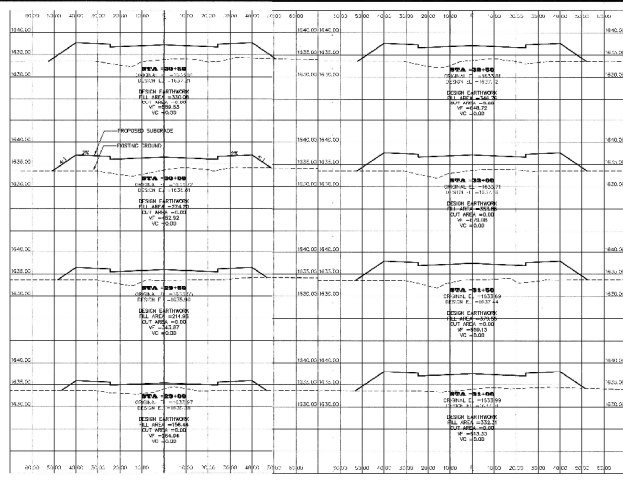

DESIGN BY: JMS
CHECK BY: JMS/SP
DATE: 02-10-05
FILE NO.: SW-16-16
SURVEY FILE: SW-16-16

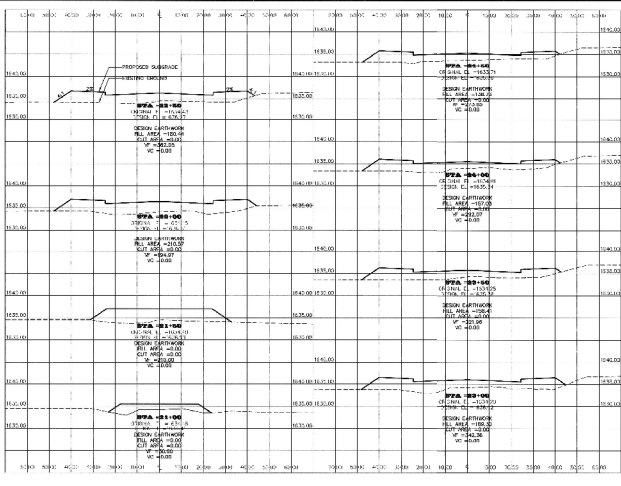

SHEET
C14
OF 18

\\swhc\lab\cadd\2005\16\16-16.dwg, 0/2/2005 11:50:27 AM, p.c.