

CROSS SECTIONS ON 40TH AVENUE SE  
DISTRICT 133 PROJECT 2005-16



DESIGN BY: JRM  
CHECK BY: JRM/SLP  
DATE: 05-10-05  
FILE: 0505  
PLOT: 0505  
COMPUTER FILE:  
SURVEY FILE:

REVISIONS  
DATE  
BY  
REASON

RECORD NUMBER

DATE

BY

REASON

DATE

BY

REASON

DATE

BY

REASON

DATE

BY





REASON

DATE

BY

REASON

DATE

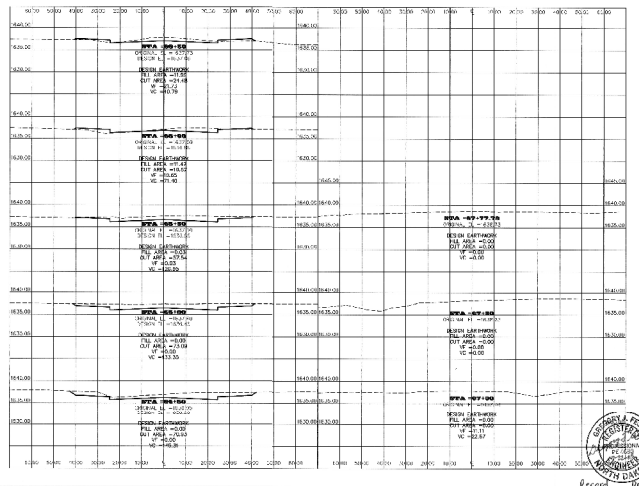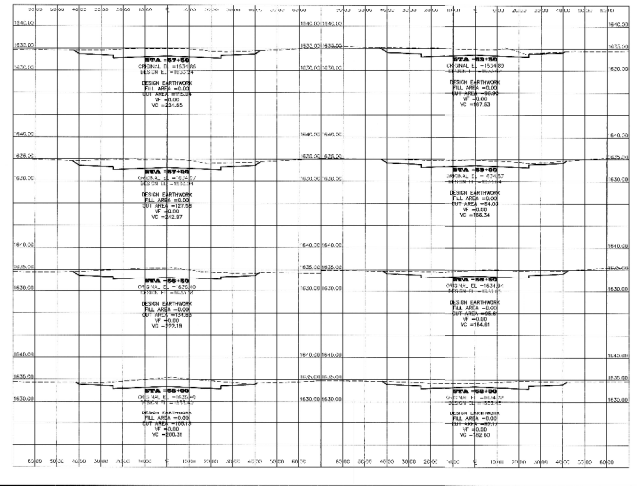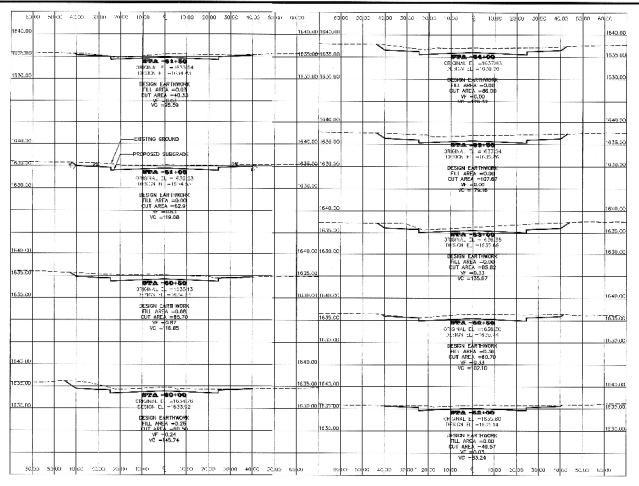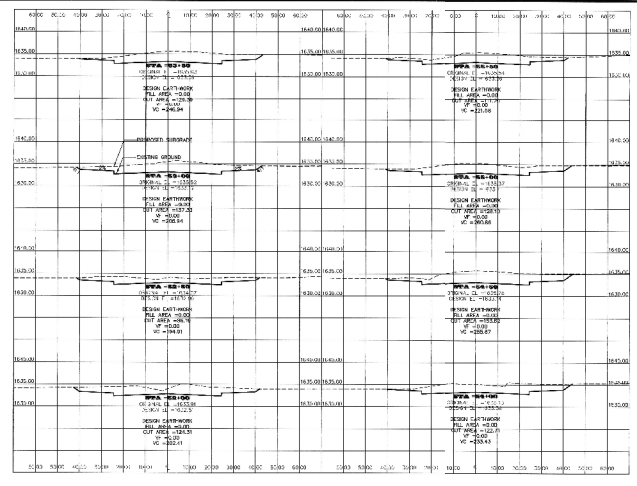

F:\Roads\40th\0505\0505.dwg

