


INLET DETAIL

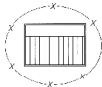


NOTE:
INSTALL EROSION CONTROL DEVICE AROUND INLETS TO PROTECT FROM SETTLEMENTS ENTERING STORM SEWER SYSTEM.

ONCE CURB AND GUTTER IS CONSTRUCTED, PROTECT INLETS WITH GRAVEL FILLED SANDBAGS TO PROTECT INLETS UNTIL STREET IS COMPLETED.



SCALE 1" = 150'
Overall Schematic
NOT FOR CONSTRUCTION

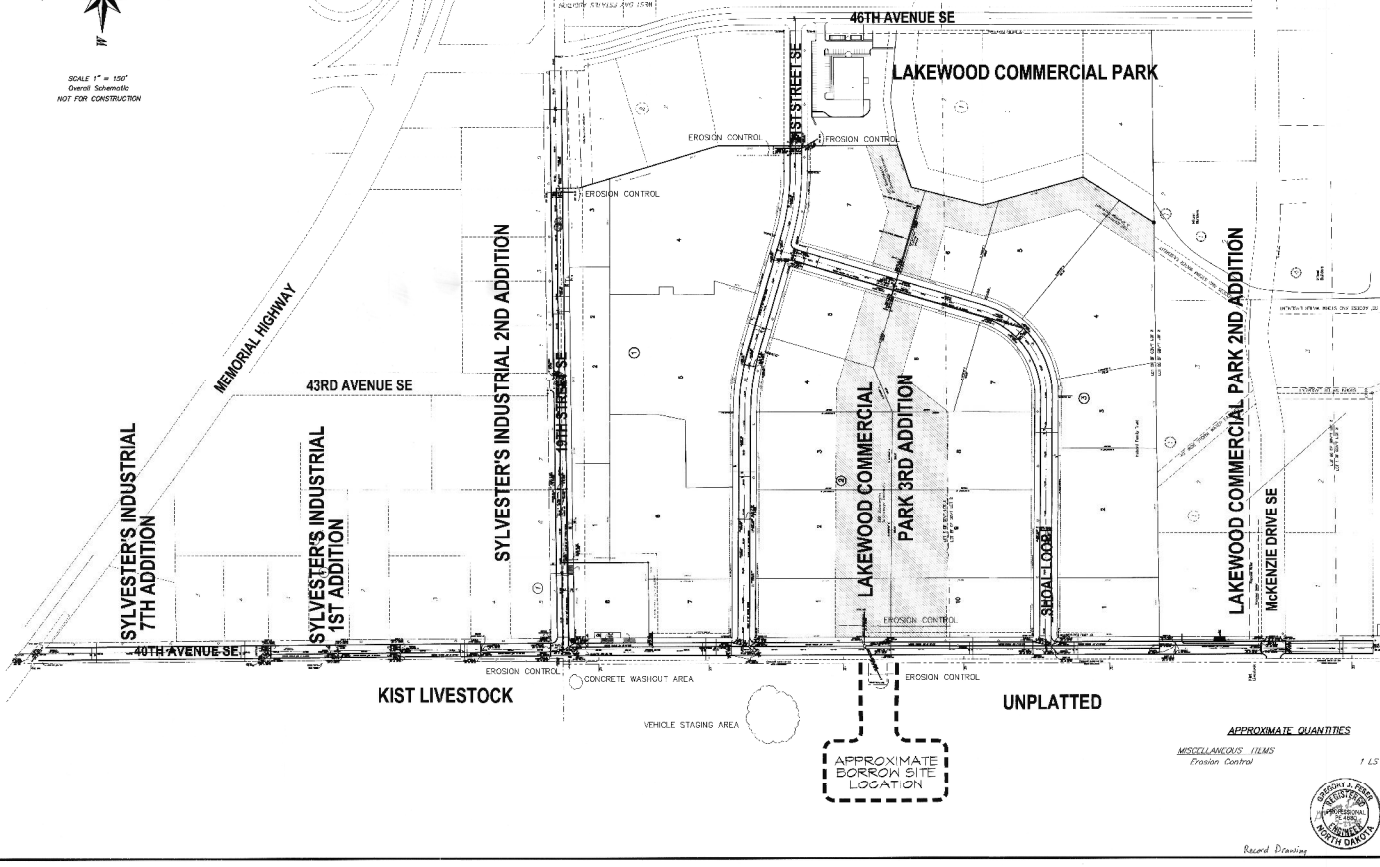

EROSION CONTROL PLAN
PROJECT 2005-16
DISTRICT 133



| | |
|----------------|----------|
| DESIGN BY: | MCH |
| CHECK BY: | JBS/EJE |
| DATE: | 02-22-05 |
| FILE NO.: | |
| DATE: | |
| COMPUTER FILE: | |
| DATE: | |

APPROXIMATE QUANTITIES

MISCELLANEOUS ITEMS
Erosion Control

1 LS



SHEET
CHOP 18

Revised Drawing