
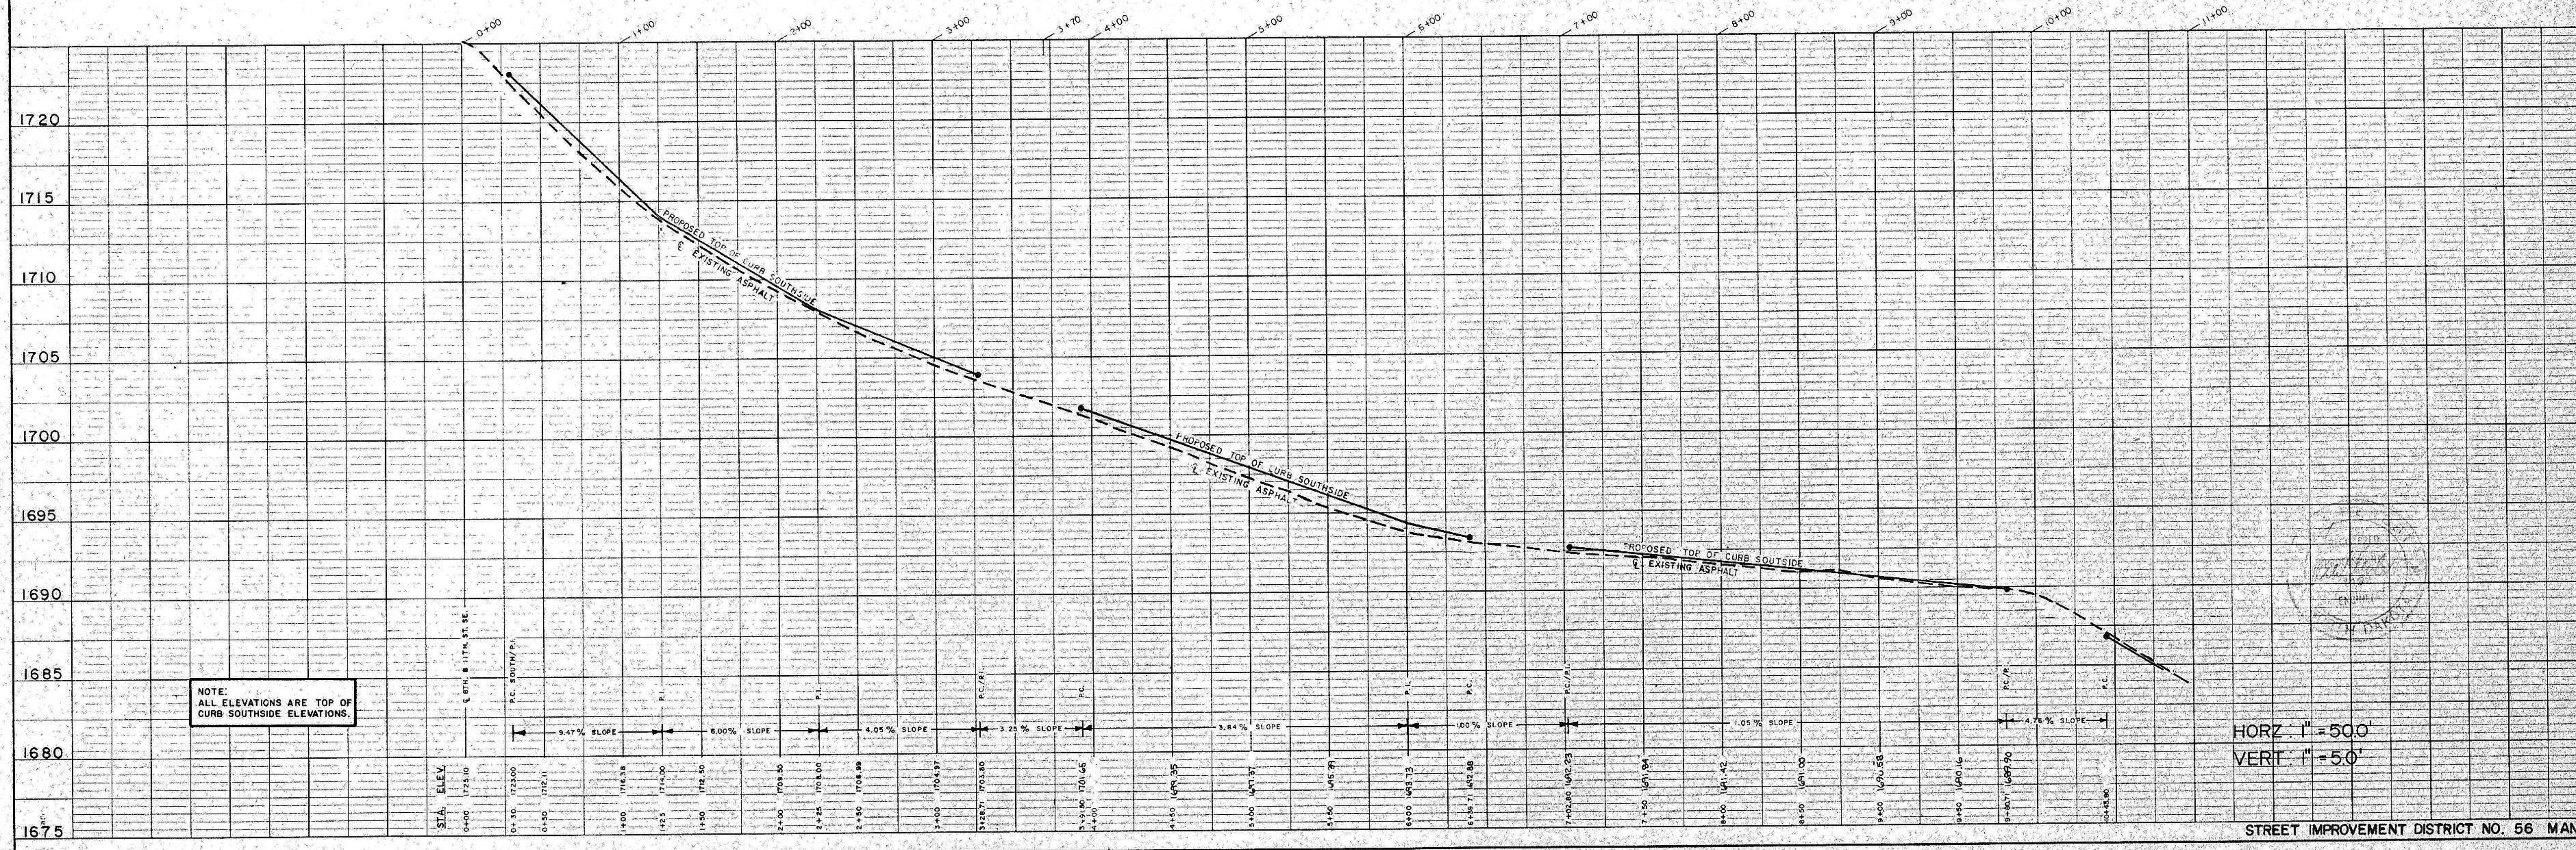
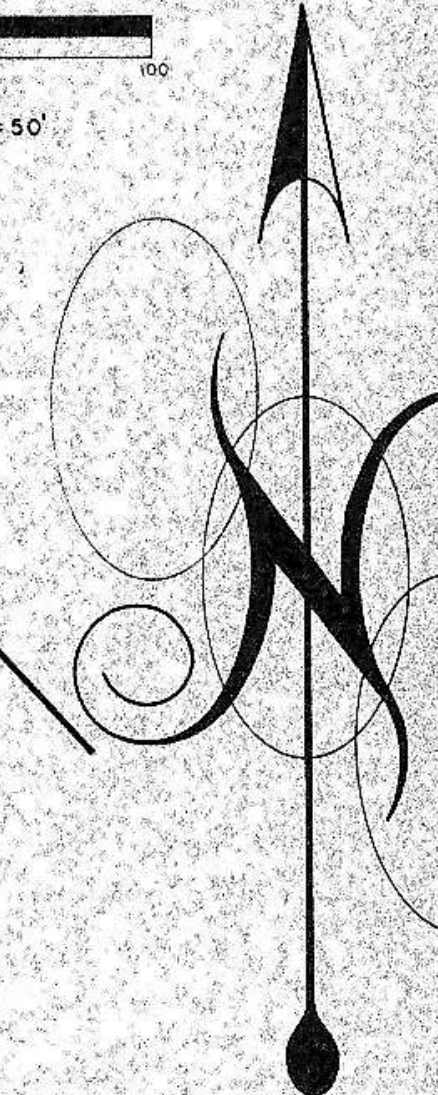
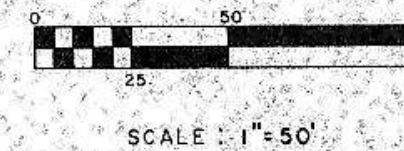


PLAN	SURVEY	DATE
NOTE BOOK	ALIGNED	CHECKED
NO.	BY	BY

PROFILE	DATE
NOTE BOOK	BY
NO.	BY

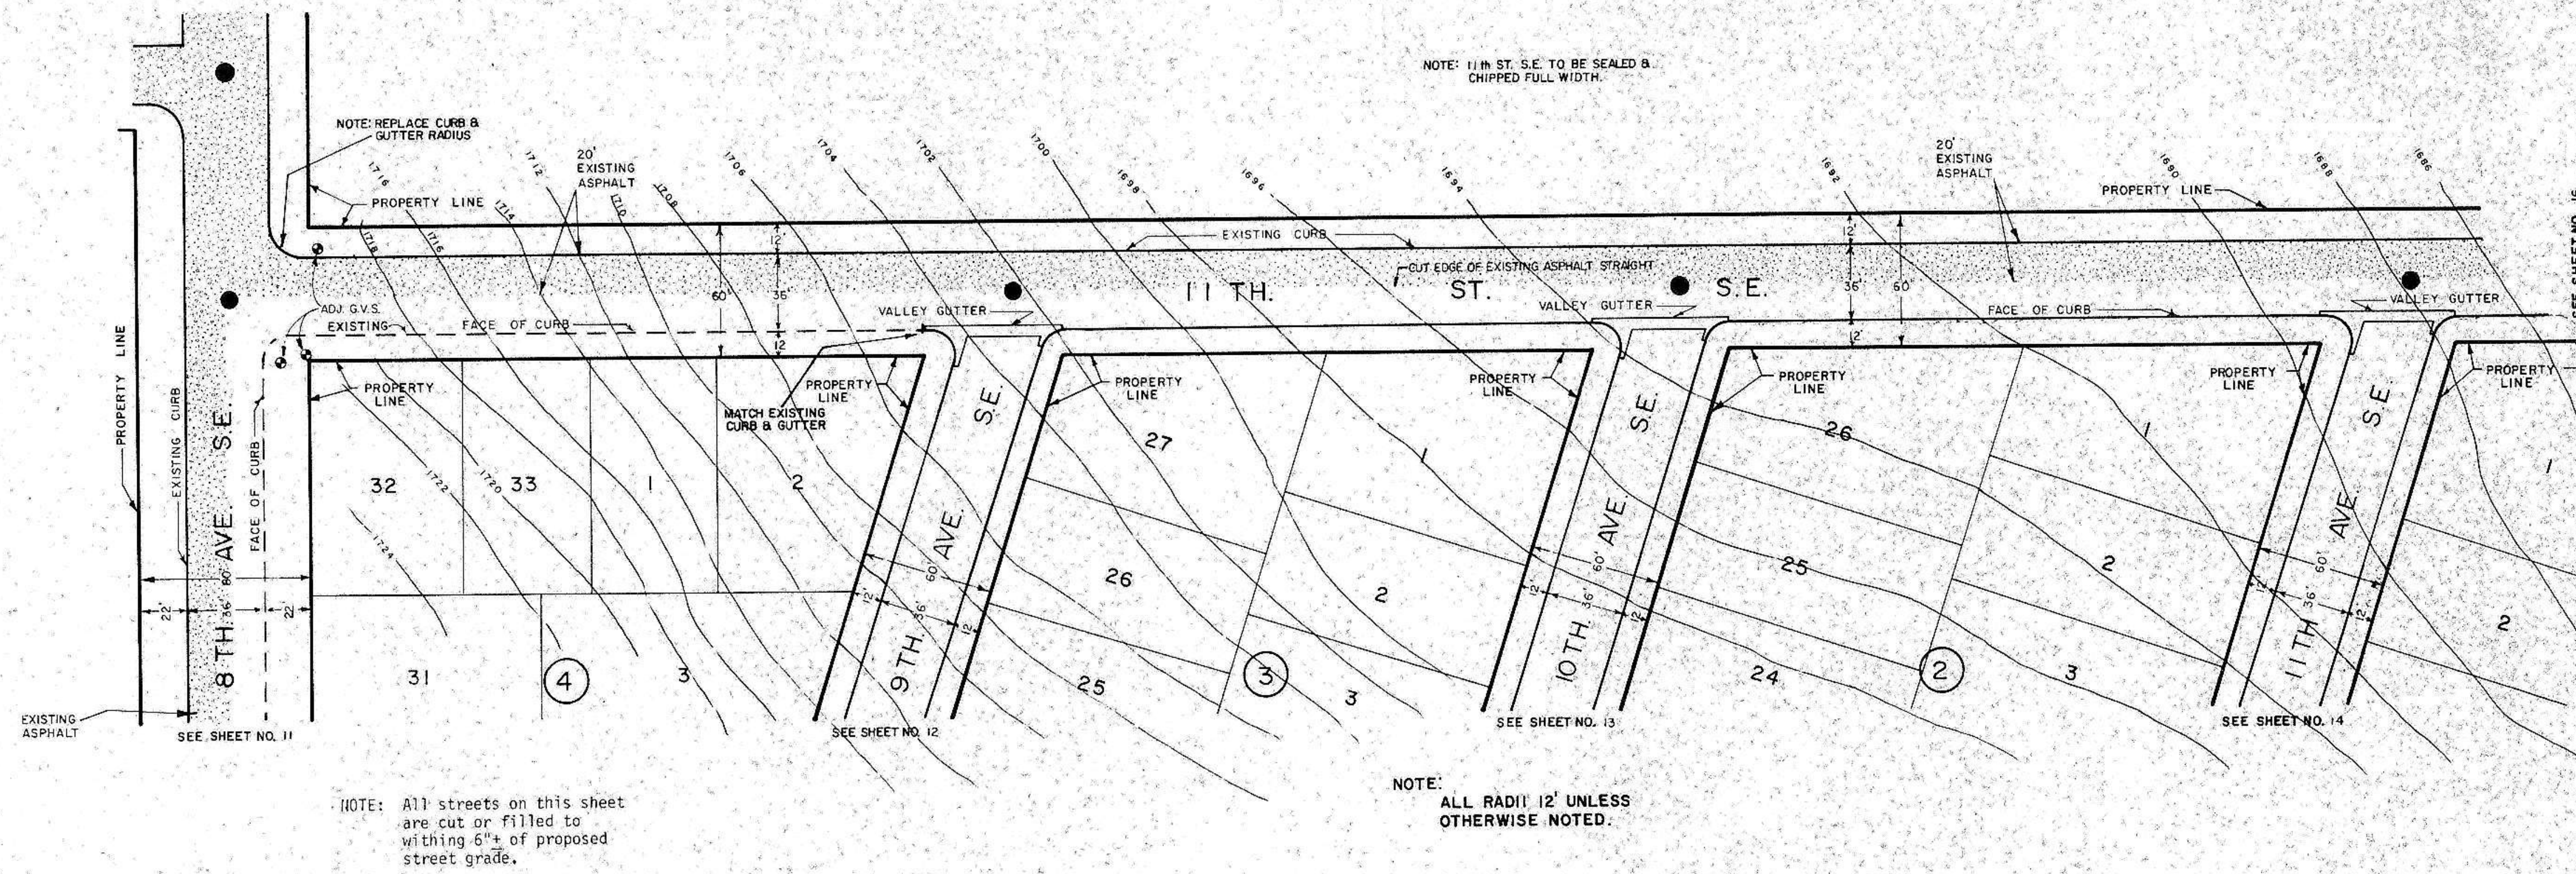

HORZ. 1" = 50'
VERT. 1" = 50'