


PLAN
 SURVEYED BY _____ DATE _____
 ALIGNED BY _____
 CHECKED BY _____
 RT. OF WAY CHECKED BY _____
 NO. _____

NOTE: All streets on this sheet are cut or filled to within 6"± of proposed street grade.

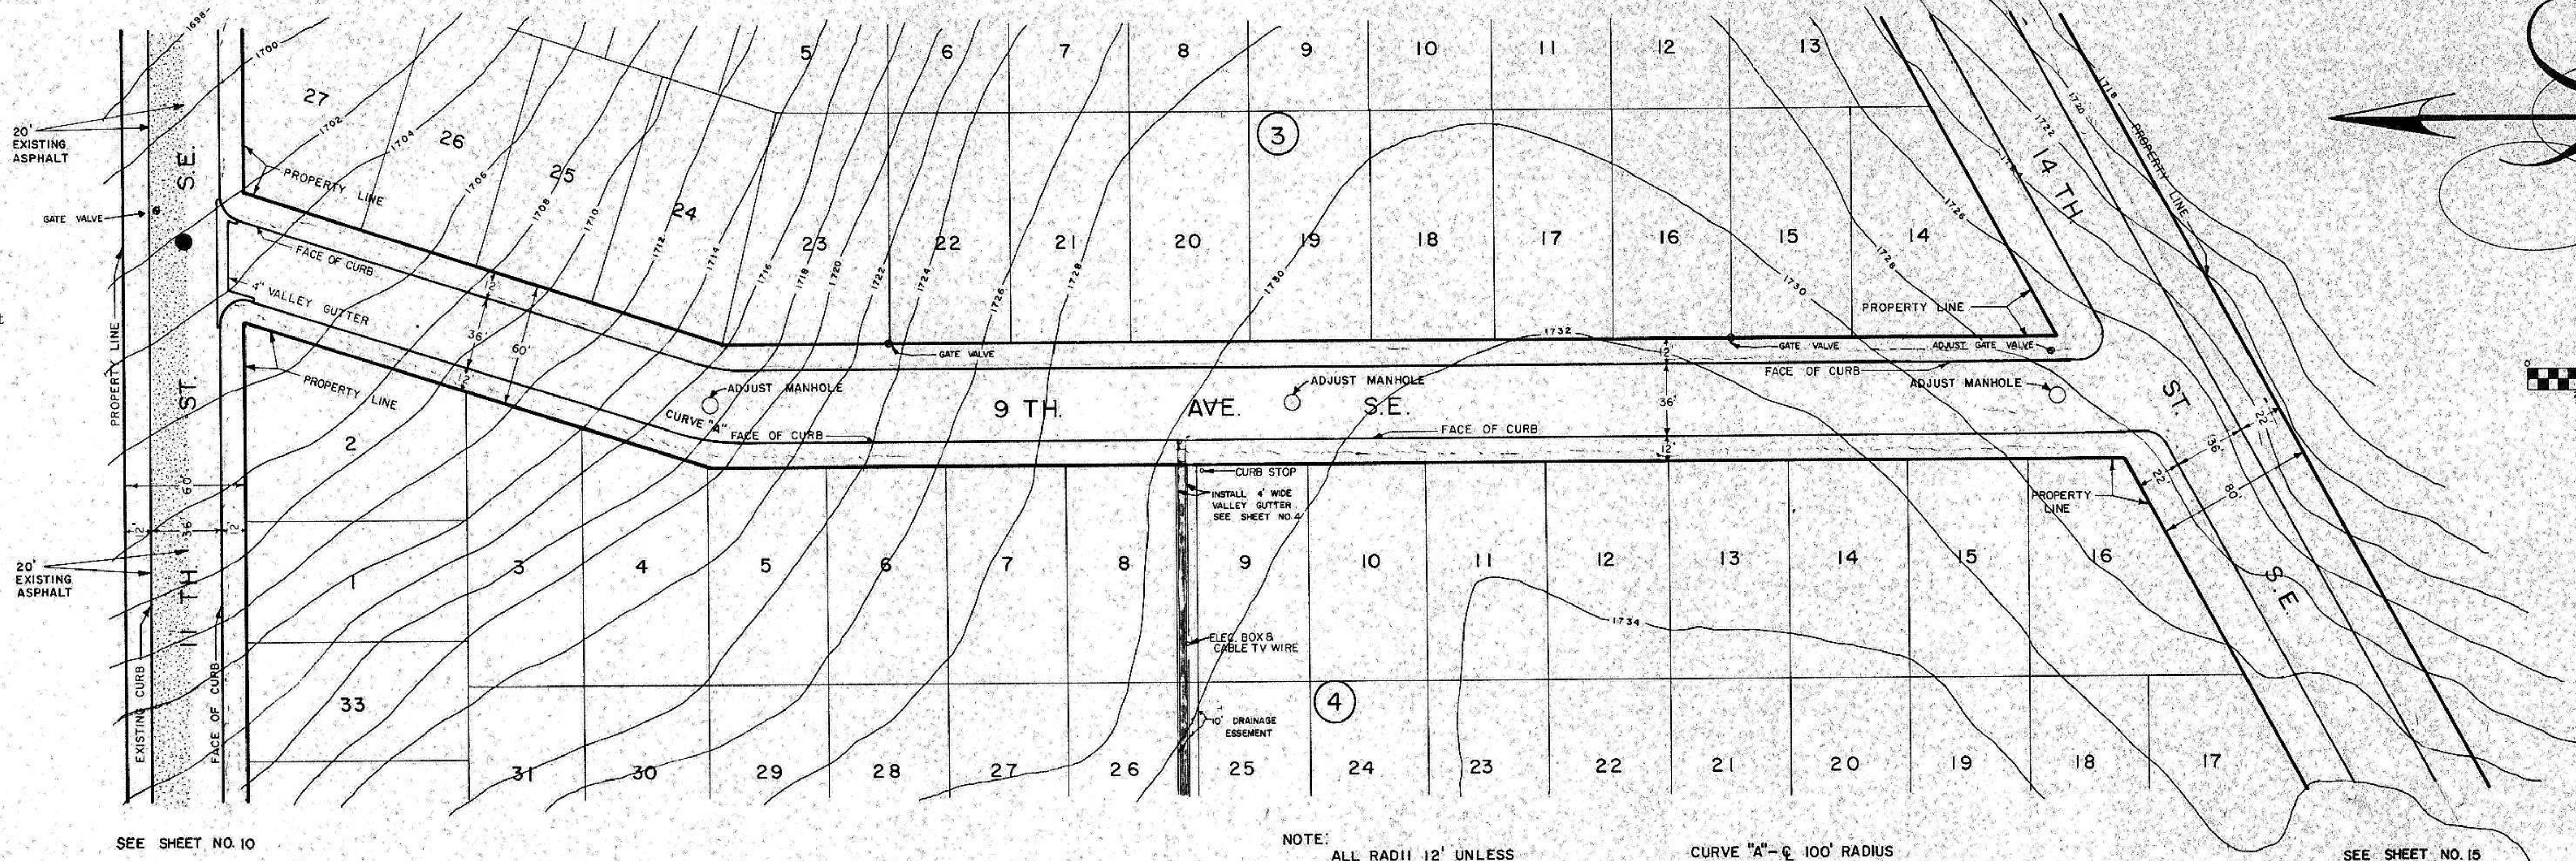


SEE SHEET NO. 10

NOTE: ALL RADII 12' UNLESS OTHERWISE STATED.
 9th, 10th, & 11th AVENUES TO HAVE SURMOUNTABLE CURB.

CURVE "A" - 6' 100' RADIUS

SEE SHEET NO. 15

PROFILE
 SURVEYED BY _____ DATE _____
 ALIGNED BY _____
 CHECKED BY _____
 RT. OF WAY CHECKED BY _____
 STRUCTURE NOTES (SEE SHEET NO. 10)
 NO. _____

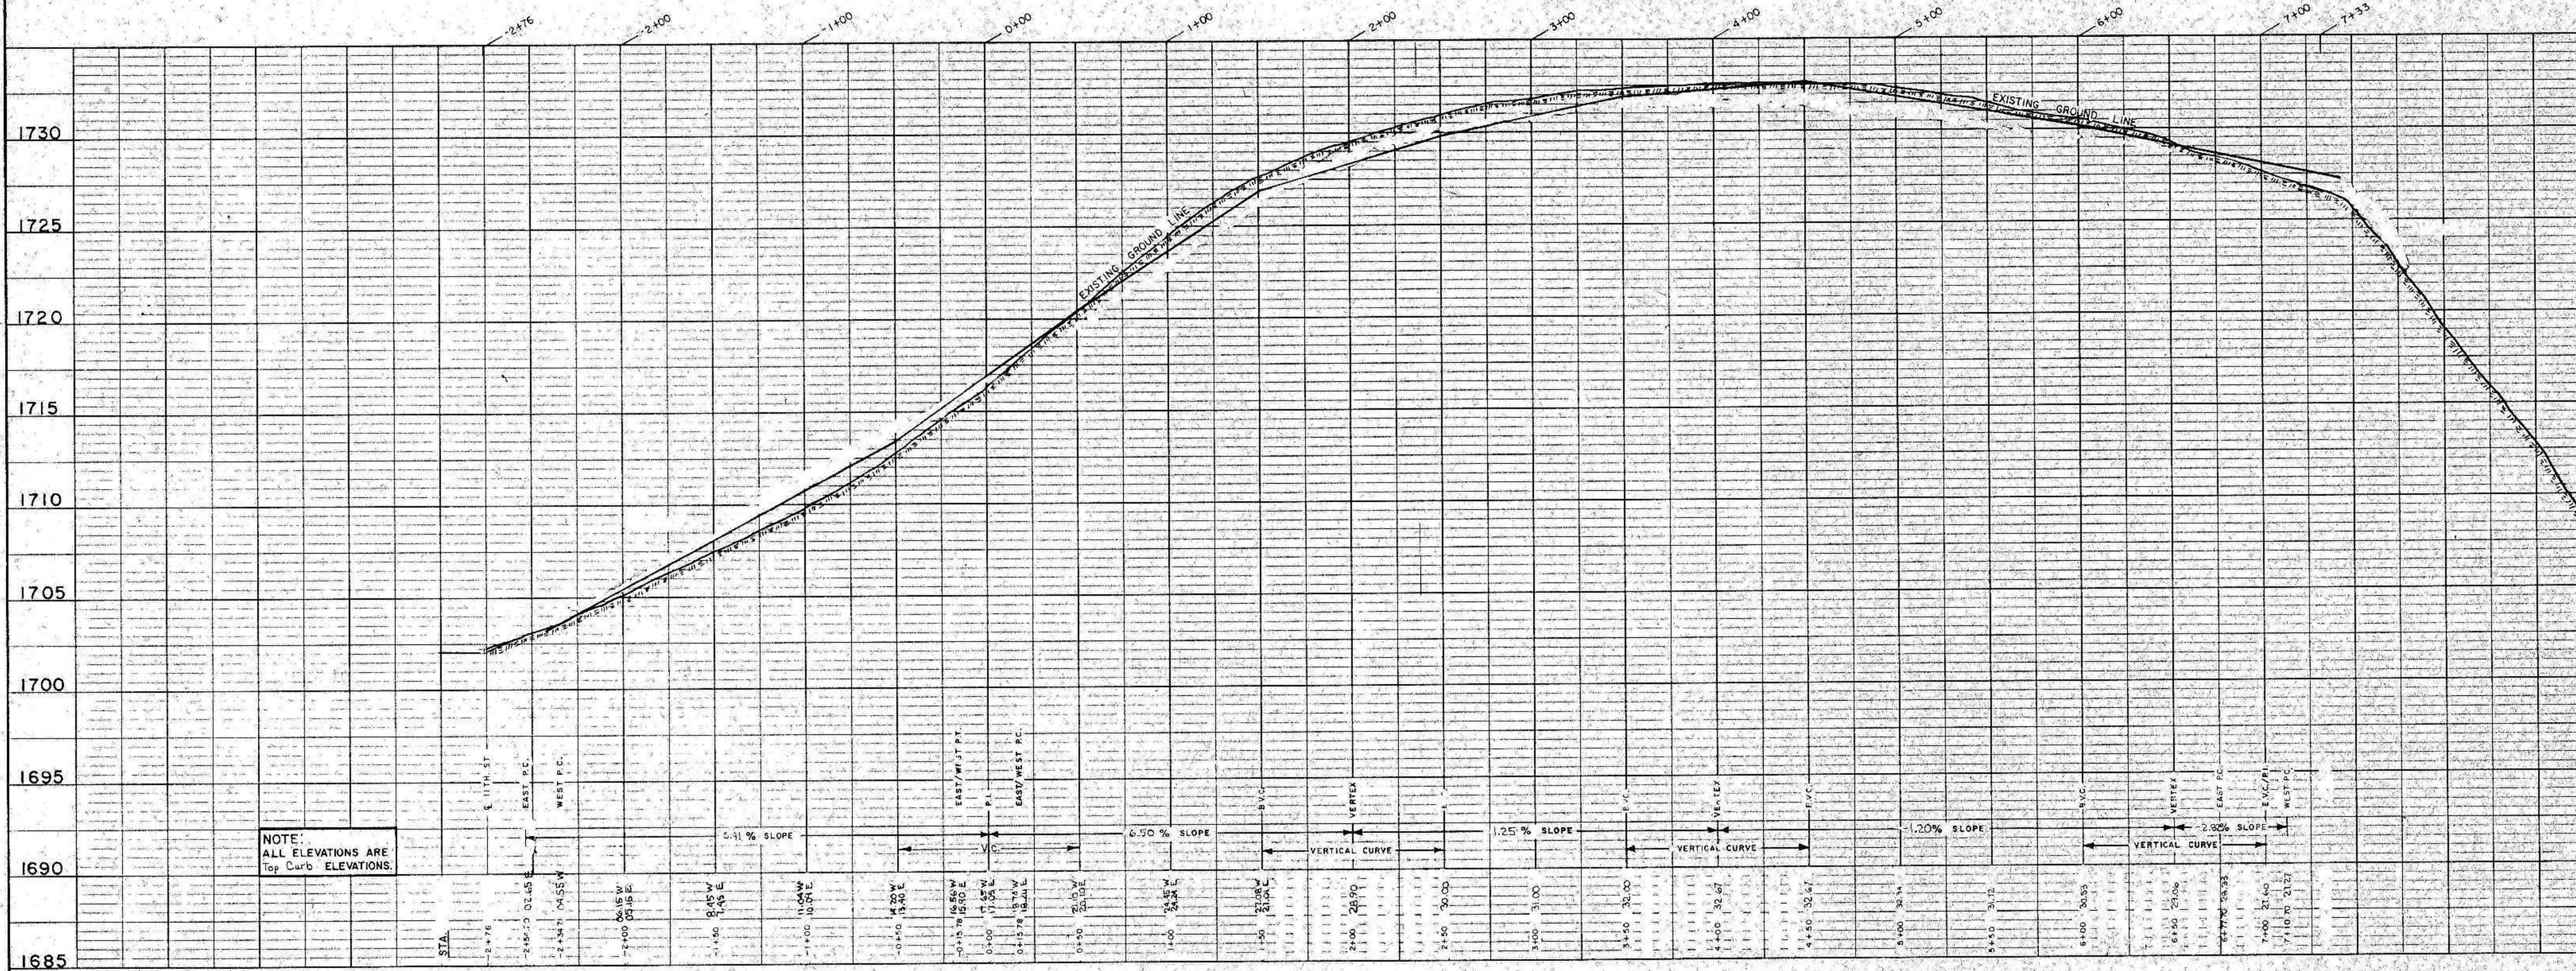

NOTE: ALL ELEVATIONS ARE Top Curb ELEVATIONS.

HORIZ. 1" = 50.0'
 VERT. 1" = 5.0'

