
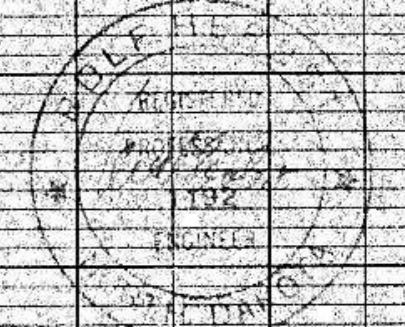
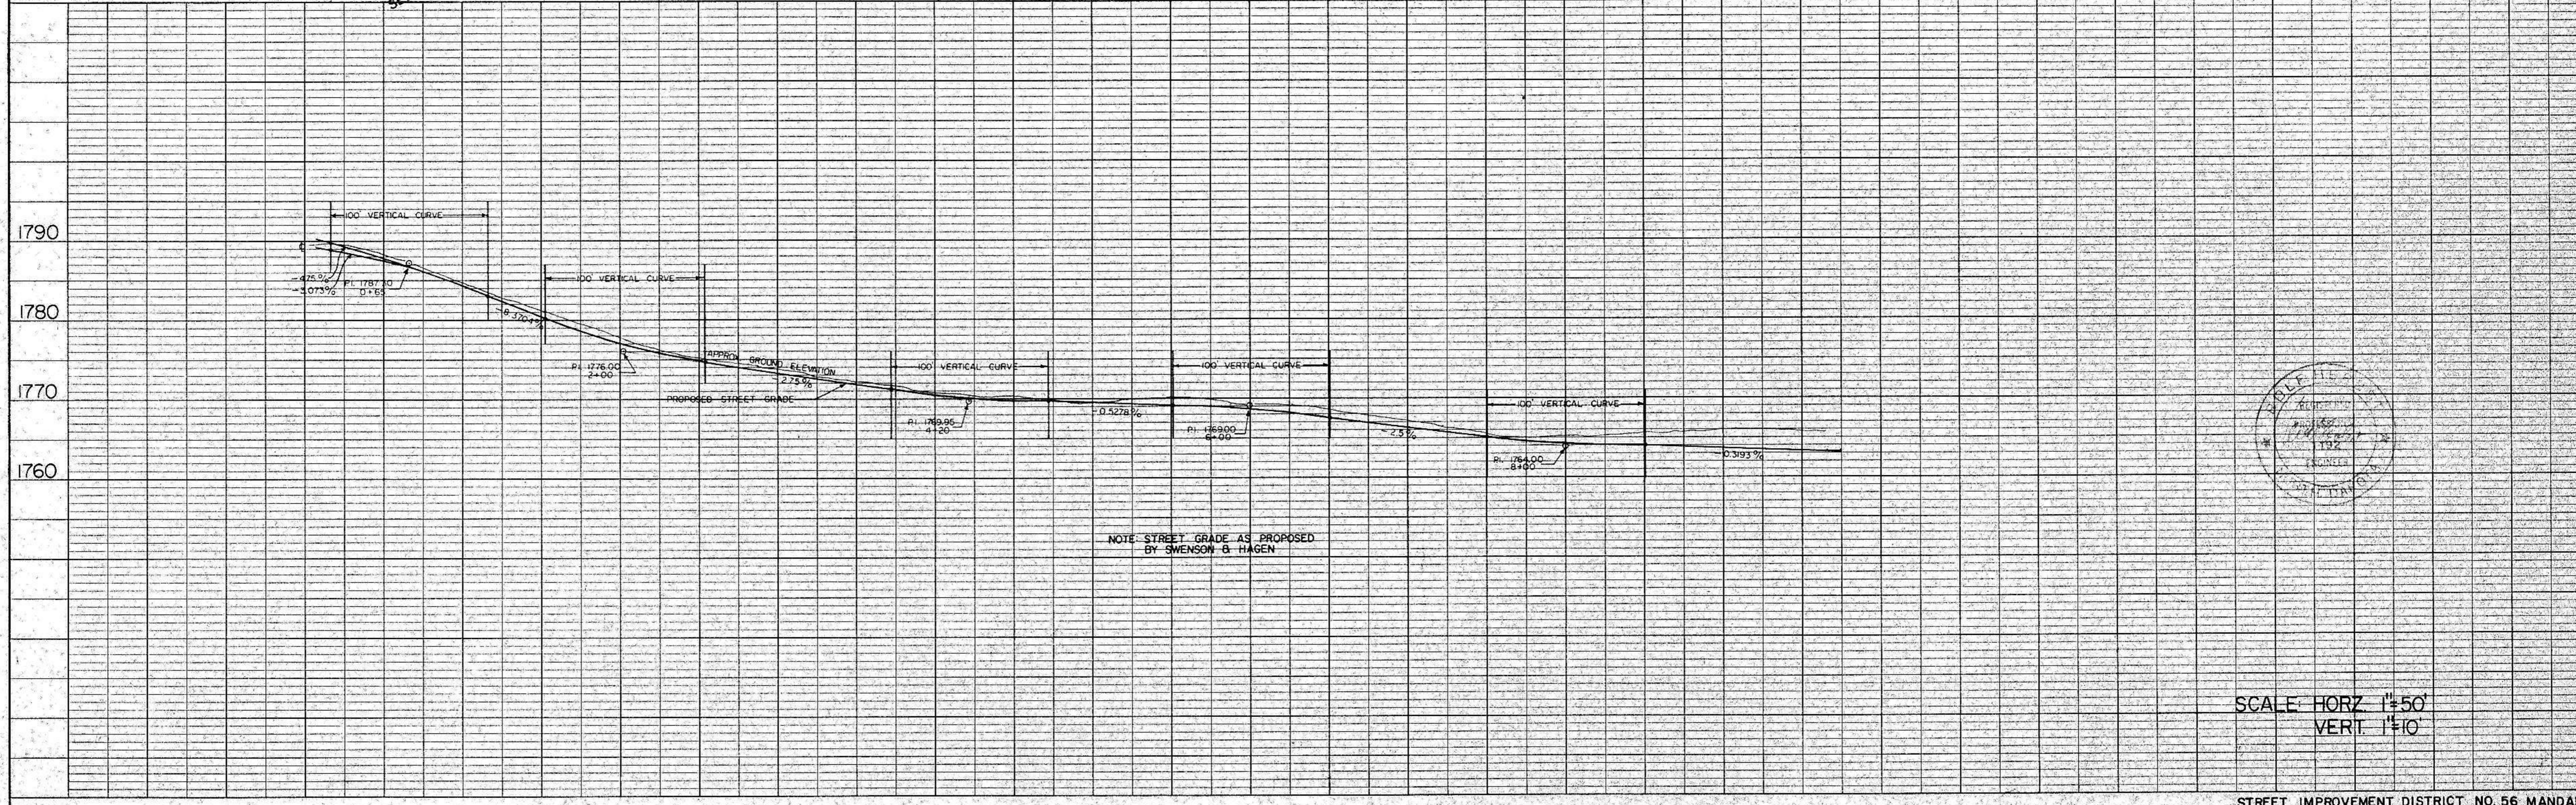


PLAN	SUBMITTED	DATE
	PLOTTED	
	NOTE BOOK	
	ALIGNMENT CHECKED	
	RT. OF WAY CHECKED	
	NO.	

PROFILE	SUBMITTED	DATE
	PLOTTED	
	NOTE BOOK	
	GRADES CHECKED	
	B. M. NOTED	
	STRUCTURE NOTATIONS CHECKED	
	NO.	

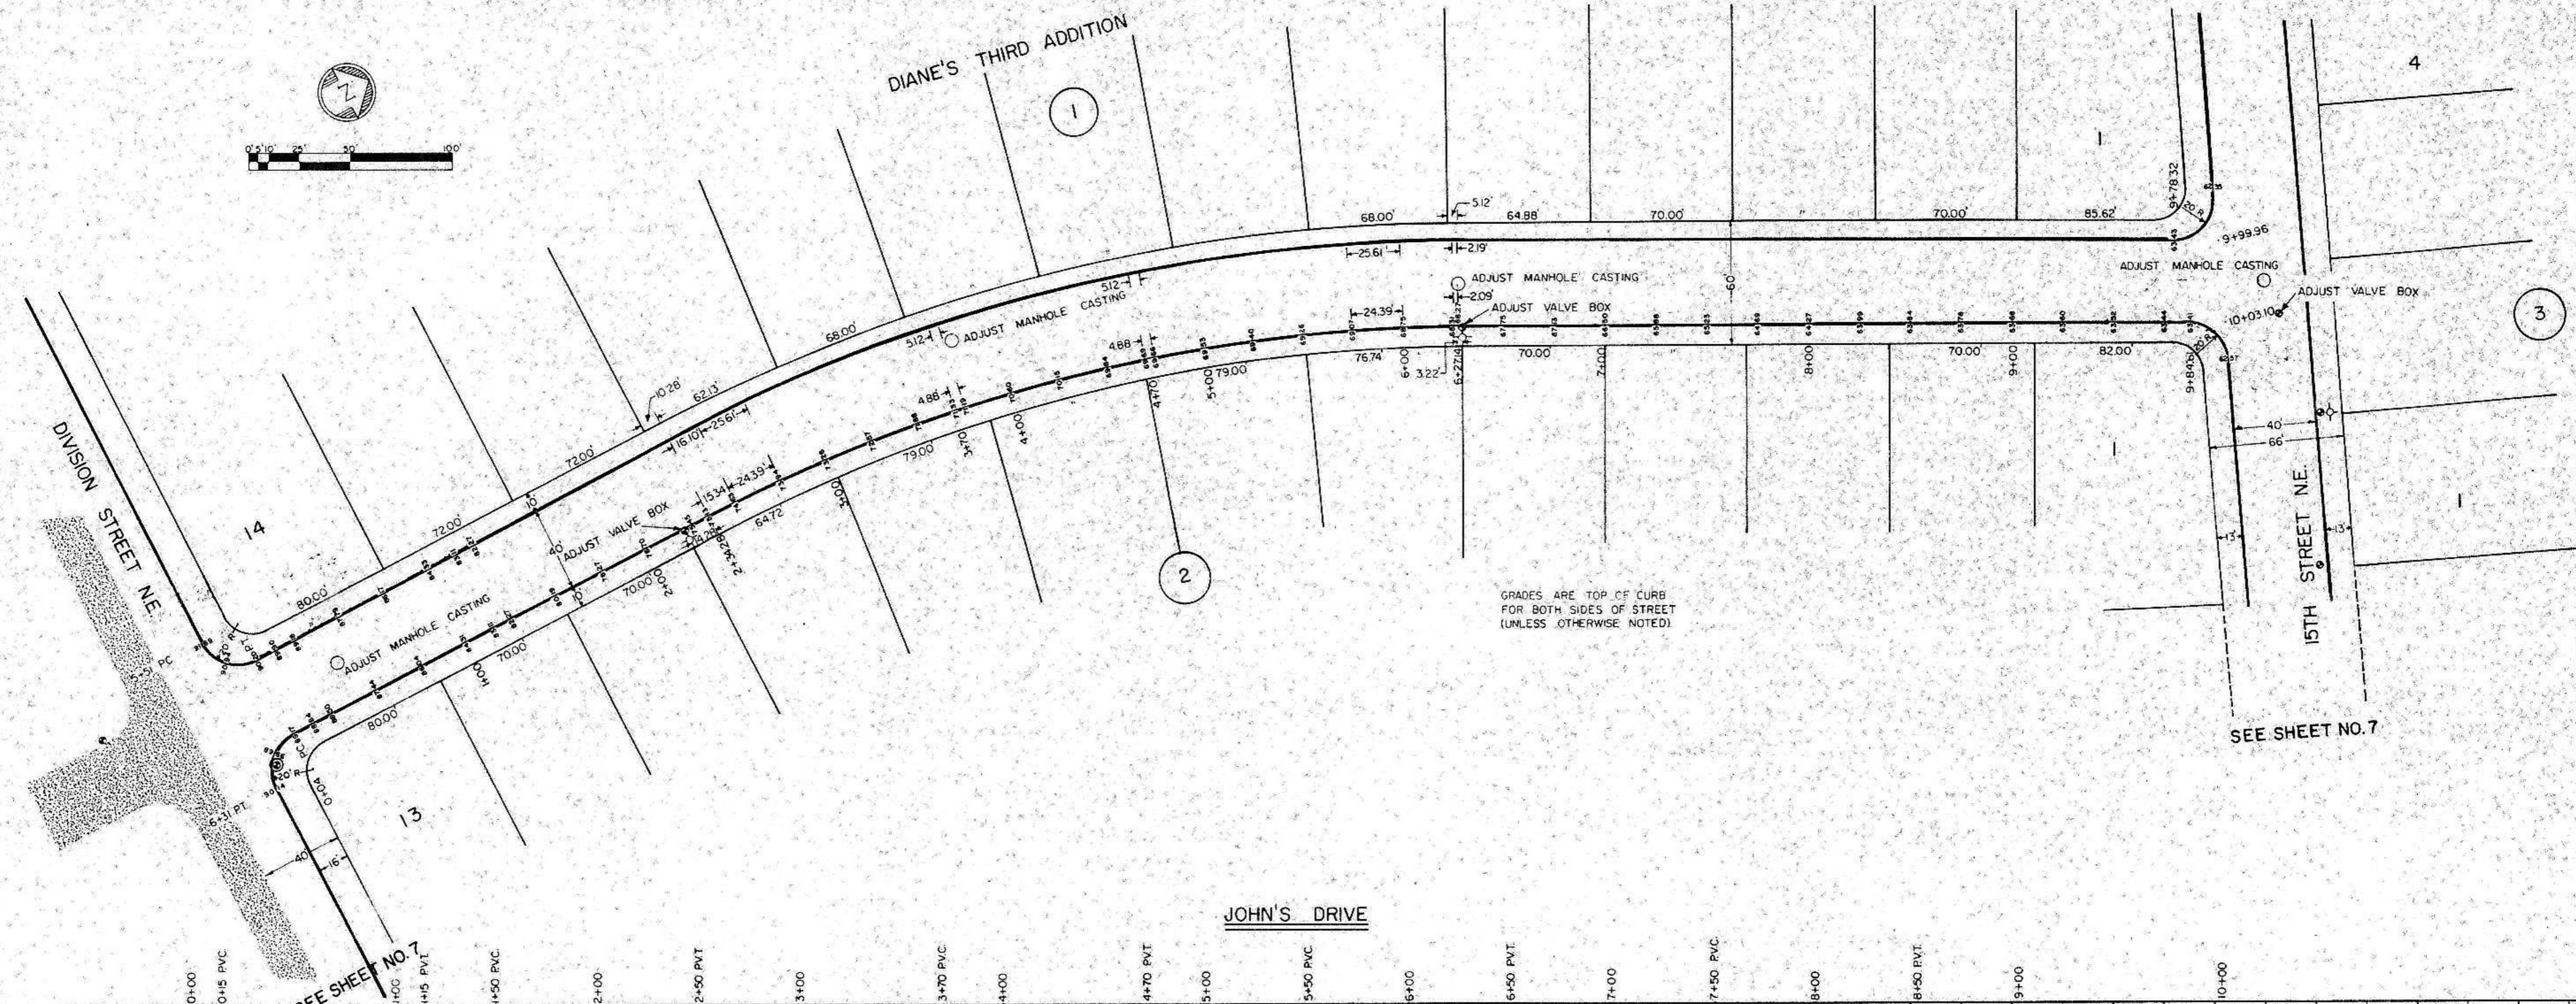

SCALE: HORIZ. 1"=50'  
VERT. 1"=10'