
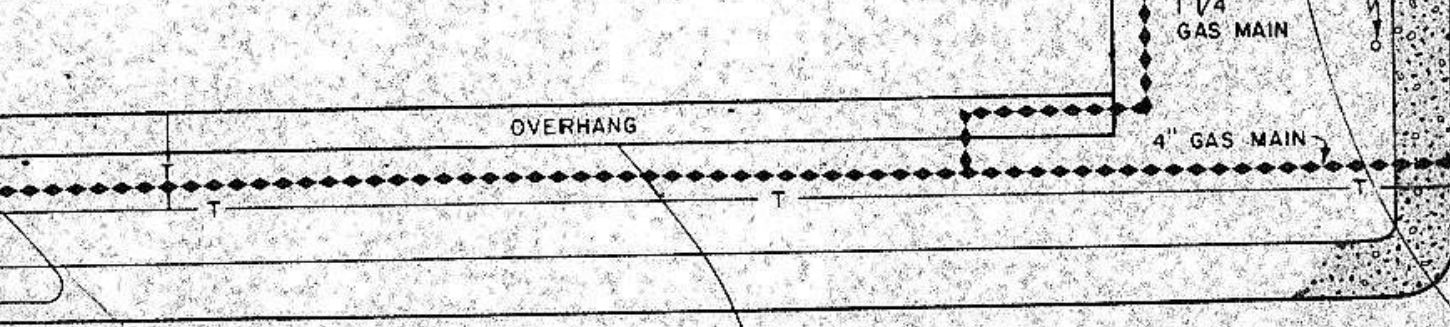
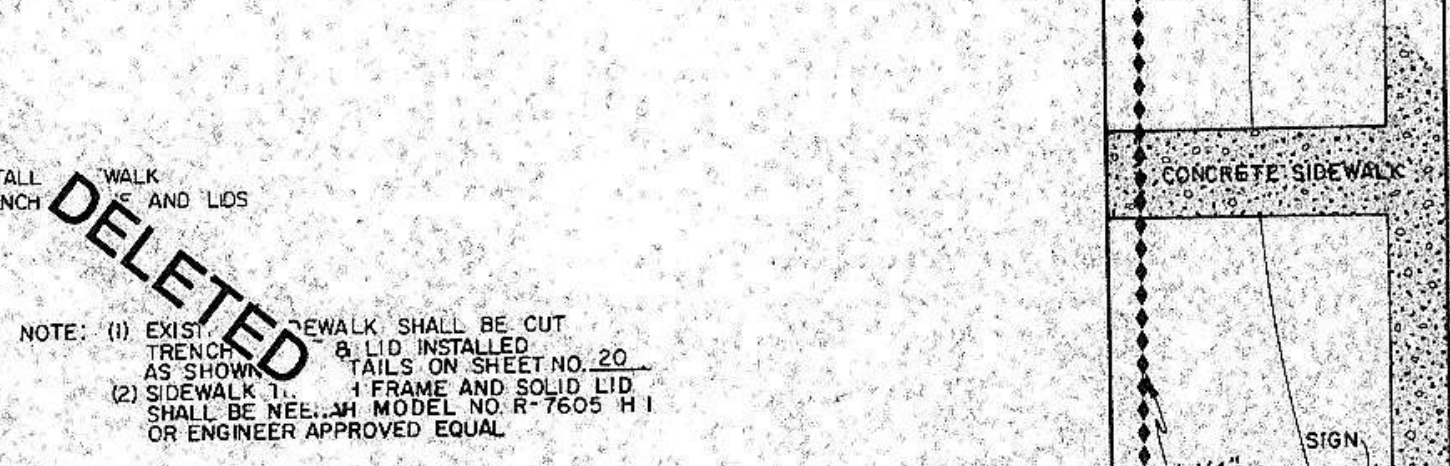
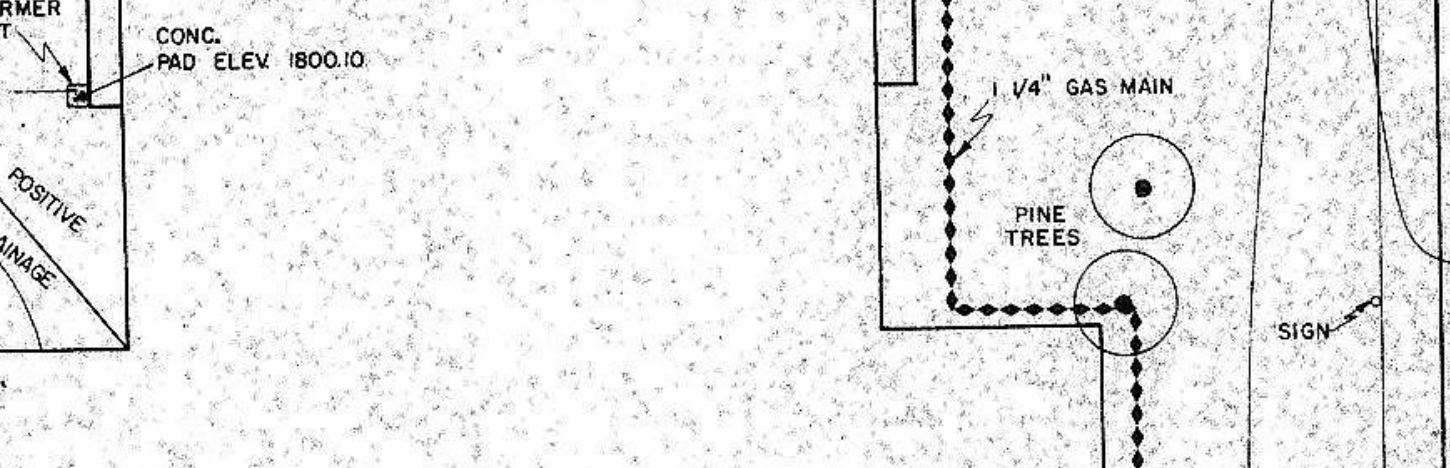
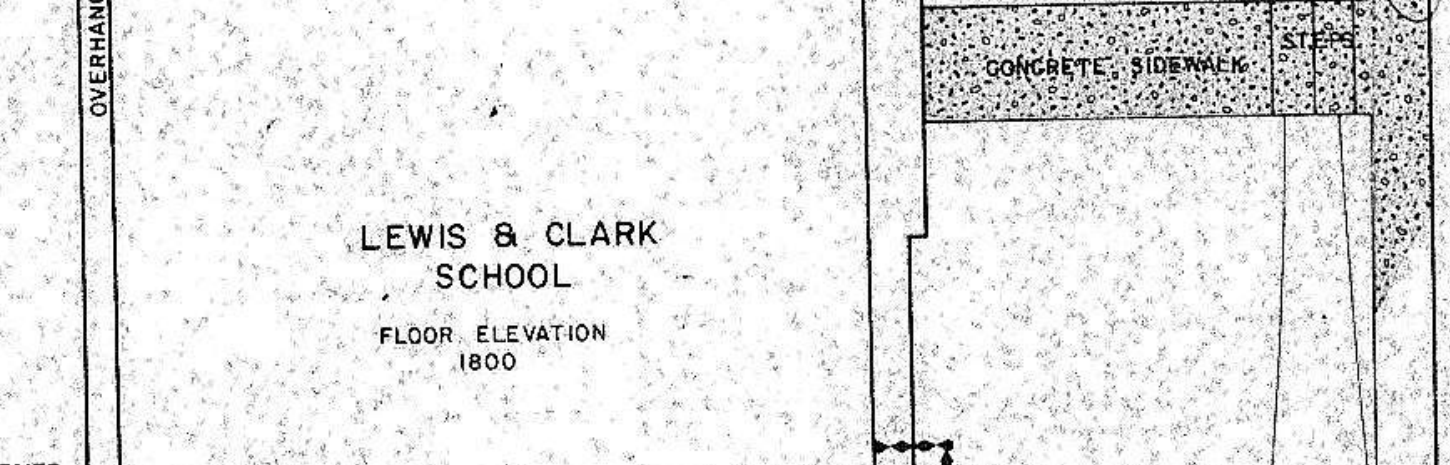
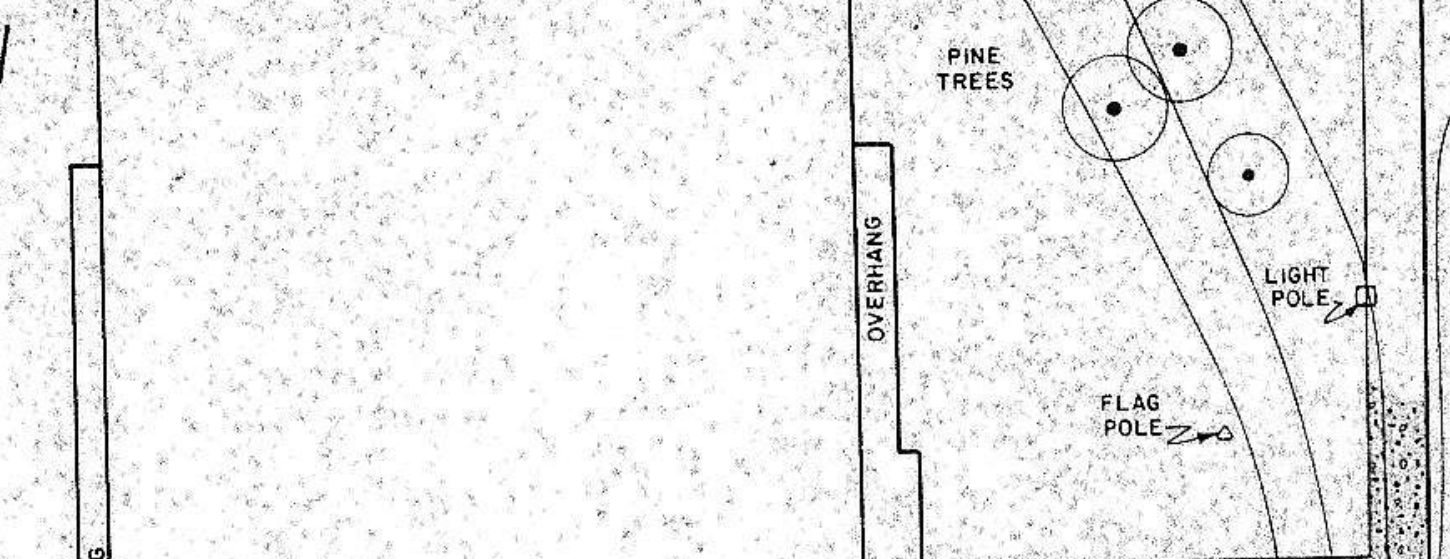
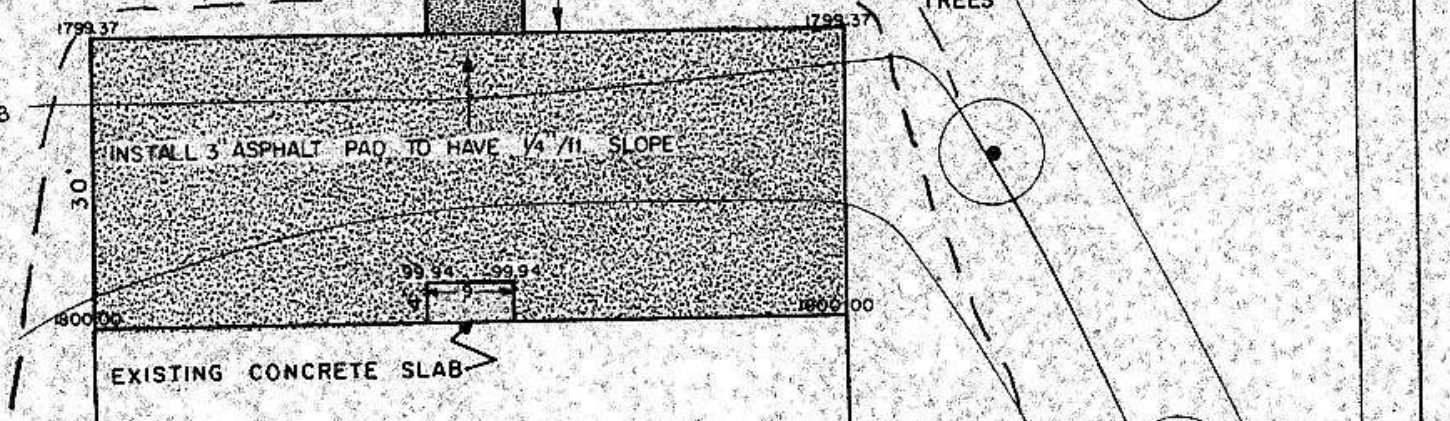
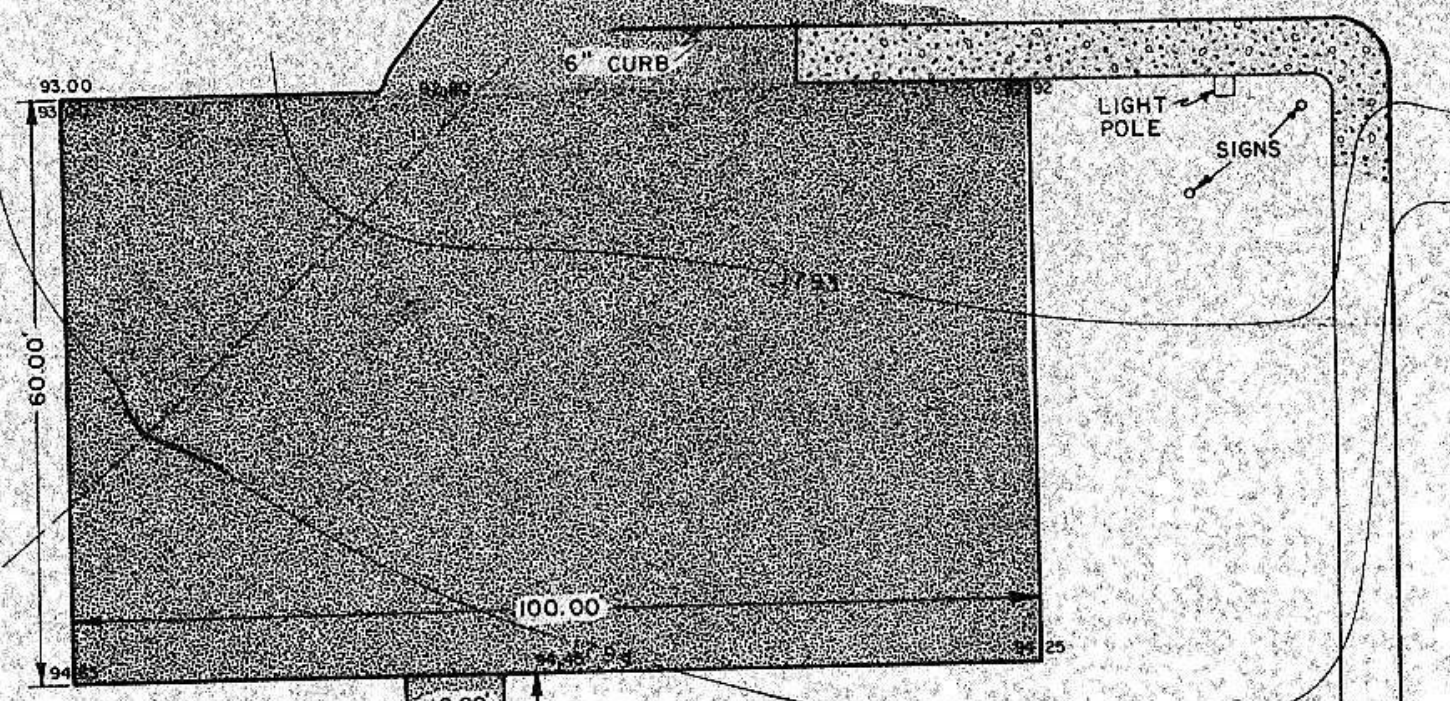


SCALE: 1"=20'  
MAY 1978

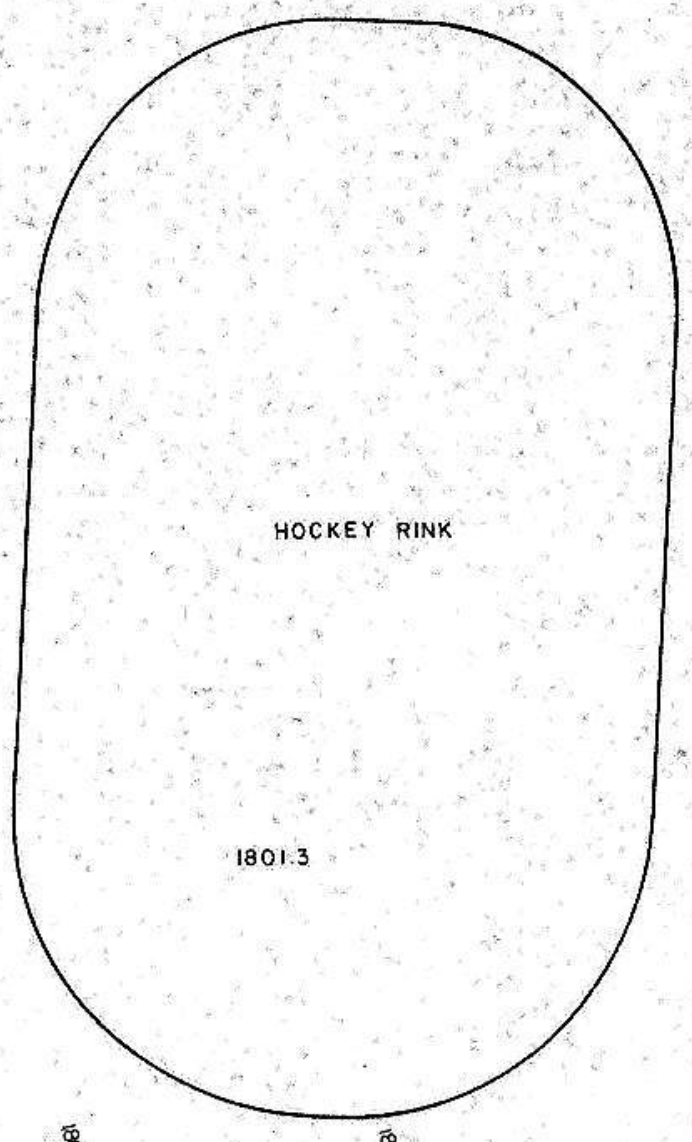

NOTE: SHAPE AREA AROUND TO BLOCK-IV  
INSTALL 3 1/2" ASPHALT MAT (EROSION BARRIER)

NOTE: ALL AREAS THAT WERE RESHAPED SHALL BE SEEDED

NOTE: (1) EXISTING SIDEWALK SHALL BE CUT TRENCH & LID INSTALLED AS SHOWN IN TALLS ON SHEET NO. 20 (2) SIDEWALK 1" FRAME AND SOLID LID SHALL BE NEEL-MI MODEL NO. 4-760P N-1 OR ENGINEER APPROVED EQUAL

LEGEND

- 1799 — = EXISTING CONTOUR LINES
- - - 1798 - - - = PROPOSED CONTOUR LINES (THIS PROJECT)
- = INDICATES AREAS TO BE PAVED

**THIS AREA DELETED**

**DELETED**

16 TH. ST. NW.

14 TH. ST. NW.

6 TH. AVE. NW.

