

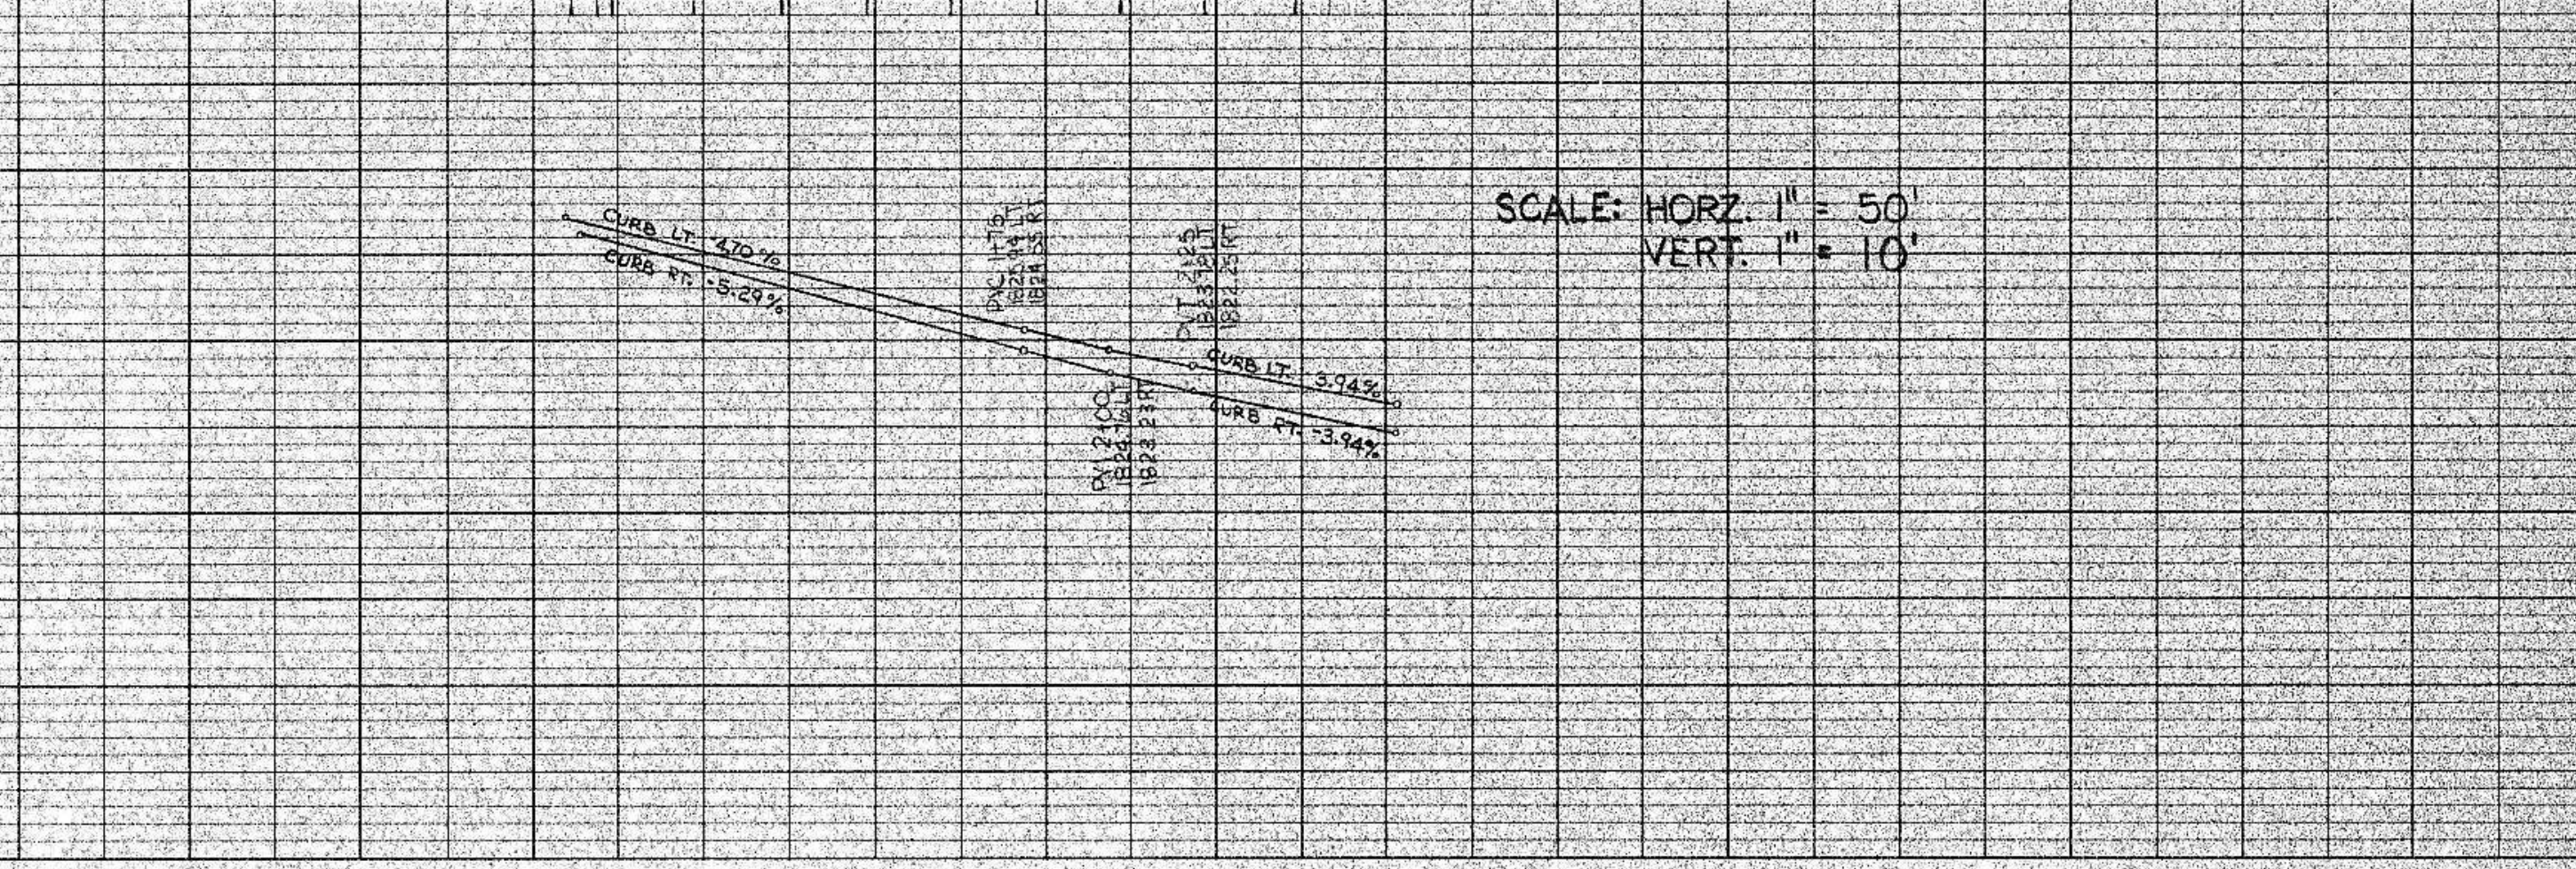
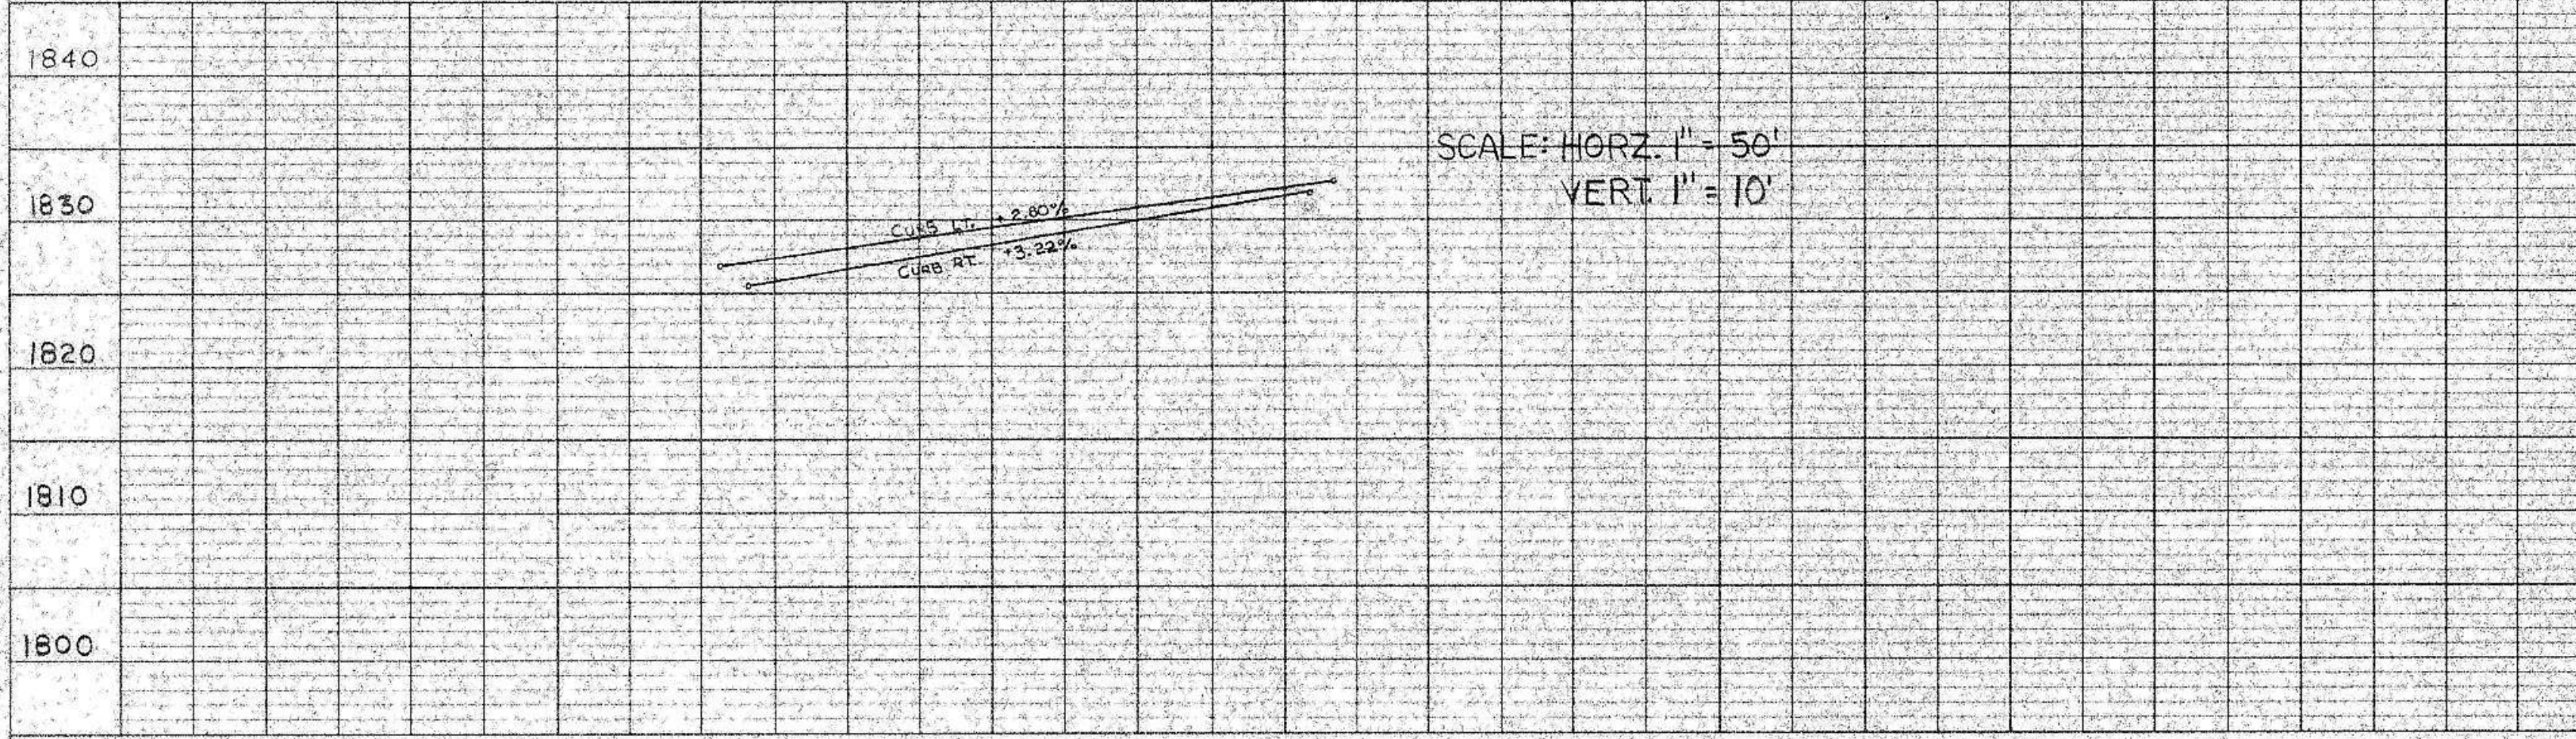
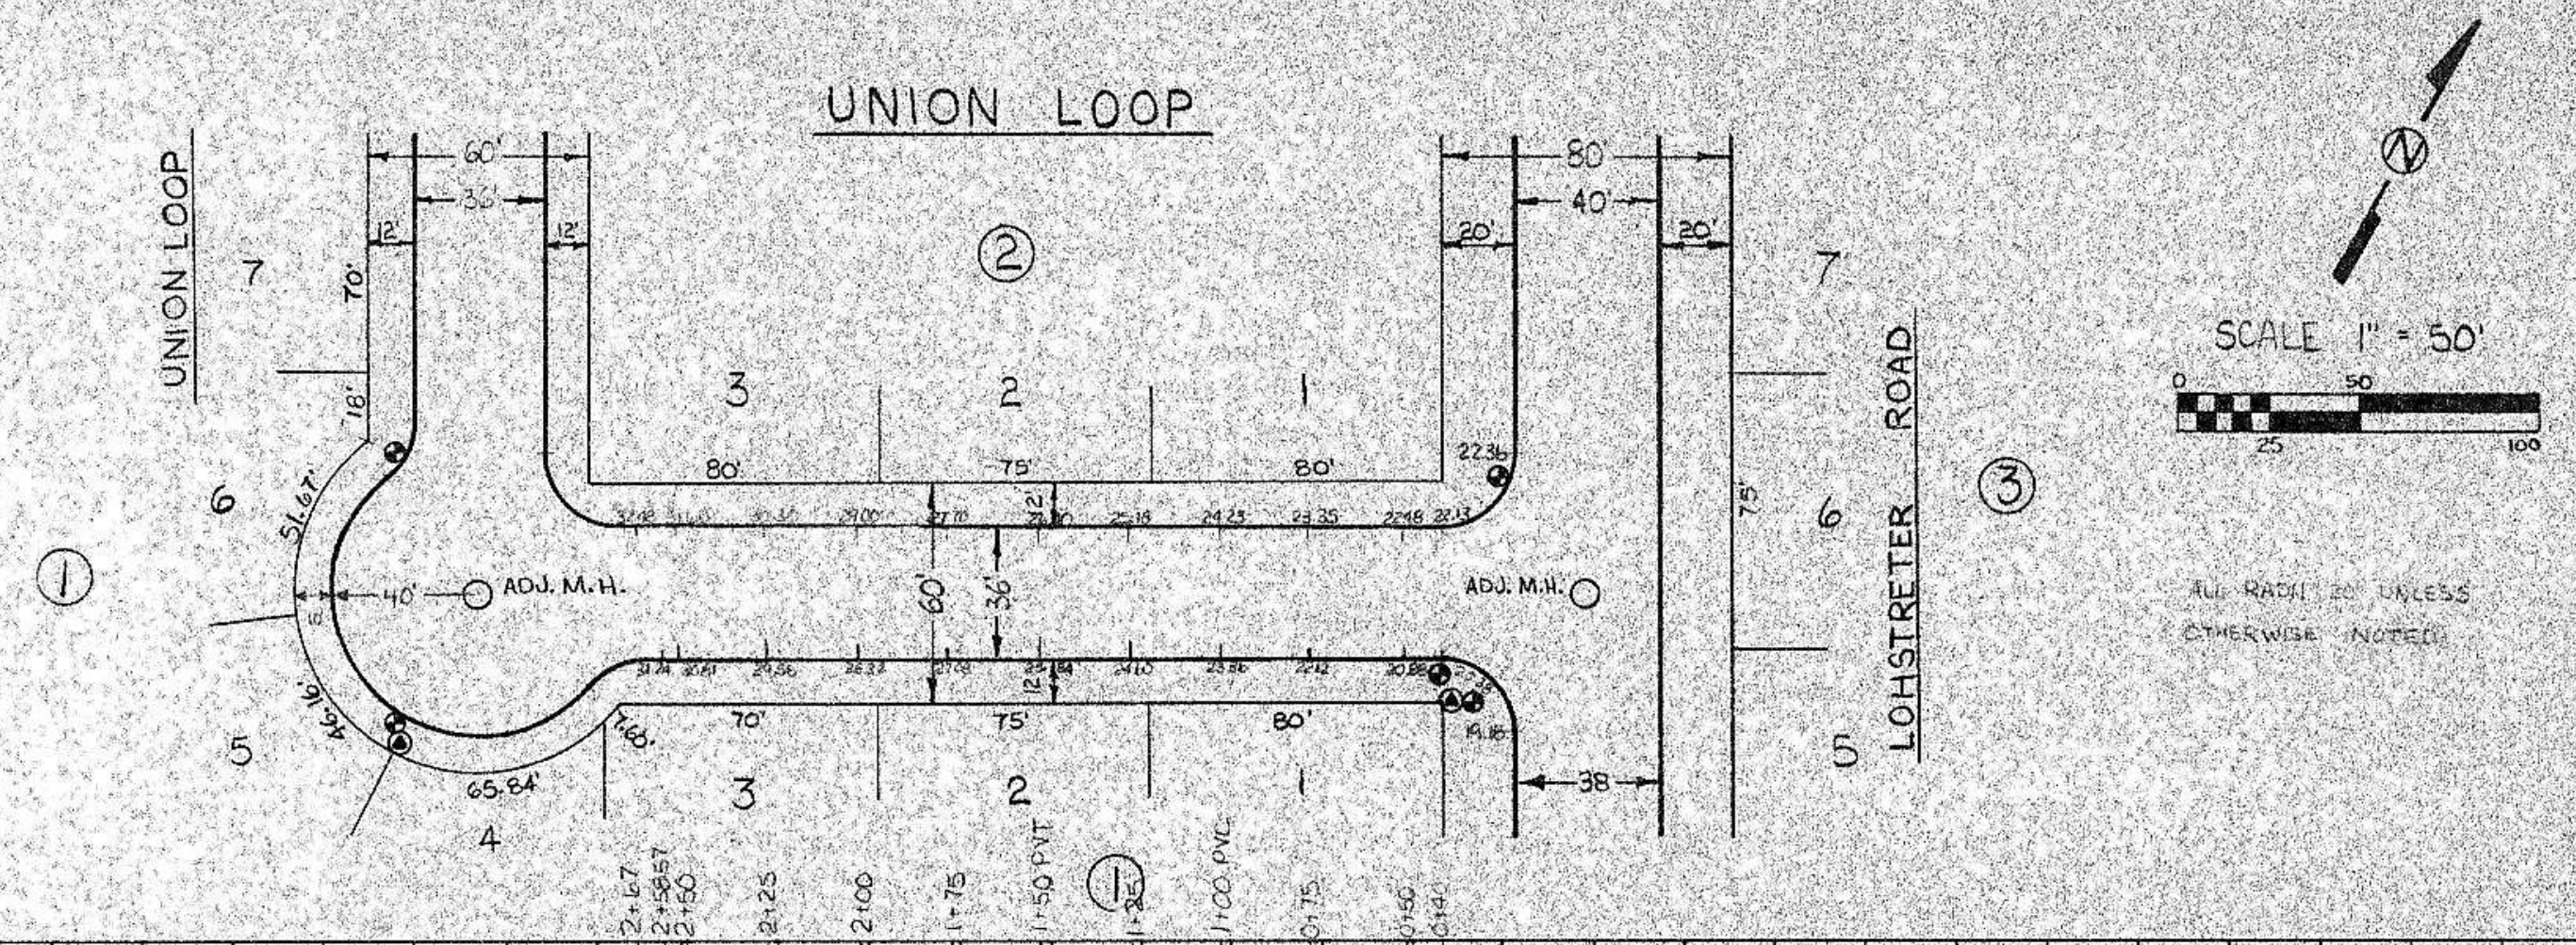
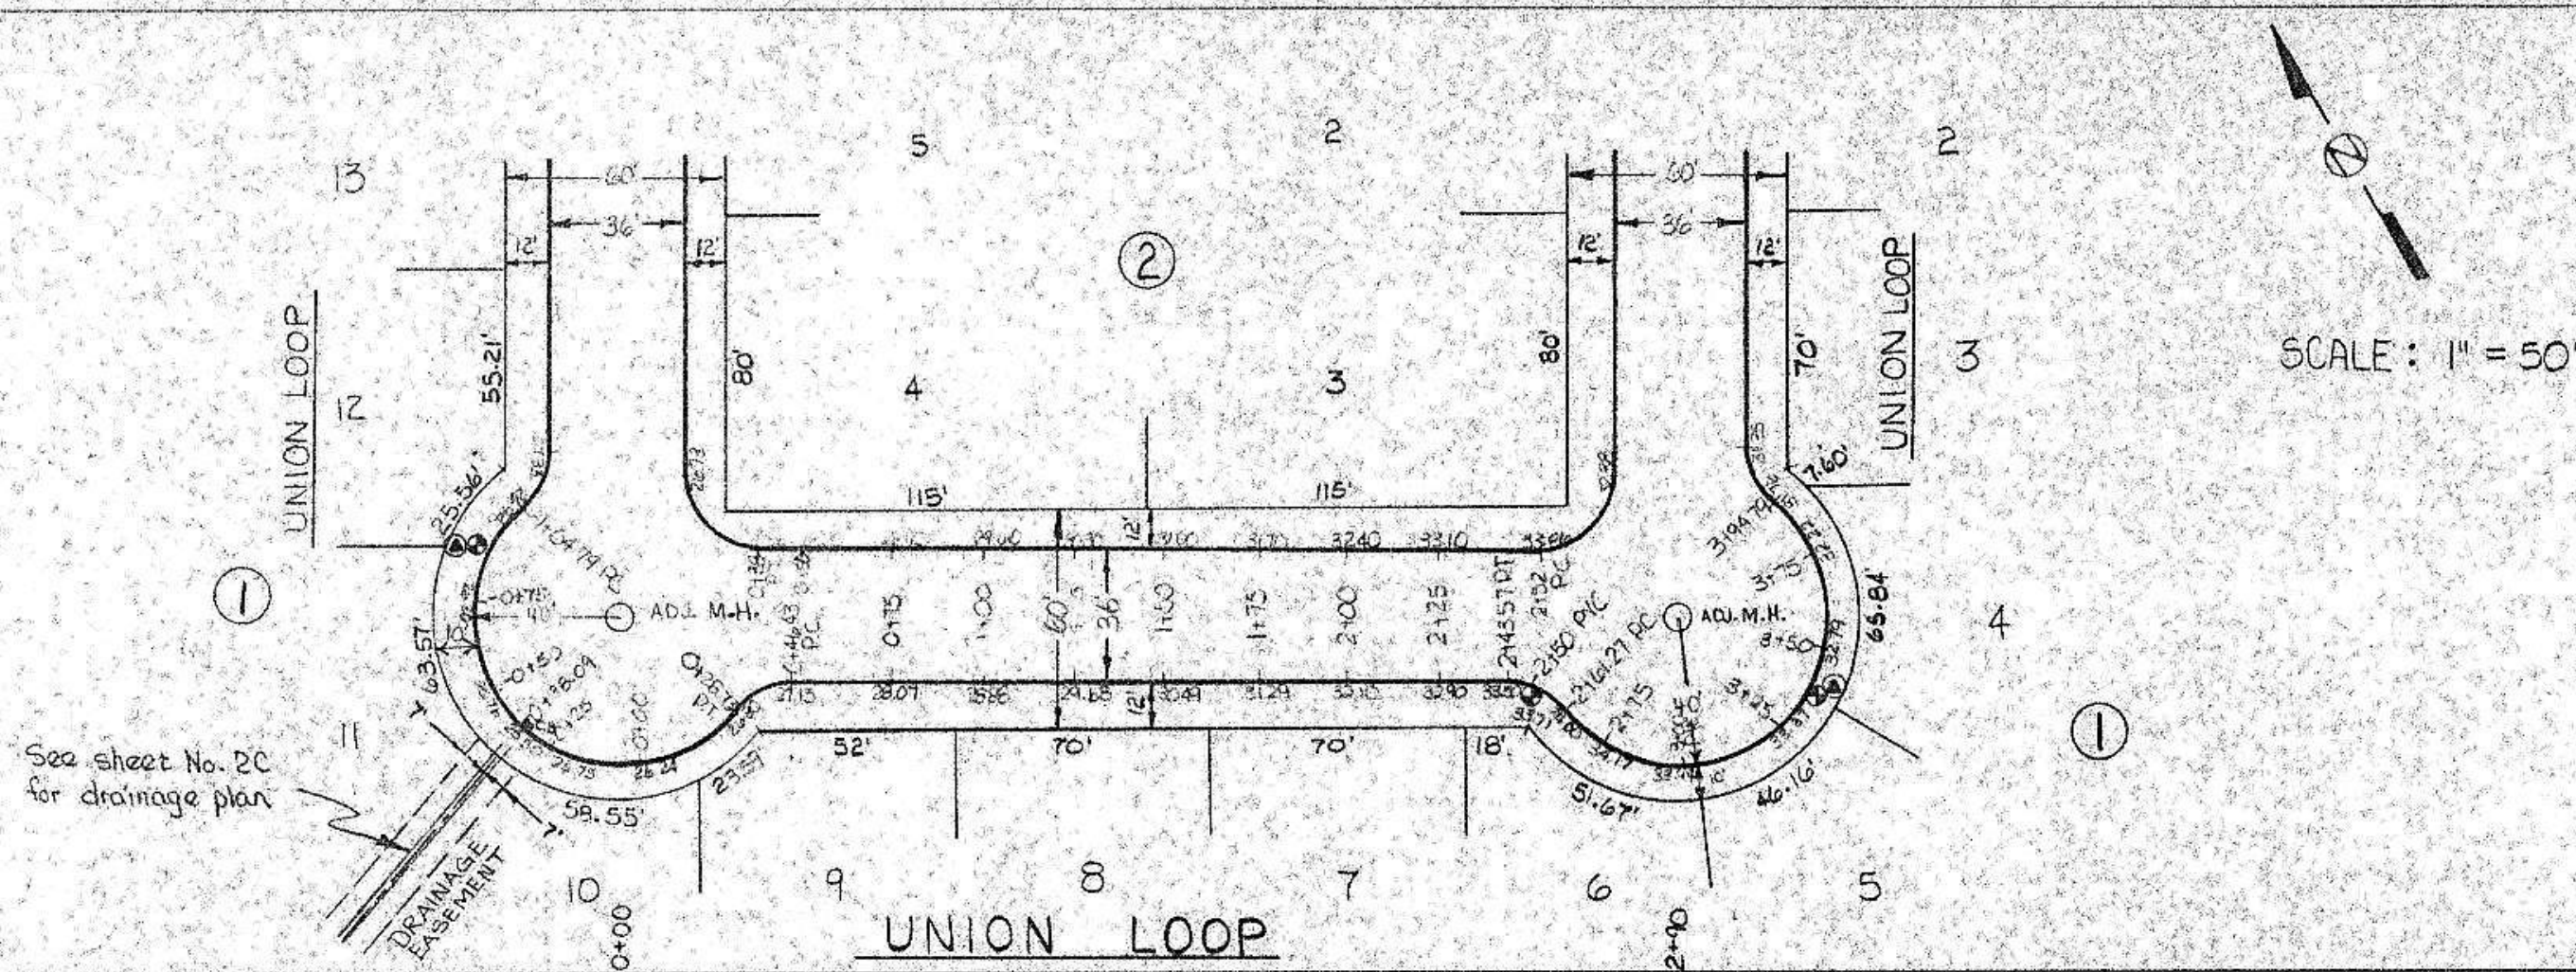


DATE: \_\_\_\_\_ BY: \_\_\_\_\_  
 SUPERVISOR: \_\_\_\_\_  
 CHECKED: \_\_\_\_\_  
 NOTE BOOK: \_\_\_\_\_  
 NO. OF WAYS CHECKED: \_\_\_\_\_

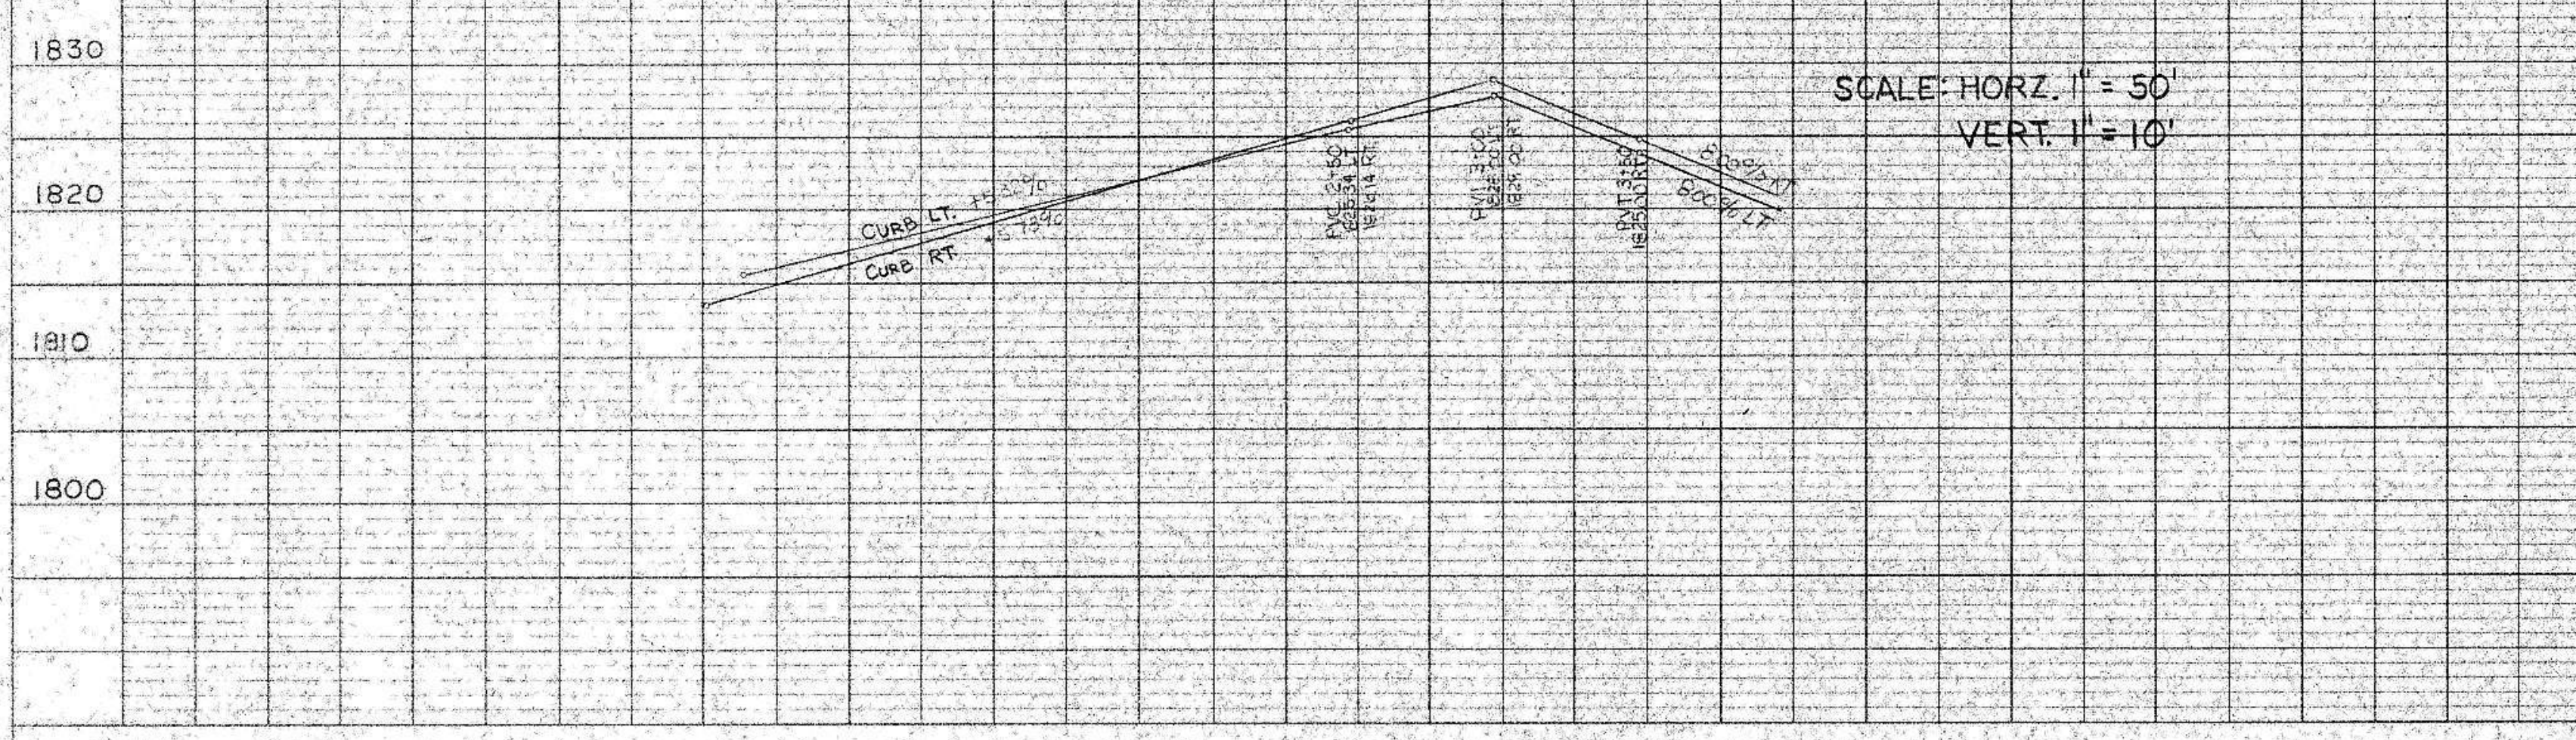

DATE: \_\_\_\_\_ BY: \_\_\_\_\_  
 SUPERVISOR: \_\_\_\_\_  
 CHECKED: \_\_\_\_\_  
 NOTE BOOK: \_\_\_\_\_  
 NO. OF WAYS CHECKED: \_\_\_\_\_

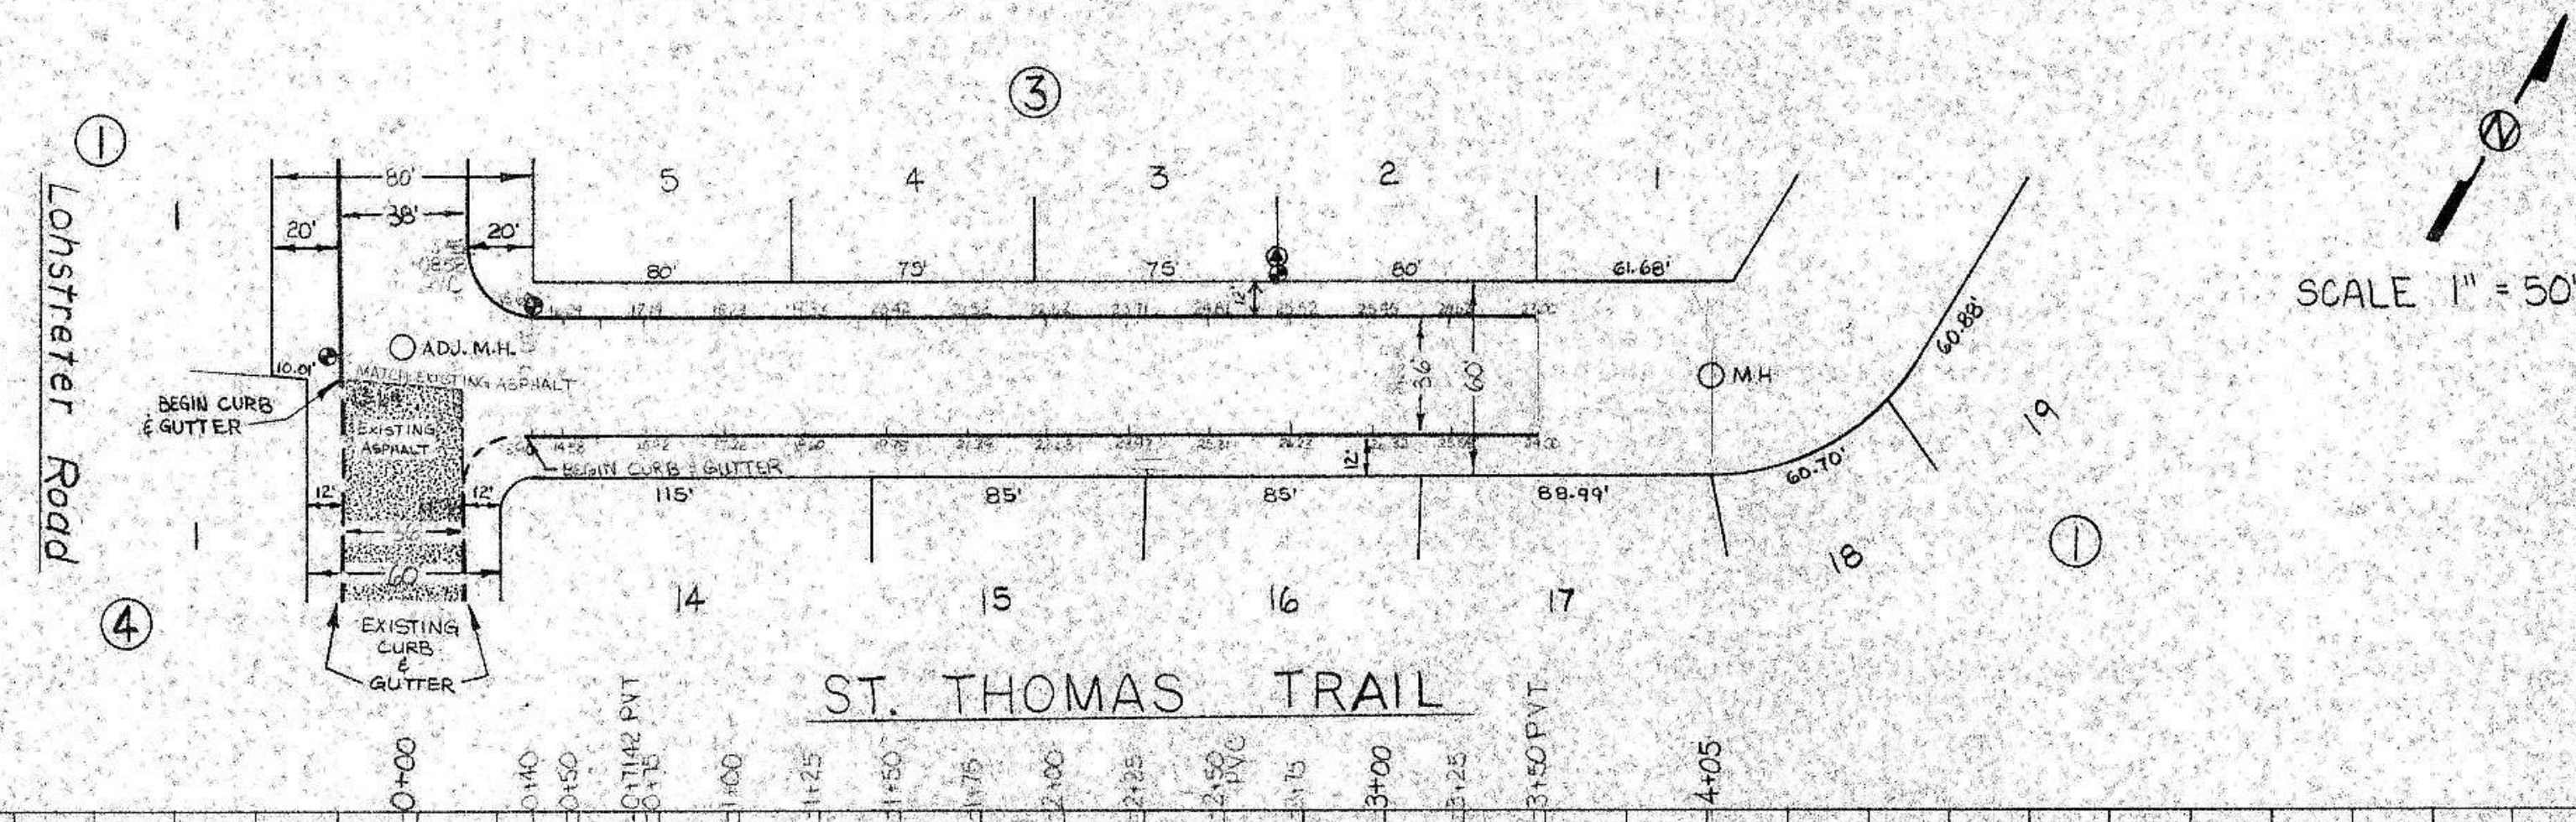

HIGHWAY FEDERAL AID SHEET  
 PLATE 2-DOUBLE PLAN AND PROFILE-FULL LINE  
 PRINTED IN U.S.A.

ASBUILT CONSTRUCTION DRAWINGS

STREET IMPROVEMENT DISTRICT NO. 56 MANDA

CHANGE ORDER #1  
 SHEET NO. 2A OF 23