


50TH AVE. N.W.
 0+00 TO 10+00

PLAN
 CHECKED BY: [Signature]
 DATE: [Date]
 NOTE BOOK, ALGEBRA CHECKED
 BY: [Signature]
 NO. [Number]

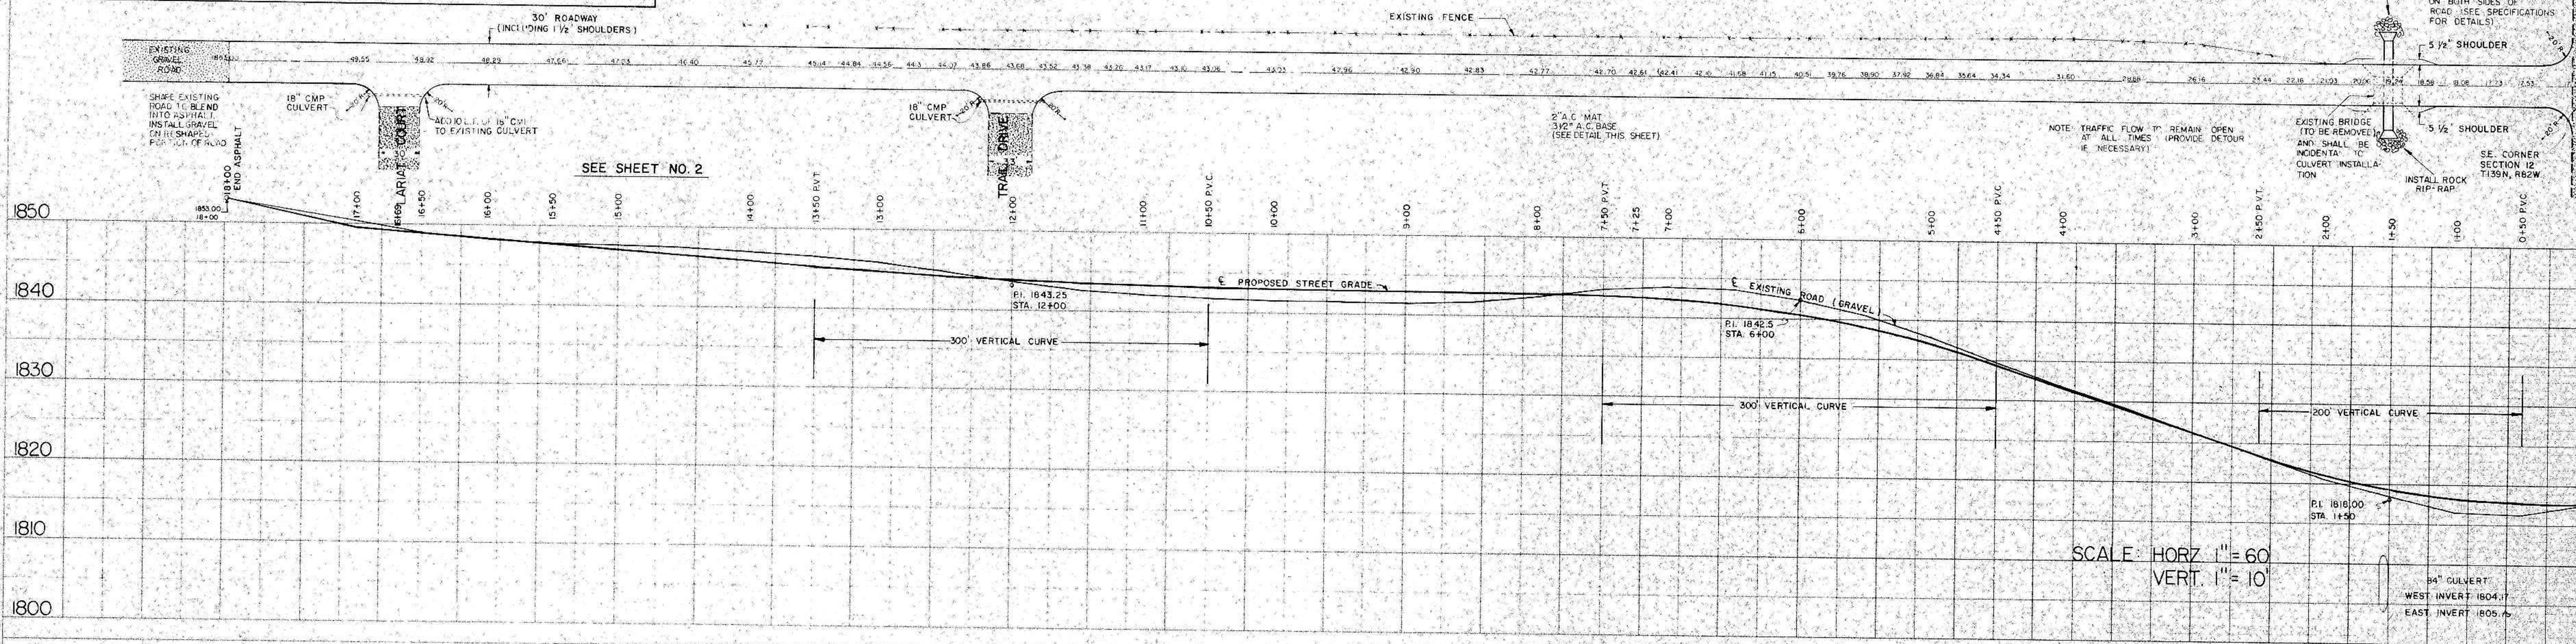

PROFILE
 CHECKED BY: [Signature]
 DATE: [Date]
 NOTE BOOK, ALGEBRA CHECKED
 BY: [Signature]
 NO. [Number]

MANDAN AVENUE

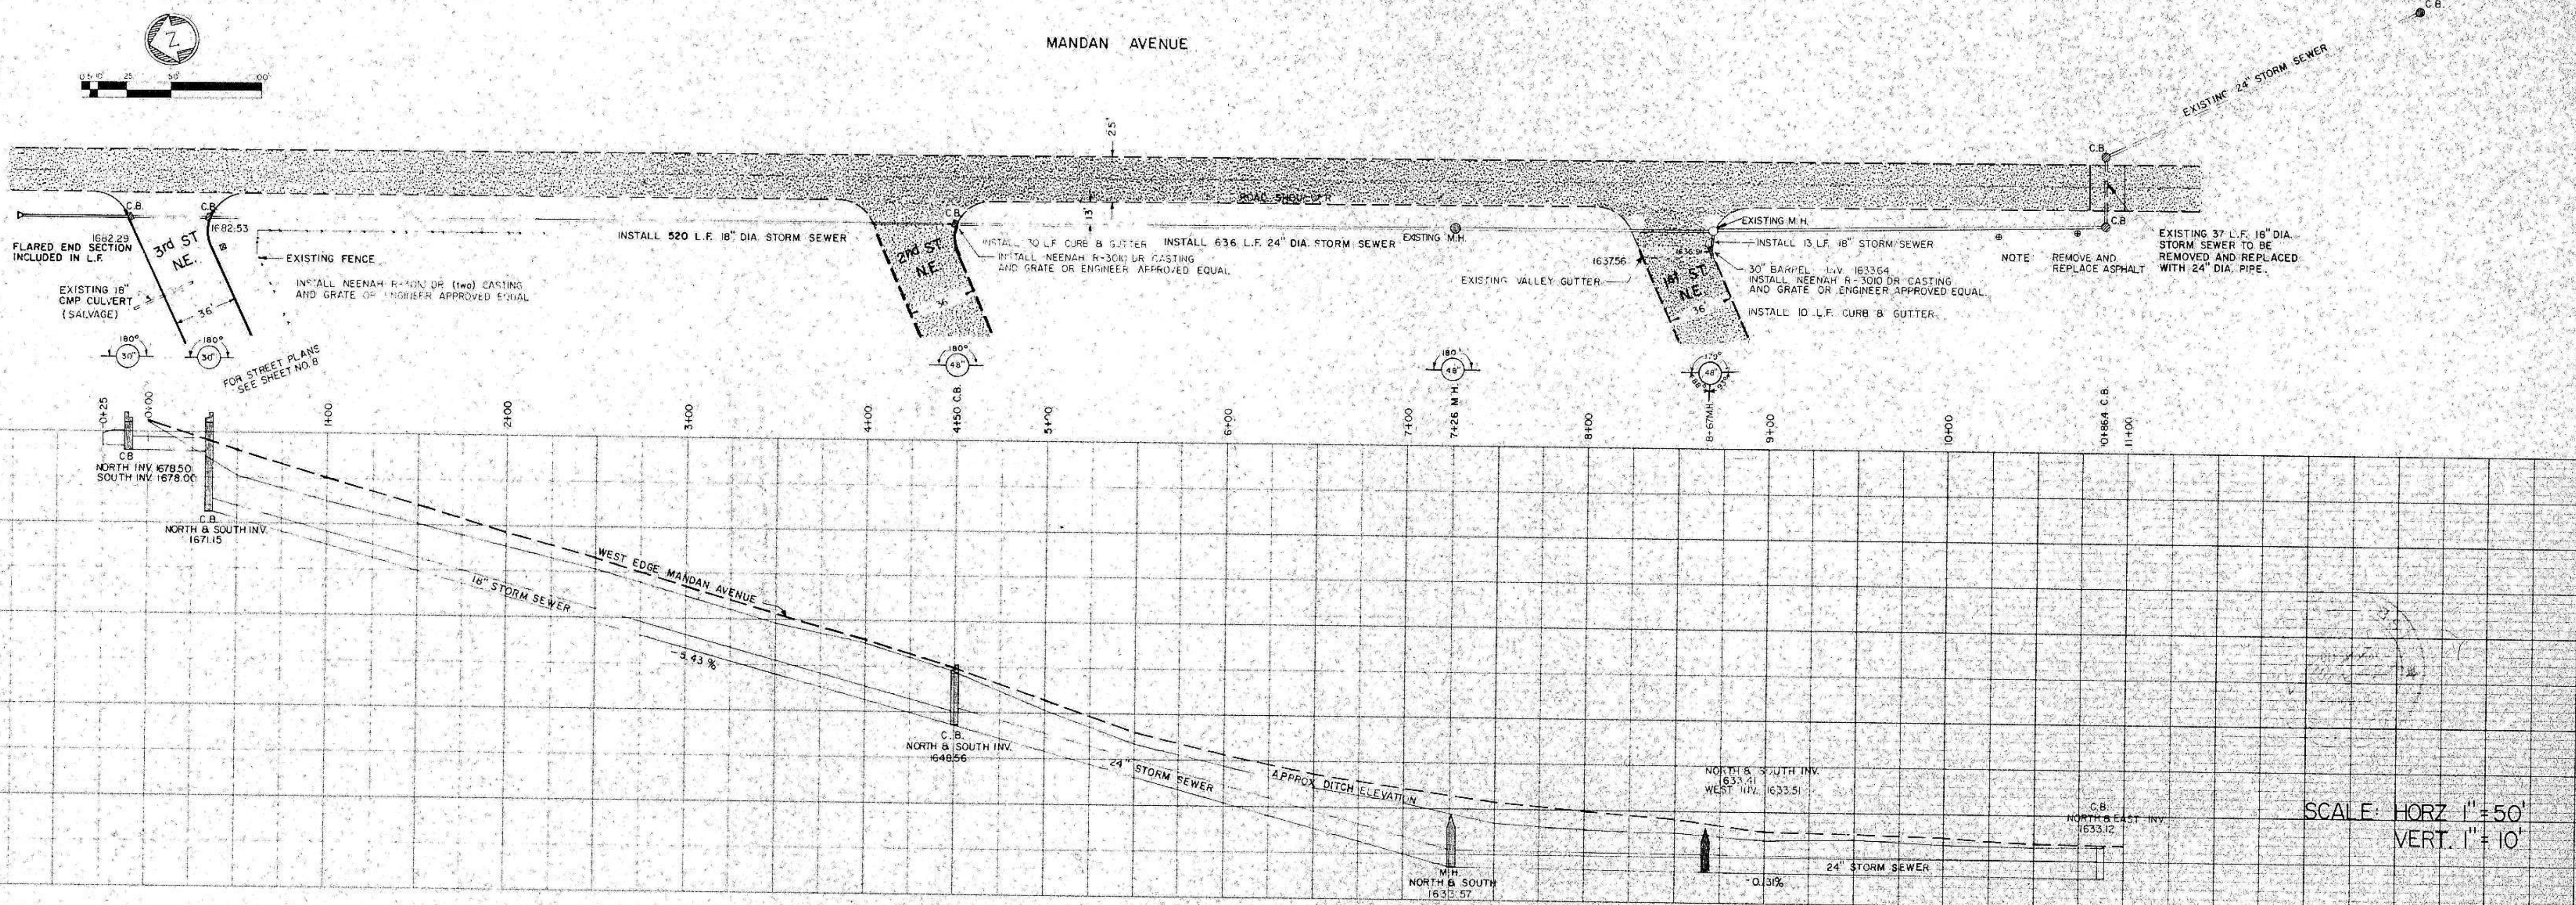


PLATE 2 DOUBLE PLAN AND PROFILE
 ASBUILT CONSTRUCTION DRAWINGS