



MISSOURI DRIVE

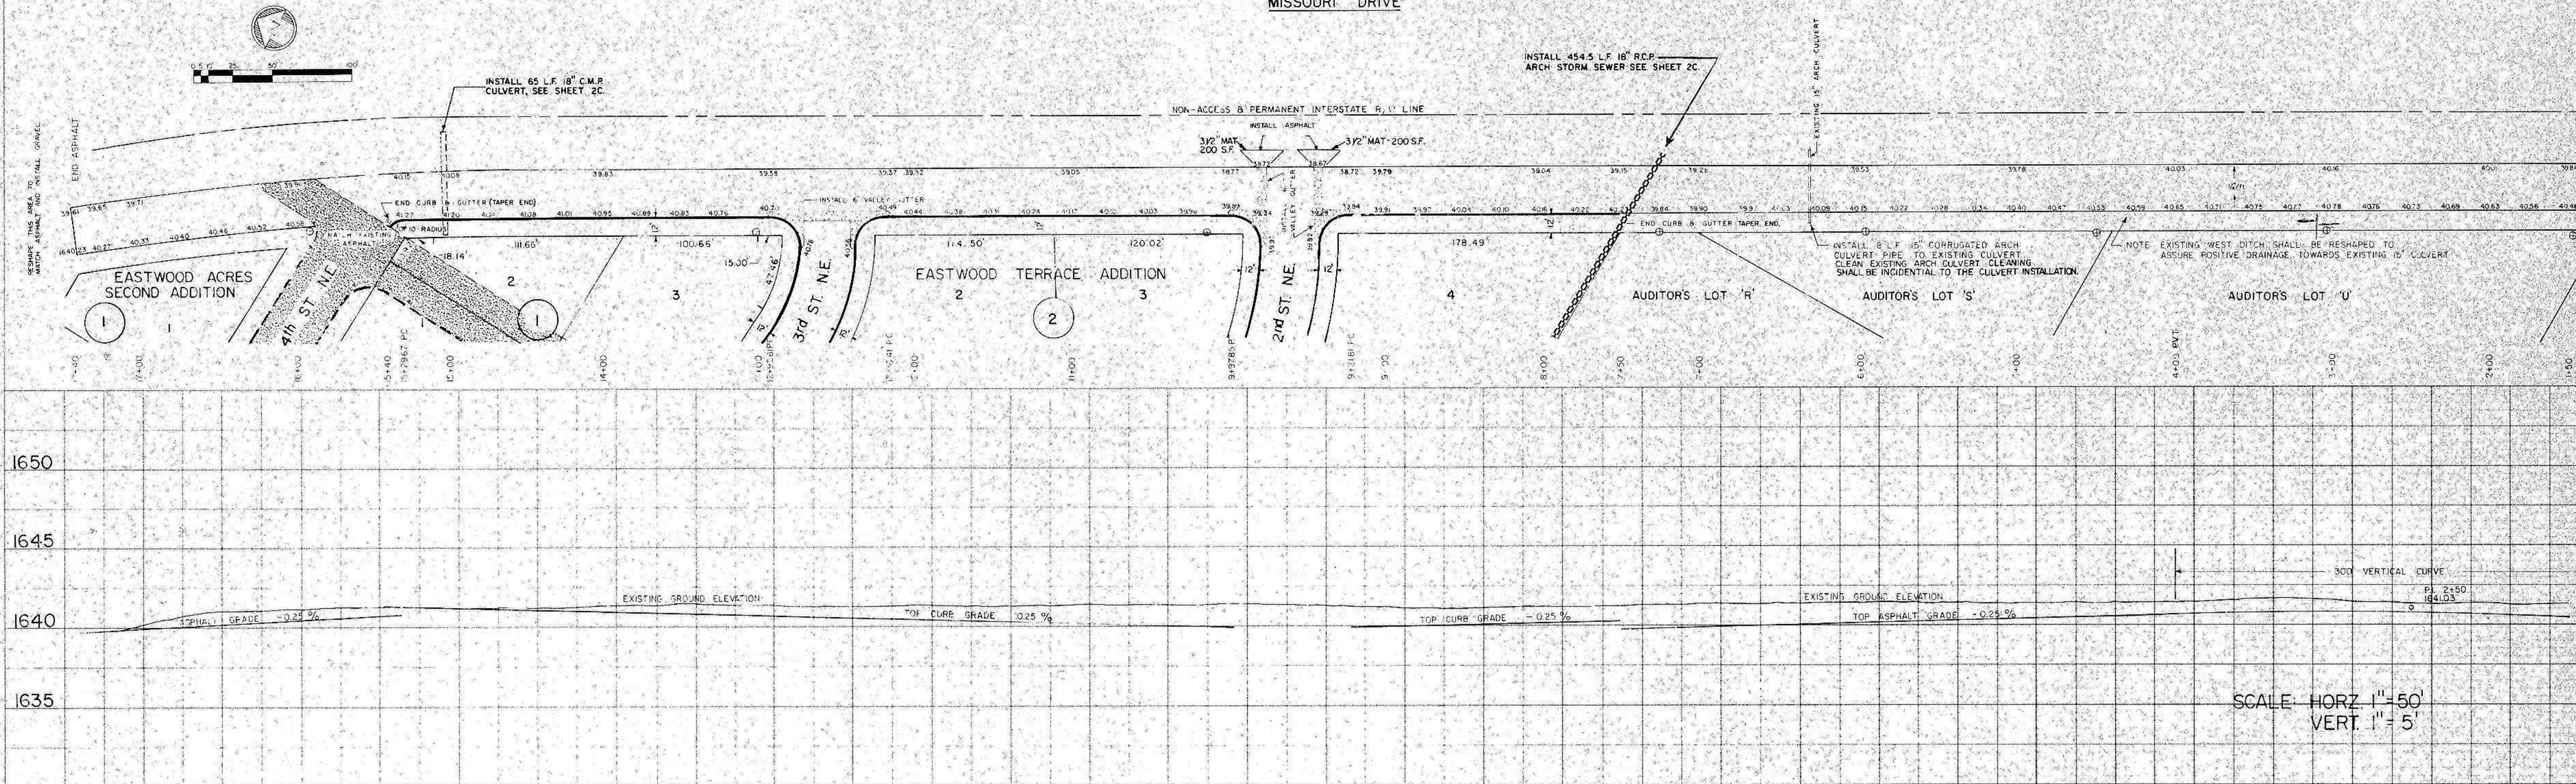


PLAN
 SUPPLIES
 NOTED
 CHECKED
 BY
 DATE

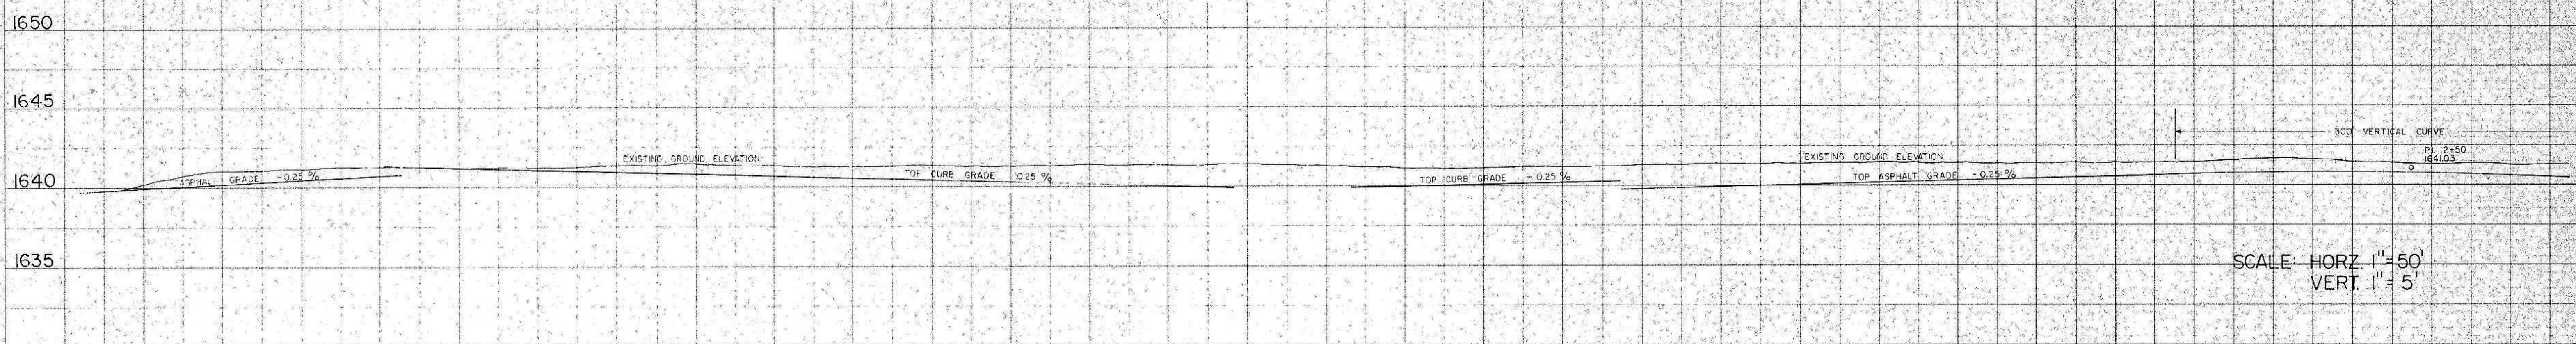


SCALE: HORIZ. 1"=50'
 VERT. 1"=5'

MISSOURI DRIVE

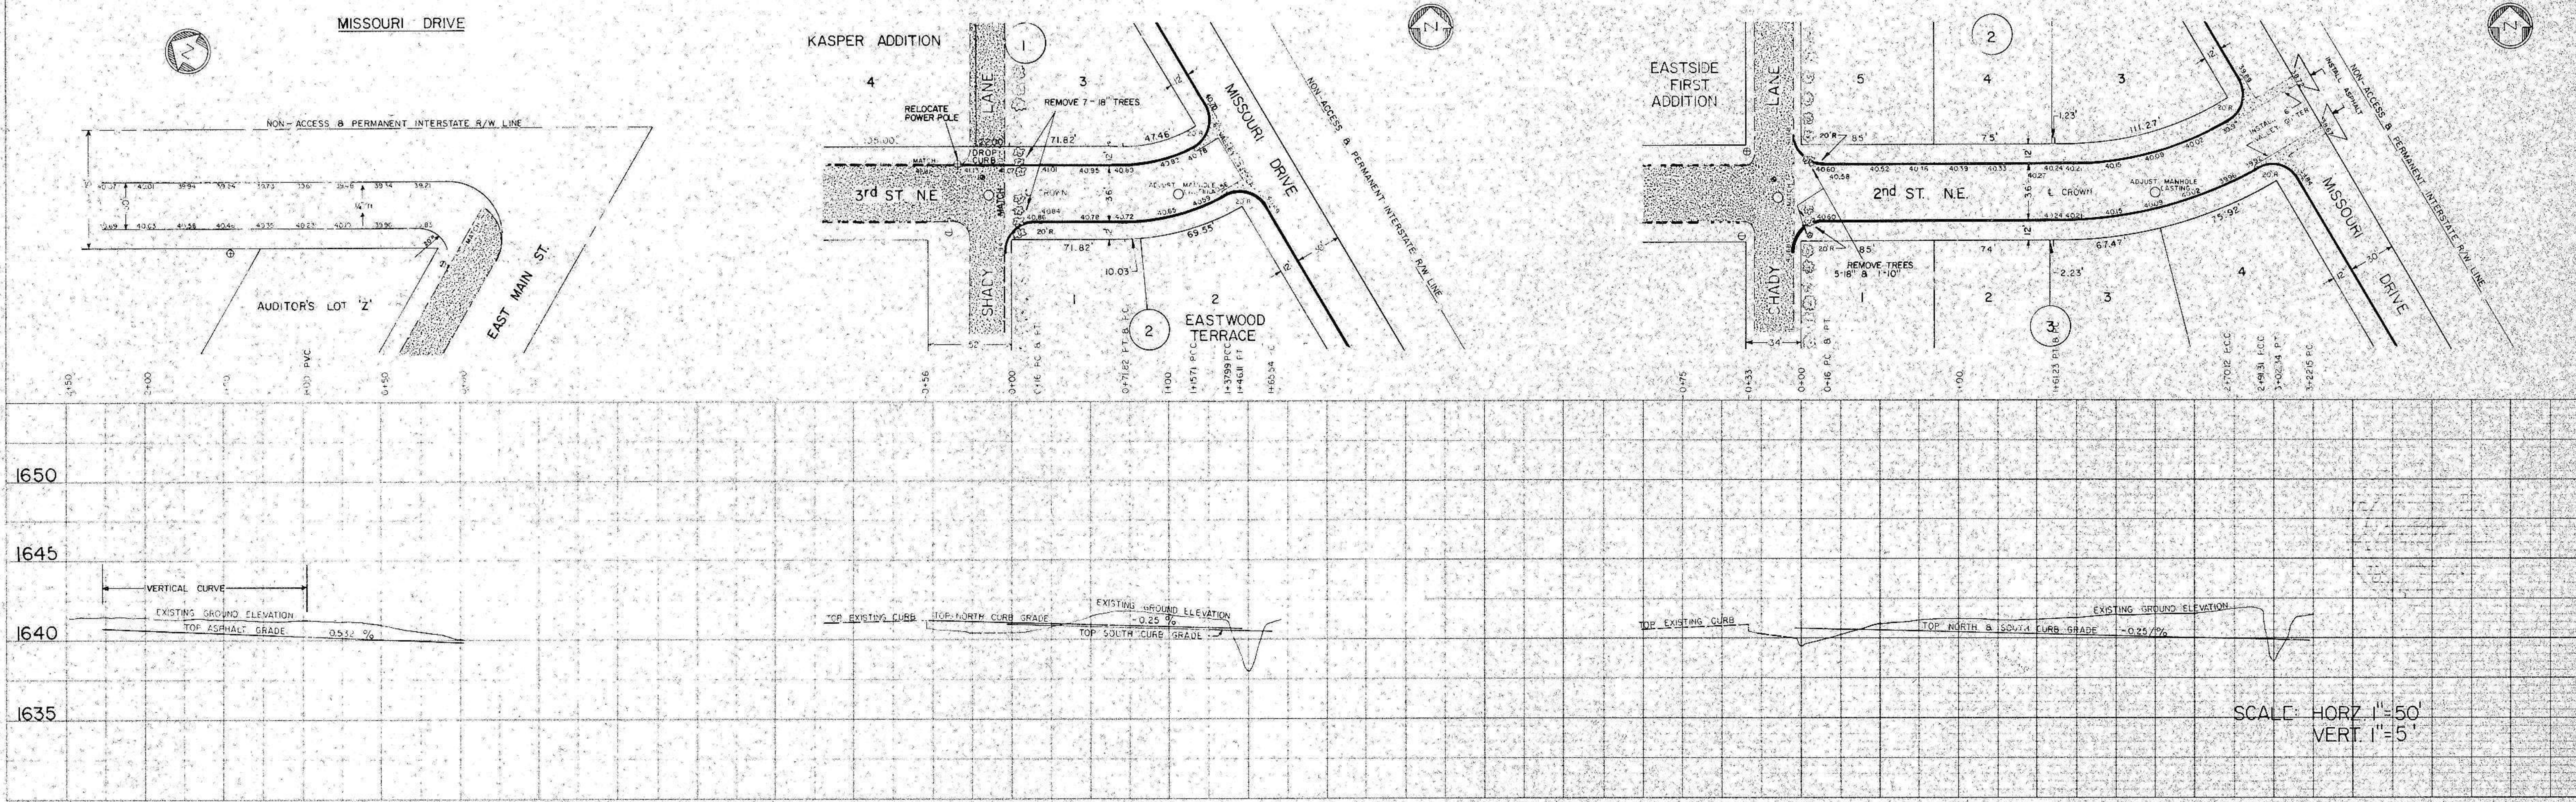

PROFILE
 SUPPLIES
 NOTED
 CHECKED
 BY
 DATE

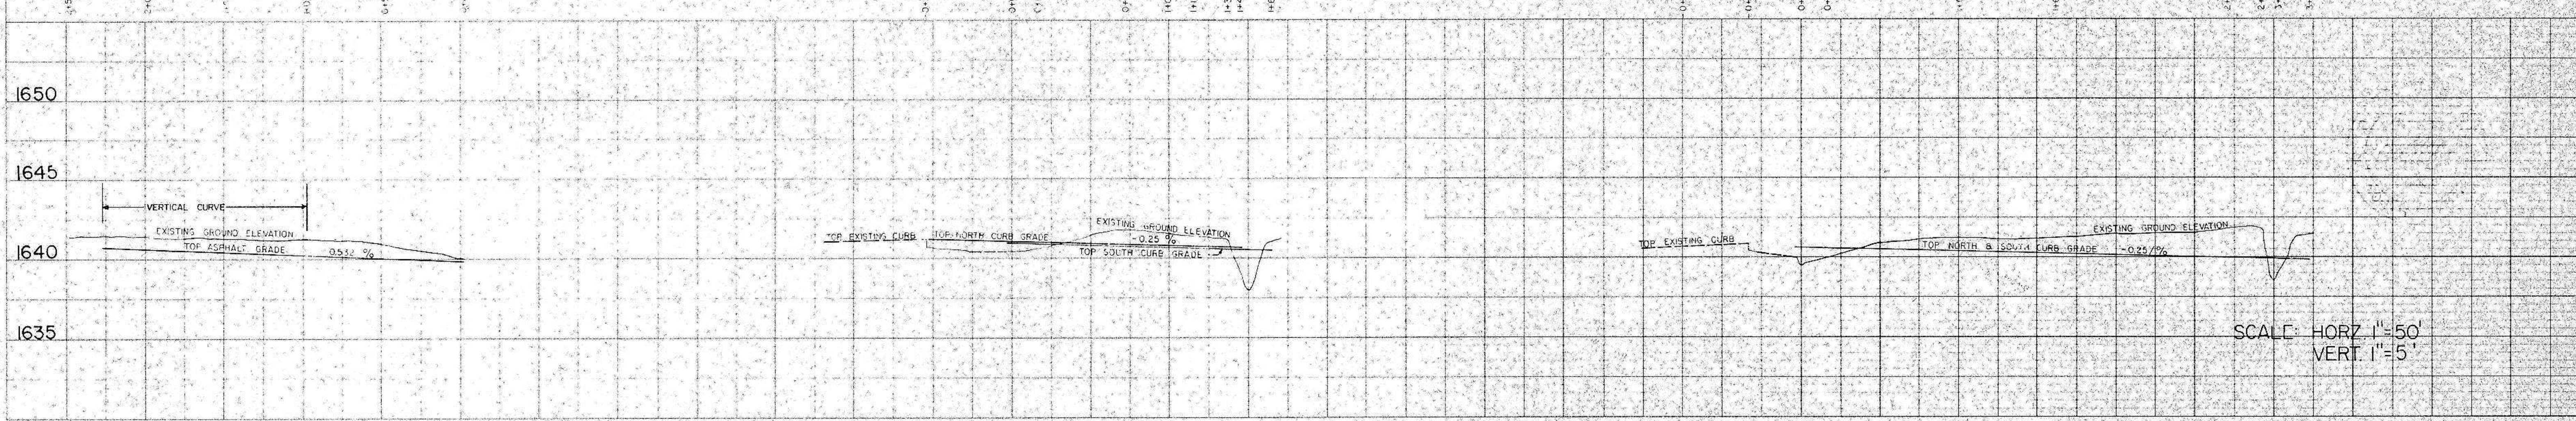

SCALE: HORIZ. 1"=50'
 VERT. 1"=5'