
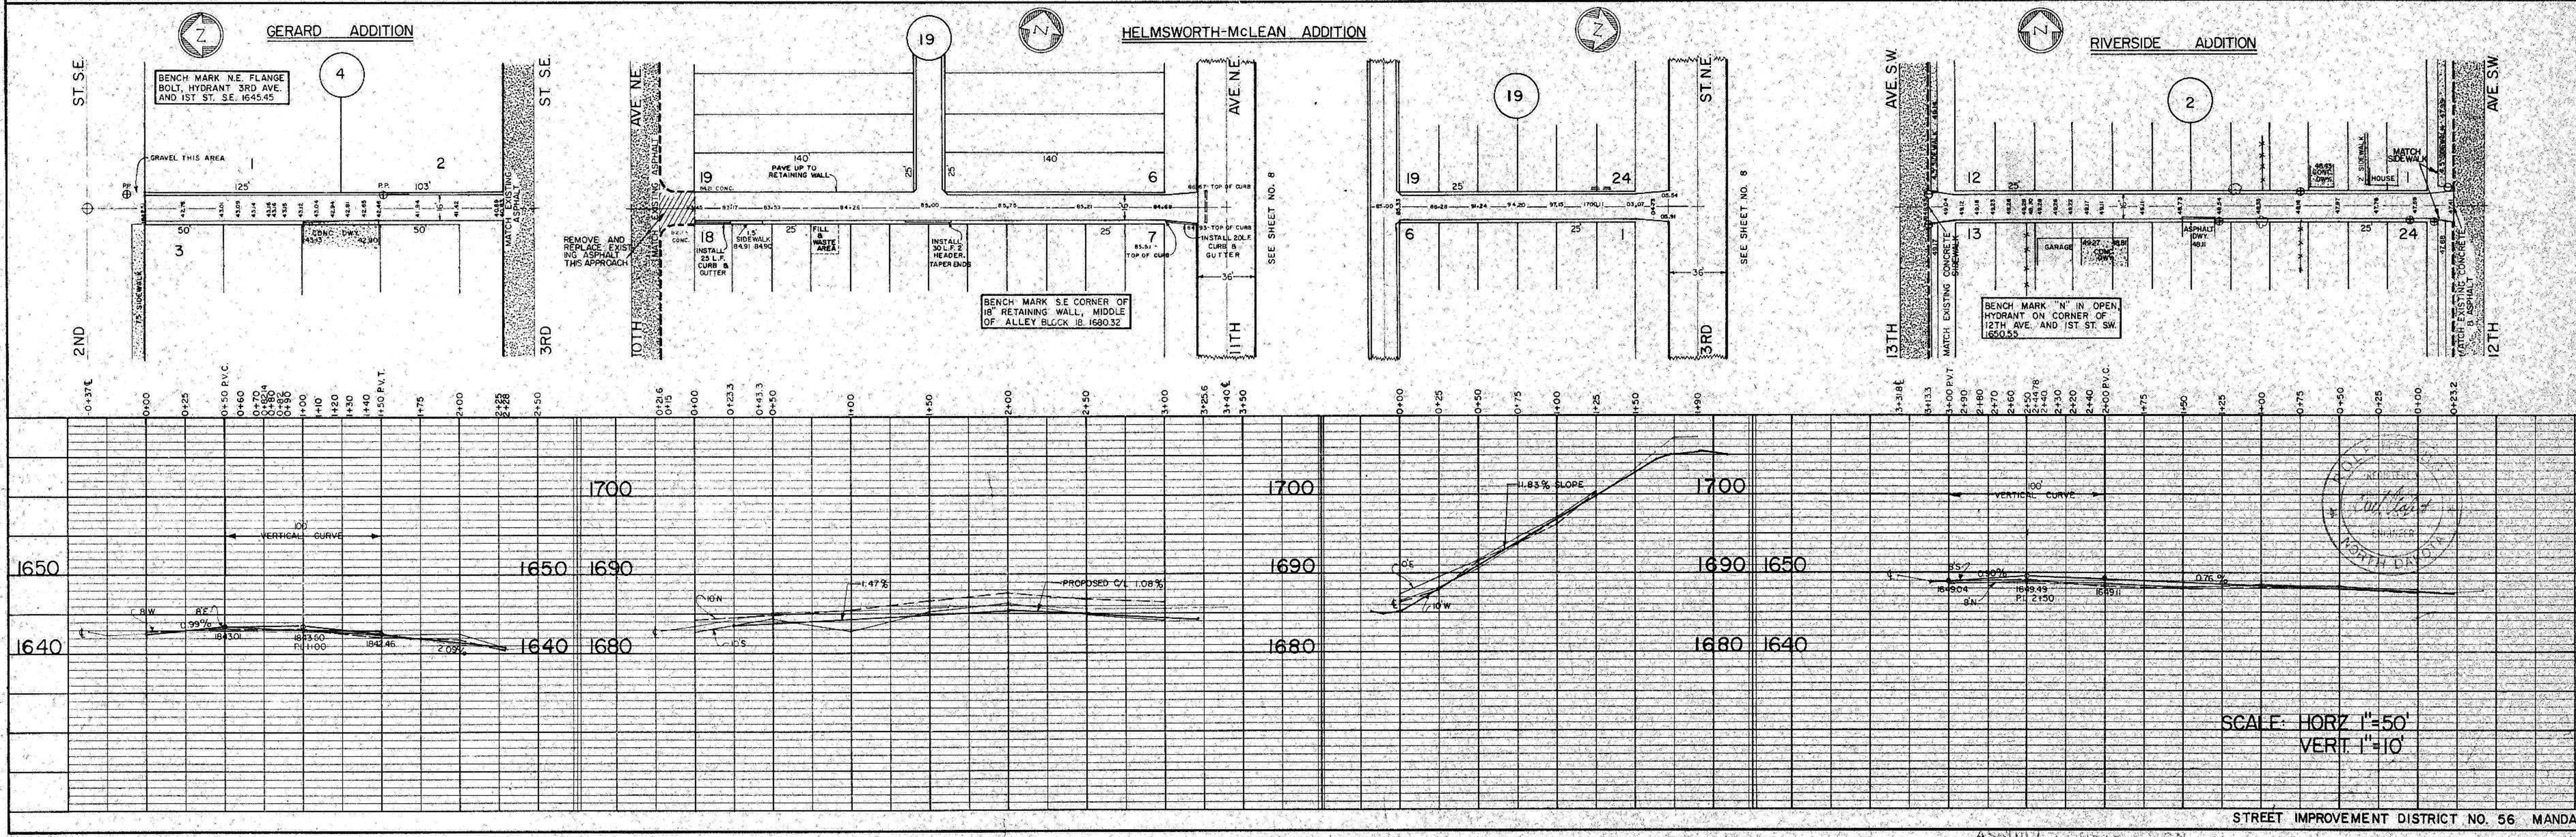


PLAN	DATE
BY	
REVISIONS	
NO.	
NOTE BOOK ALIGNED CHECKED	
RT. OF WAY CHECKED	

PROFILE	DATE
BY	
NO.	
NOTE BOOK	
GRADES CHECKED	
B. M. NOTED	
STRUCTURE NOTATIONS CH. 3	

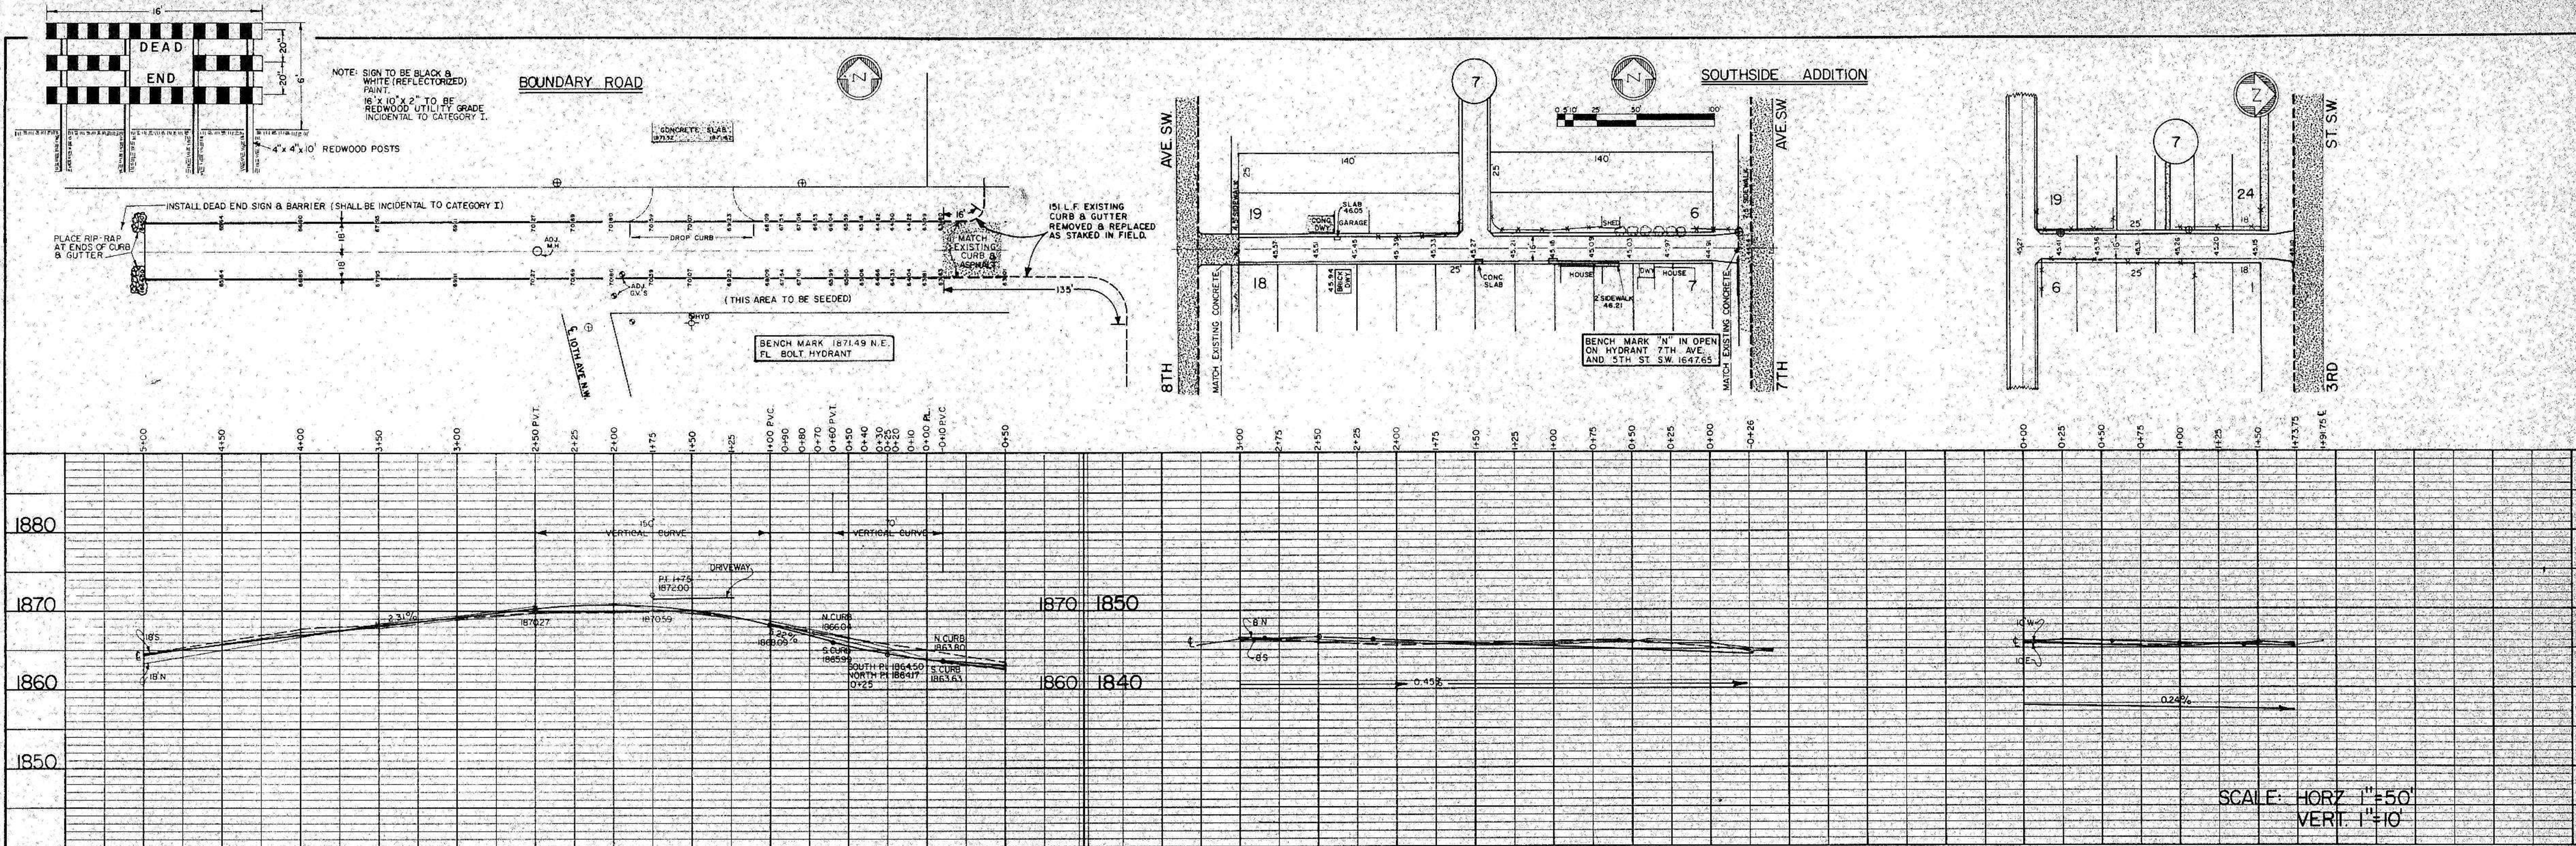

KE PLATE 2, PLAN-PROFILE
KEUFFEL & ESSER CO.
48 7032 ALBANYE TRACING PAPER 2880
MADE IN U.S.A.