

BEGIN QUANTITIES
STA 0+39

END QUANTITIES
STA 13+22.74

HORIZONTAL SCALE 1" = 50'
VERTICAL SCALE 1" = 10'
DATE: MAY, 1979

DATE: 5/15/79
BY: [Signature]
CHECKED: [Signature]
NO. 101

PLAN
NOTE BOOK ALIGNMENT CHECKED
RT. OF WAY CHECKED
No.

LEGEND

(Existing)

- SAN SEWER MAIN
- WATER MAIN
- SAN SEWER M.H. HYDRANT
- GATE VALVE
- CURB STOP & BOX
- STORM SEWER
- M.H. and INLETS

- CONSTRUCTION NOTES:**
- 1) Preliminary street grading has been done by others.
 - 2) Depress crown and tip gutter section to allow drainage as shown.
 - 3) All dimensions shown are to face of curb unless otherwise stated.
 - 4) All radii of intersections shall be 15' to face of curb unless otherwise stated.
 - 5) All elevations shown are to top of curb unless otherwise stated.
 - 6) Sewer and Water Improvements shall be completed prior to curb and gutter and asphalt construction. The contractor shall be responsible for the preservation of those improvements and other existing utilities.
 - 7) All street, right-of-way shall be seeded to grass from the edge of the street or road bed to the property line.
 - 8) Class IV seeding shall be used.
 - 9) A 16-20-0 fertilizer spread at the rate of 3 pounds per 100 square yards shall be used prior to seeding.


CURVE DATA

CURVE	F
A	20° 00' 00"
B	16° 00' 00"
L	63.35'
L	125.00'
R	359.26'
E	5.54'

LEGEND

(Existing)

- 50' LEFT
- C
- 50' RIGHT

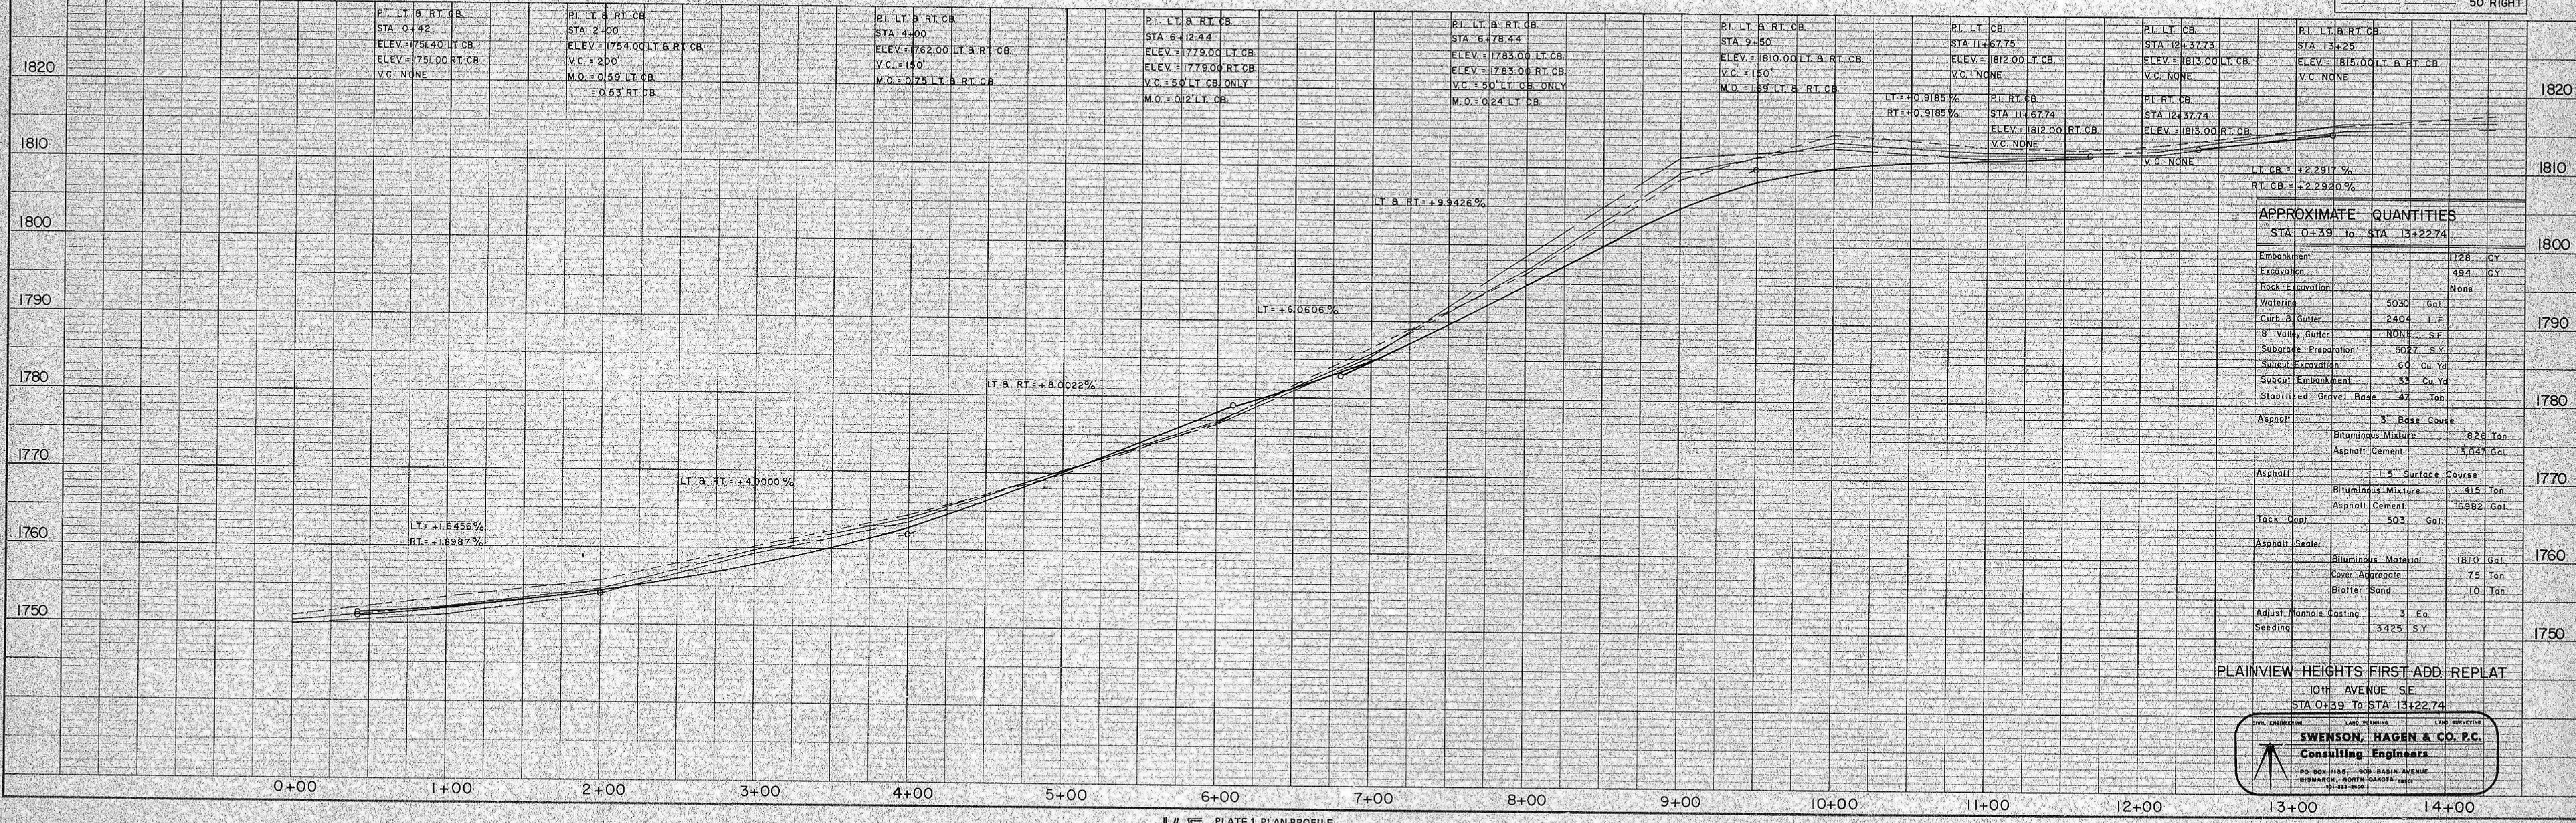

APPROXIMATE QUANTITIES
STA 0+39 to STA 13+22.74

Embankment	1728	CY
Excavation	494	CY
Rock Excavation	None	
Water	4030	Gal
Curb & Gutter	2404	L.F.
B. Valve, Gutter	None	S.F.
Subgrade Preparation	6077	S.Y.
Subcut Embankment	60	Cu. Yd.
Subcut Embankment	33	Cu. Yd.
Stabilized Gravel Base	47	Ton
Asphalt	3" Base Course	
	Bituminous Mixture	828 Ton
	Asphalt Cement	13,041 Gal
Asphalt	1.5" Surface Course	
	Bituminous Mixture	415 Ton
	Asphalt Cement	6,982 Gal
Tack Coat	503	Gal.
Asphalt Sealer		
	Bituminous Material	1870 Gal
	Cover Aggregate	75 Ton
	Blotter Sand	10 Ton
Adjust Manhole Castings	3	Eq.
Seeding	3428	S.Y.

PLAINVIEW HEIGHTS FIRST ADD. REPLAT
10TH AVENUE S.E.
STA 0+39 TO STA 13+22.74

SWENSON, HAGEN & CO. P.C.
Consulting Engineers
PO BOX 1158 - 5000 BASIN AVENUE
BISMARCK, NORTH DAKOTA 58103

PLATE 1, PLAN-PROFILE
KEUFFEL & ESSER CO.
48 7024 MADE IN U.S.A.