

# STREET IMPROVEMENT DISTRICT NO. 61 MANDAN, NORTH DAKOTA

CITY NO. 80-7

## INDEX


SHEET NO. 1 - PROJECT LAYOUT MAP  
SHEET NO. 2 - 2" OVERLAY  
ROUGH RIDER ESTATES  
SHEET NO. 3 - RETAINING WALL  
5TH. ST. N.W.

APPROVED:  DATE: March 9, 1981  
THOMAS LITTLE, P.E.  
CITY ENGINEER  
MANDAN, N.D.



AUGUST 5, 1980

TOMAN ENGINEERING CO.  
CONSULTING ENGINEERS  
TECO. NO. 7037

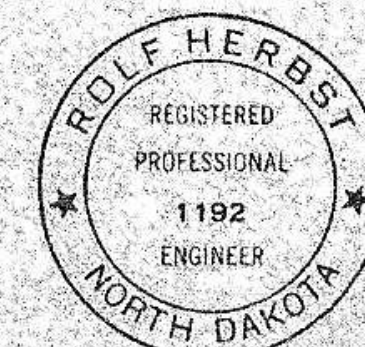

MANDAN  
NORTH DAKOTA

2

D 61  
P 80-7