


ITEM	AS-BUILT QUANTITY
2" A.C. Wearing Course	2,047.0 Ton
Tack Coat	1,750.0 Gal
120-150 Pen A.C. Oil	6,254.8 S.F. lbs./gal.
Asphalt Removal	737.5 S.Y.
Manhole Adjustment	11 Each
Topsoiling	
Seeding	
Post & 3 Street Signs	
Stop Signs	
Curb & Gutter Removal & Replacement	329.0 S.Y.

- BENCH MARKS**
- TOP OF HYDRANT WAGON WHEEL PLACE, ROUGHRIDER ESTATES. ELEV. 1870.25
  - TOP OF HYDRANT SOUTHEAST CORNER LOT 48, ROUGHRIDER ESTATES. ELEV. 1858.03
  - TOP OF HYDRANT NORTH CORNER LOT 31, ROUGHRIDER ESTATES. ELEV. 1840.48
  - TOP OF HYDRANT SOUTHWEST CORNER LOT 25, ROUGHRIDER ESTATES. ELEV. 1834.07
  - TOP OF HYDRANT NORTHWEST CORNER LOT 19, ROUGHRIDER ESTATES. ELEV. 1818
  - TOP OF HYDRANT SOUTHWEST CORNER TRAIL DRIVE, ROUGHRIDER ESTATES. ELEV. 1842.58
  - TOP OF HYDRANT NORTHEAST CORNER LOT 54, ROUGHRIDER ESTATES. ELEV. 1847.08

- LEGEND**
- EXISTING HYDRANT
  - EXISTING SW
  - EXISTING MH TO BE ADJUSTED
  - EXISTING CURB & GUTTER
  - EXISTING ASPHALT
  - EXISTING GRAVEL

DELETED  
NOTE: INSTALL DOUBLE UNIT CATCH BASIN CASTING SIMILAR TO HESAH #3233-B OR ENGINEER APPROVED EQUAL.

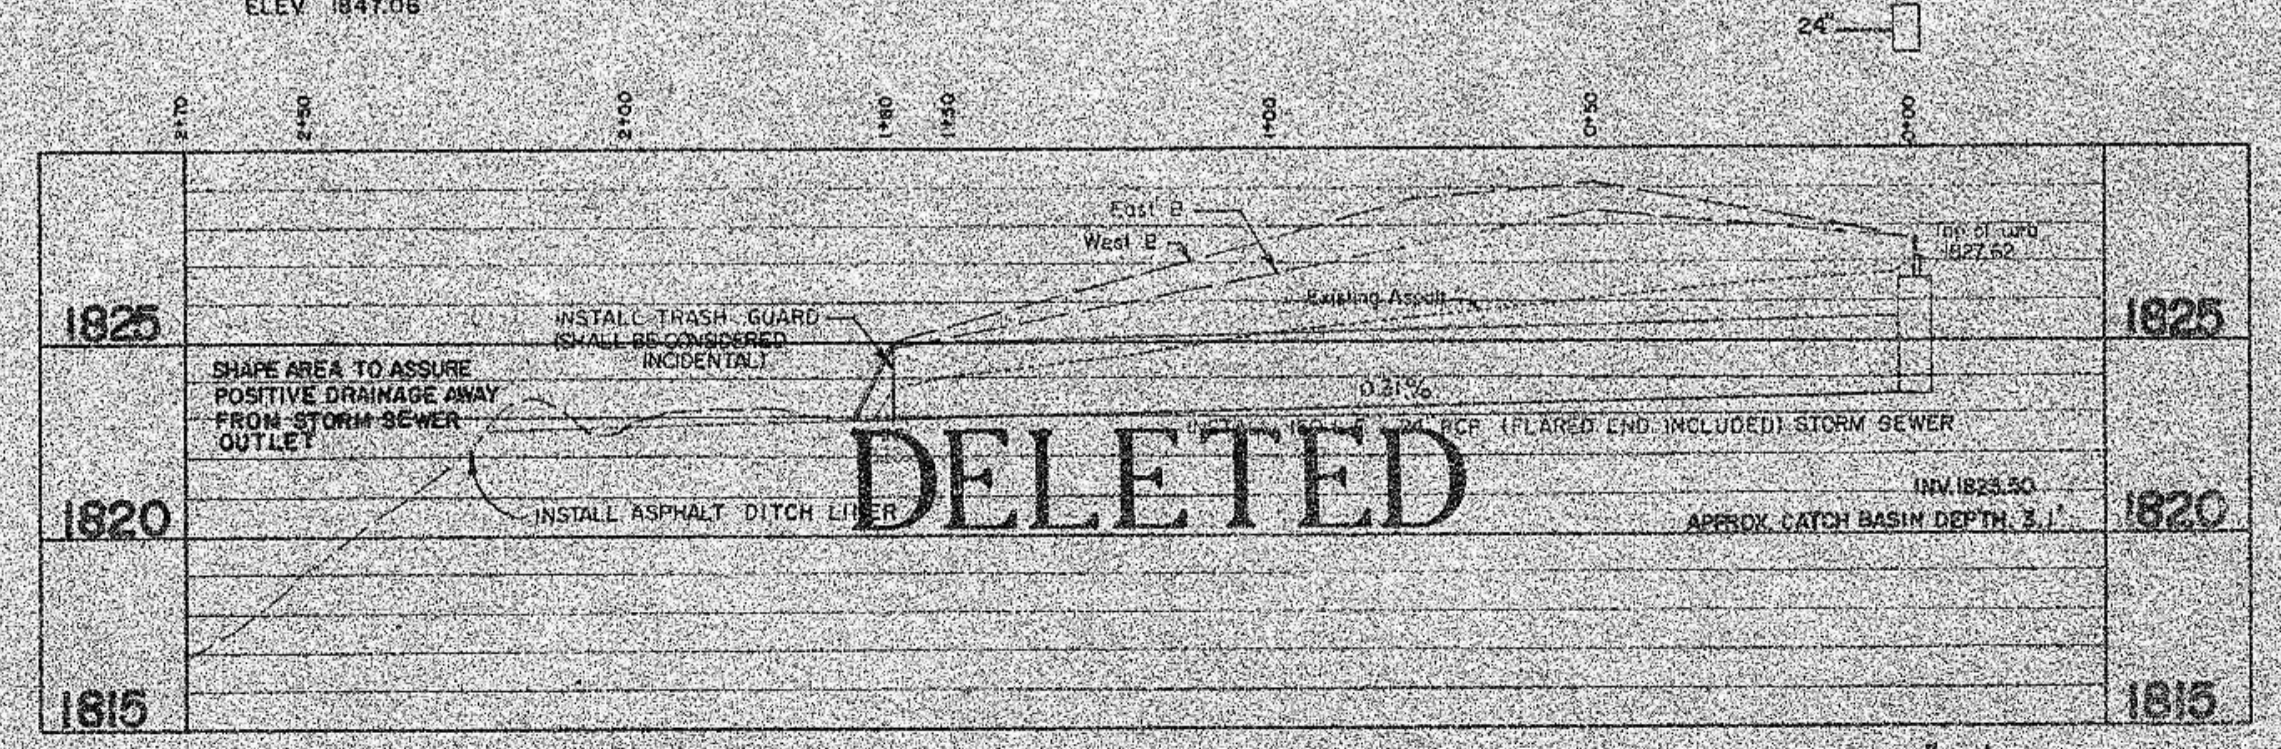

STORM SEWER PROFILE

SCALE: HORIZ. 1" = 30'  
VERT. 1" = 5'



TEC ENGINEERING COMPANY  
1000 WEST 10TH STREET  
MANDAN, NORTH DAKOTA 58542  
TEL: 701-785-4444



STREET IMPROVEMENT DISTRICT NO. 61, MANDAN, N.D.  
SHEET NO. 2 OF 3 SHEETS  
TECO NO. 7037  
CITY NO. 60-7