


DATE: _____ BY: _____
 PLAN: _____
 CHECKED: _____
 DATE: _____ BY: _____
 NOTE BOOK: _____
 NO. _____


DATE: _____ BY: _____
 PROFILE: _____
 CHECKED: _____
 DATE: _____ BY: _____
 NOTE BOOK: _____
 NO. _____





SCALE 1 inch = 50 feet

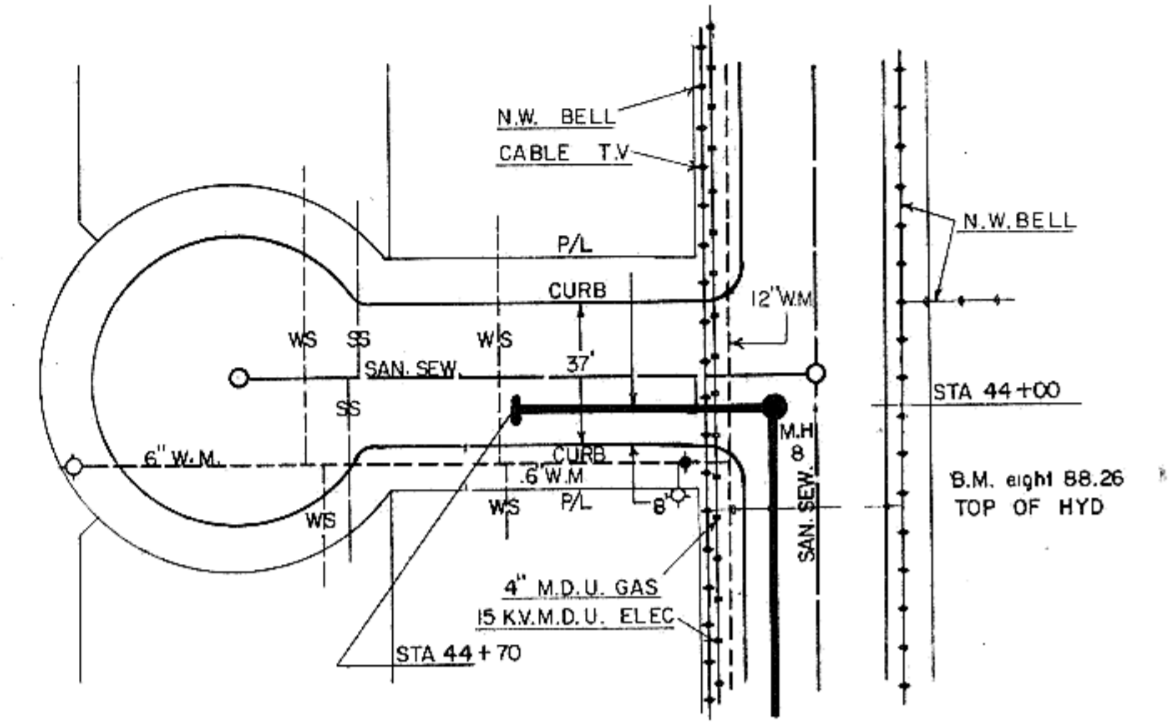

SCALE 1 inch = 50 feet

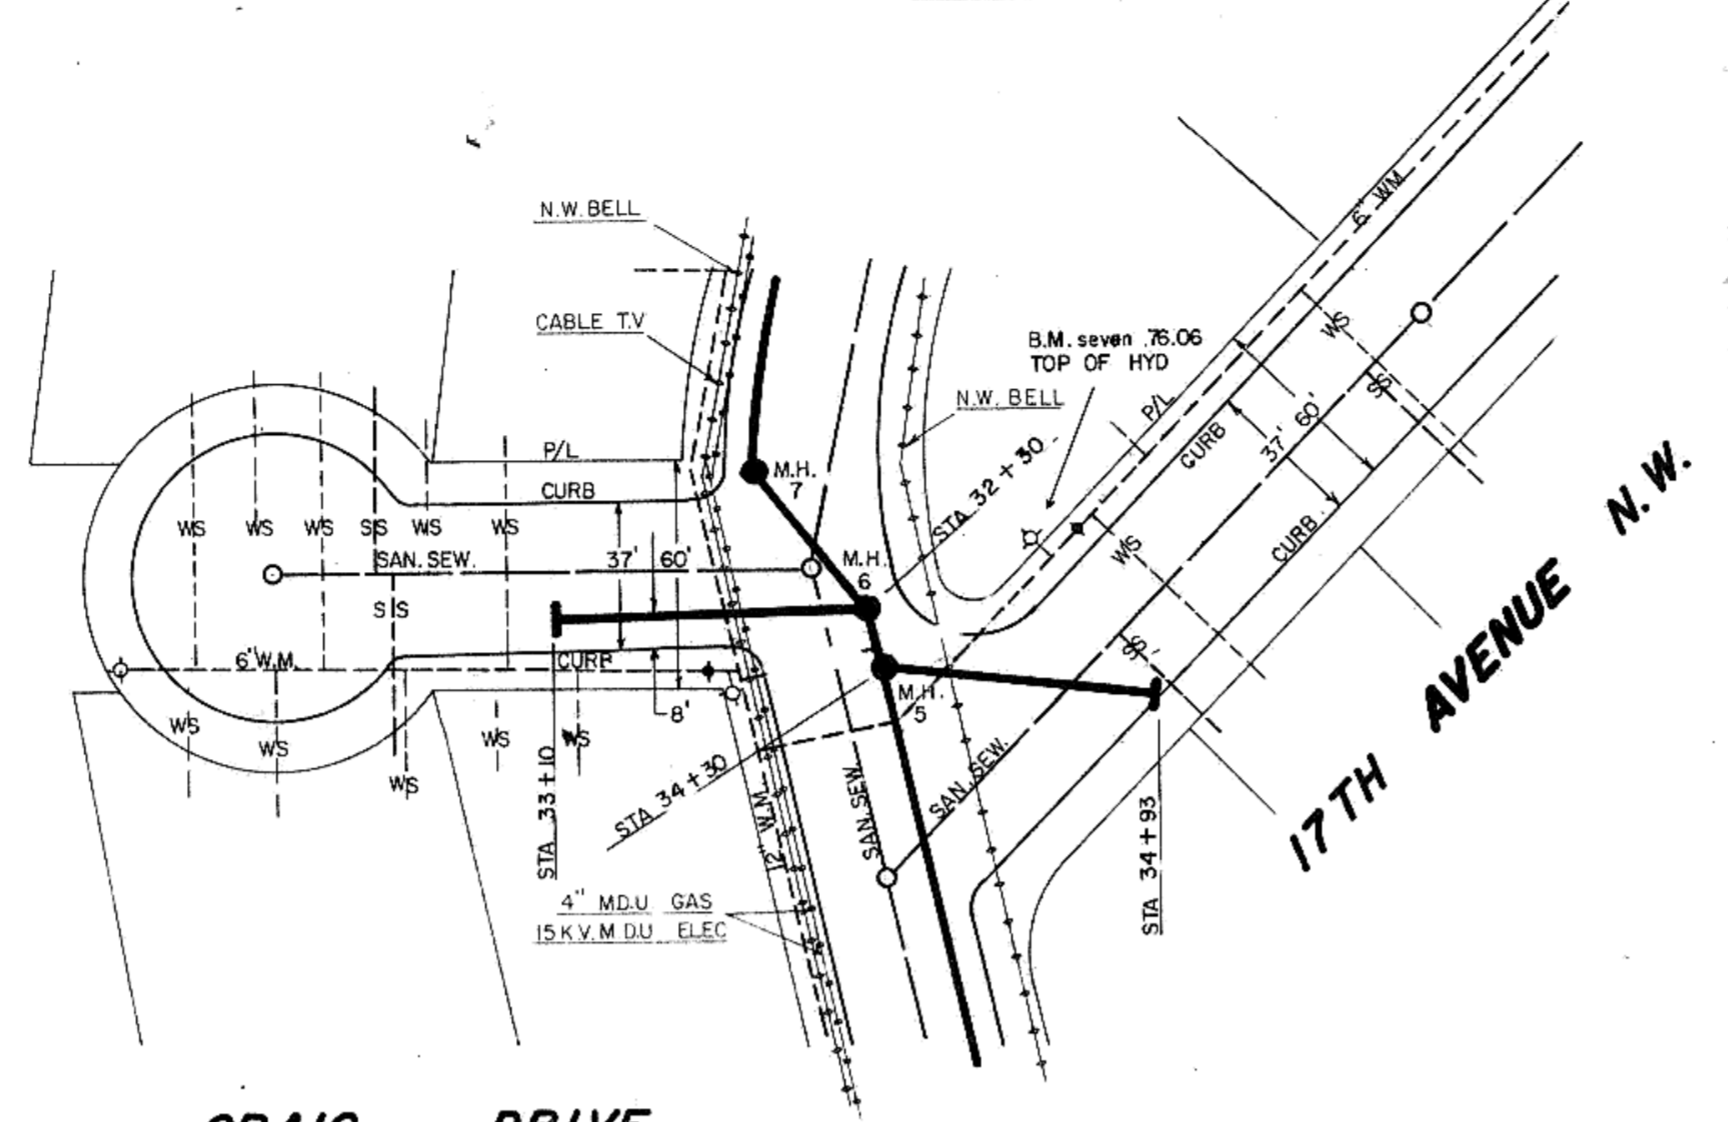

SCALE 1 inch = 50 feet

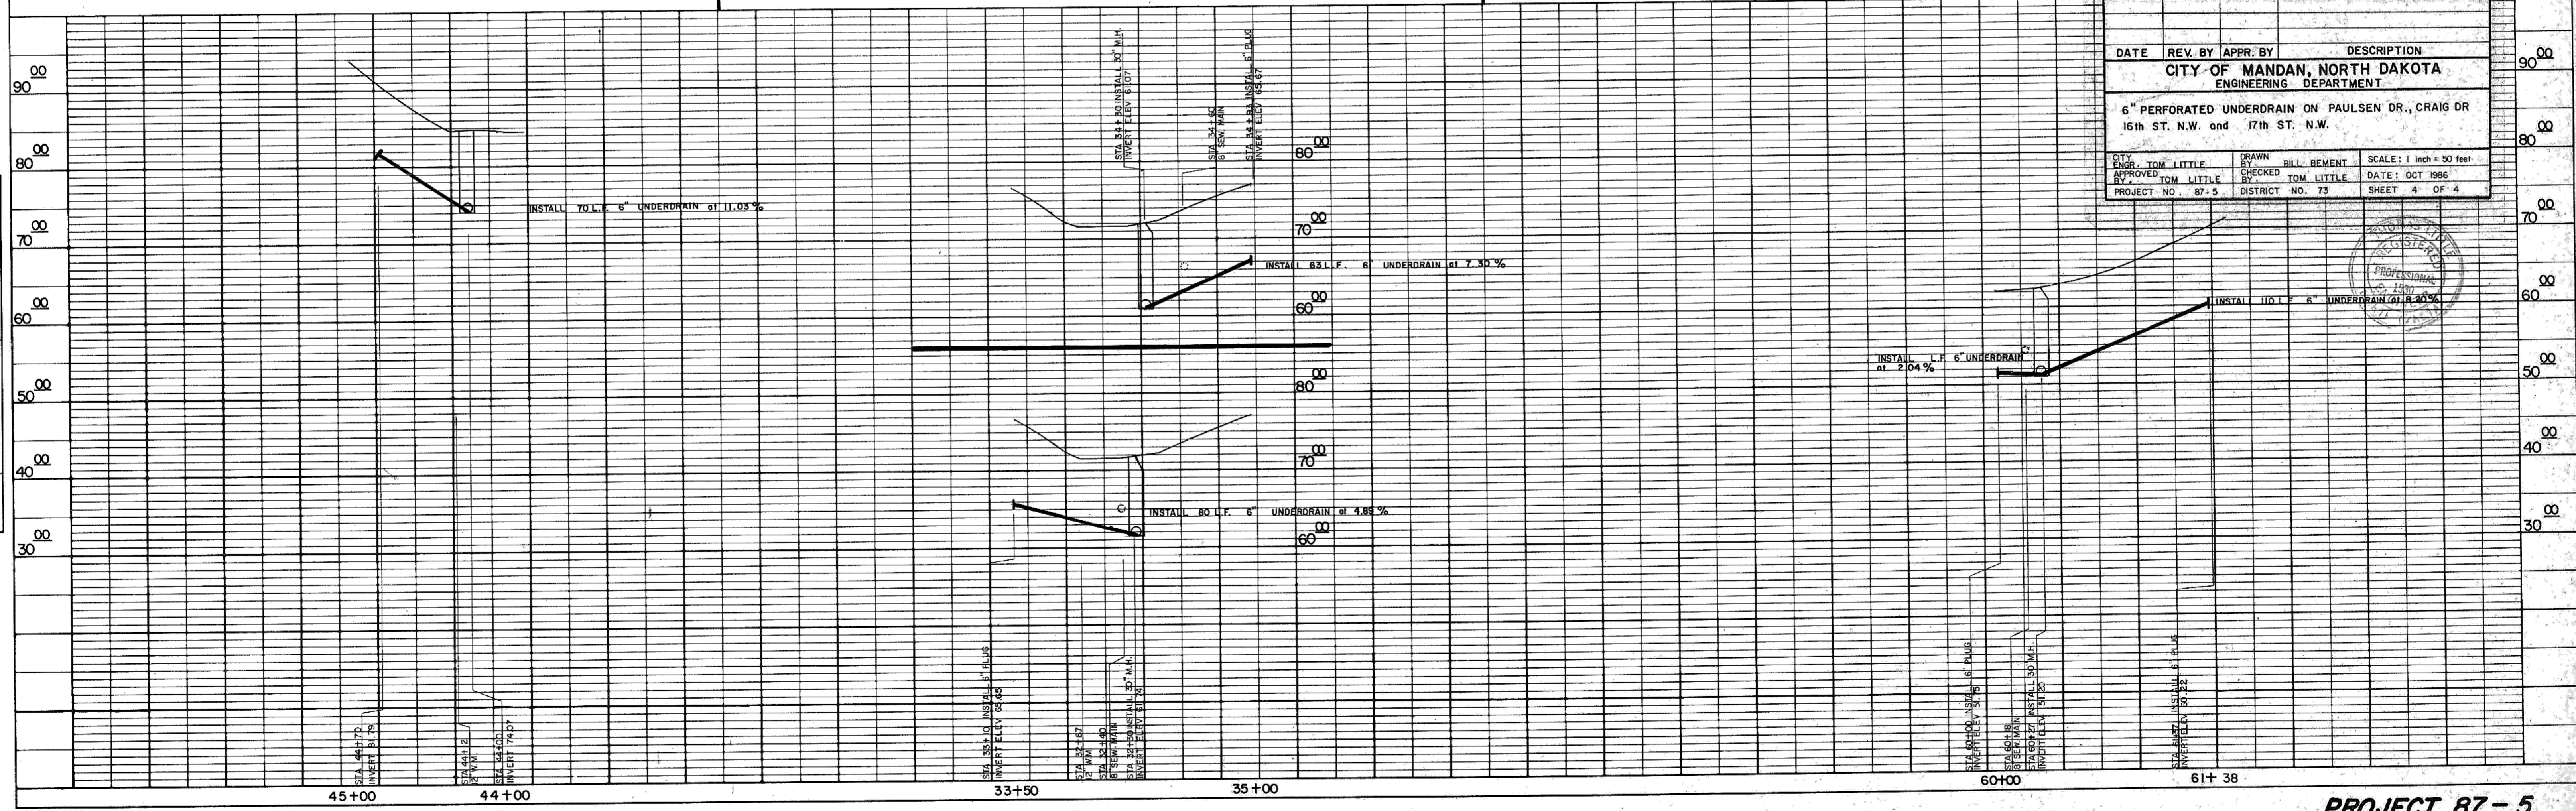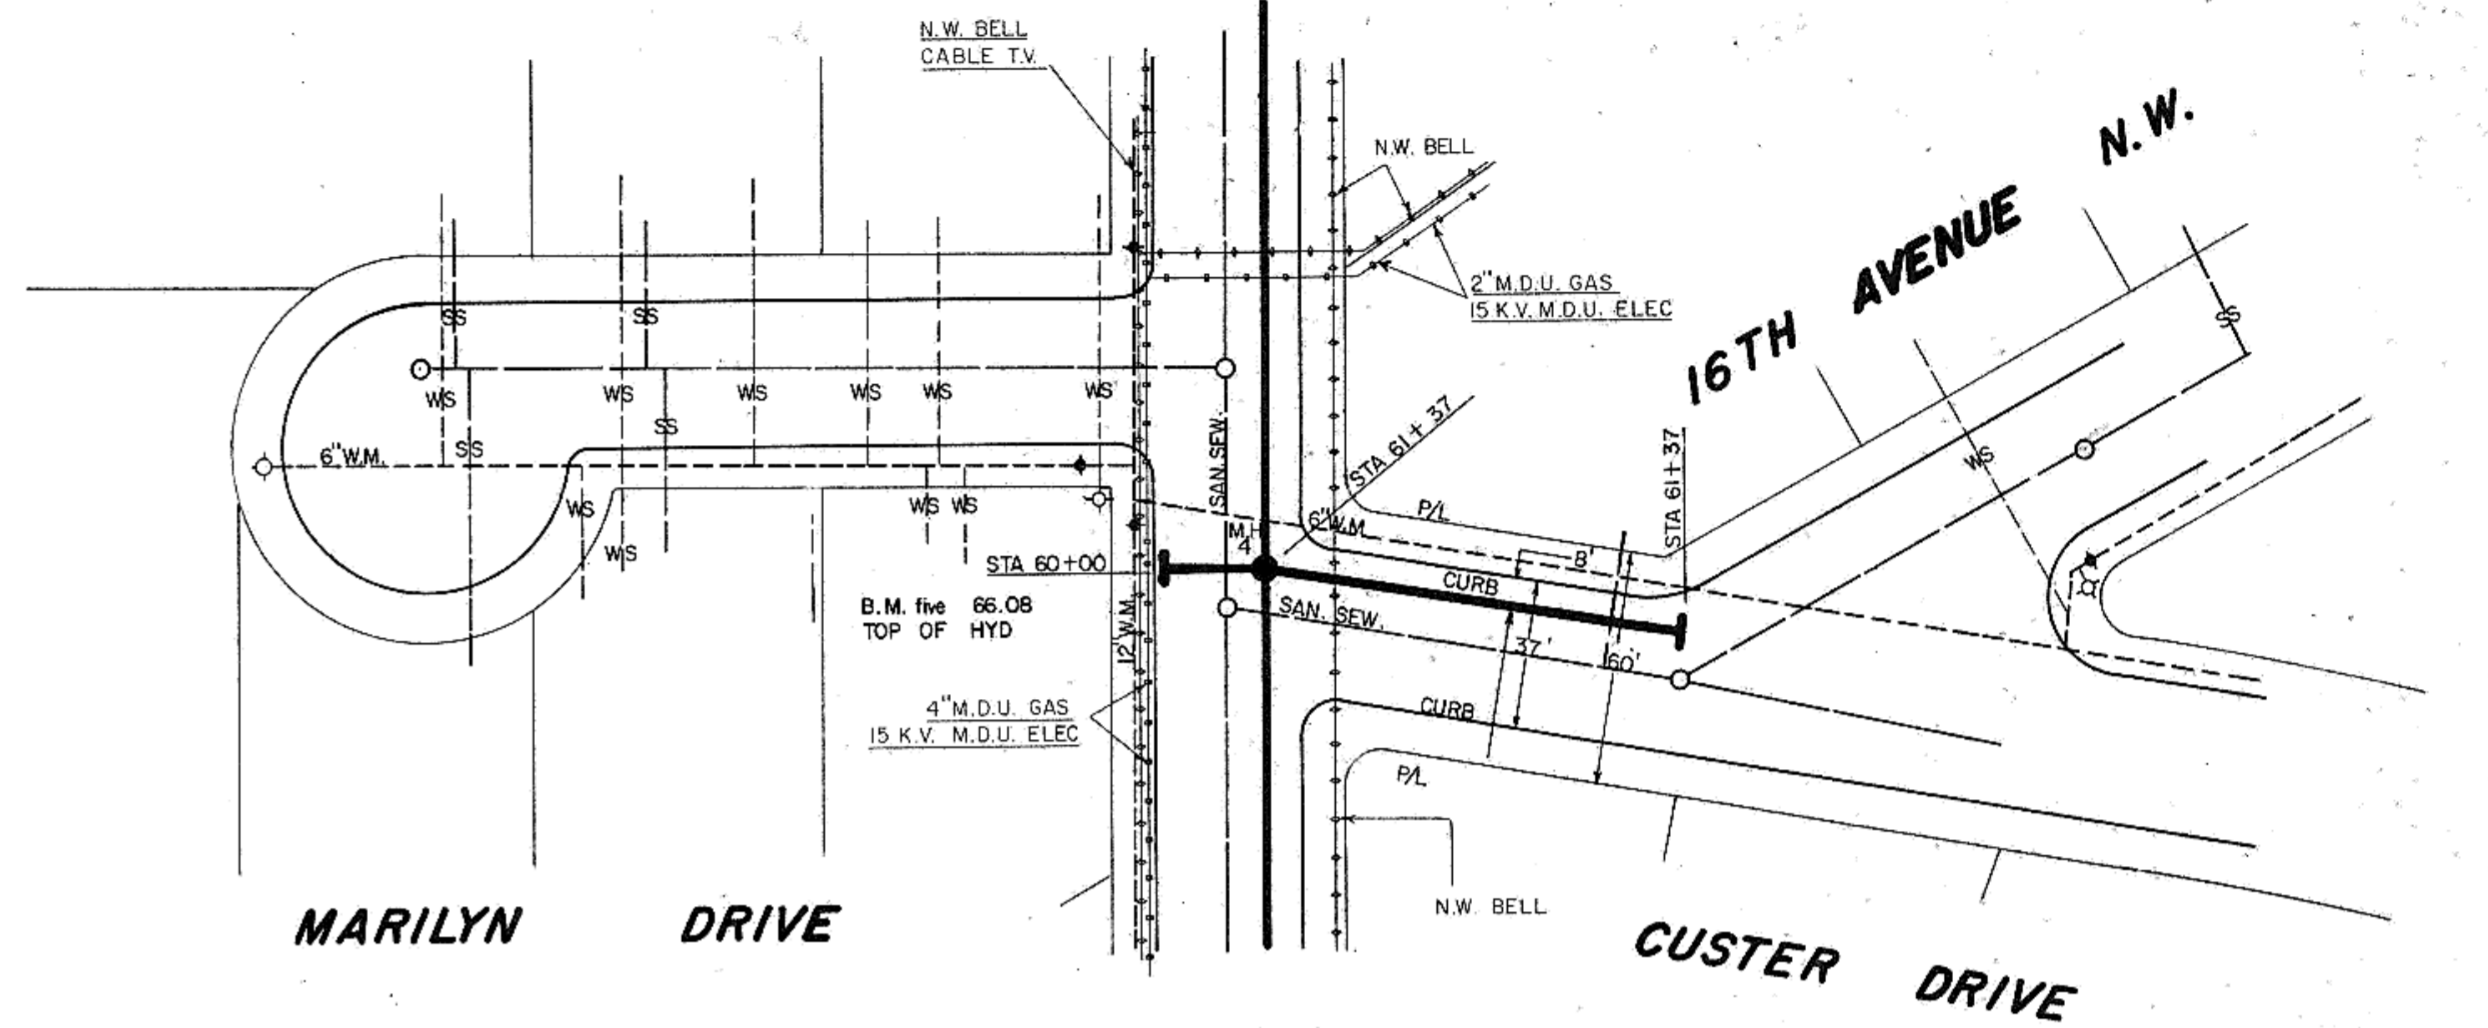

DATE	REV. BY	APPR. BY	DESCRIPTION
			CITY OF MANDAN, NORTH DAKOTA ENGINEERING DEPARTMENT
6" PERFORATED UNDERDRAIN ON PAULSEN DR., CRAIG DR 16th ST. N.W. and 17th ST. N.W.			
CITY ENGR. TOM LITTLE	DRAWN BY BILL BEMENT	CHECKED BY TOM LITTLE	SCALE: 1 inch = 50 feet
APPROVED BY TOM LITTLE	CHECKED BY TOM LITTLE	DATE: OCT 1986	
PROJECT NO. 87-5	DISTRICT NO. 73	SHEET 4 OF 4	