

# STREET IMPROVEMENT DISTRICT NO. 81 MANDAN, NORTH DAKOTA

(CITY NO. 89-5)

## INDEX

### BOARD OF CITY COMMISSIONERS MANDAN, NORTH DAKOTA

ROBERT DYKSHORN, PRESIDENT  
ED FROELICH, COMMISSIONER  
BRUCE BOEHM, COMMISSIONER  
TONY ENGELHARDT, COMMISSIONER  
GENEVIEVE HUTMACHER, COMMISSIONER  
LYNN LANDER, AUDITOR  
THOMAS LITTLE, CITY ENGINEER


W/SID # 21 Site # 4

SID 81 - Project 89-5 #  
File # 2

~~SID # 21 Project # 2000~~

Sylvestre's Industrial  
Park 2nd

SHEET NO.	DESCRIPTION
AREA 1	
1.	24th AVE. S.E. BETWEEN MEMORIAL HIGHWAY AND LONGSPUR TRAIL S.E.
2.	LONGSPUR TRAIL S.E. BETWEEN 24th AVE. S.E. AND STATION 31+97.99
3.	LONGSPUR TRAIL S.E. BETWEEN STATION 31+97.99 AND REDWING DRIVE AND REDWING DRIVE BETWEEN MEMORIAL HIGHWAY AND LONGSPUR TRAIL S.E.
4.	RACE TRACK & RODEO ARENA STORM SEWER PLAN & PROFILE
15.	LIFT STATION AND FORCEMAIN LAYOUT AND DETAILS
AREA 2	
6.	43rd AVE. S.E. BETWEEN MEMORIAL HIGHWAY AND 19th STREET S.E. REMOVAL AND RELOCATION DETAILS
7.	43rd AVE. S.E. BETWEEN MEMORIAL HIGHWAY AND 19th STREET S.E.
8.	19th STREET S.E. STORM SEWER PLAN & PROFILE PINTAIL LOOP GRADING PLAN & PROFILE (PART OF AREA 3)
AREA 3	
9.	BAYSIDE DRIVE S.E. BETWEEN PINTAIL LOOP S.E. AND 46th AVE. S.E.
10.	NORTH SHORE LOOP BETWEEN PINTAIL LOOP S.E. AND BAYSIDE DRIVE S.E.
11.	DETAIL SHEET
ELECTRICAL SHEETS	
E1.	AREA 1
E2.	AREA 2 & AREA 3
E3.	DETAILS

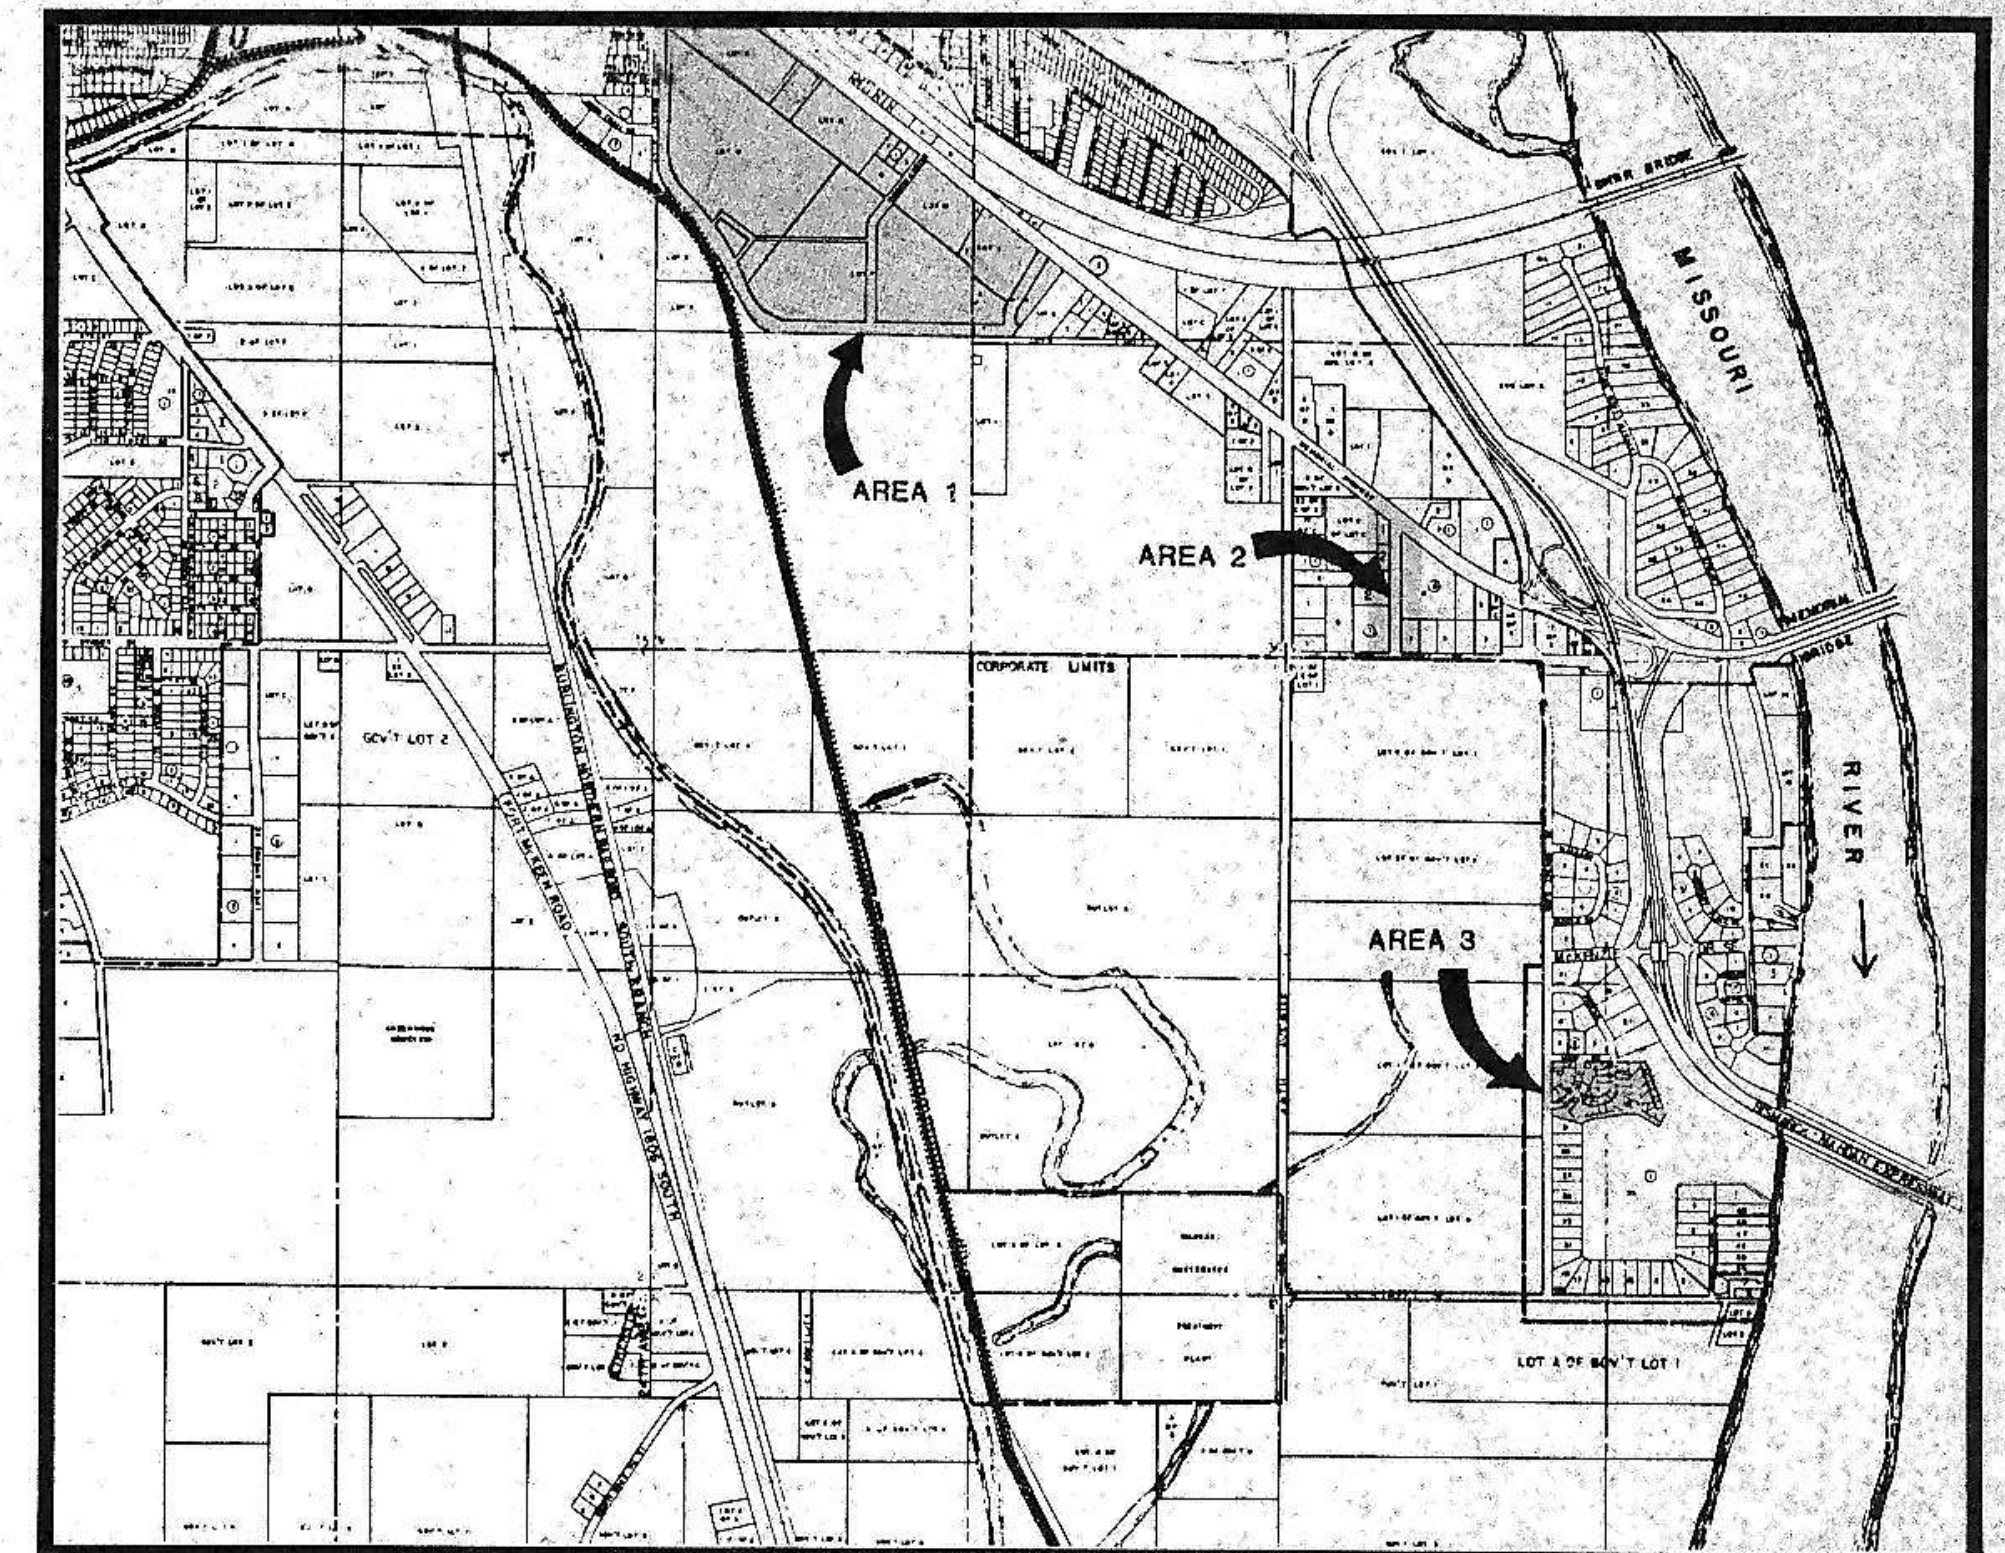

APPROVED: Thomas Little DATE: 5-20-1989  
THOMAS LITTLE, R.P.E. CITY ENGINEER, MANDAN, NORTH DAKOTA

AS-BUILT




PREPARED BY:

TOMAN ENGINEERING CO. ★ CONSULTING ENGINEERS ★ MANDAN, NORTH DAKOTA

D 89-5

D 81

GEORGE J. TOMAN, R.P.E. 185  
SENIOR ENGINEER

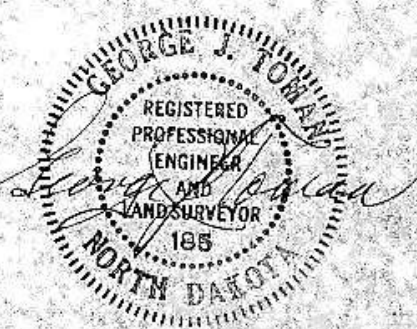

7

2