


TOMAH ENGINEERING COMPANY
CONSULTING CIVIL & ENVIRONMENTAL ENGINEERS
Mandan, North Dakota 58554

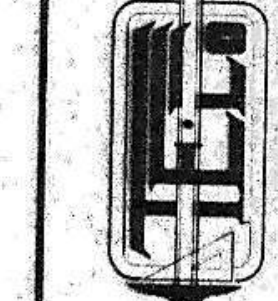

PROJECT: STREET IMPROVEMENT
DISTRICT NO. 81
MANDAN, NORTH DAKOTA

TITLE		DATE		BY	
DETAIL SHEET					
NO.					
SHEET NUMBER					
OF SHEETS					