
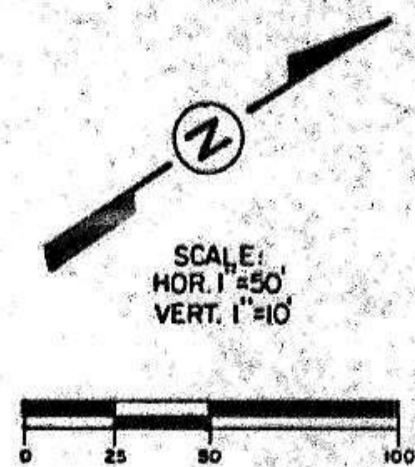








**RACE TRACK & RODEO ARENA STORM SEWER PLAN & PROFILE**

PLAN  
 REVISED AS-BUILT CORRECTIONS  
 DATE: 1-91  
 BY: JRM

PROFILE  
 REVISED AS-BUILT CORRECTIONS  
 DATE: 1-91  
 BY: JRM

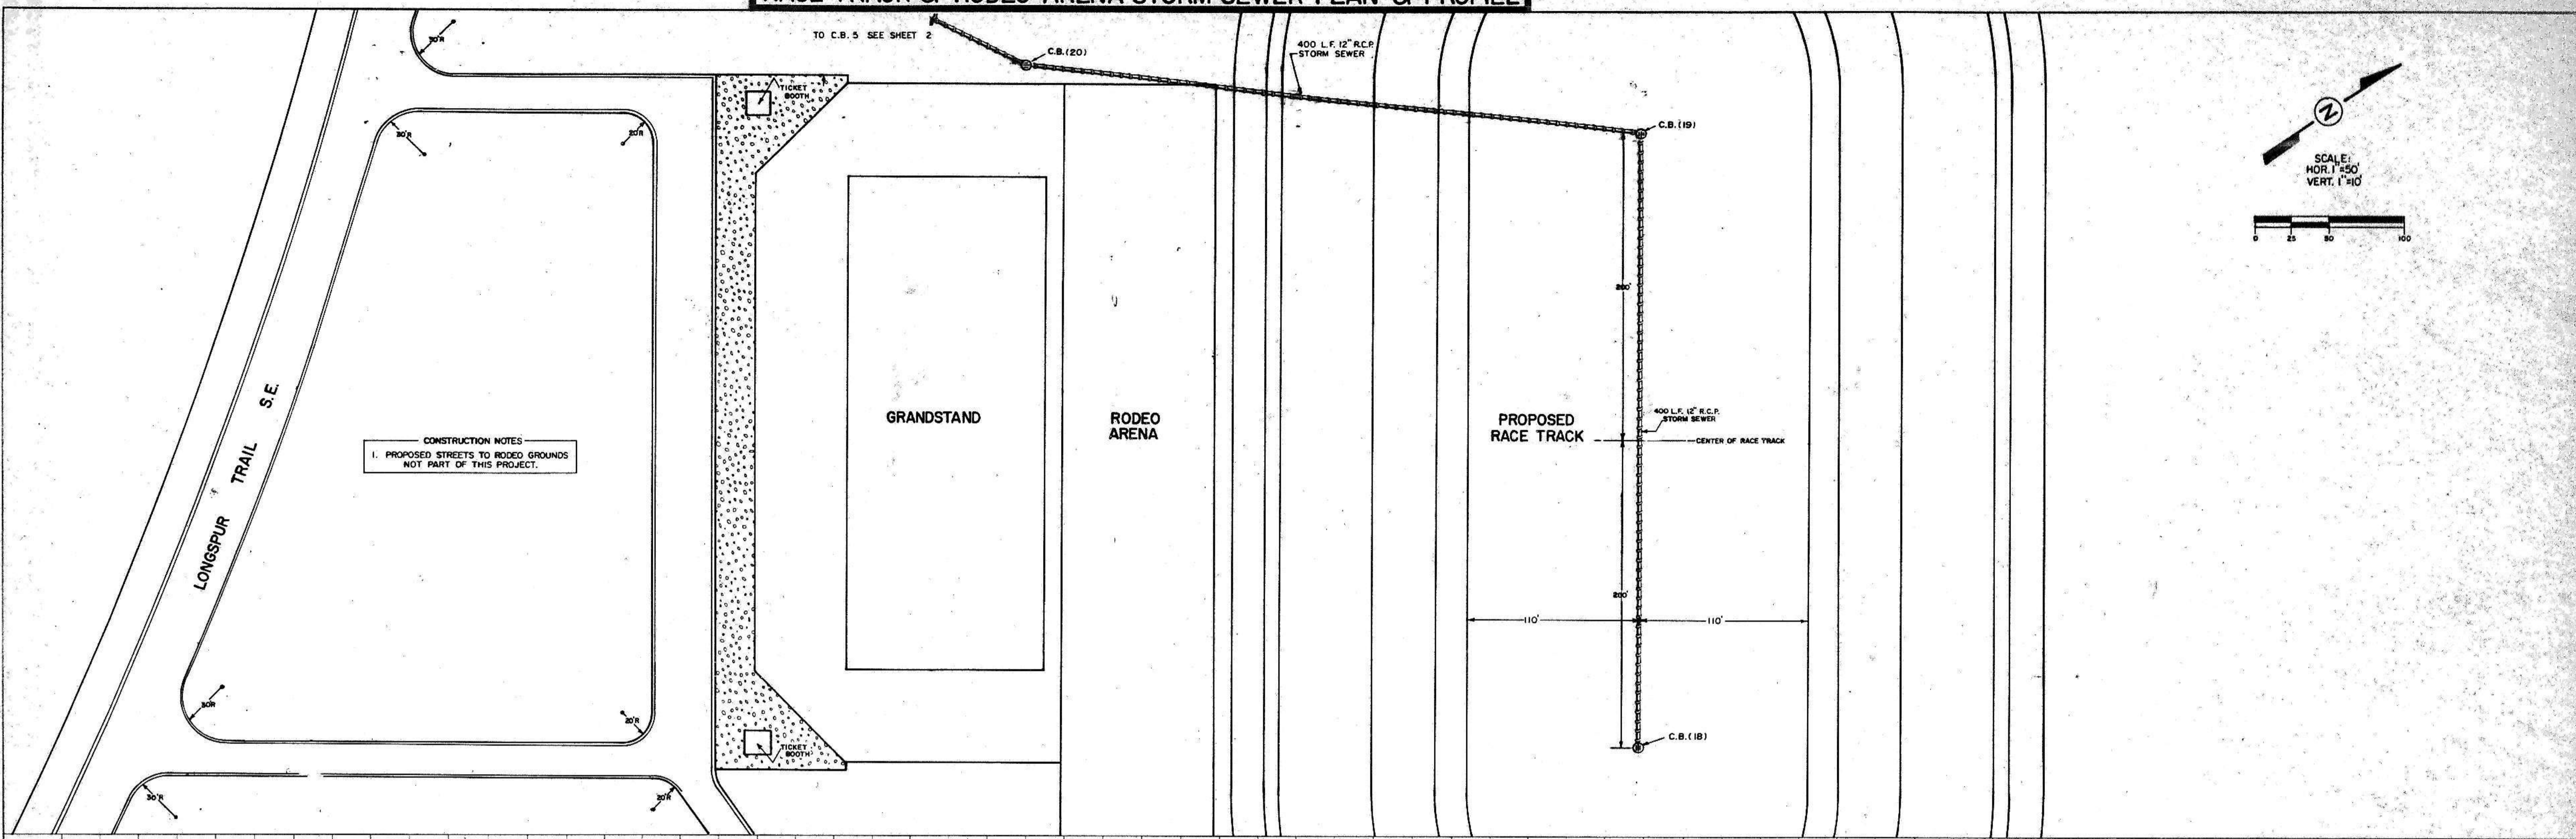

CONSTRUCTION NOTES  
 1. PROPOSED STREETS TO RODEO GROUNDS NOT PART OF THIS PROJECT.

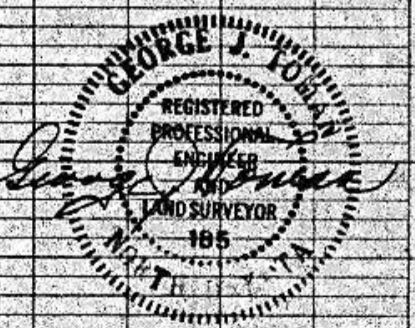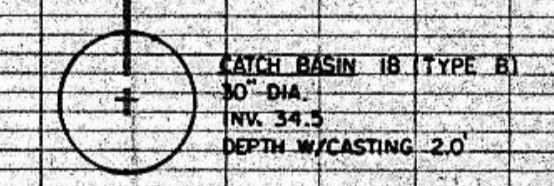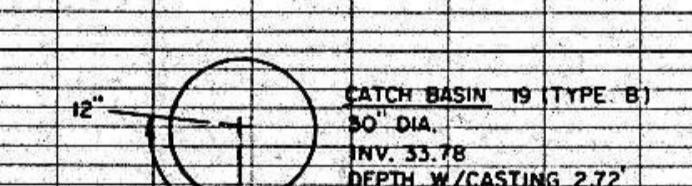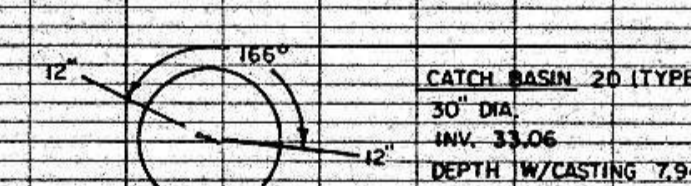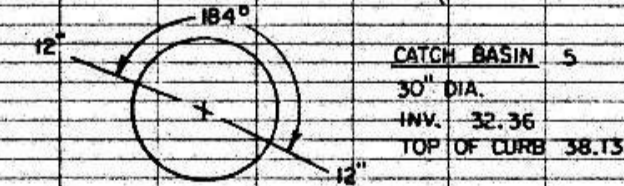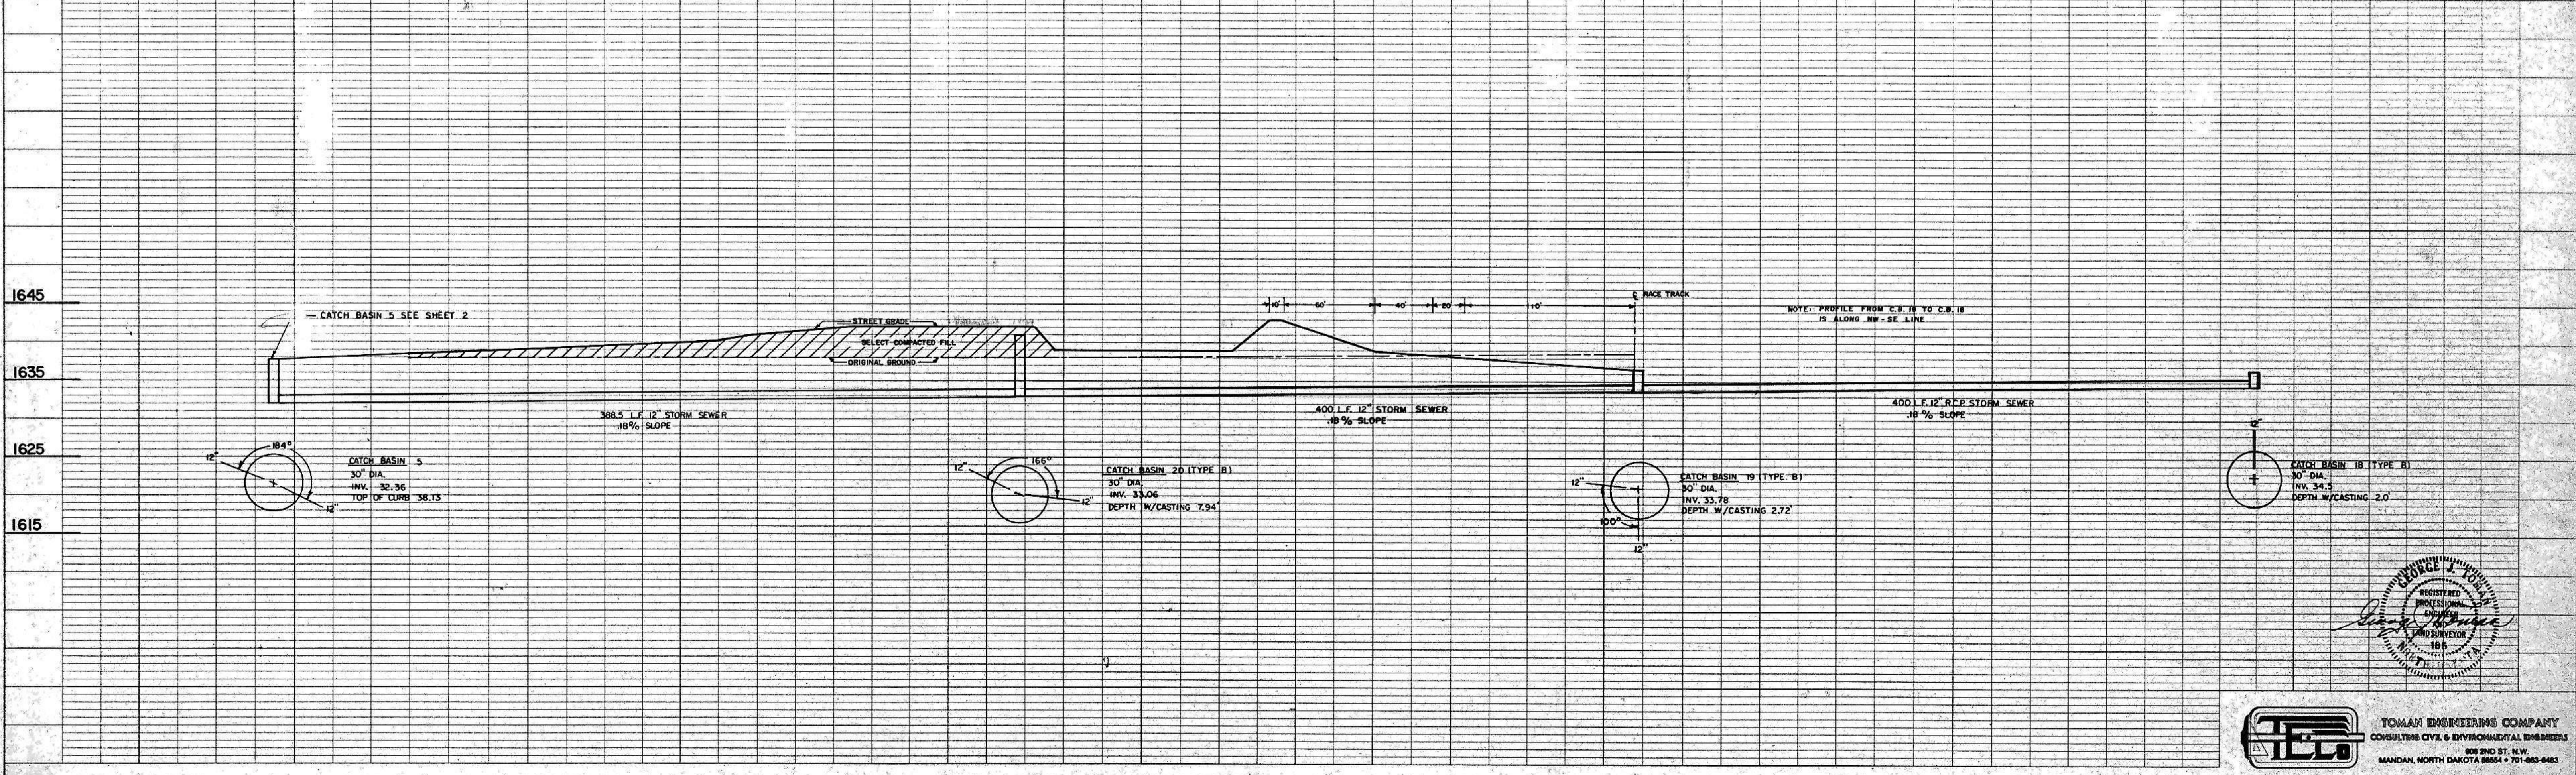

**TOMLAN ENGINEERING COMPANY**  
 CONSULTING CIVIL & ENVIRONMENTAL ENGINEERS  
 804 2ND ST. N.W.  
 MANDAN, NORTH DAKOTA 58554 • 701-883-8463