

43RD AVE. S.E.

AREA 2

CAUTION
LOCATE ALL BURIED
UTILITIES BEFORE DIGGING.
OVER HEAD POWER

Q CURVE DATA


A	Z	T	R
37°29'48"	52.14'	100.43'	153.61'

- CONSTRUCTION NOTES**
1. DRIVEWAYS TO BE LOCATED IN FIELD. SEE DETAIL FOR DIMENSIONS.
 2. LOCATIONS OF HYDRANTS, VALVES AND STOP SIGNS SHOWN ON THIS SHEET REFLECT PROPOSED RELOCATION.
 3. ALL STATIONING IS TO CENTERLINE OF STREET.
 4. ELEVATIONS SHOWN ARE TOP OF CURB GRADES.
 5. TOP OF CURB GRADES ARE THE SAME CORRESPONDING STATIONS ON BOTH SIDES OF STREET.

SCALE: HOR. 1" = 80'
VERT. 1" = 2'

PLAN
SURVEYED AS-BUILT CORRECTIONS BY JPH
NOTE BOOK ALIGNMENT CHECKED BY JPH
BT. OF MW CHECKED BY JPH
NO.

PROFILE
SURVEYED PLOTTED GRADINGS CHECKED STRUCTURE NOTATIONS CH'D
NOTE BOOK
NO.

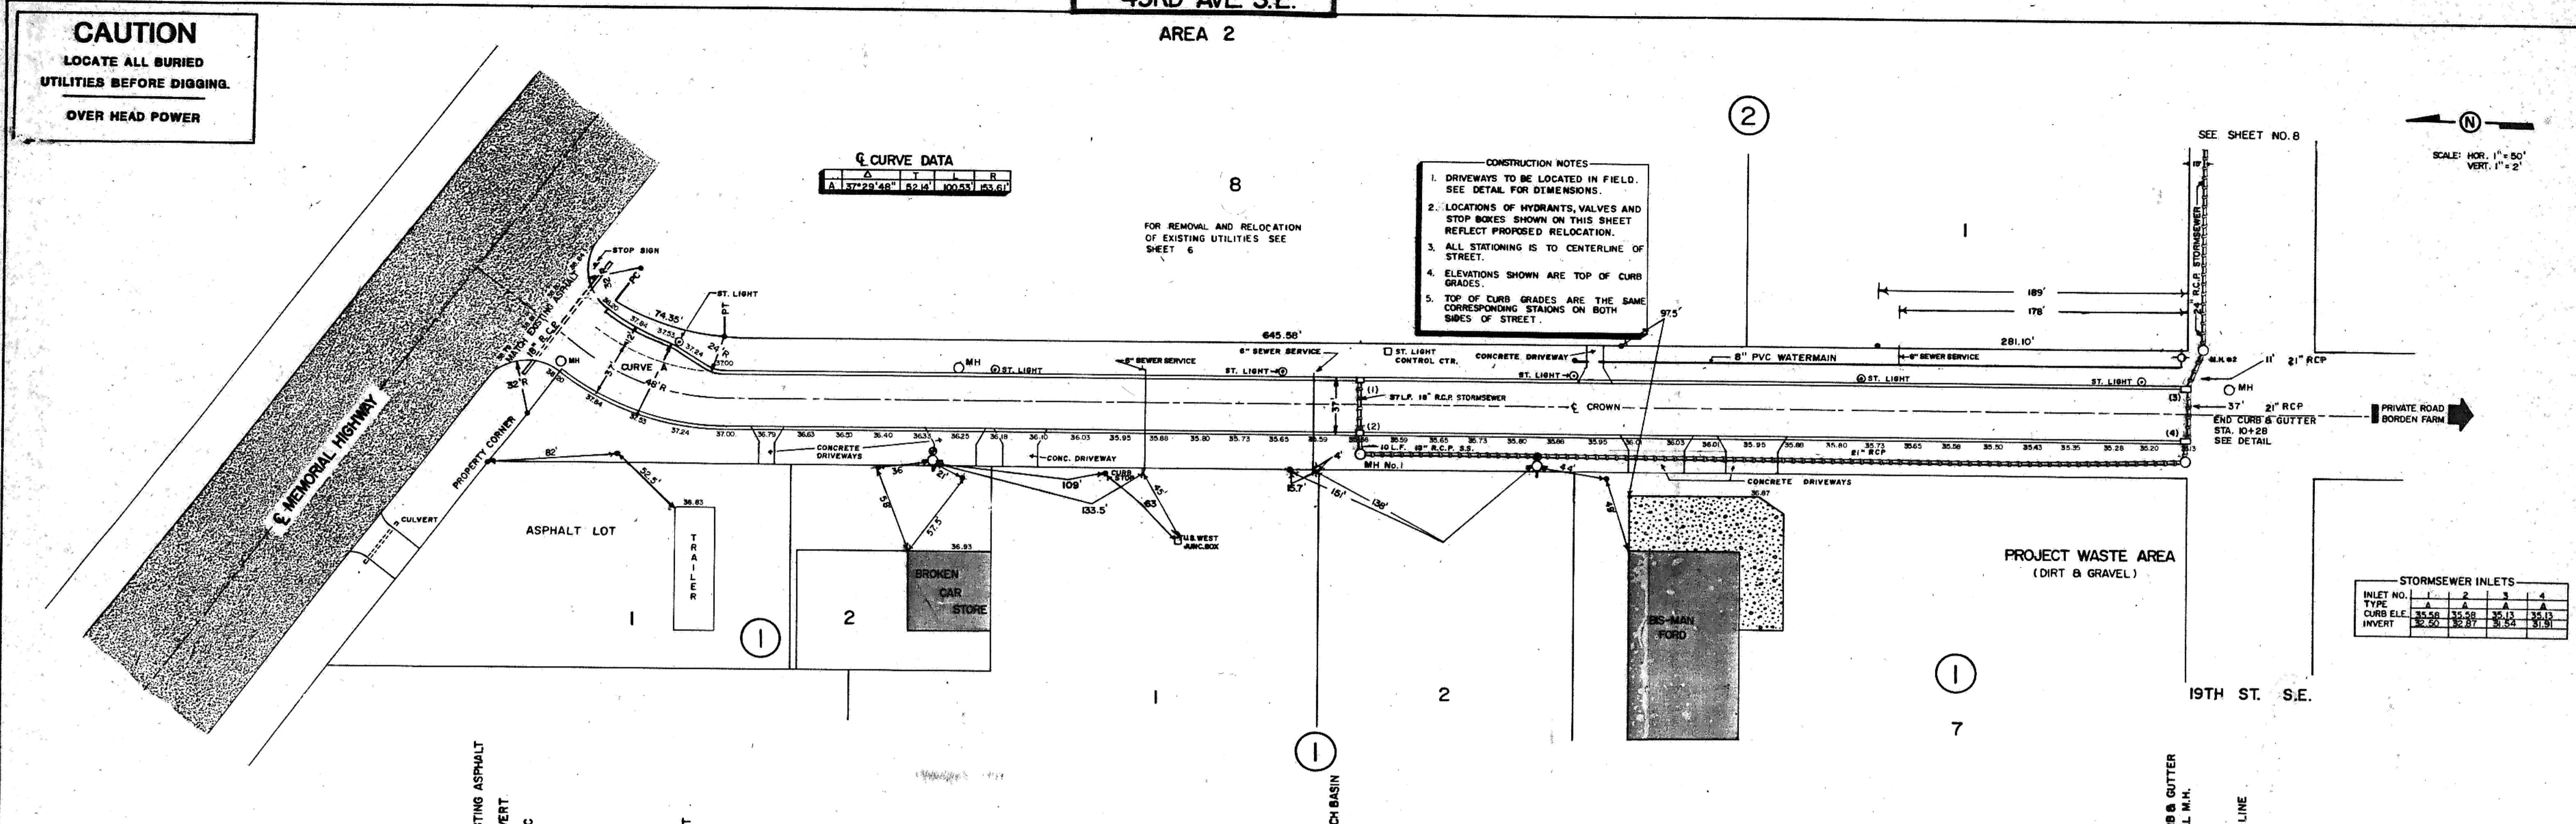

STORMSEWER INLETS

INLET NO.	1	2	3	4
TYPE	A	A	A	A
CURB ELE.	35.58	35.58	35.13	35.13
INVERT	32.50	32.87	32.54	31.91

