


STREET IMPROVEMENT DISTRICT NO. 86 MANDAN, NORTH DAKOTA

(CITY PROJECT NO. 92-2)
TECO NO.2056


AREA A

AREA B

INDEX OF DRAWINGS	
SHT	TITLE
1	TITLE SHEET
2	AREA A, 56TH AVE N.W. PLAN & PROFILE
3	AREA B, 2ND ST S.E. & 4TH AVE S.E. PLAN VIEW
4	DETAIL SHEET

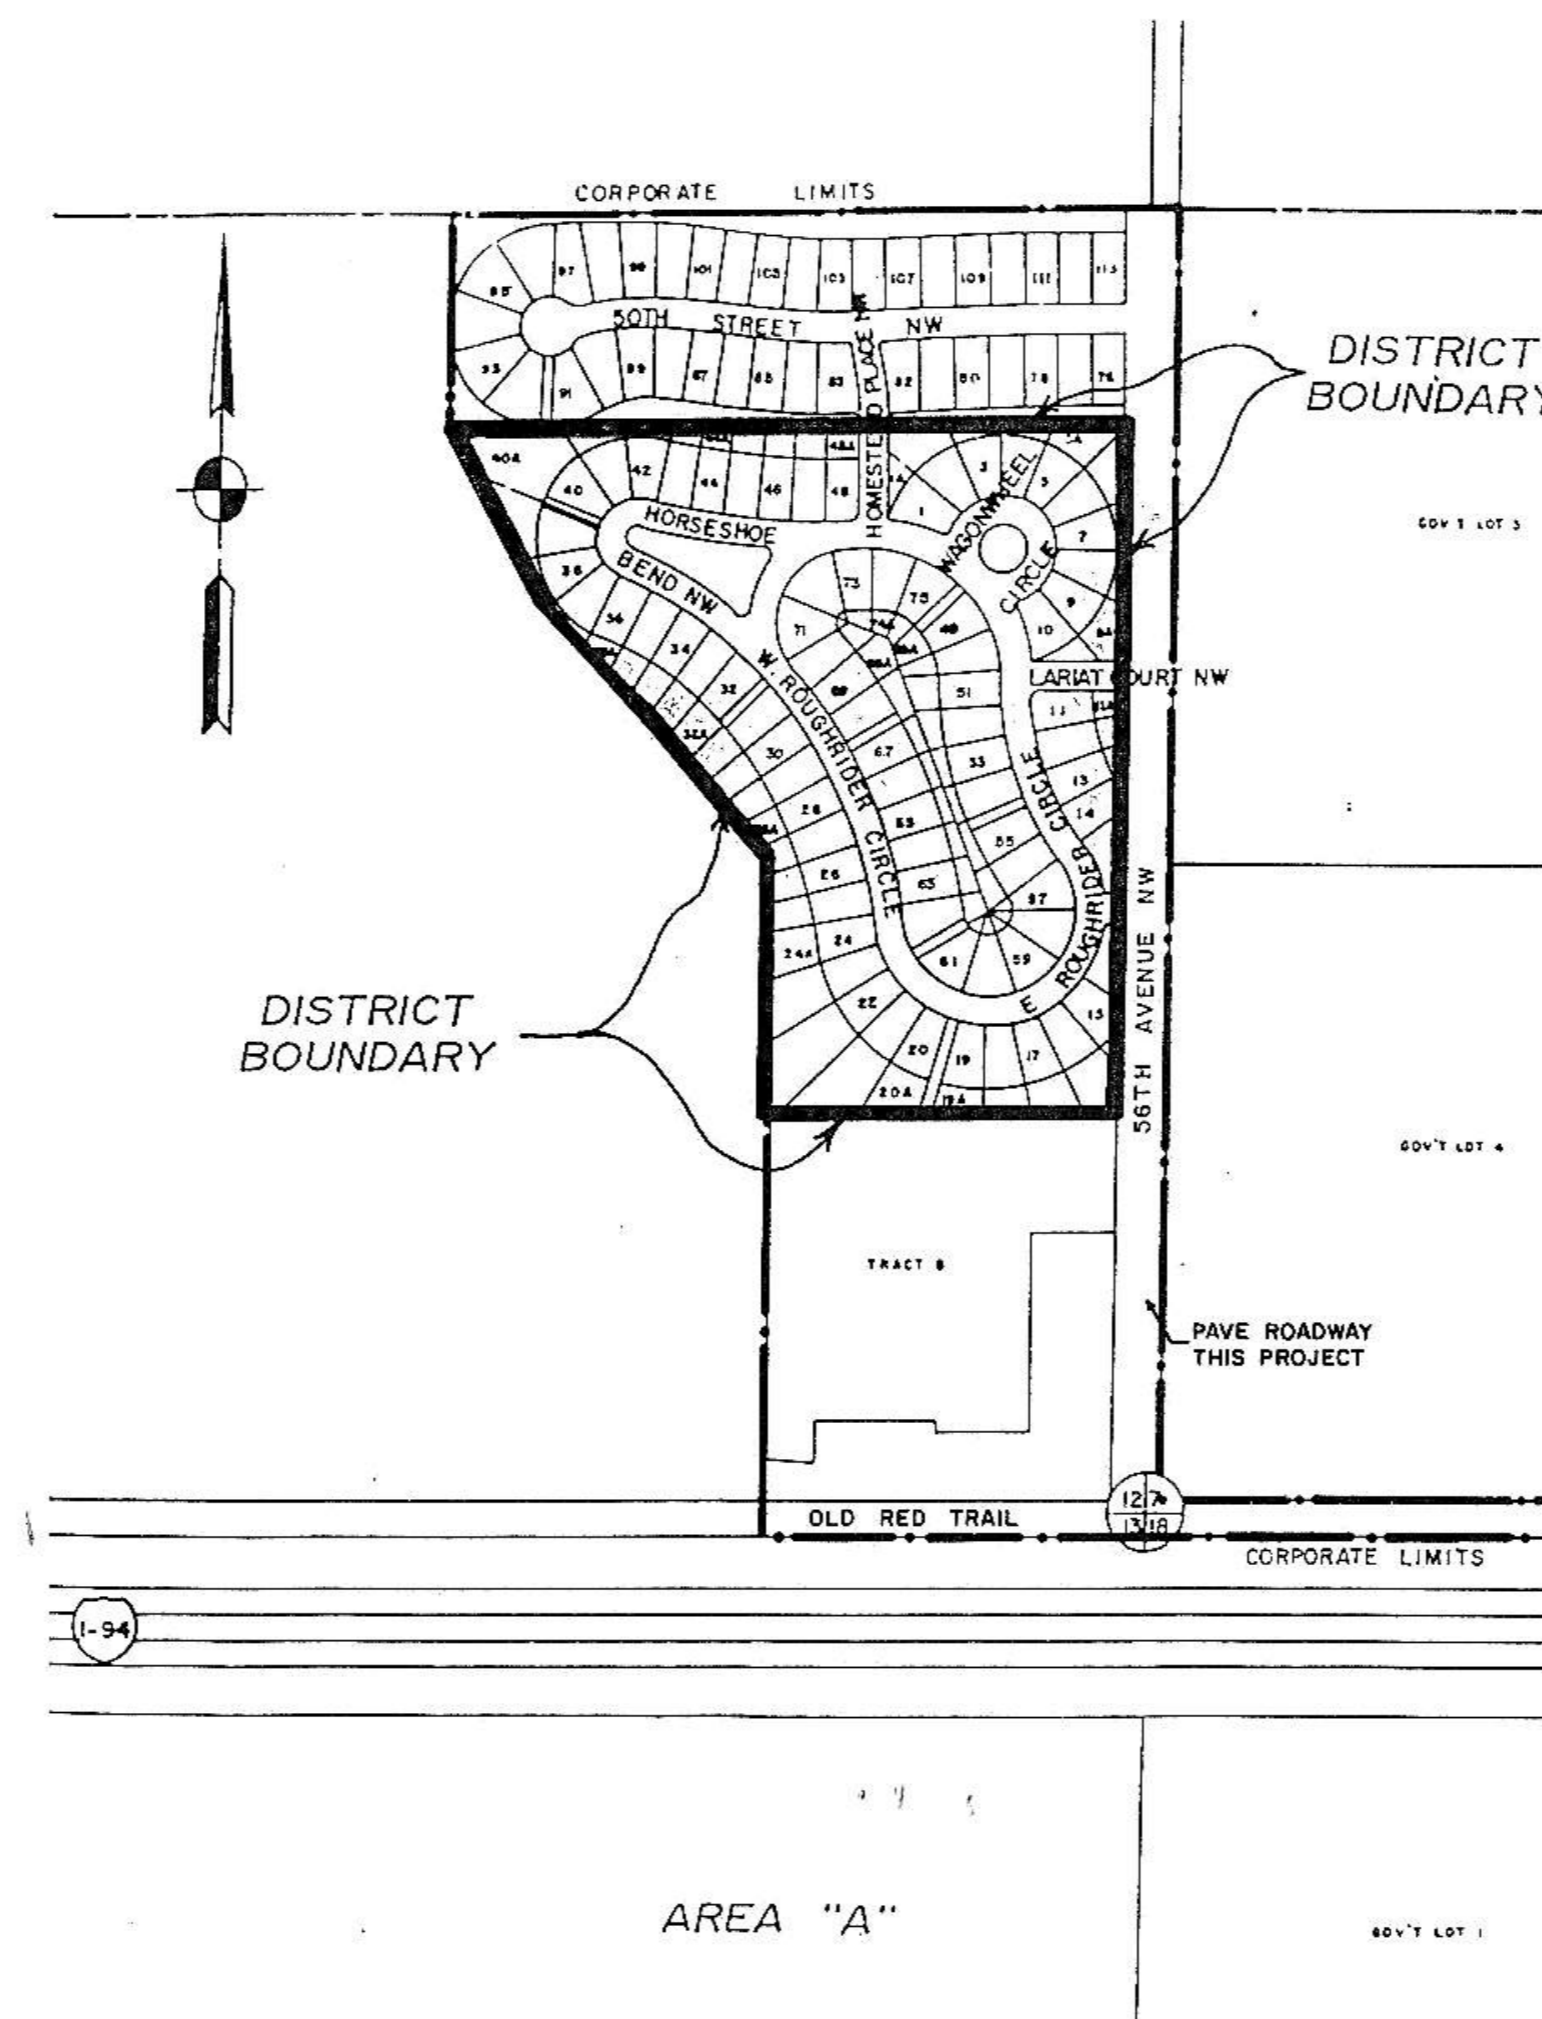

APPROVED: Thomas Little DATE: June 19, 1992
THOMAS LITTLE, R.P.E. CITY ENGINEER, MANDAN, NORTH DAKOTA

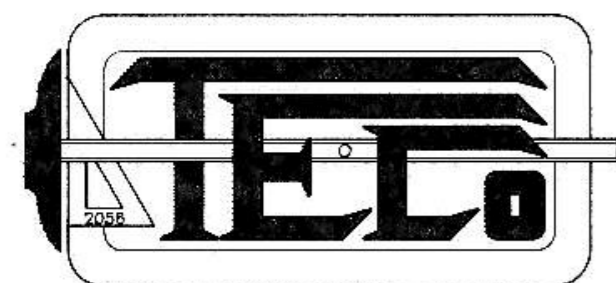

PREPARED BY:
TOMAN ENGINEERING
RONALD MANCHESTER R.P.E. 3252
DATE: 6/19/1992



TOMAN ENGINEERING CO. ★ CONSULTING ENGINEERS ★ MANDAN, NORTH DAKOTA

CONSULTING CIVIL & ENVIRONMENTAL ENGINEERS
906 2ND ST N.W. • MANDAN, NORTH DAKOTA 58554 • 701-663-6483


JUNE 1992

AREA "A"


STREET IMPROVEMENT DIST. 86 MANDAN, NORTH DAKOTA




SCALE: 1"=60'

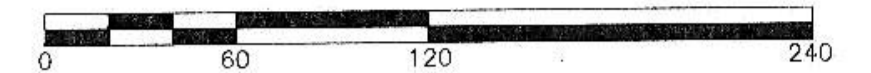


CAUTION
LOCATE ALL BURIED
UTILITIES BEFORE DIGGING
OVER HEAD POWER

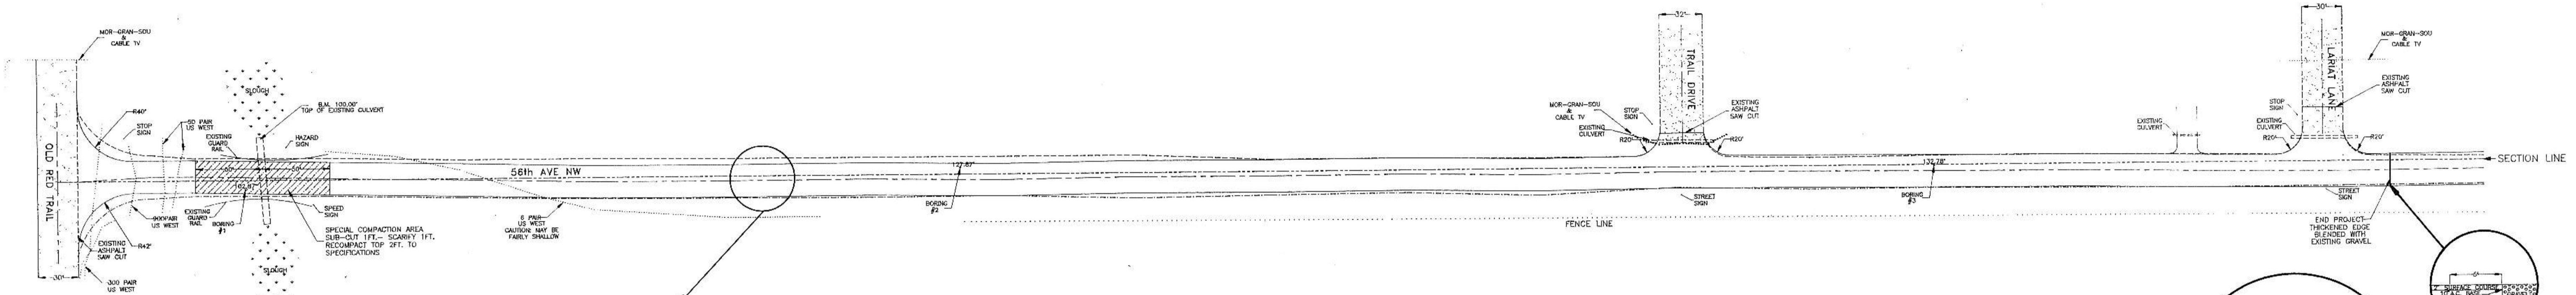



- NOTE:**
1. ALL DISTURBED AREAS TO BE SEEDED
 2. CONTRACTOR TO MAINTAIN TRAFFIC AT ALL TIMES. CONSTRUCTION SIGNING TO BE INCIDENTAL TO PROJECT

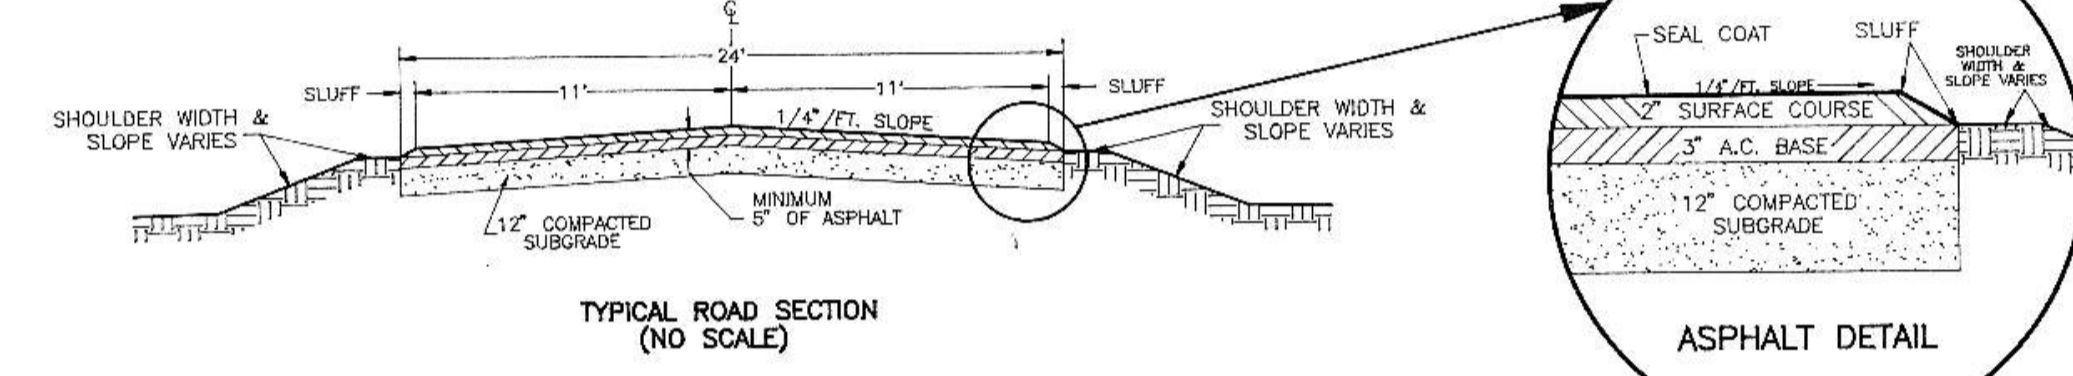

CAUTION
LOCATE ALL BURIED
UTILITIES BEFORE DIGGING
OVER HEAD POWER

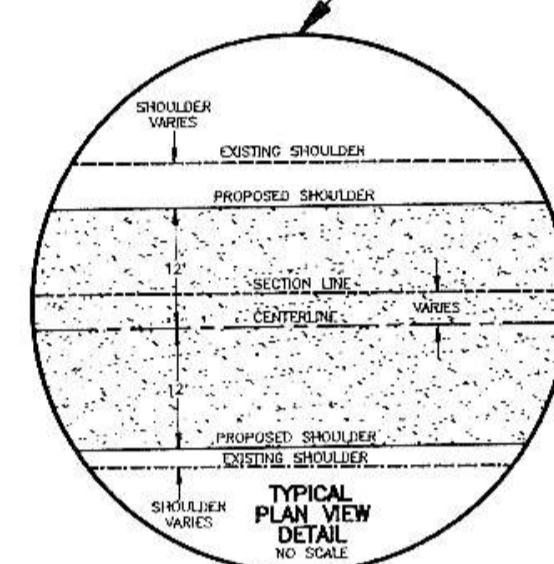

SCALE: HORZ: 1"=60'
VERT: 1"=5'

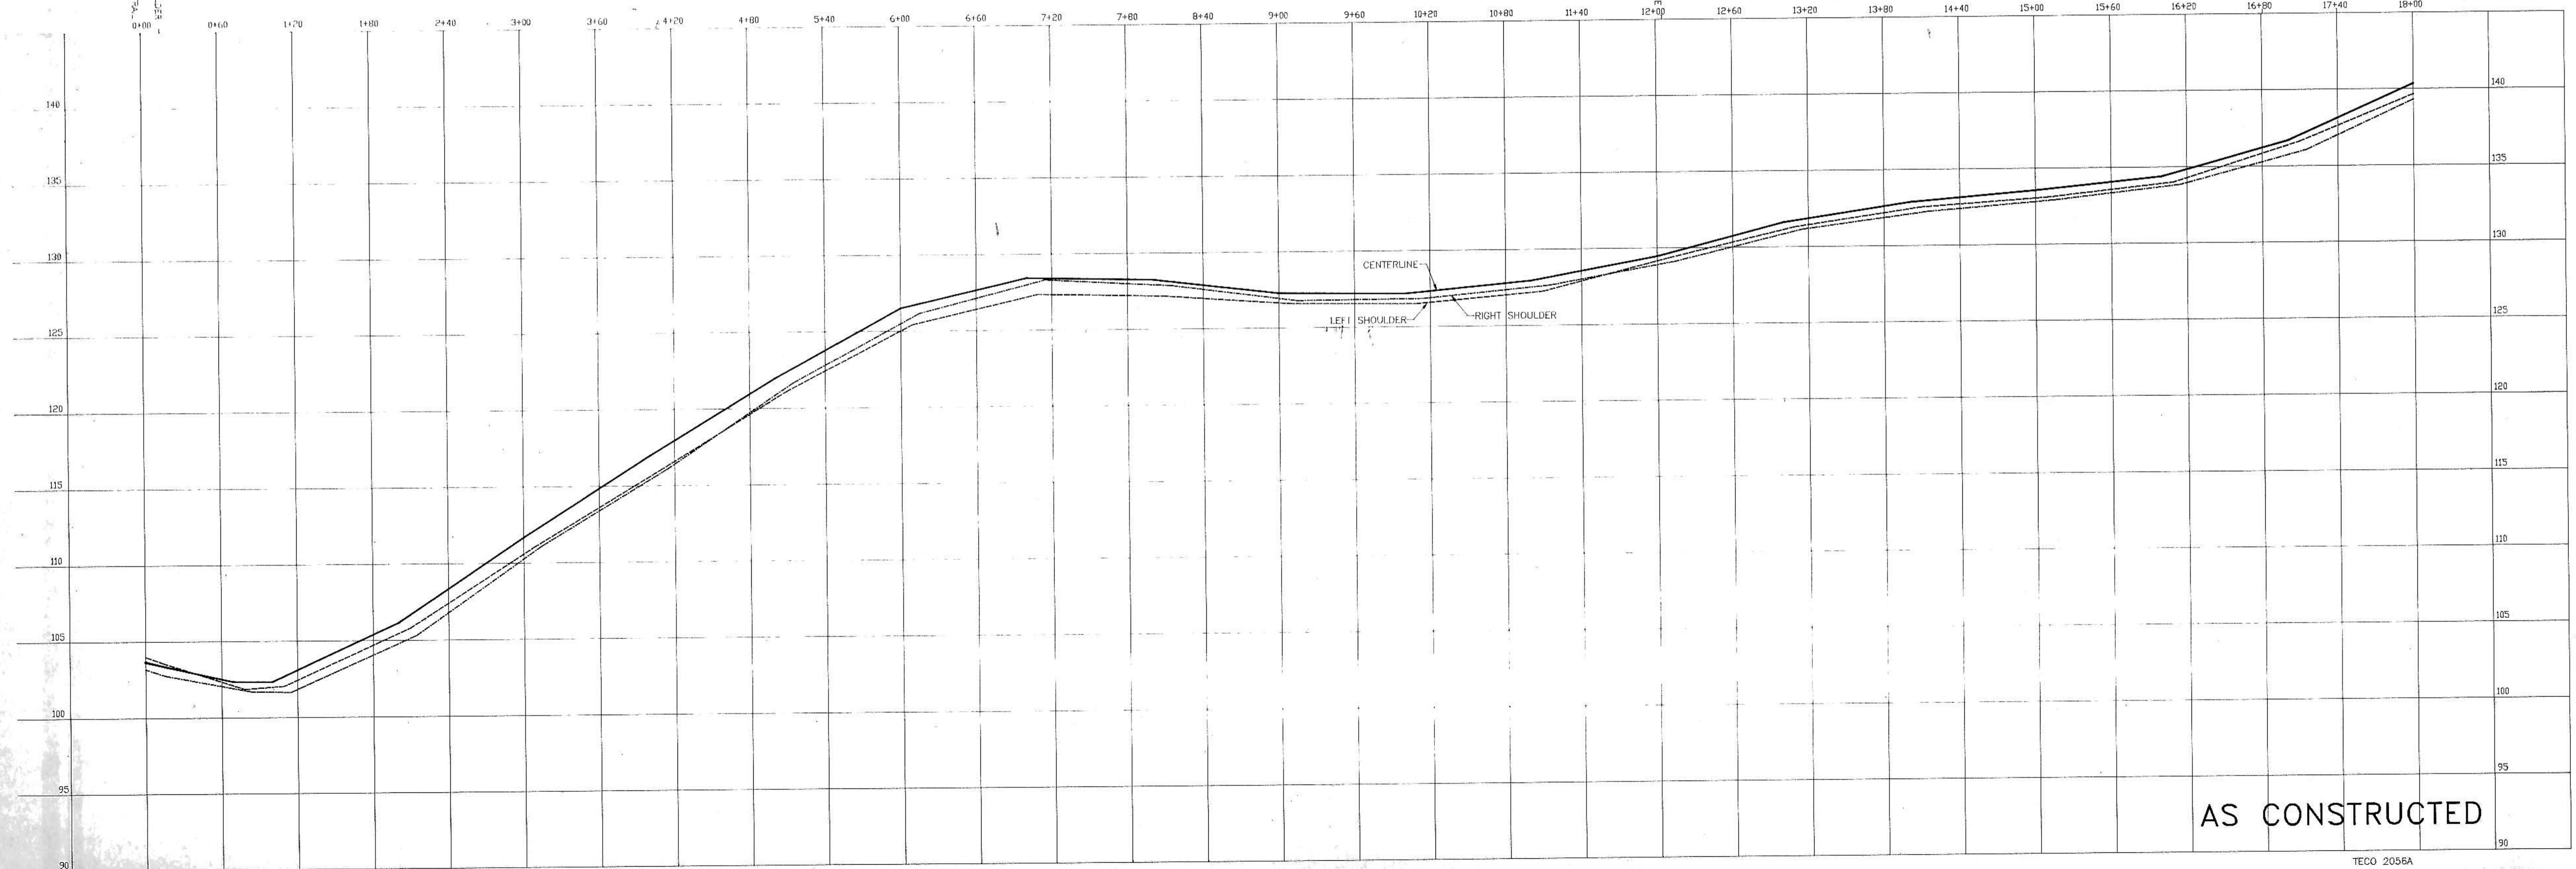
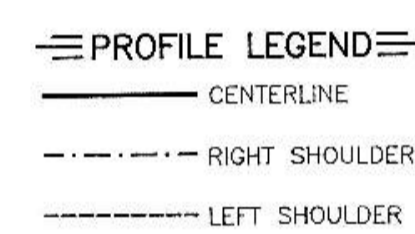


AS CONSTRUCTED

TECO 2056A

AREA "B" STREET IMPROVEMENT DIST. 86 MANDAN, NORTH DAKOTA

CAUTION
LOCATE ALL BURIED UTILITIES BEFORE DIGGING
OVER HEAD POWER

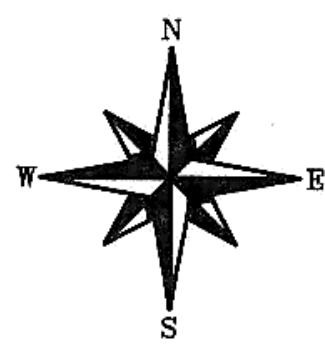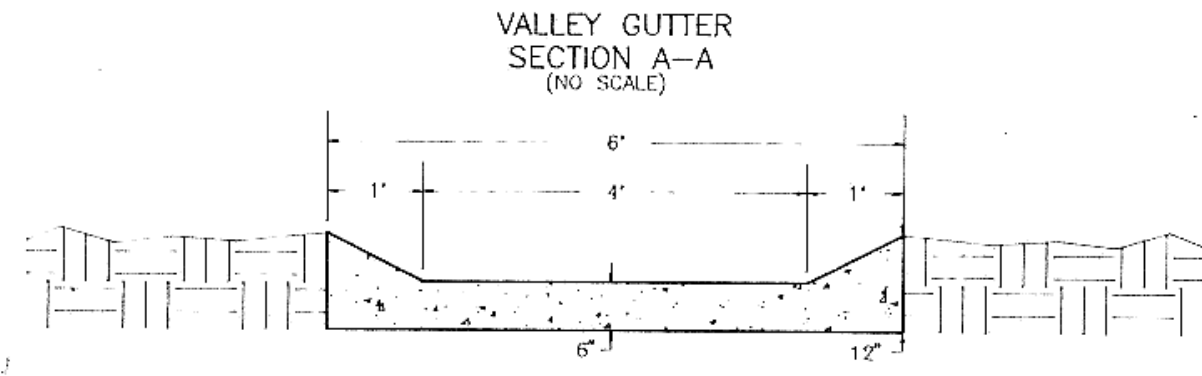


SCALE: 1"=20'
JANUARY 1993


- LEGEND**
- ⊕ MANHOLE
 - POWER POLE
 - HYDRANT
 - STREET LIGHT
 - STOP SIGN
 - GATE VALVE
 - ▨ EXISTING ASPHALT
 - ▨ EXISTING CONCRETE
 - PROPERTY LINE
 - 97.11 EXISTING ELEVATION
 - 97.69 TOP OF CURB ELEVATION
 - == PROPOSED CURB & GUTTER
 - - - APPROXIMATE LOCATION WATERMAIN

NOTE: ALL DISTURBED AREAS TO BE SEEDED
ALL DRIVEWAY LOCATIONS TO BE FIELD VERIFIED
ALL AREA "B" STREETS HAVE INVERTED CENTERLINES

CONTRACTOR
NORTHERN IMPROVEMENT CO.

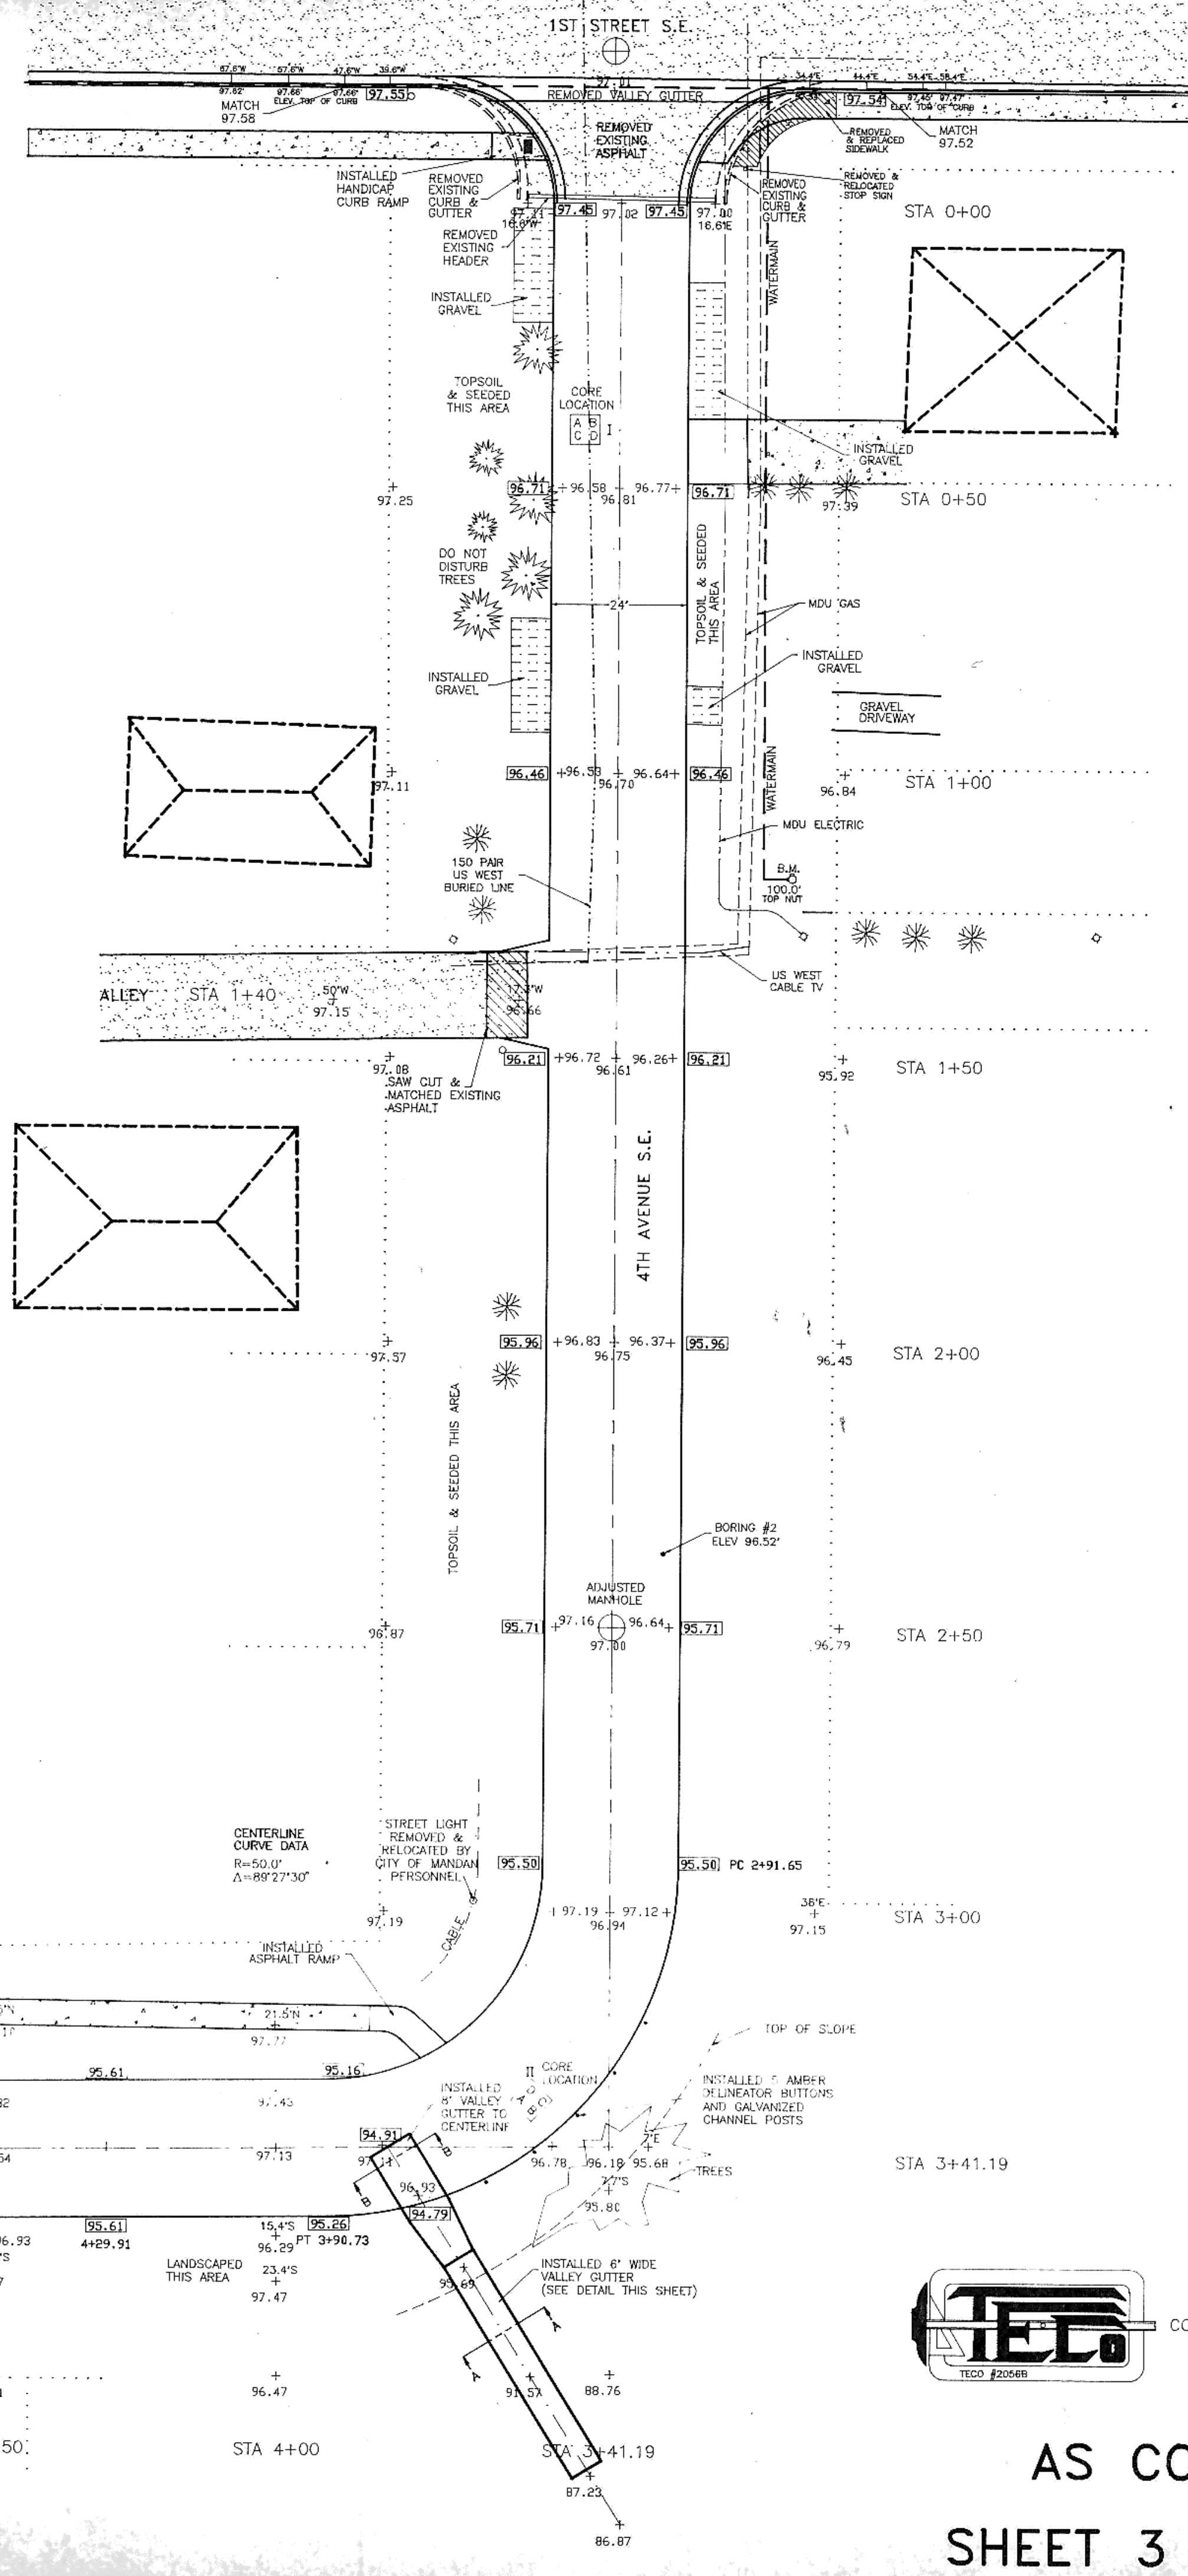

CAUTION
LOCATE ALL BURIED UTILITIES BEFORE DIGGING
OVER HEAD POWER

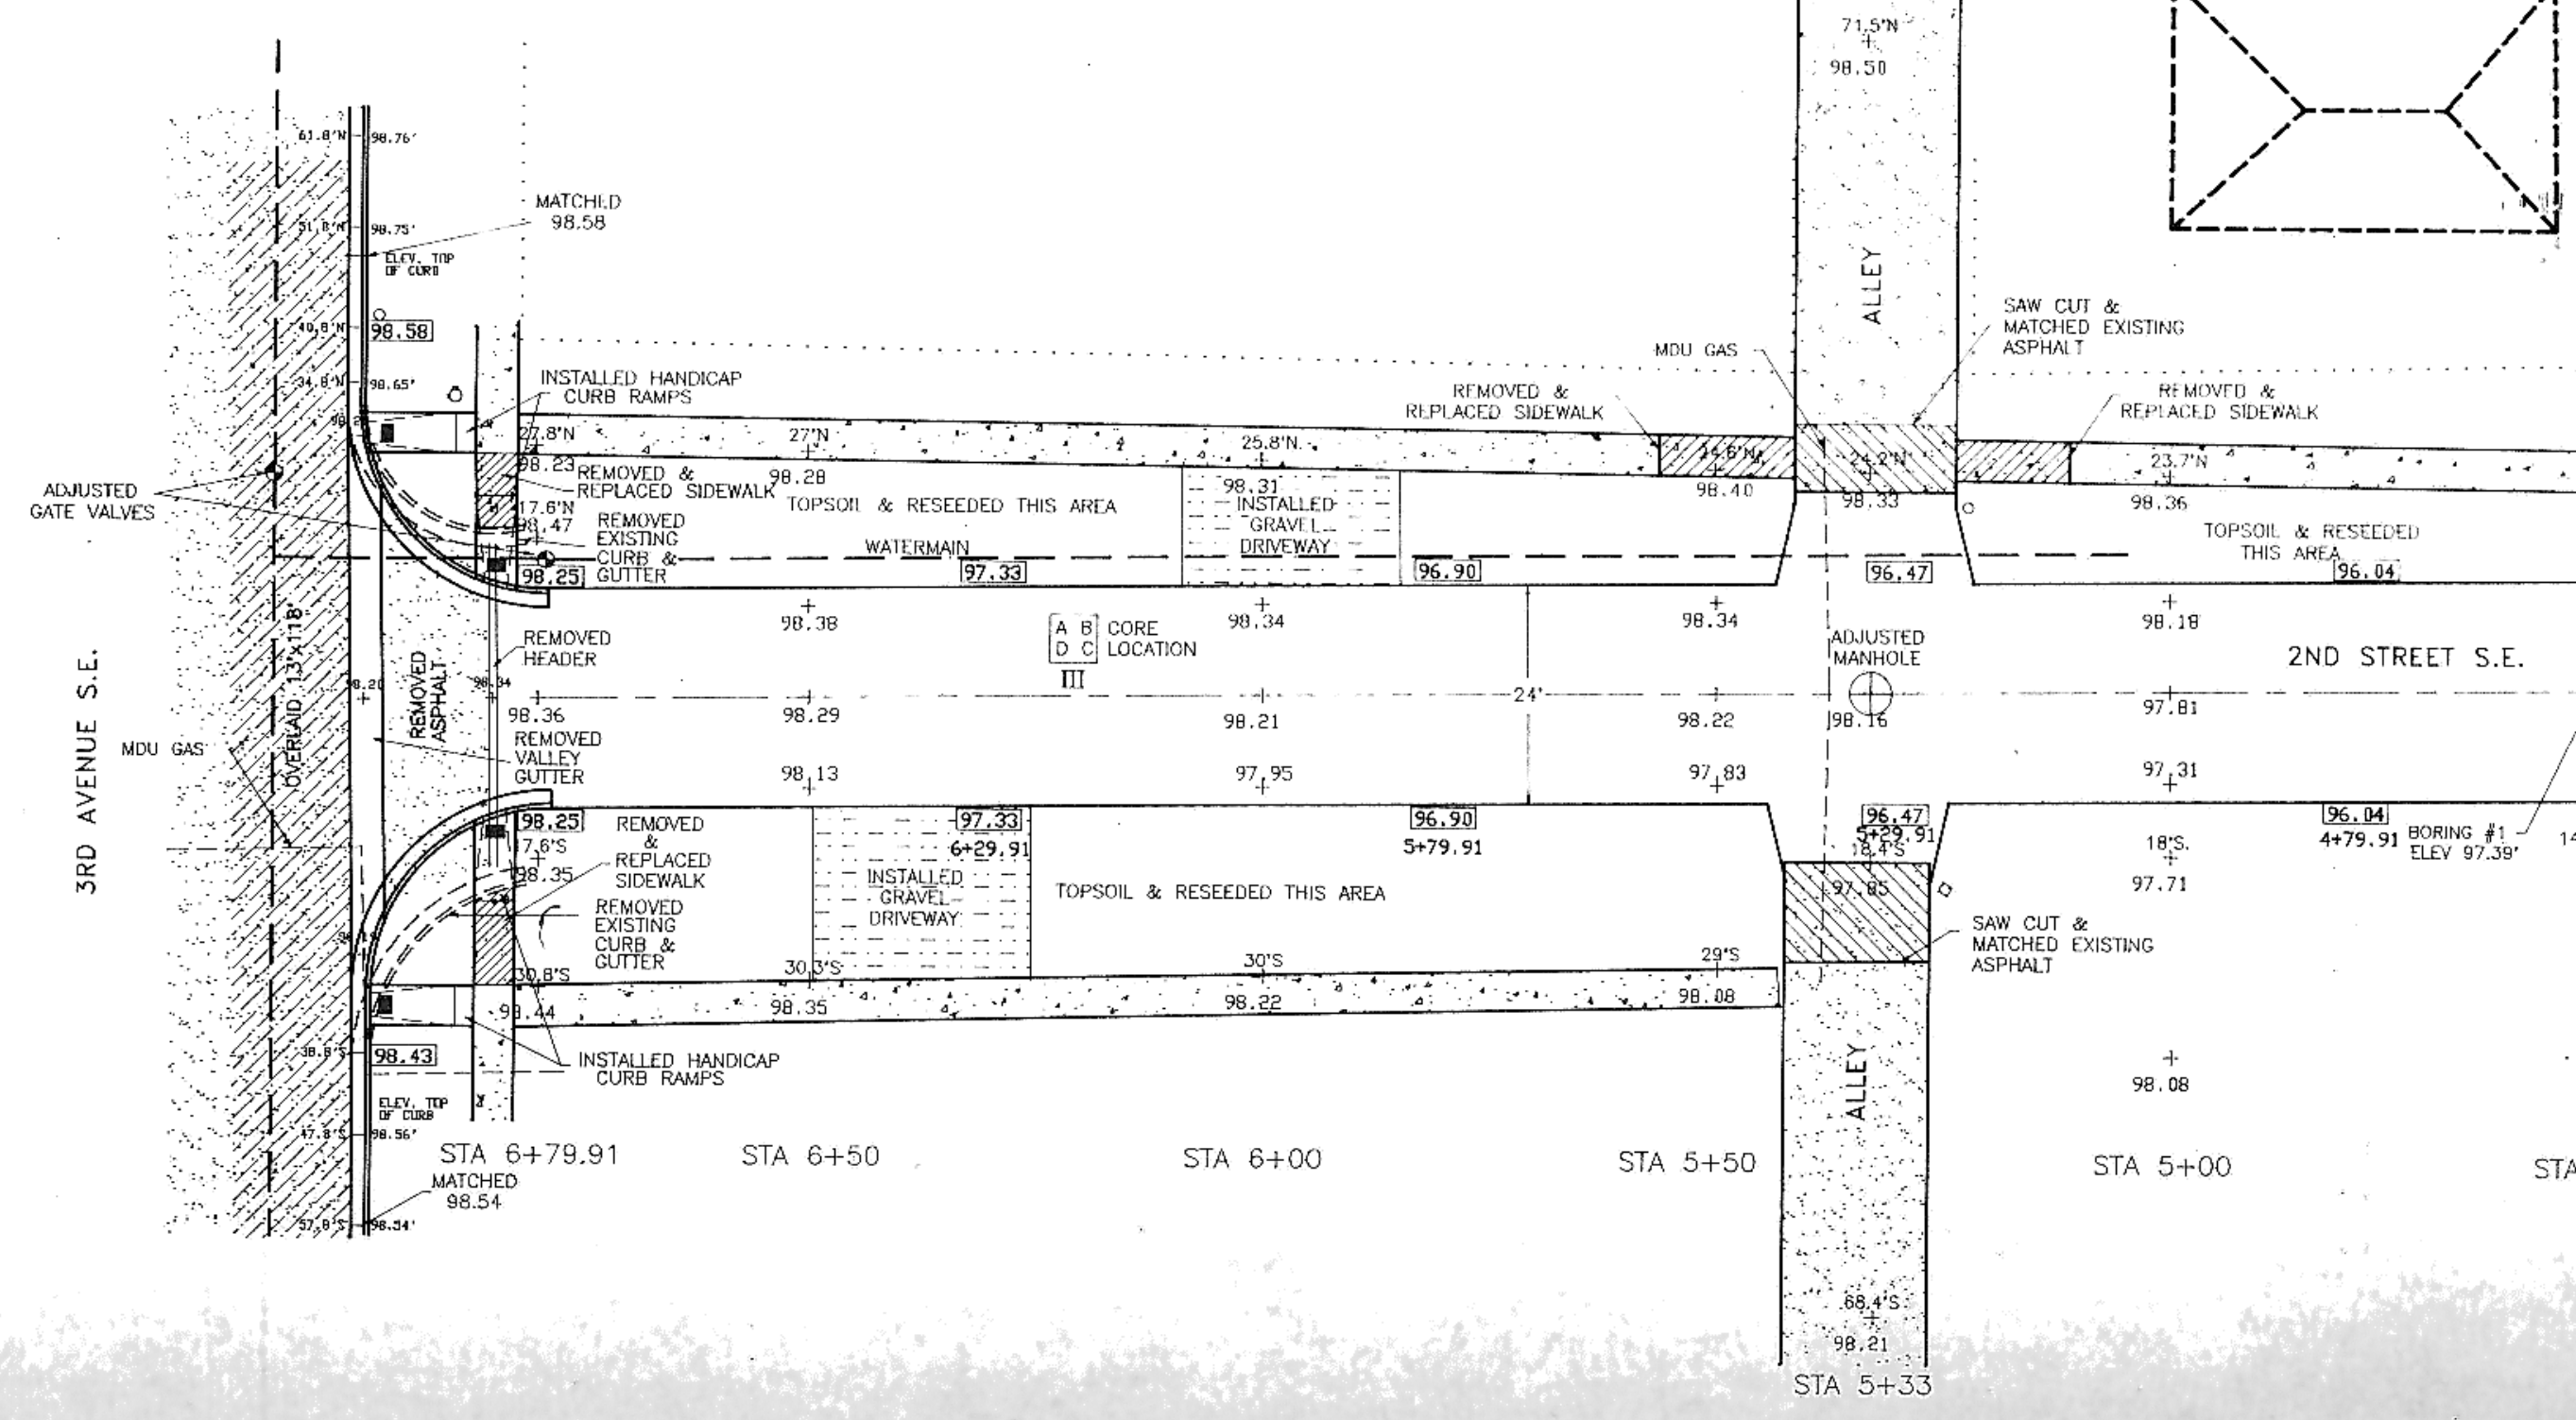

TOMAN ENGINEERING COMPANY
CONSULTING CIVIL & ENVIRONMENTAL ENGINEERS
906 2ND ST. N.W. • BISMARCK, NORTH DAKOTA 58504 • 701-663-6483

AS CONSTRUCTED
SHEET 3 OF 4 SHEETS