



- LEGEND**
- WATERMAIN
 - GATE VALVE
 - HYDRANT
 - ++++ RAILROAD

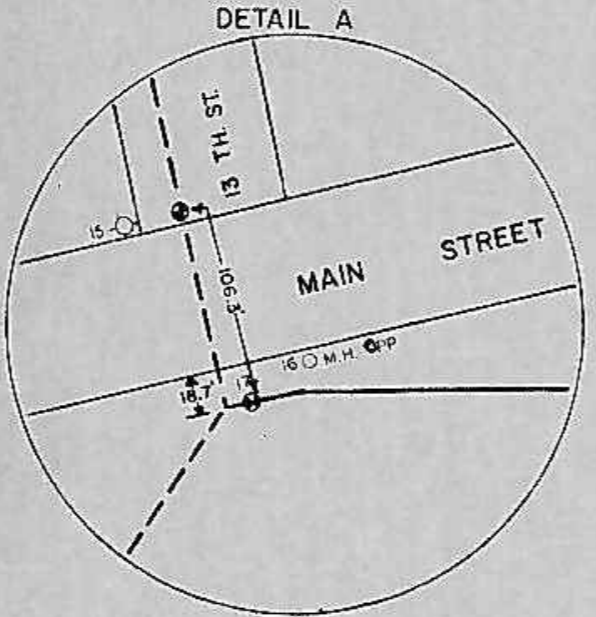

SCALE 1"=100'

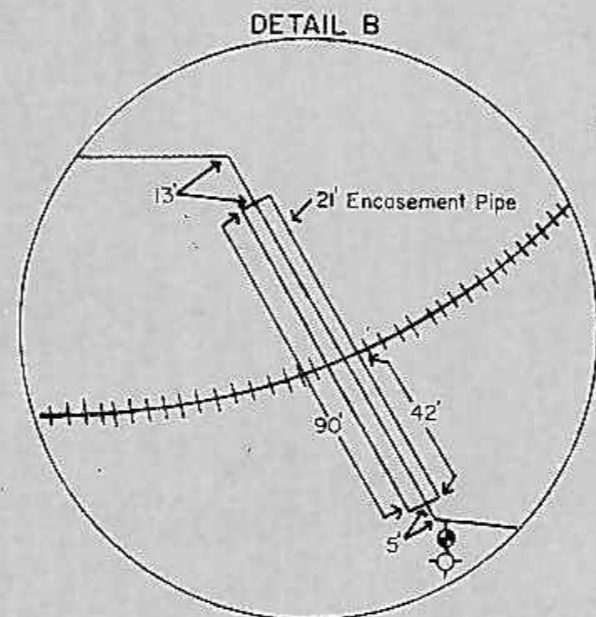

SCALE 1"=50'

15 to 17 = 106.7
16 to 17 = 63.2

SEE SHEET NO. 82

CONSOLIDATED WATER AND SEWER IMPROVEMENT DISTRICT NO. 18		
12" A.C. WATERMAIN	SCALE 1" = 200'	DRAWN BY <i>R.M.</i> REVISED
CONTRACTOR — DELZER CONST. CO.		
DATE JAN. 1975	TWIN CITY INDUSTRIAL SITES	DRAWING NUMBER