


# TWIN CITY INDUSTRIAL SITES


# 80

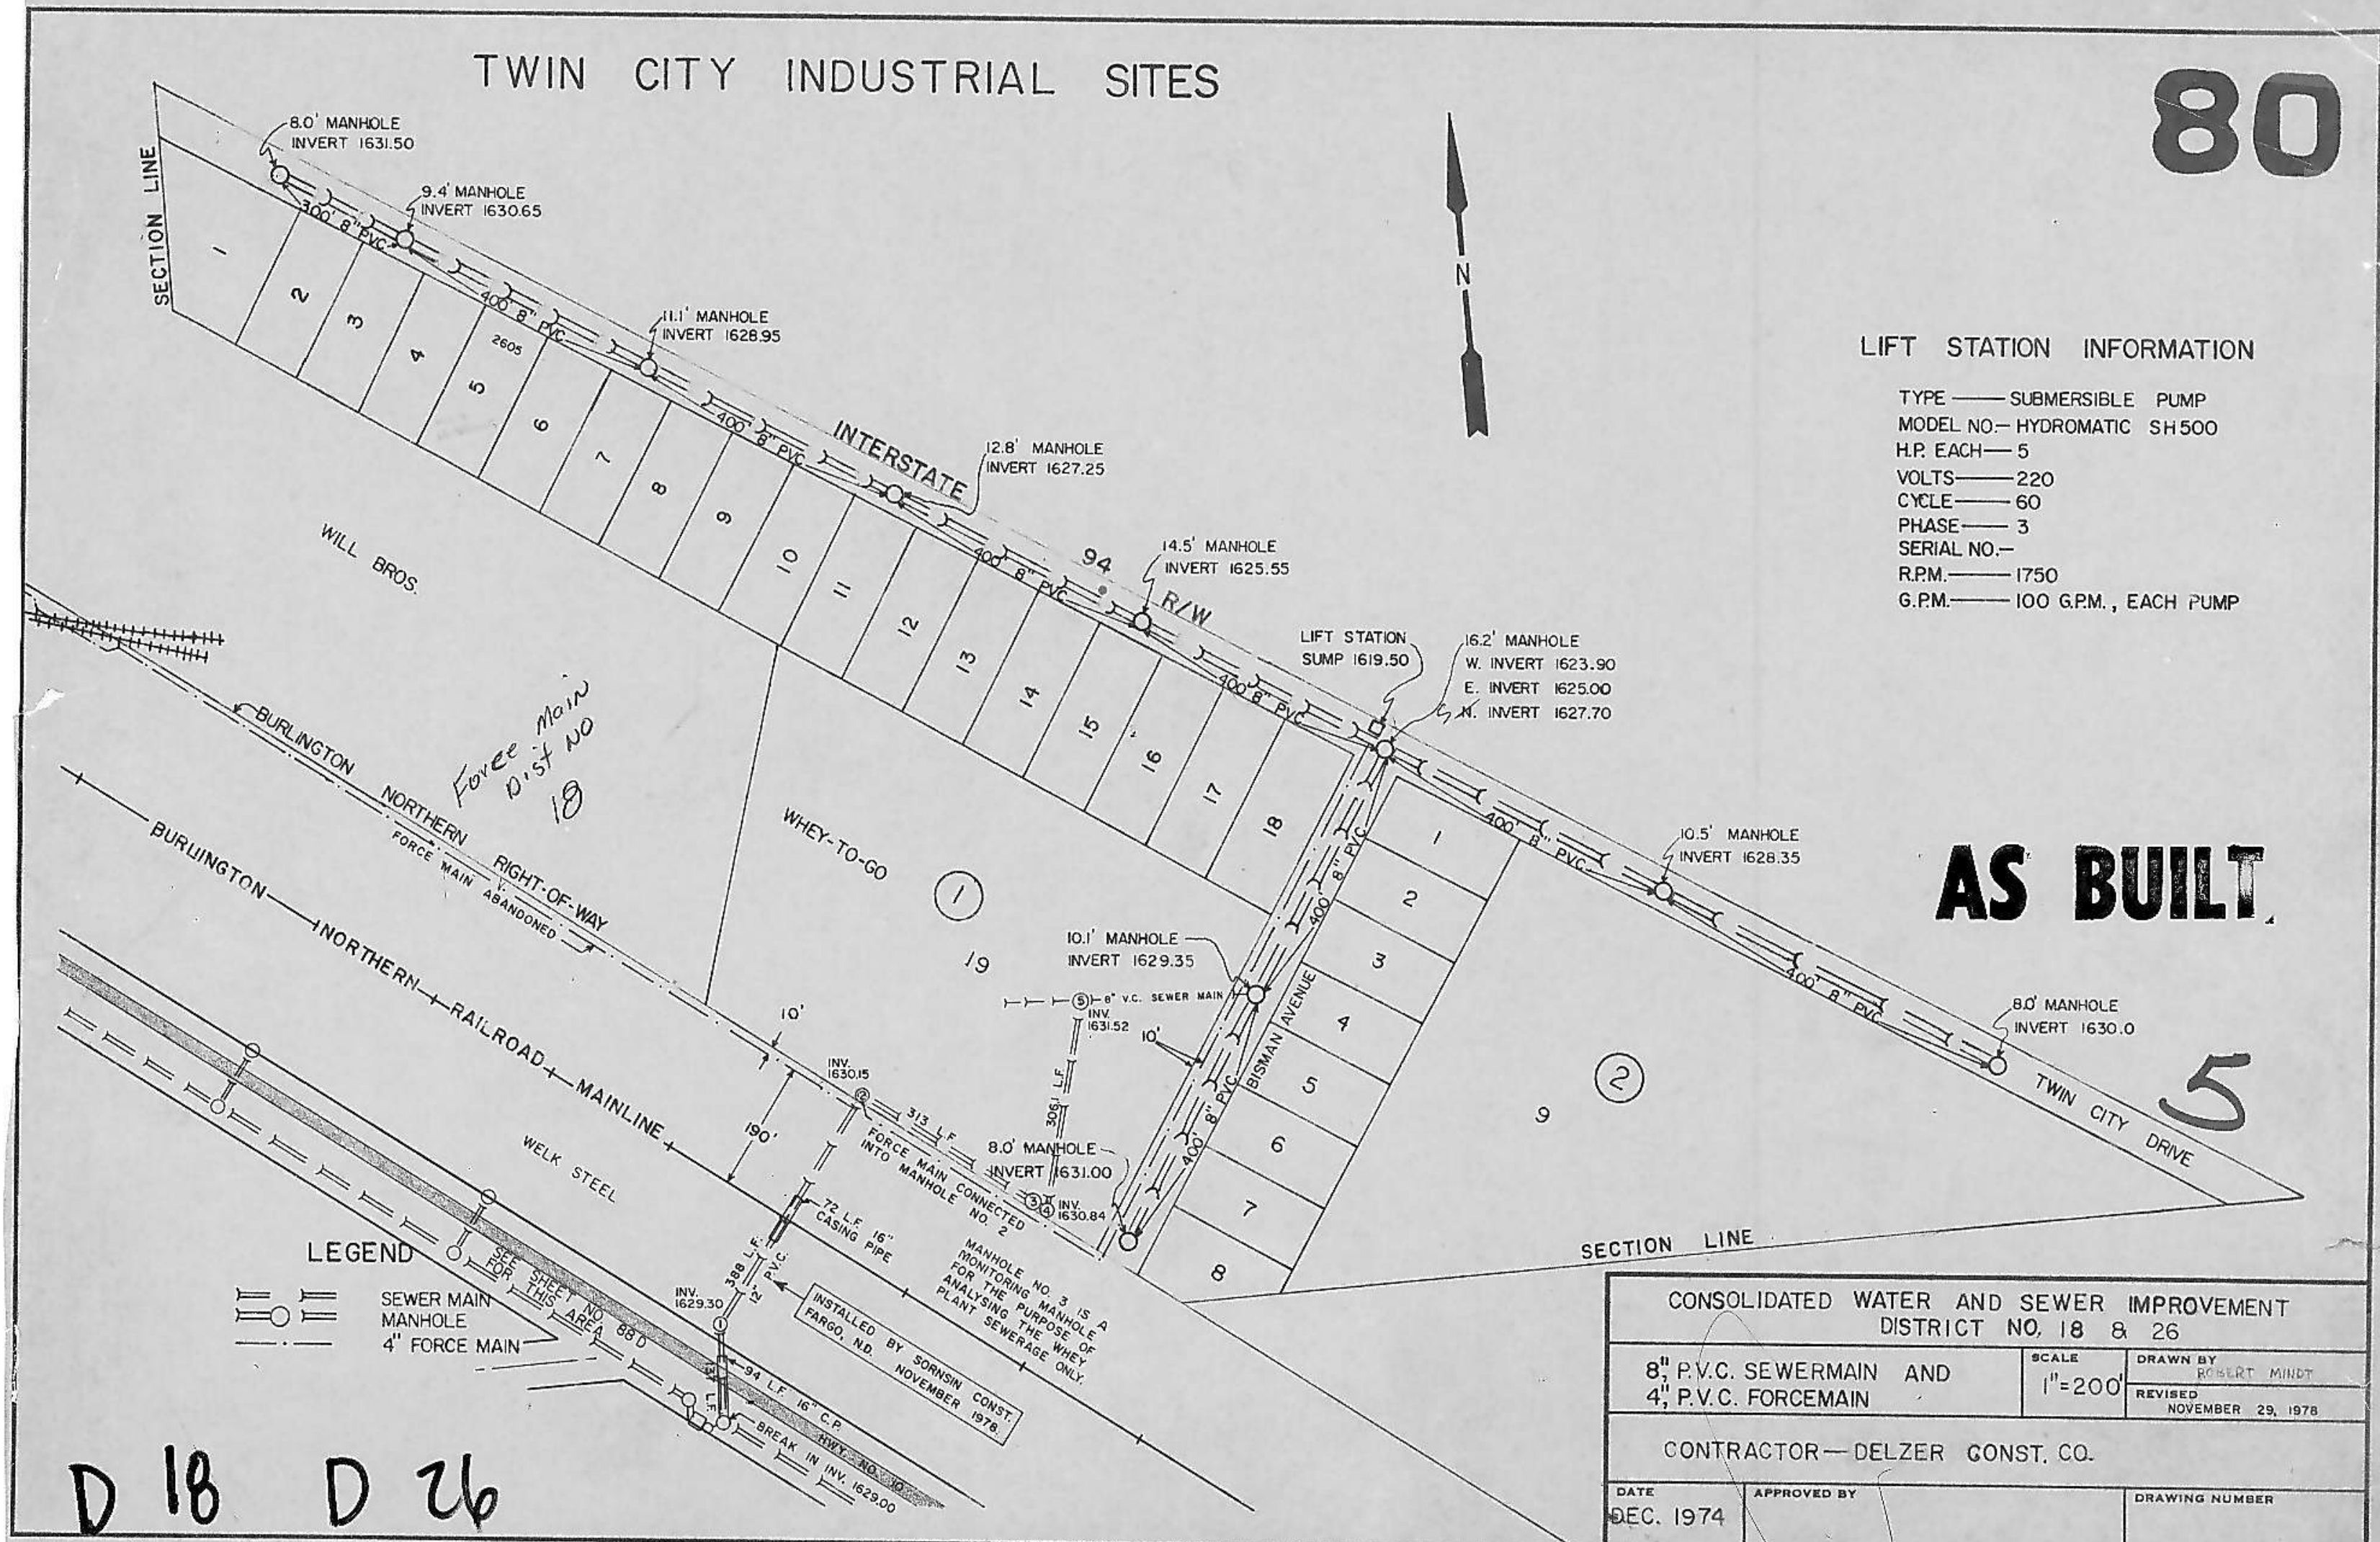

### LIFT STATION INFORMATION

- TYPE — SUBMERSIBLE PUMP
- MODEL NO.— HYDROMATIC SH500
- H.P. EACH— 5
- VOLTS— 220
- CYCLE— 60
- PHASE— 3
- SERIAL NO.—
- R.P.M.— 1750
- G.P.M.— 100 G.P.M., EACH PUMP

## AS BUILT.

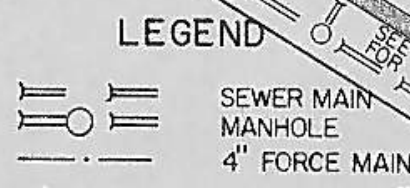

CONSOLIDATED WATER AND SEWER IMPROVEMENT DISTRICT NO. 18 & 26		
8" P.V.C. SEWERMAIN AND 4" P.V.C. FORCEMAIN	SCALE 1"=200'	DRAWN BY ROBERT MINDT REVISED NOVEMBER 29, 1978
CONTRACTOR— DELZER CONST. CO.		
DATE DEC. 1974	APPROVED BY	DRAWING NUMBER

D 18 D 26