
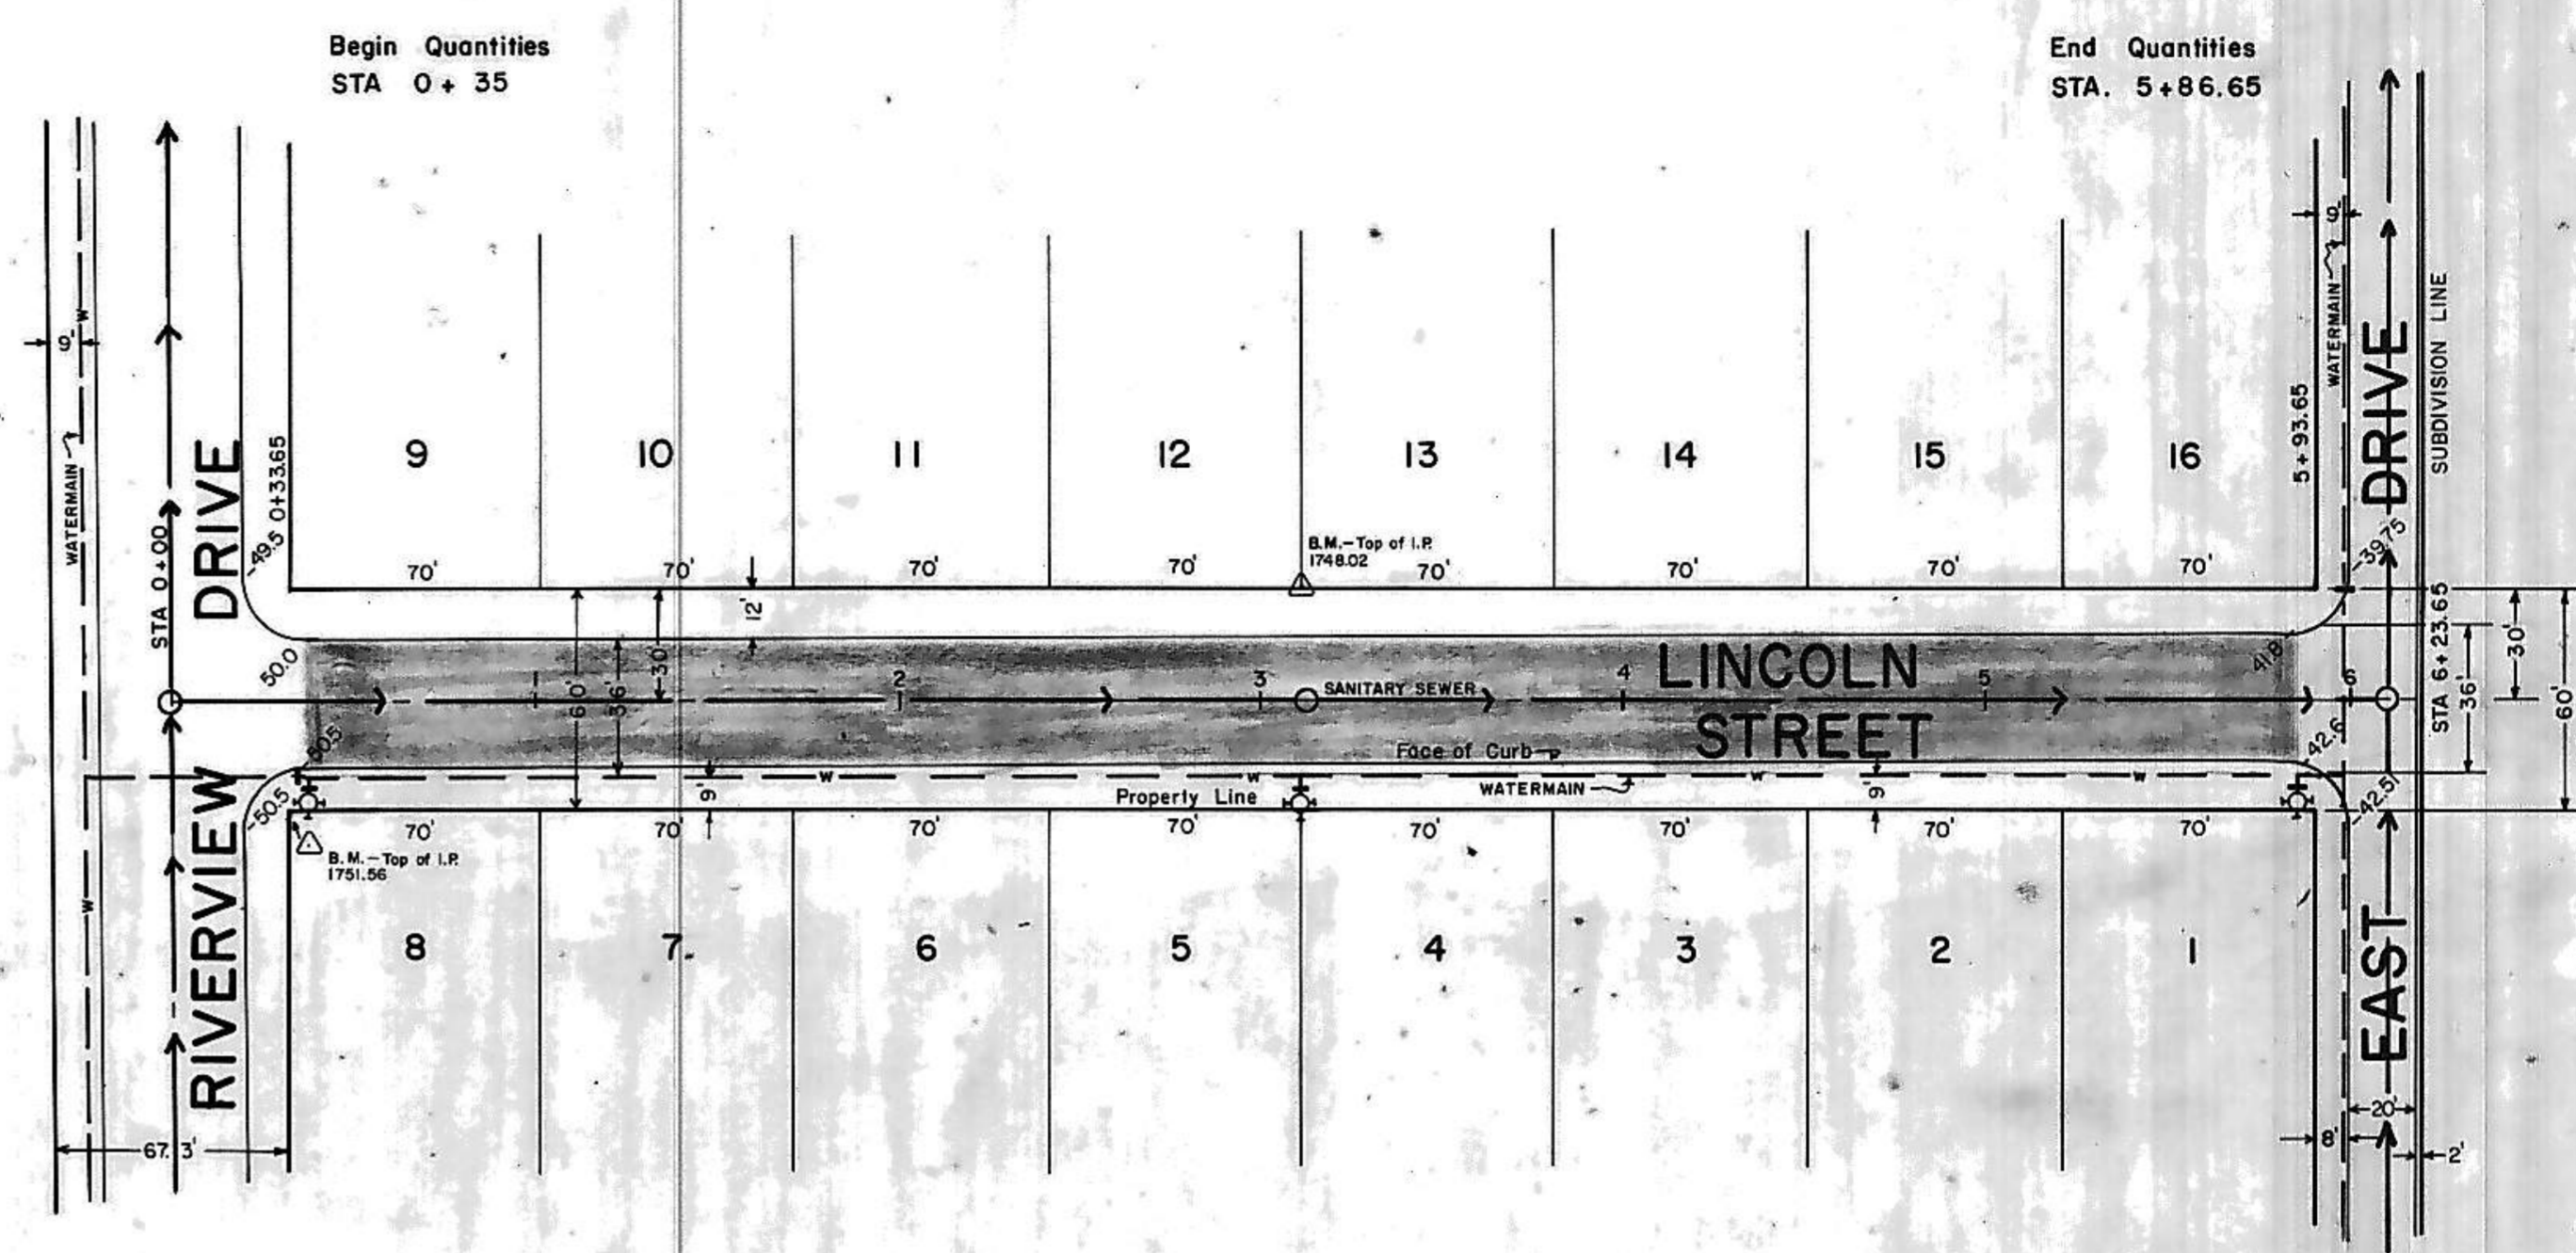


DATE: _____ BY: _____
 SURVEYED: _____
 PLANNED: _____
 NOTE BOOK: _____
 NO. _____


DATE: _____ BY: _____
 SURVEYED: _____
 PLANNED: _____
 NOTE BOOK: _____
 NO. _____

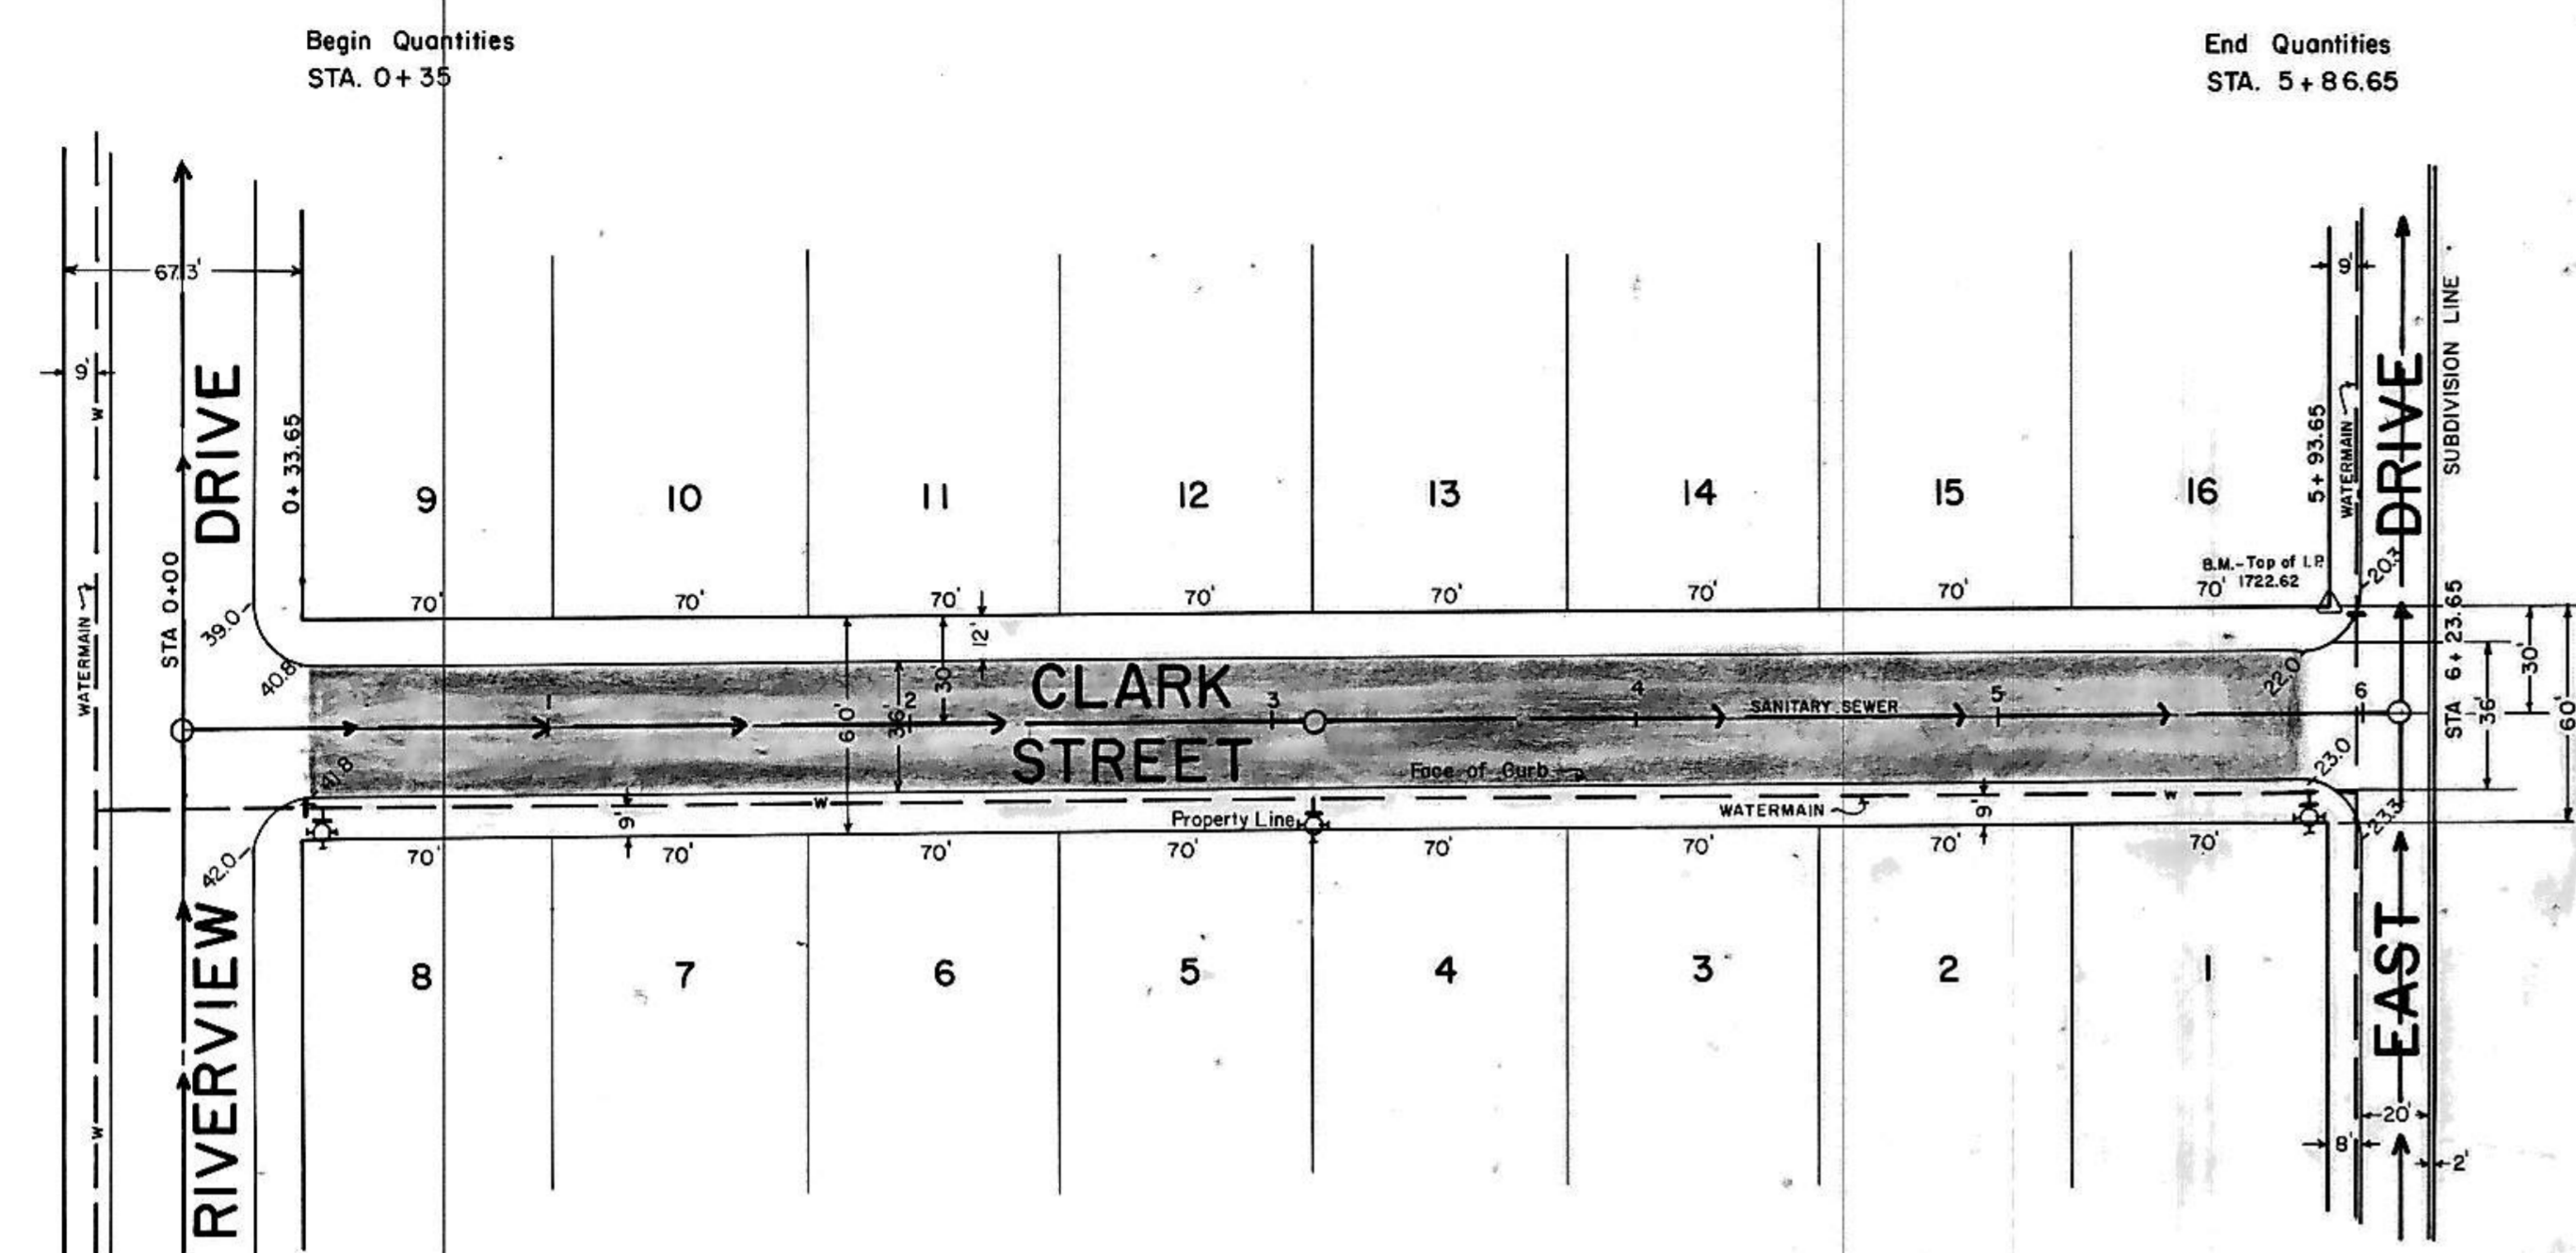

SCALE: 1" = 50'
 DATE: NOVEMBER 1976
 REVISED: FEBRUARY 1977

- NOTES**
- All curb & gutter radii are 15' at face of curb unless otherwise noted.
 - Water & sewer as per plans by TOMAN ENGINEERING.
 - Sanitary sewer is existing.
 - Watermain is proposed, not existing as of date of plans.
 - Proposed grades are to top of curb.

HORIZONTAL SCALE: 1" = 50'
 VERTICAL SCALE: 1" = 5'

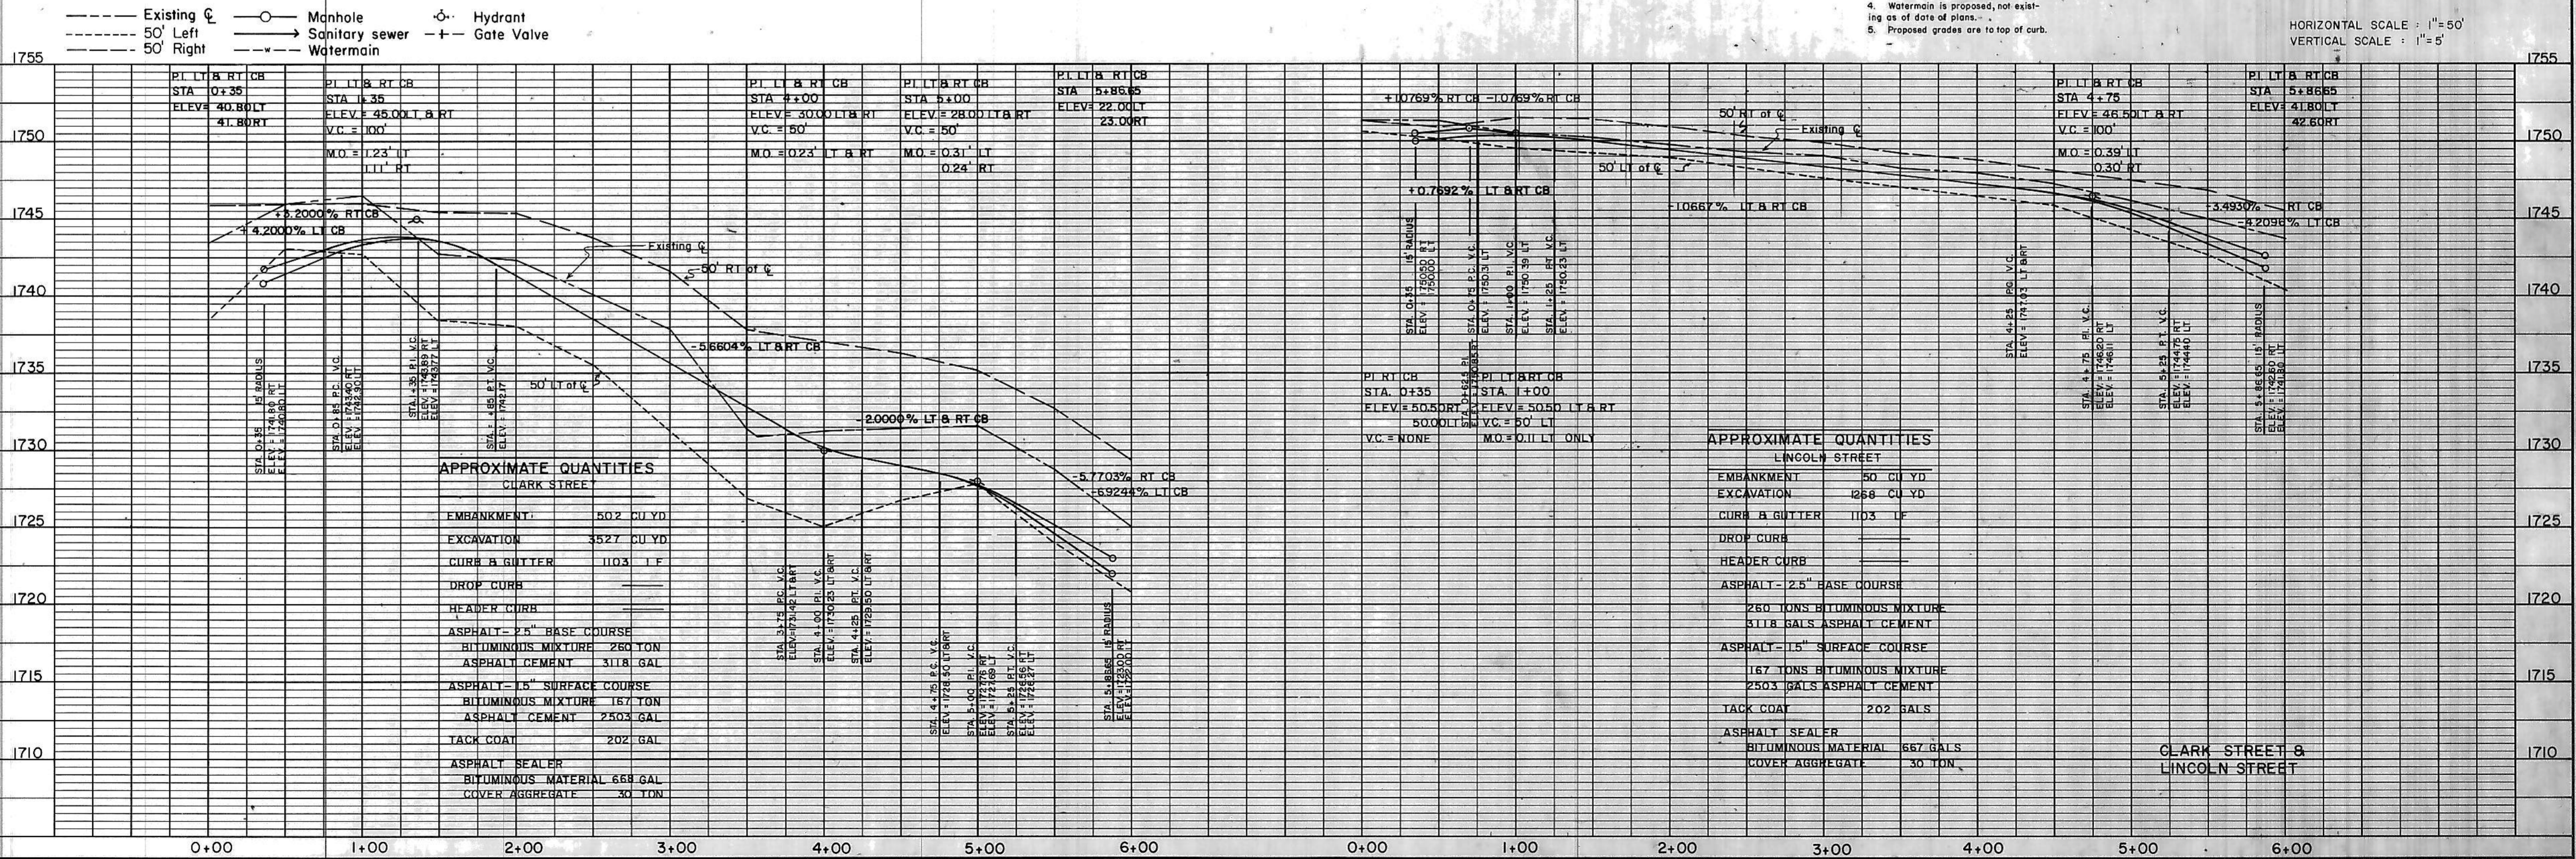

APPROXIMATE QUANTITIES
CLARK STREET

EMBANKMENT	502 CU YD
EXCAVATION	3527 CU YD
CURB & GUTTER	1103 LF
DROP CURB	
HEADER CURB	
ASPHALT - 2.5" BASE COURSE	
BITUMINOUS MIXTURE	260 TON
ASPHALT CEMENT	3118 GAL
ASPHALT - 1.5" SURFACE COURSE	
BITUMINOUS MIXTURE	167 TON
ASPHALT CEMENT	2503 GAL
TACK COAT	202 GAL
ASPHALT SEALER	
BITUMINOUS MATERIAL	668 GAL
COVER AGGREGATE	30 TON

APPROXIMATE QUANTITIES
LINCOLN STREET

EMBANKMENT	50 CU YD
EXCAVATION	1268 CU YD
CURB & GUTTER	1103 LF
DROP CURB	
HEADER CURB	
ASPHALT - 2.5" BASE COURSE	
260 TONS BITUMINOUS MIXTURE	
3118 GALS ASPHALT CEMENT	
ASPHALT - 1.5" SURFACE COURSE	
167 TONS BITUMINOUS MIXTURE	
2503 GALS ASPHALT CEMENT	
TACK COAT	202 GALS
ASPHALT SEALER	
BITUMINOUS MATERIAL	667 GALS
COVER AGGREGATE	30 TON

CLARK STREET & LINCOLN STREET