
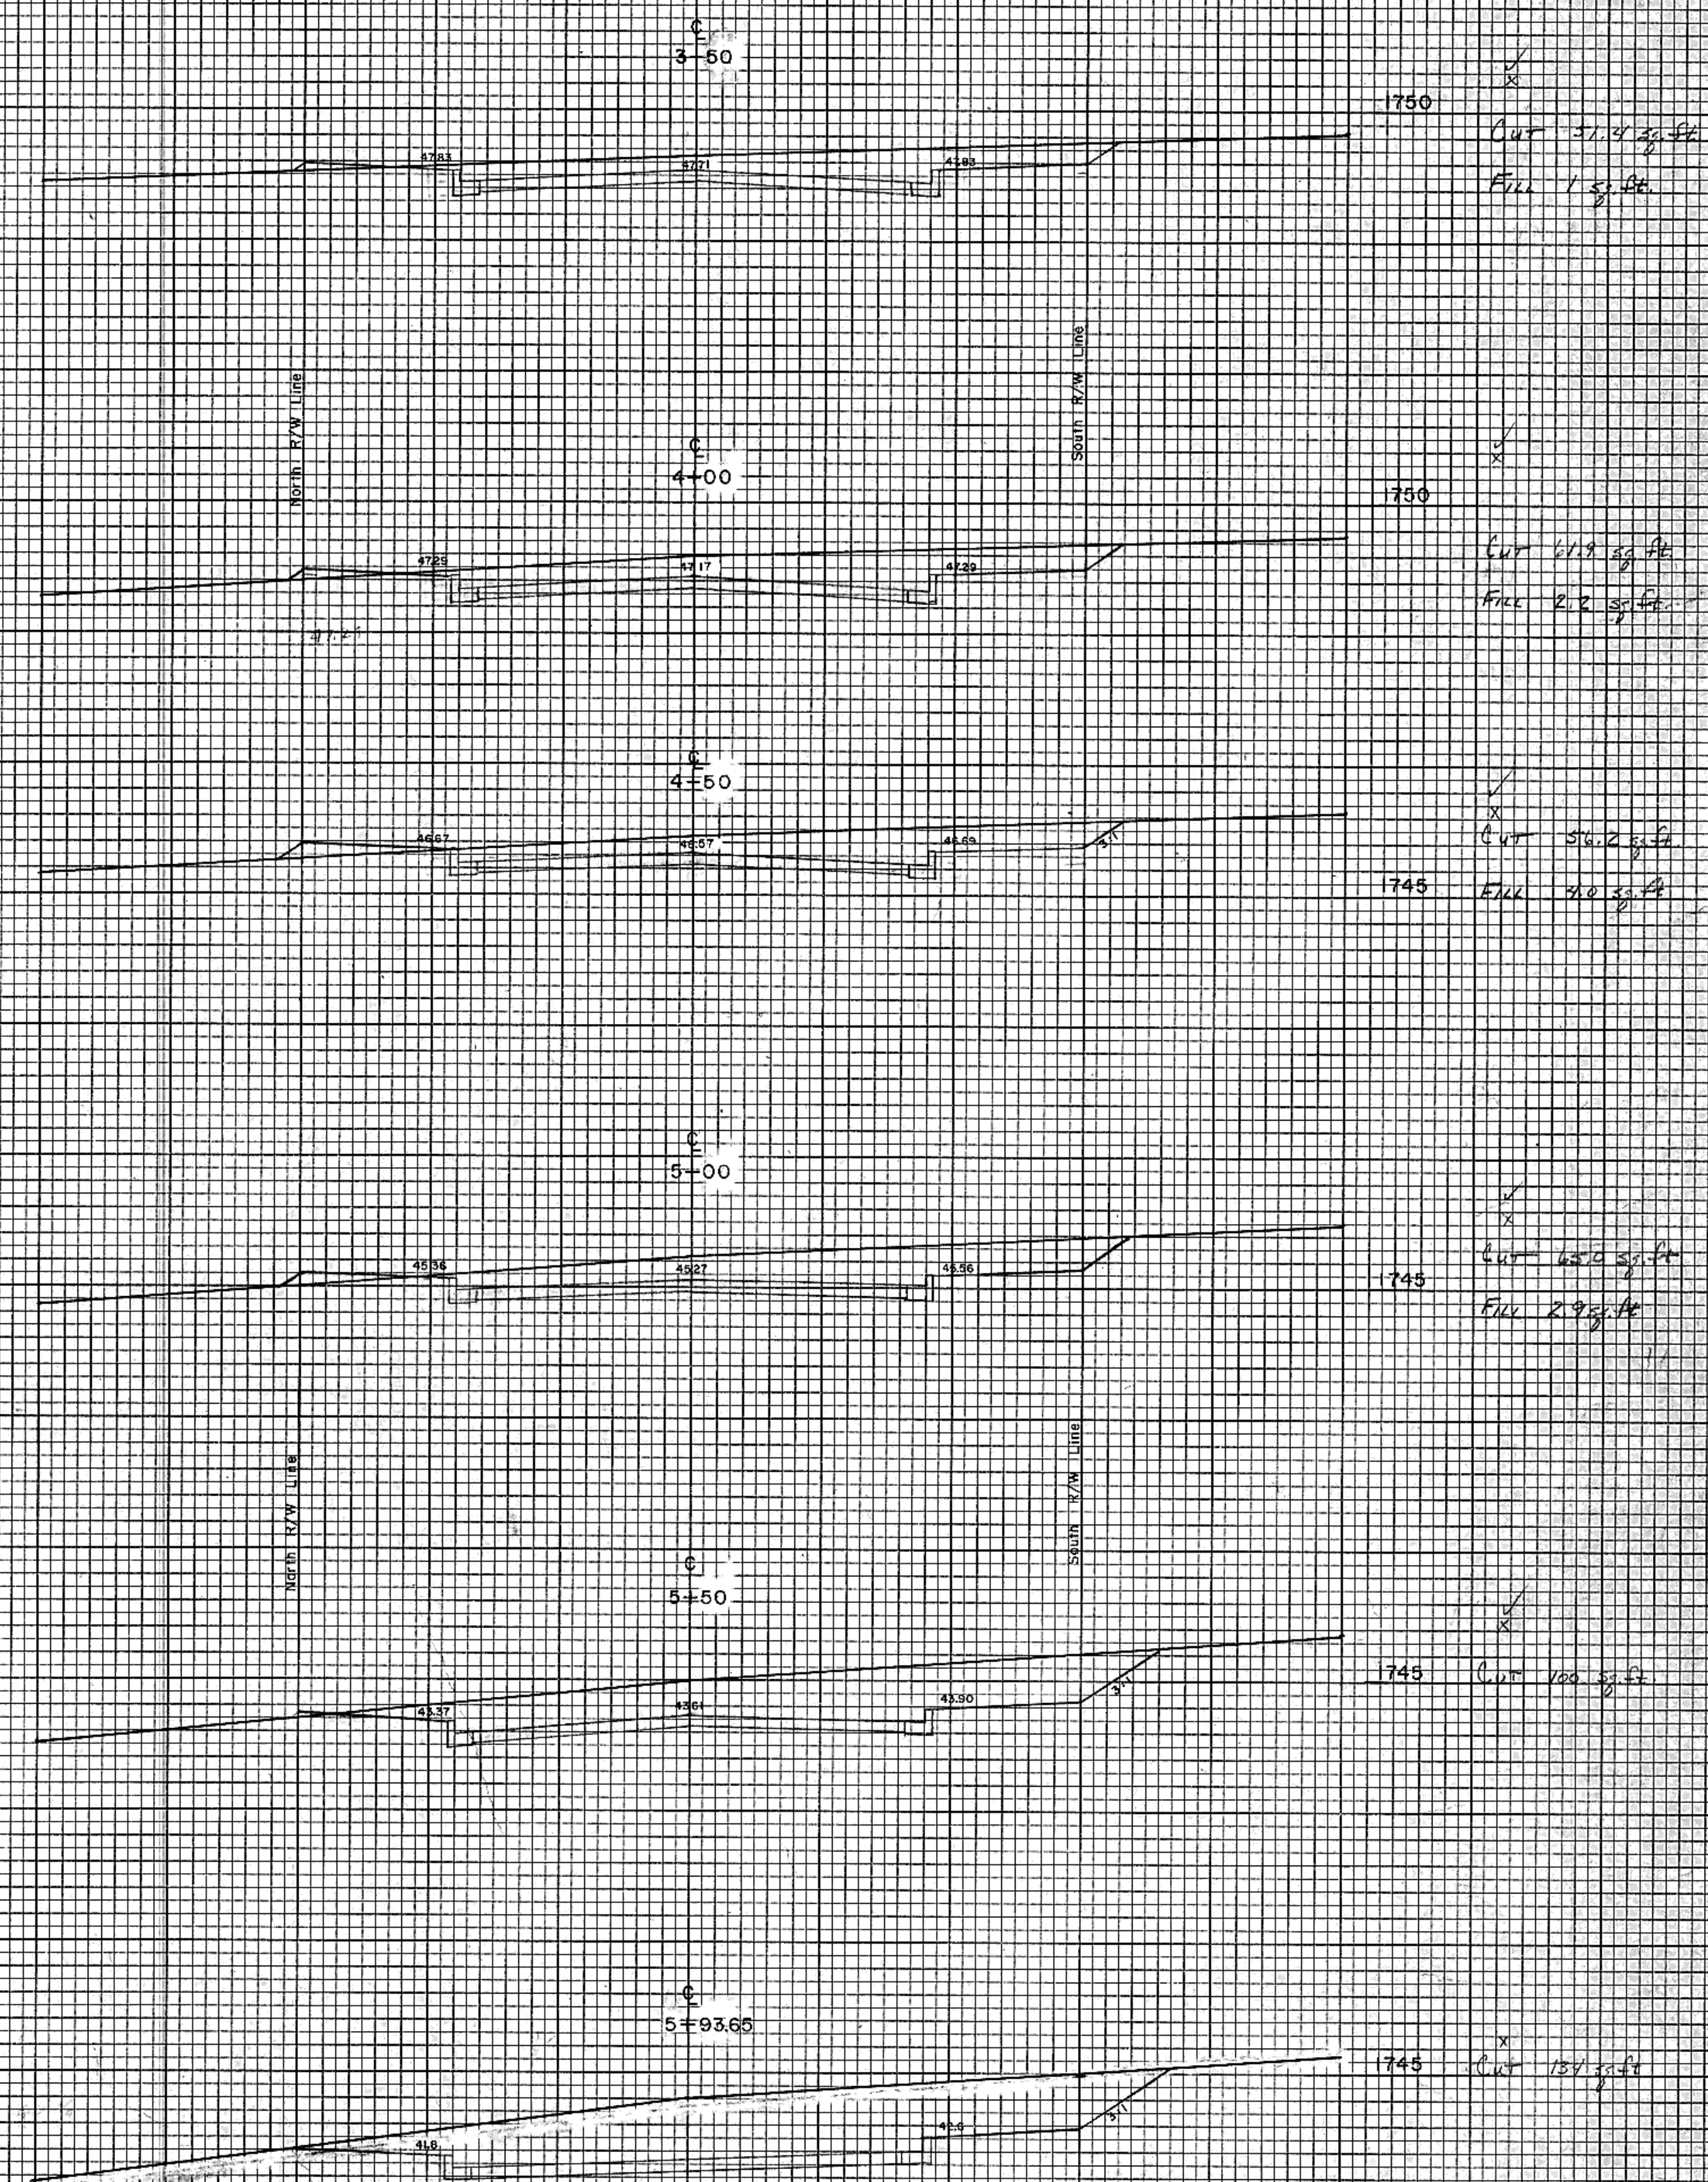


LINCOLN STREET
RIPPEL'S 2ND SUBDIVISION

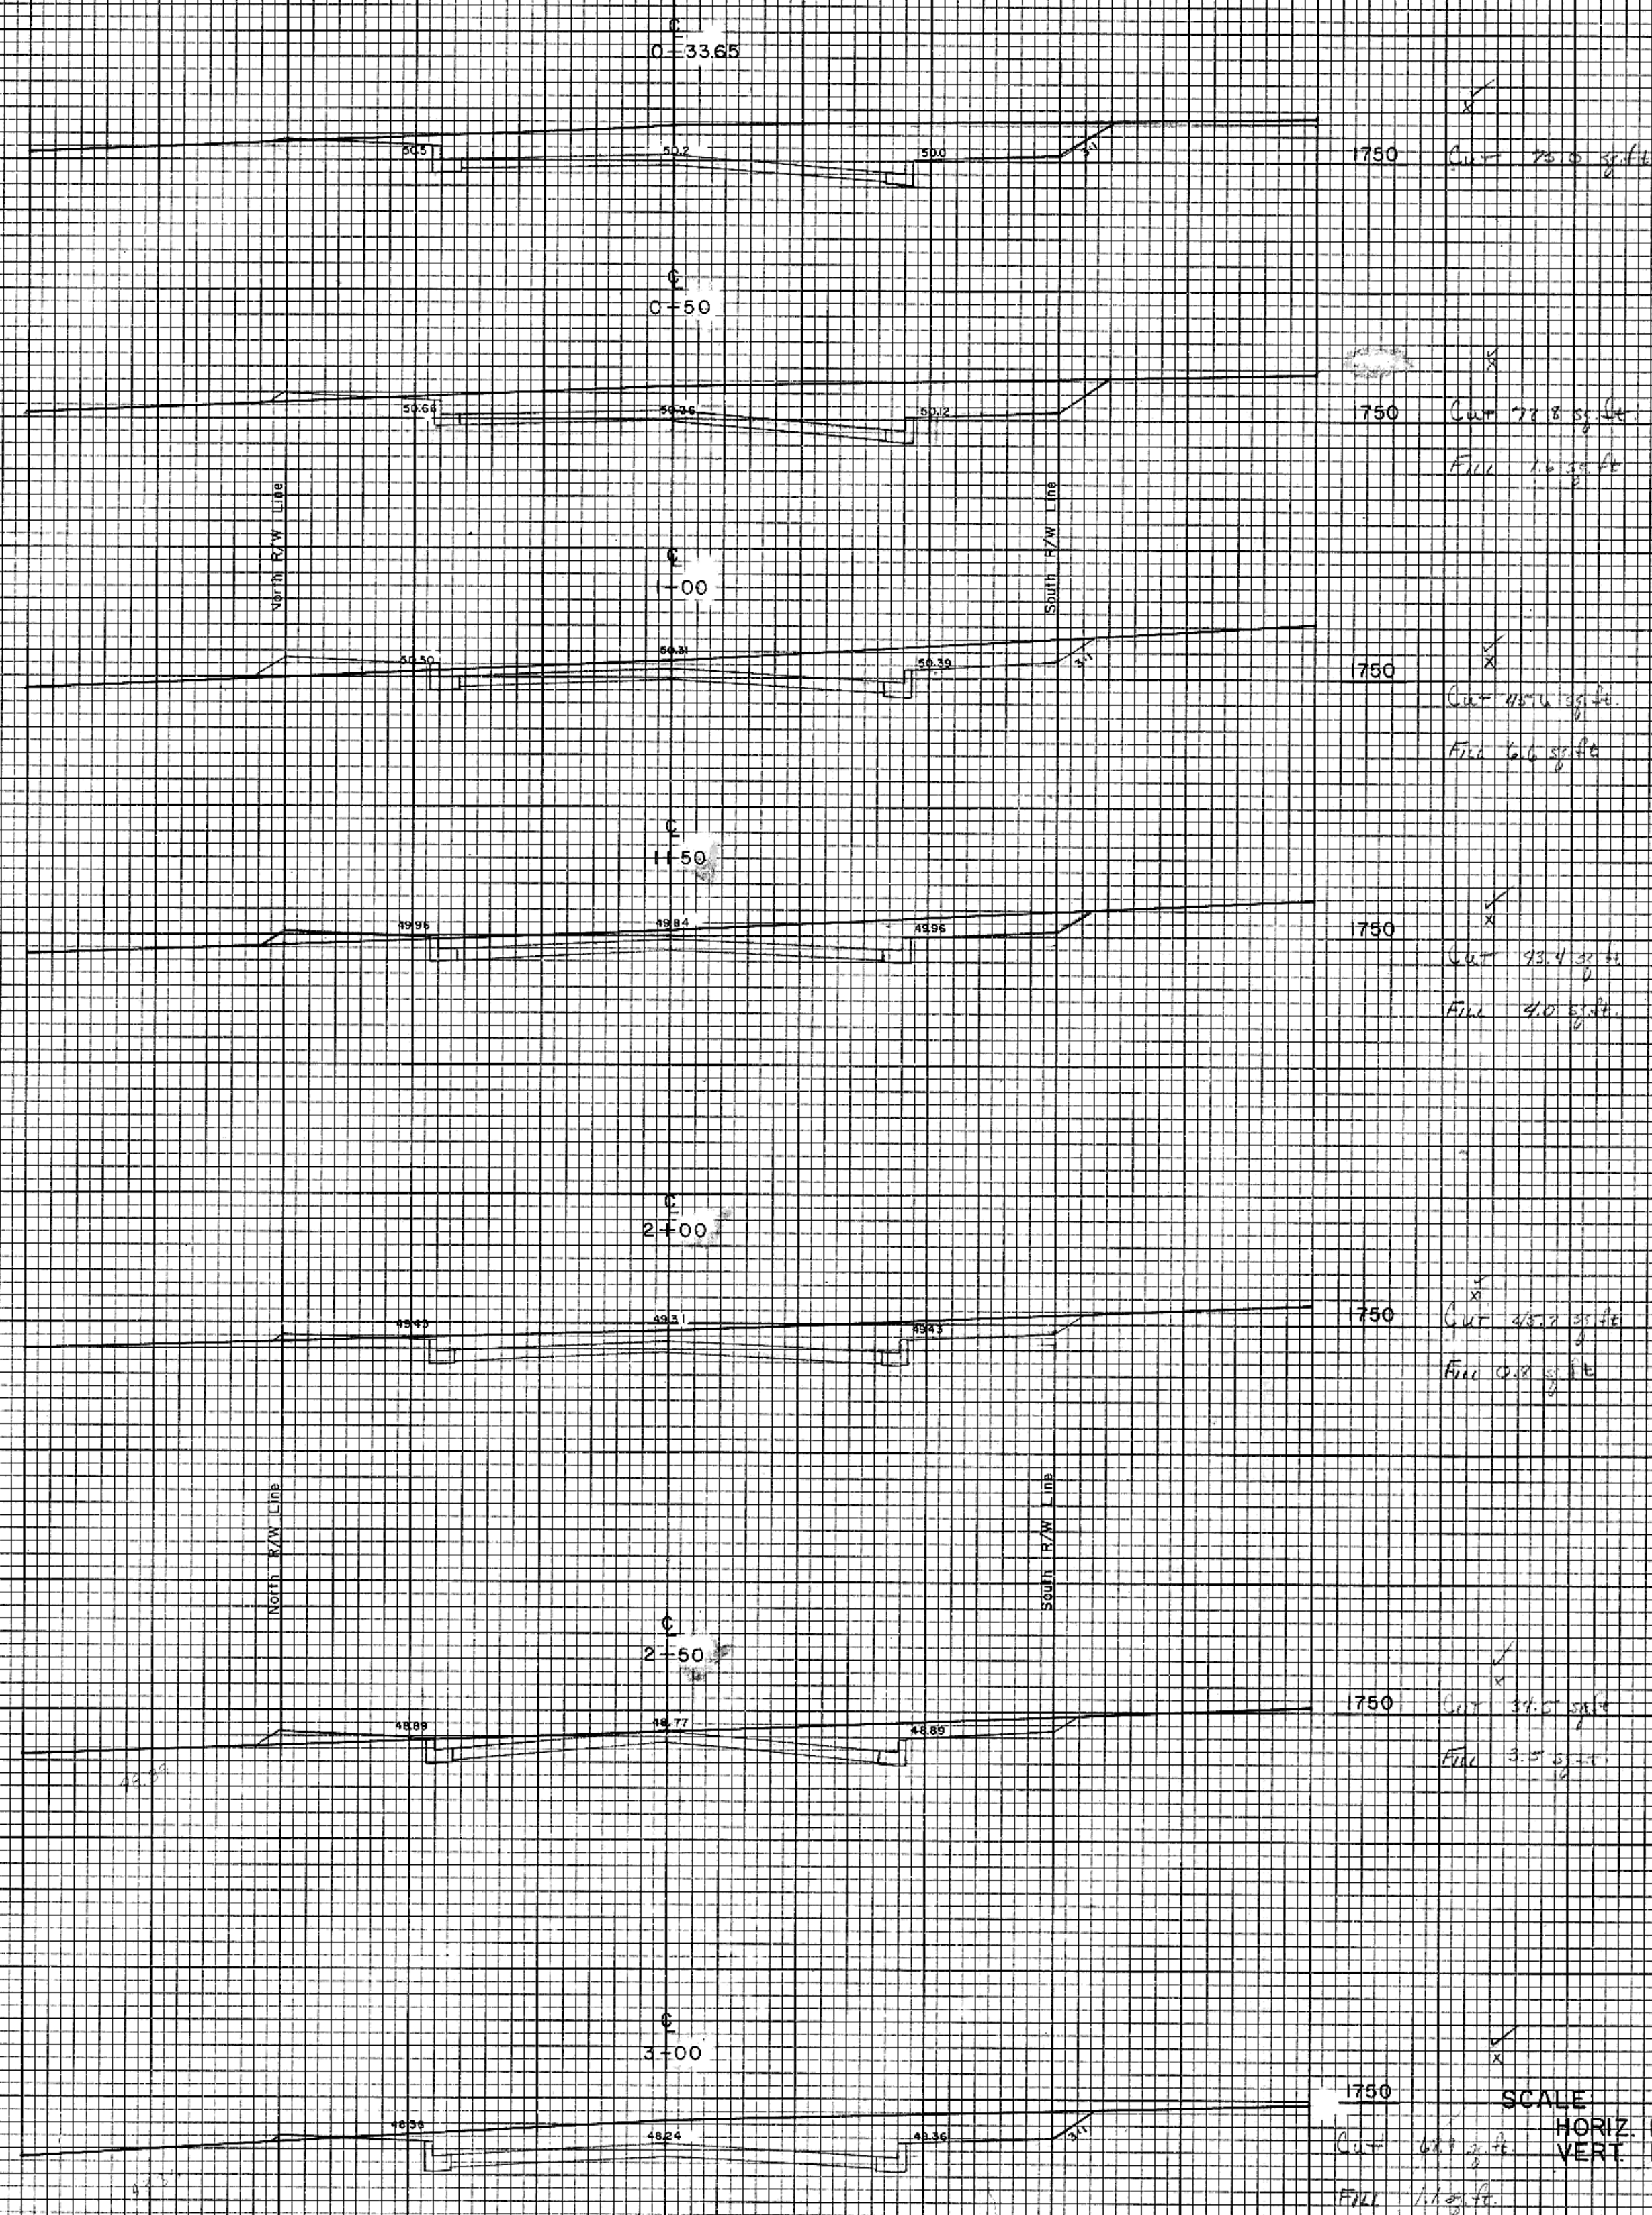

SCALE
HORIZ. 1" = 10'
VERT. 1" = 5'
1" = 50 ft

NO. AREAS CHECKED

NO. AREAS CHECKED