


FINAL SURVEY
NOTE BOOK NO. _____
SURVEYED, PLOTTED, AREAS CHECKED
TEMPLATE AREAS CHECKED
BY _____ DATE _____

ORIGINAL SURVEY
NOTE BOOK NO. _____
SURVEYED, PLOTTED, AREAS CHECKED
TEMPLATE AREAS CHECKED
BY _____ DATE _____

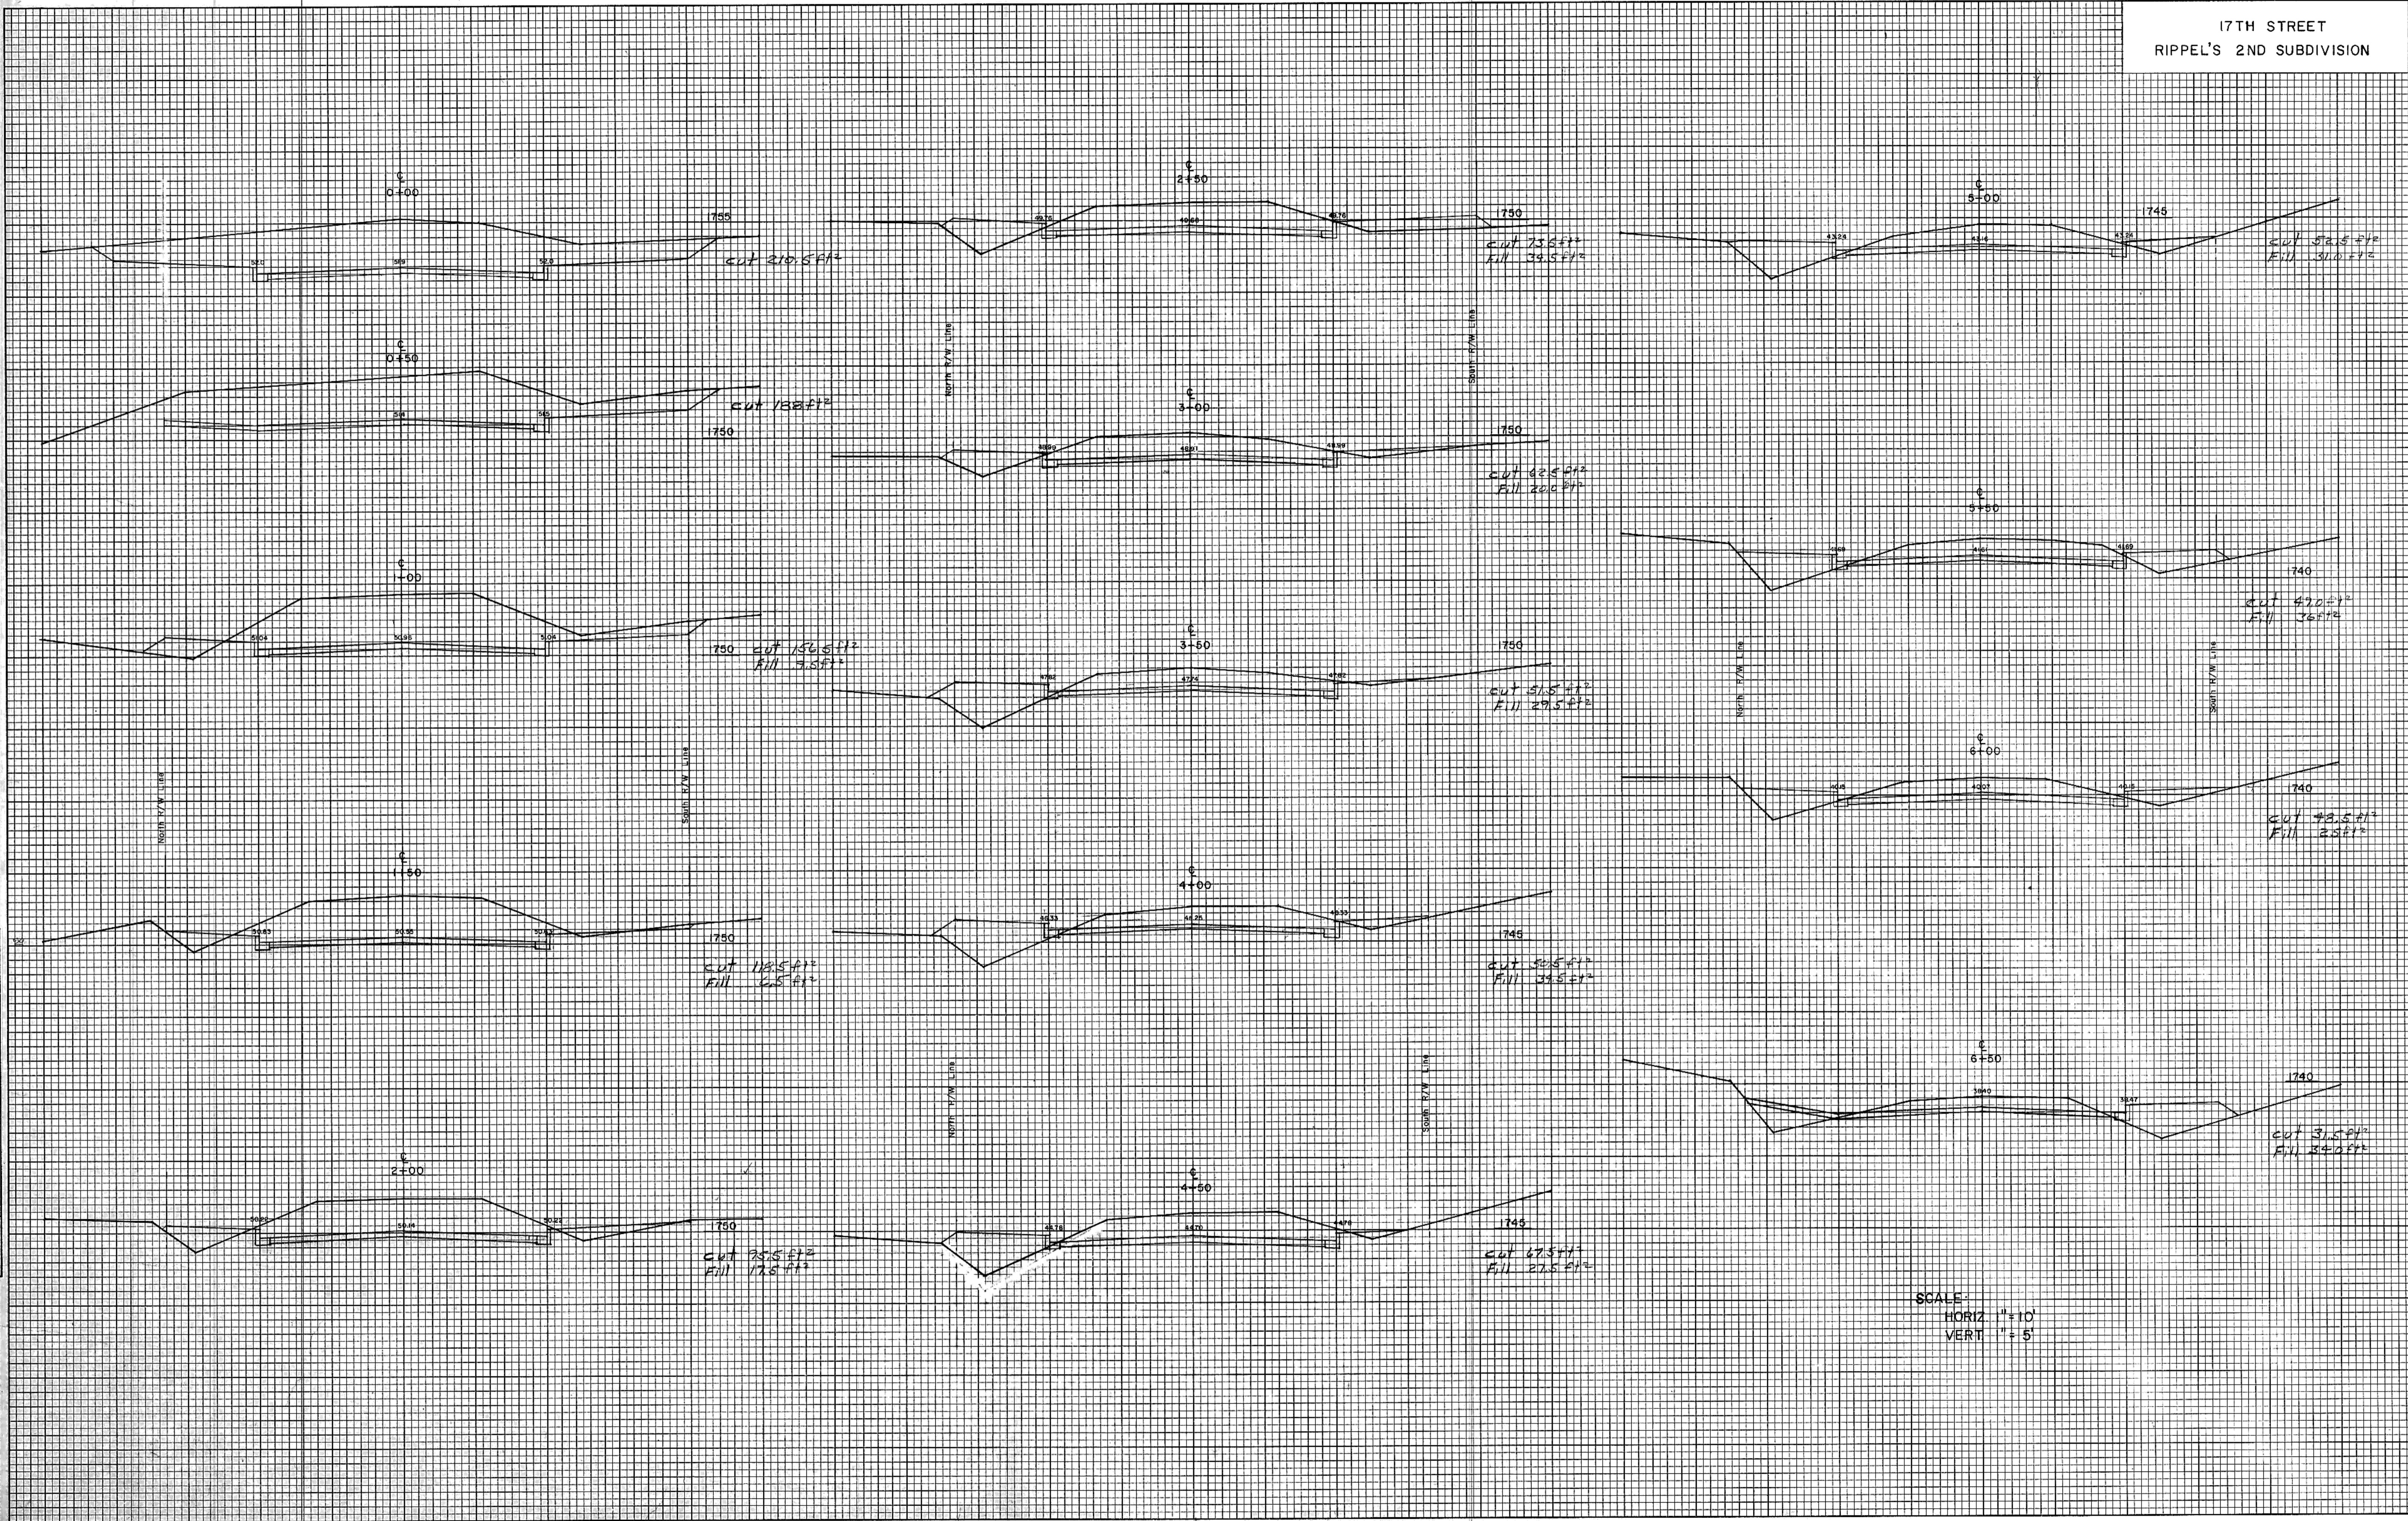

SCALE
HORIZ. " = 10'
VERT. " = 5'