

LEWIS STREET
RIPPEL'S 2ND SUBDIVISION

FINAL SURVEYED
SURVEY PLOTTED
NOTE BOOK
NO. _____

BY _____ DATE _____

SURVEYED PLOTTED
NOTE BOOK
NO. _____

BY _____ DATE _____

AREAS CHECKED


ORIGINAL SURVEY
PLOTTED
NOTE BOOK
NO. _____

BY _____ DATE _____

SURVEYED PLOTTED
NOTE BOOK
NO. _____

BY _____ DATE _____

AREAS CHECKED

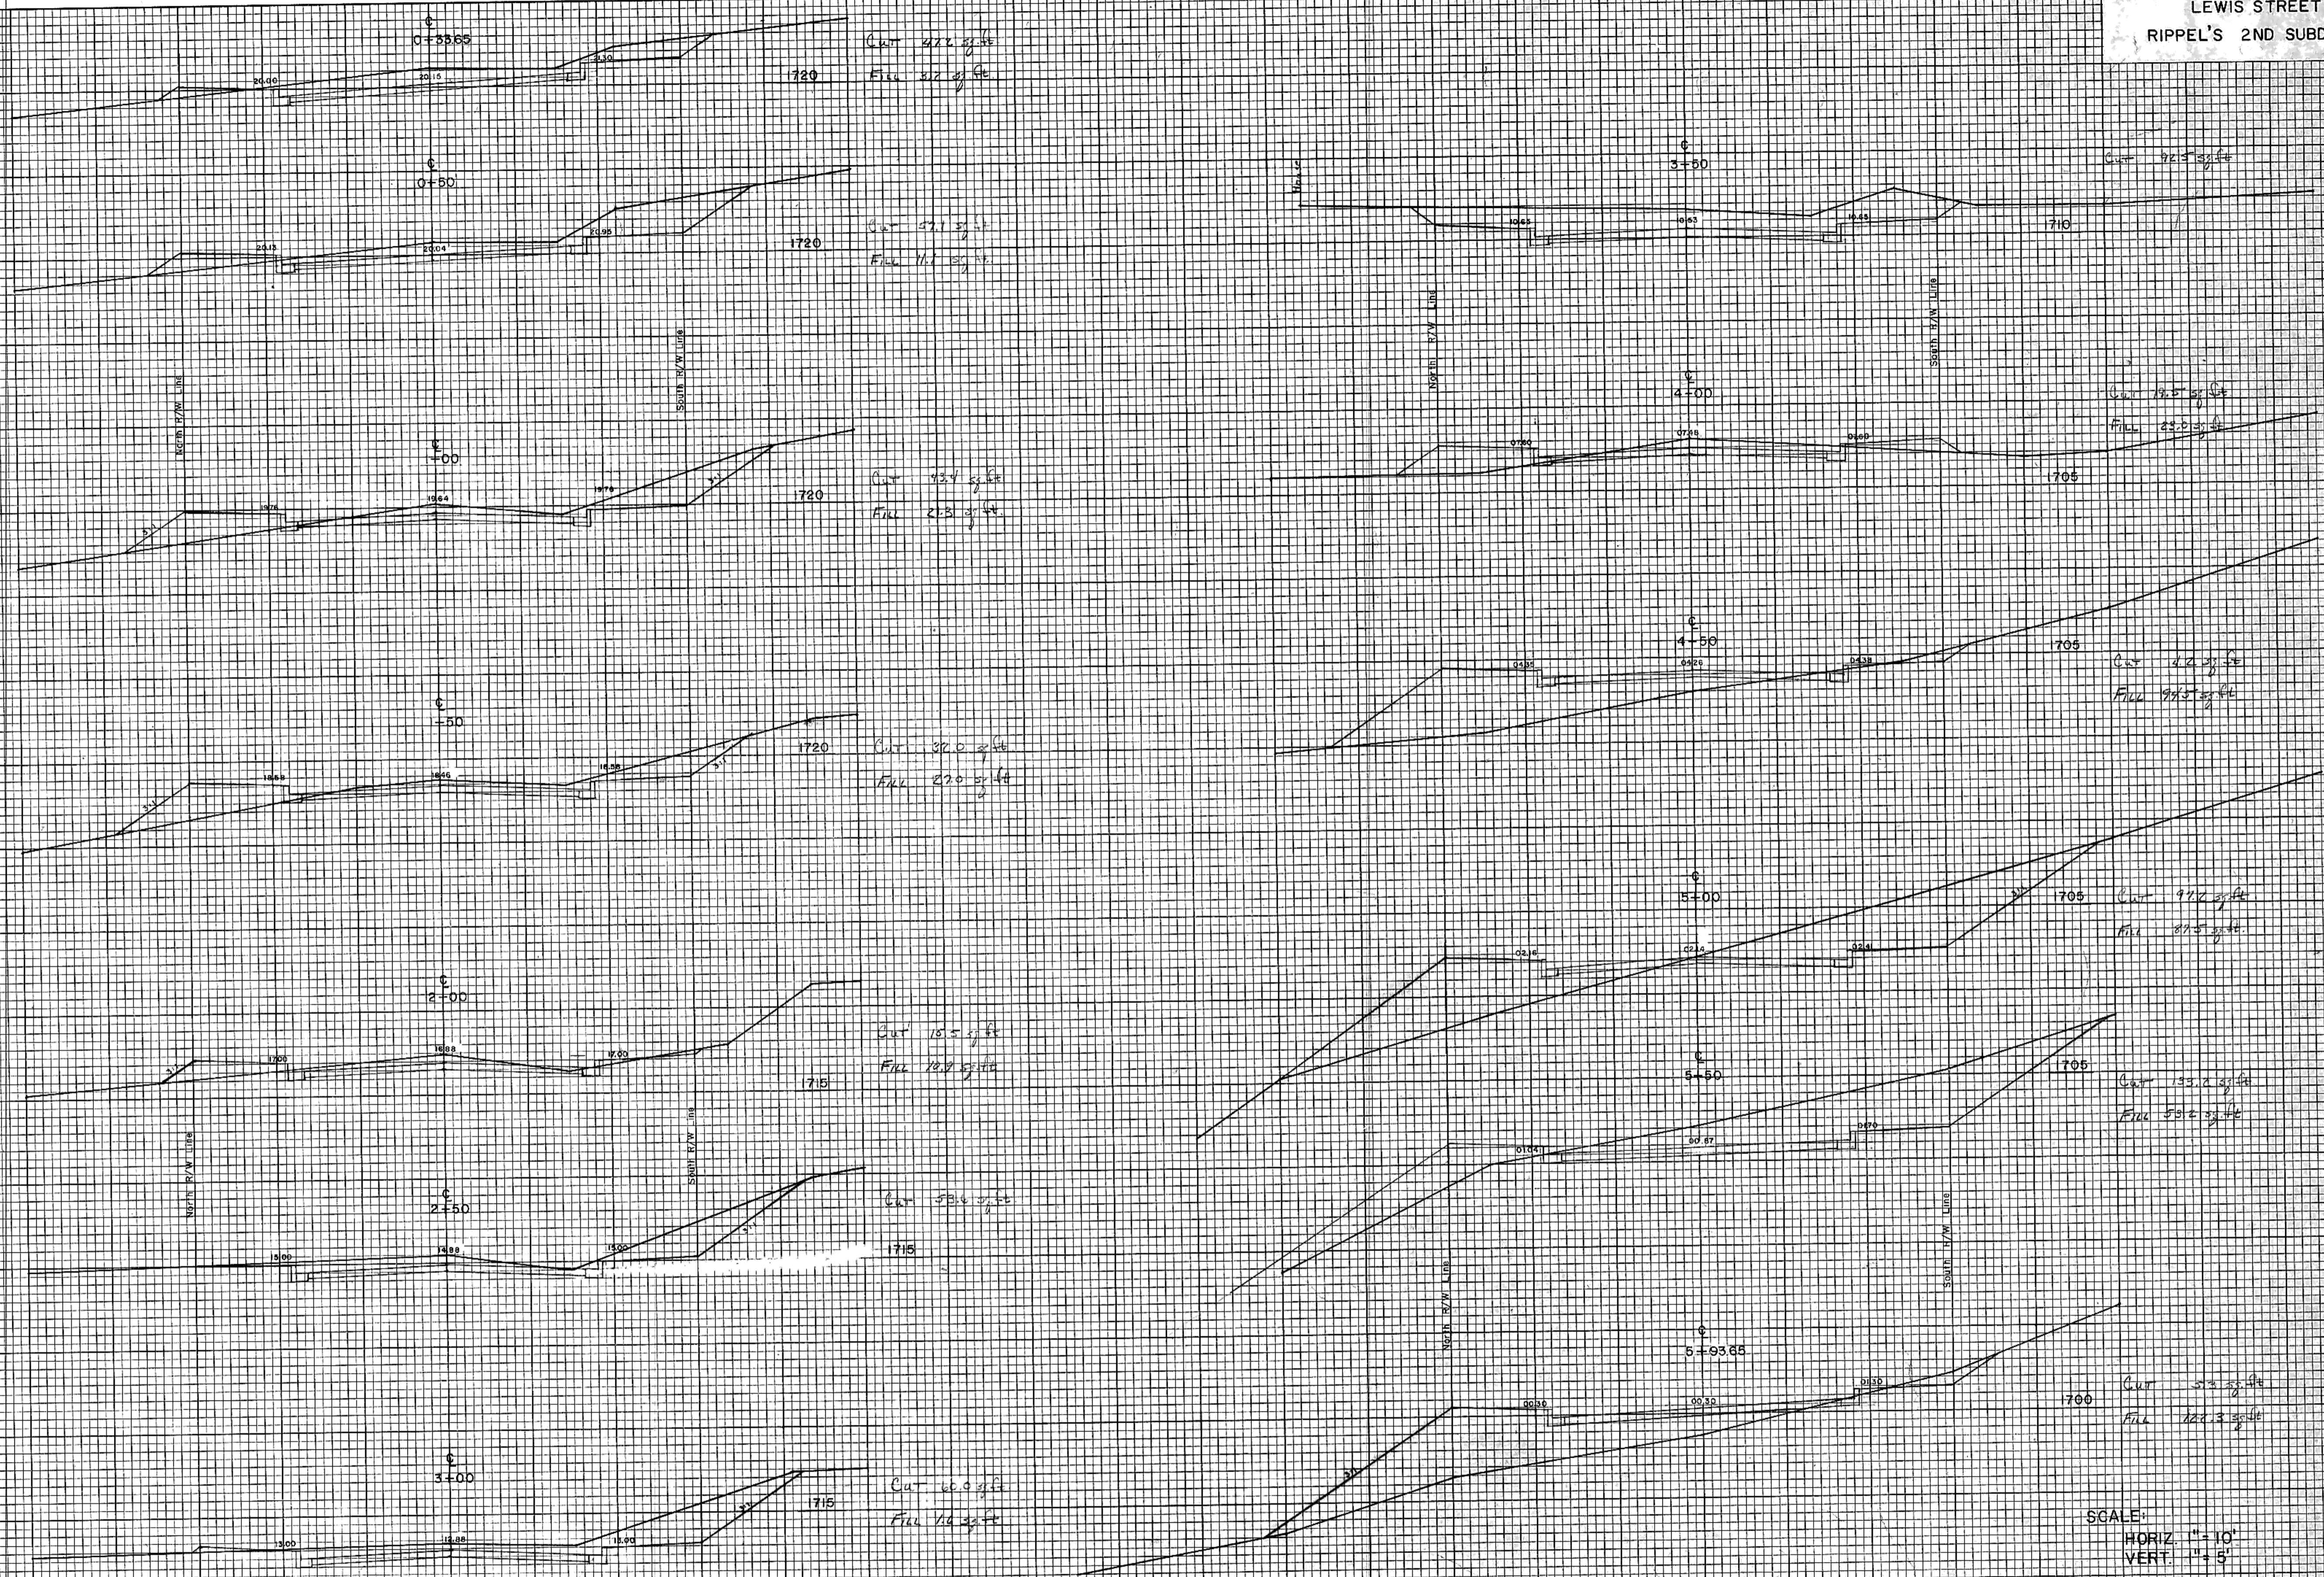

SCALE:
HORIZ. 1" = 10'
VERT. 1" = 5'