


# STREET IMPROVEMENT DISTRICT NO. 52 MANDAN, NORTH DAKOTA

## INDEX

Sheet No. 1	Project and Waste Area Layout
Sheet No. 2	First Ave. NW Between Fourteenth St. NW to North Terminus Ninth Ave. NW Between Fourteenth St. NW to South Terminus Third Ave. NE Between Fourth St. NE and Fifth St. NE
Sheet No. 3	Second Ave. NW Between Thirteenth St. NW and Fourteenth St. NW Thirteenth St. NW Between Second Ave. NW and Collins Ave. Fourteenth St. NW Between Second Ave. NW and Collins Ave.
Sheet No. 4	Collins Ave. Between Twelfth St. NW and 1-24
Sheet No. 5	Fourth Ave. NE Between Sixth St. NE and Division St.
Sheet No. 6	Fifth Ave. NE Between Sixth St. NE and Division St.
Sheet No. 7	Sixth Ave. NE Between Sixth St. NE and Division St.
Sheet No. 8	Sixth St. NE Between John's Drive and Sixth Ave. NE
Sheet No. 9	Division St. Between John's Drive and Sixth Ave. NE
Sheet No. 10	Alley Blocks 9 and 12, Second Northern Pacific Add. Bismar Ave. Between Twin City Drive and Burlington Northern R/W
Sheet No. 11	Alley Blocks 10 and 11, Second Northern Pacific Add. First Ave. NW Between Thirteenth St. NW and Fourteenth St. NW Brave Ave. Between Seventh St. NW and Indian St.
Sheet No. 12	Central Junior High School, Block 53, Mandan Proper
Sheet No. 13	Mandan Public School District No. 1 Garage Parking Lot Mandan Senior High School Parking Lot
Sheet No. 14	Third St. SE Between Third Ave. SE and Sixth Ave. SE
Sheet No. 15	Twin City Drive East of Mandan
Sheet No. 16	Paving Details



AS BUILT

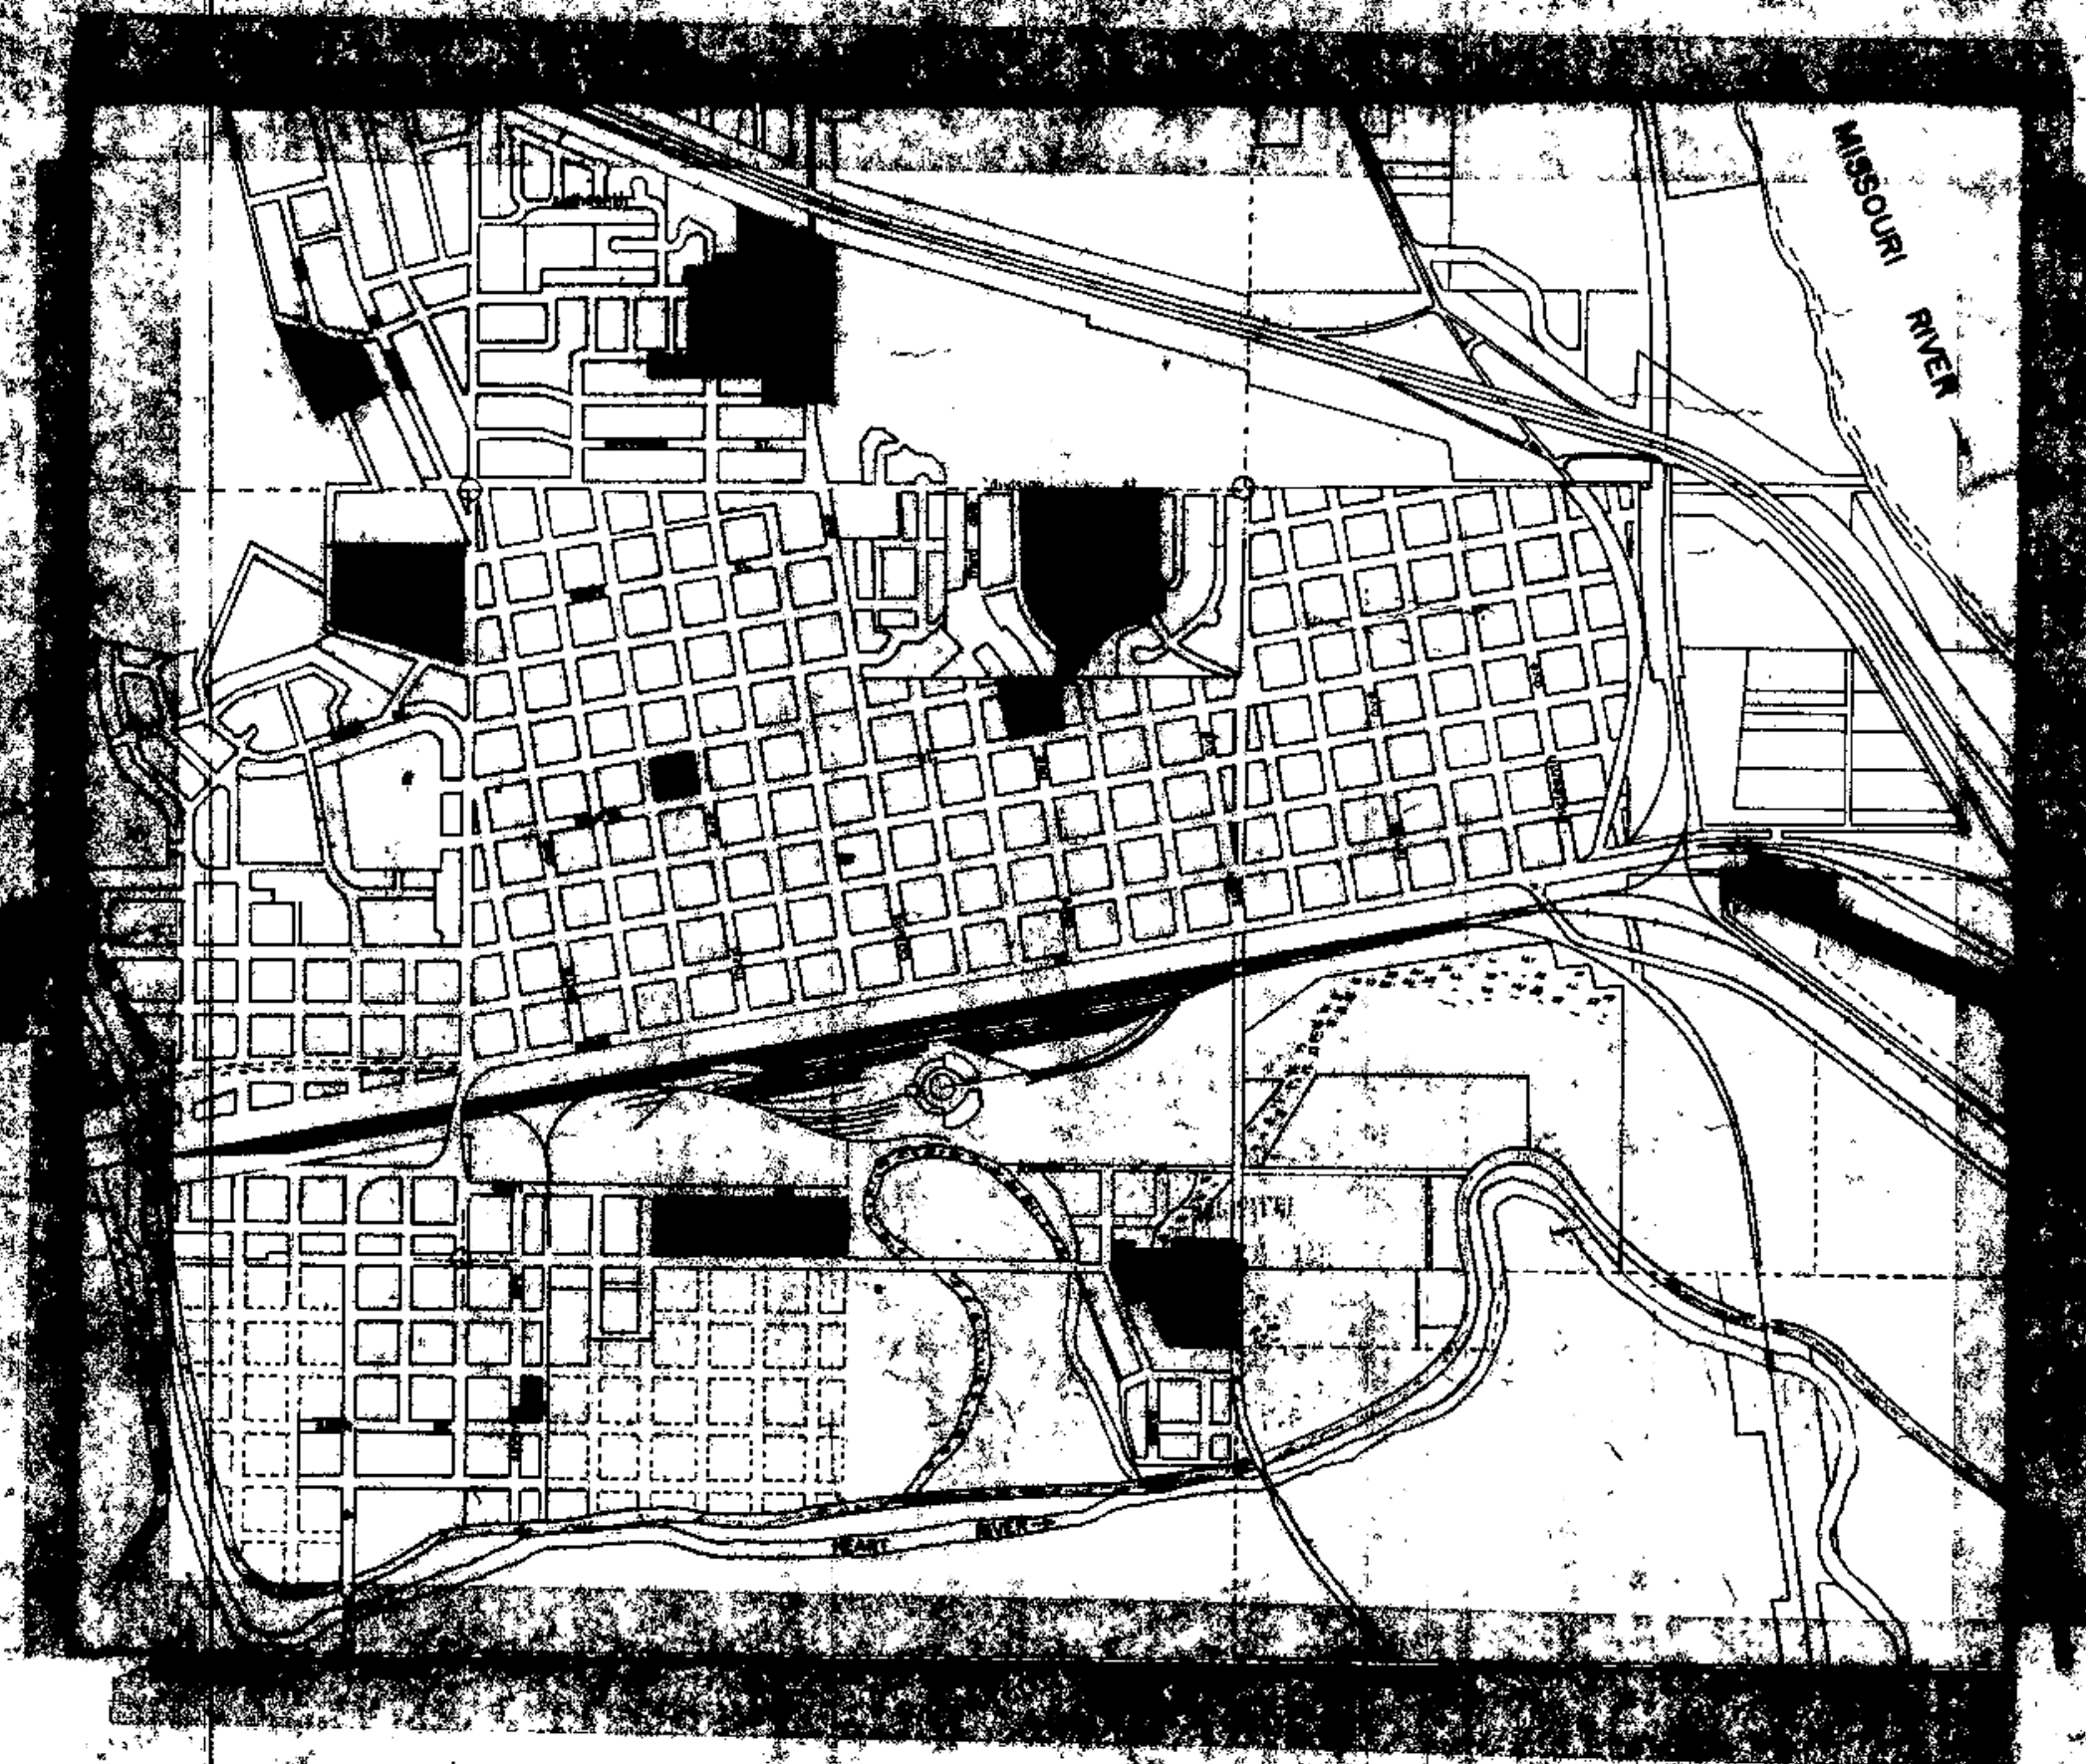

JULY 1975

TOMAN ENGINEERING CO.  
CONSULTING ENGINEERS