


# CITY OF MANDAN, N. D.

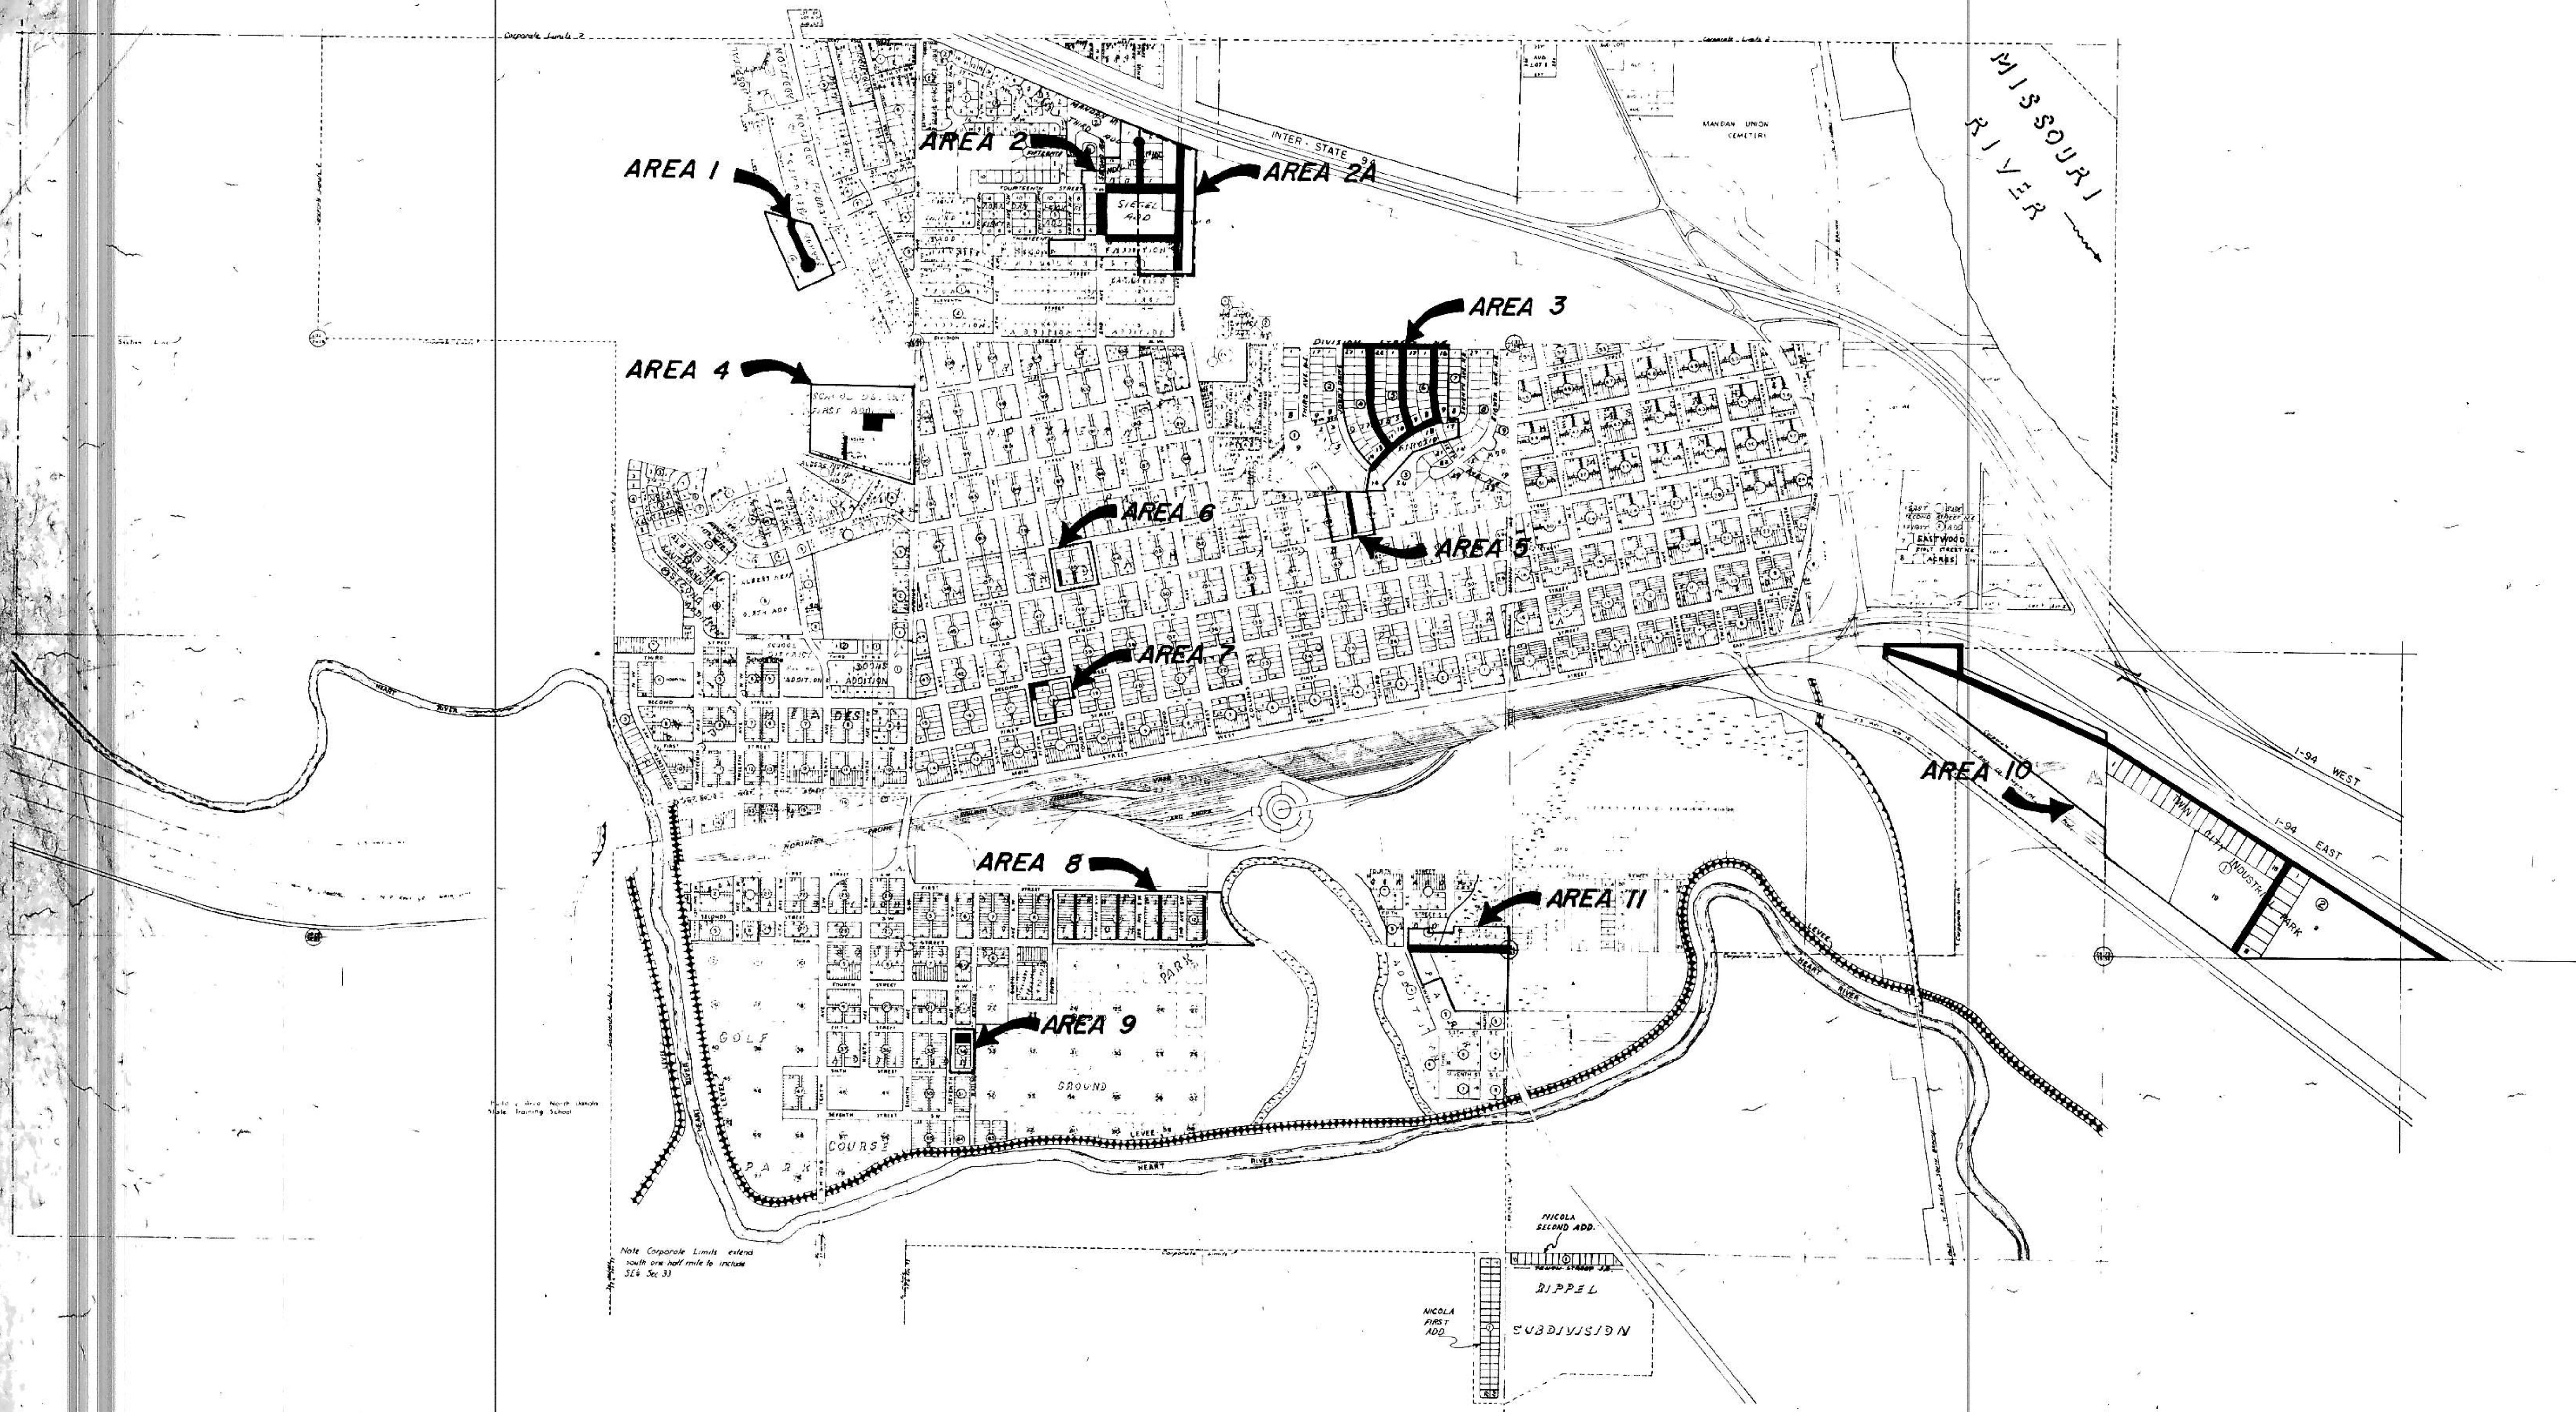

# STREET IMPROVEMENT DISTRICT NO. 52