

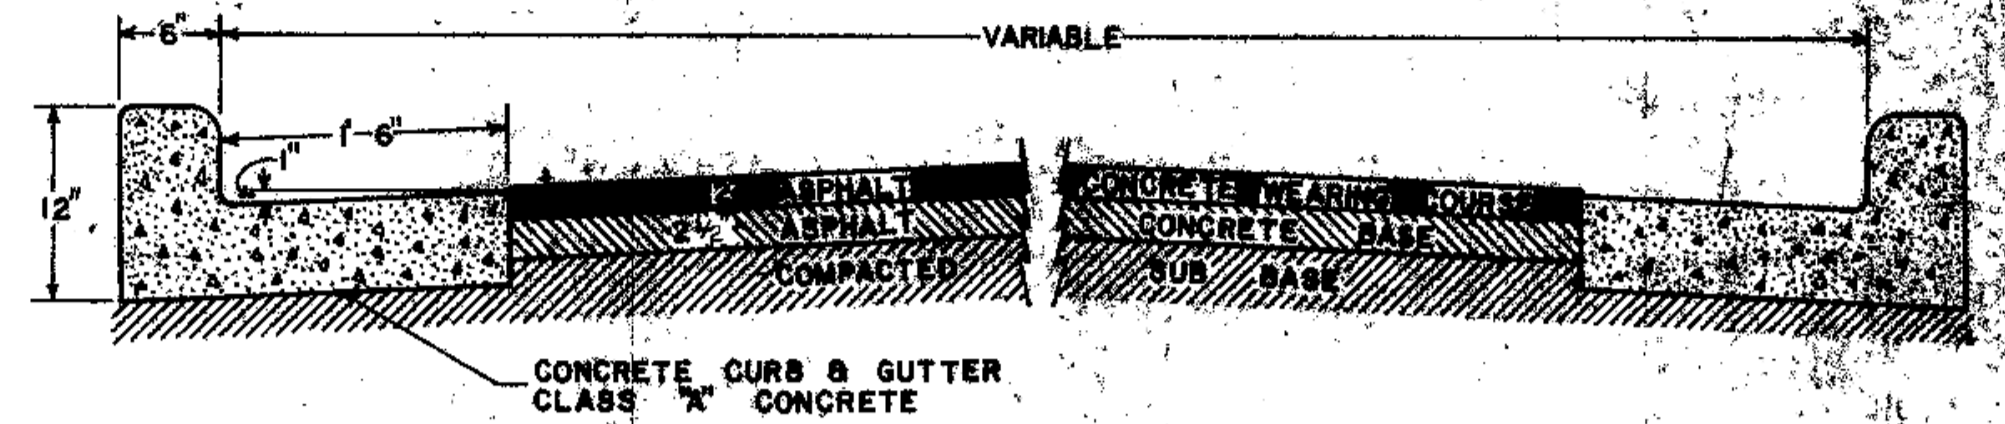



# CITY OF MANDAN, N. D.

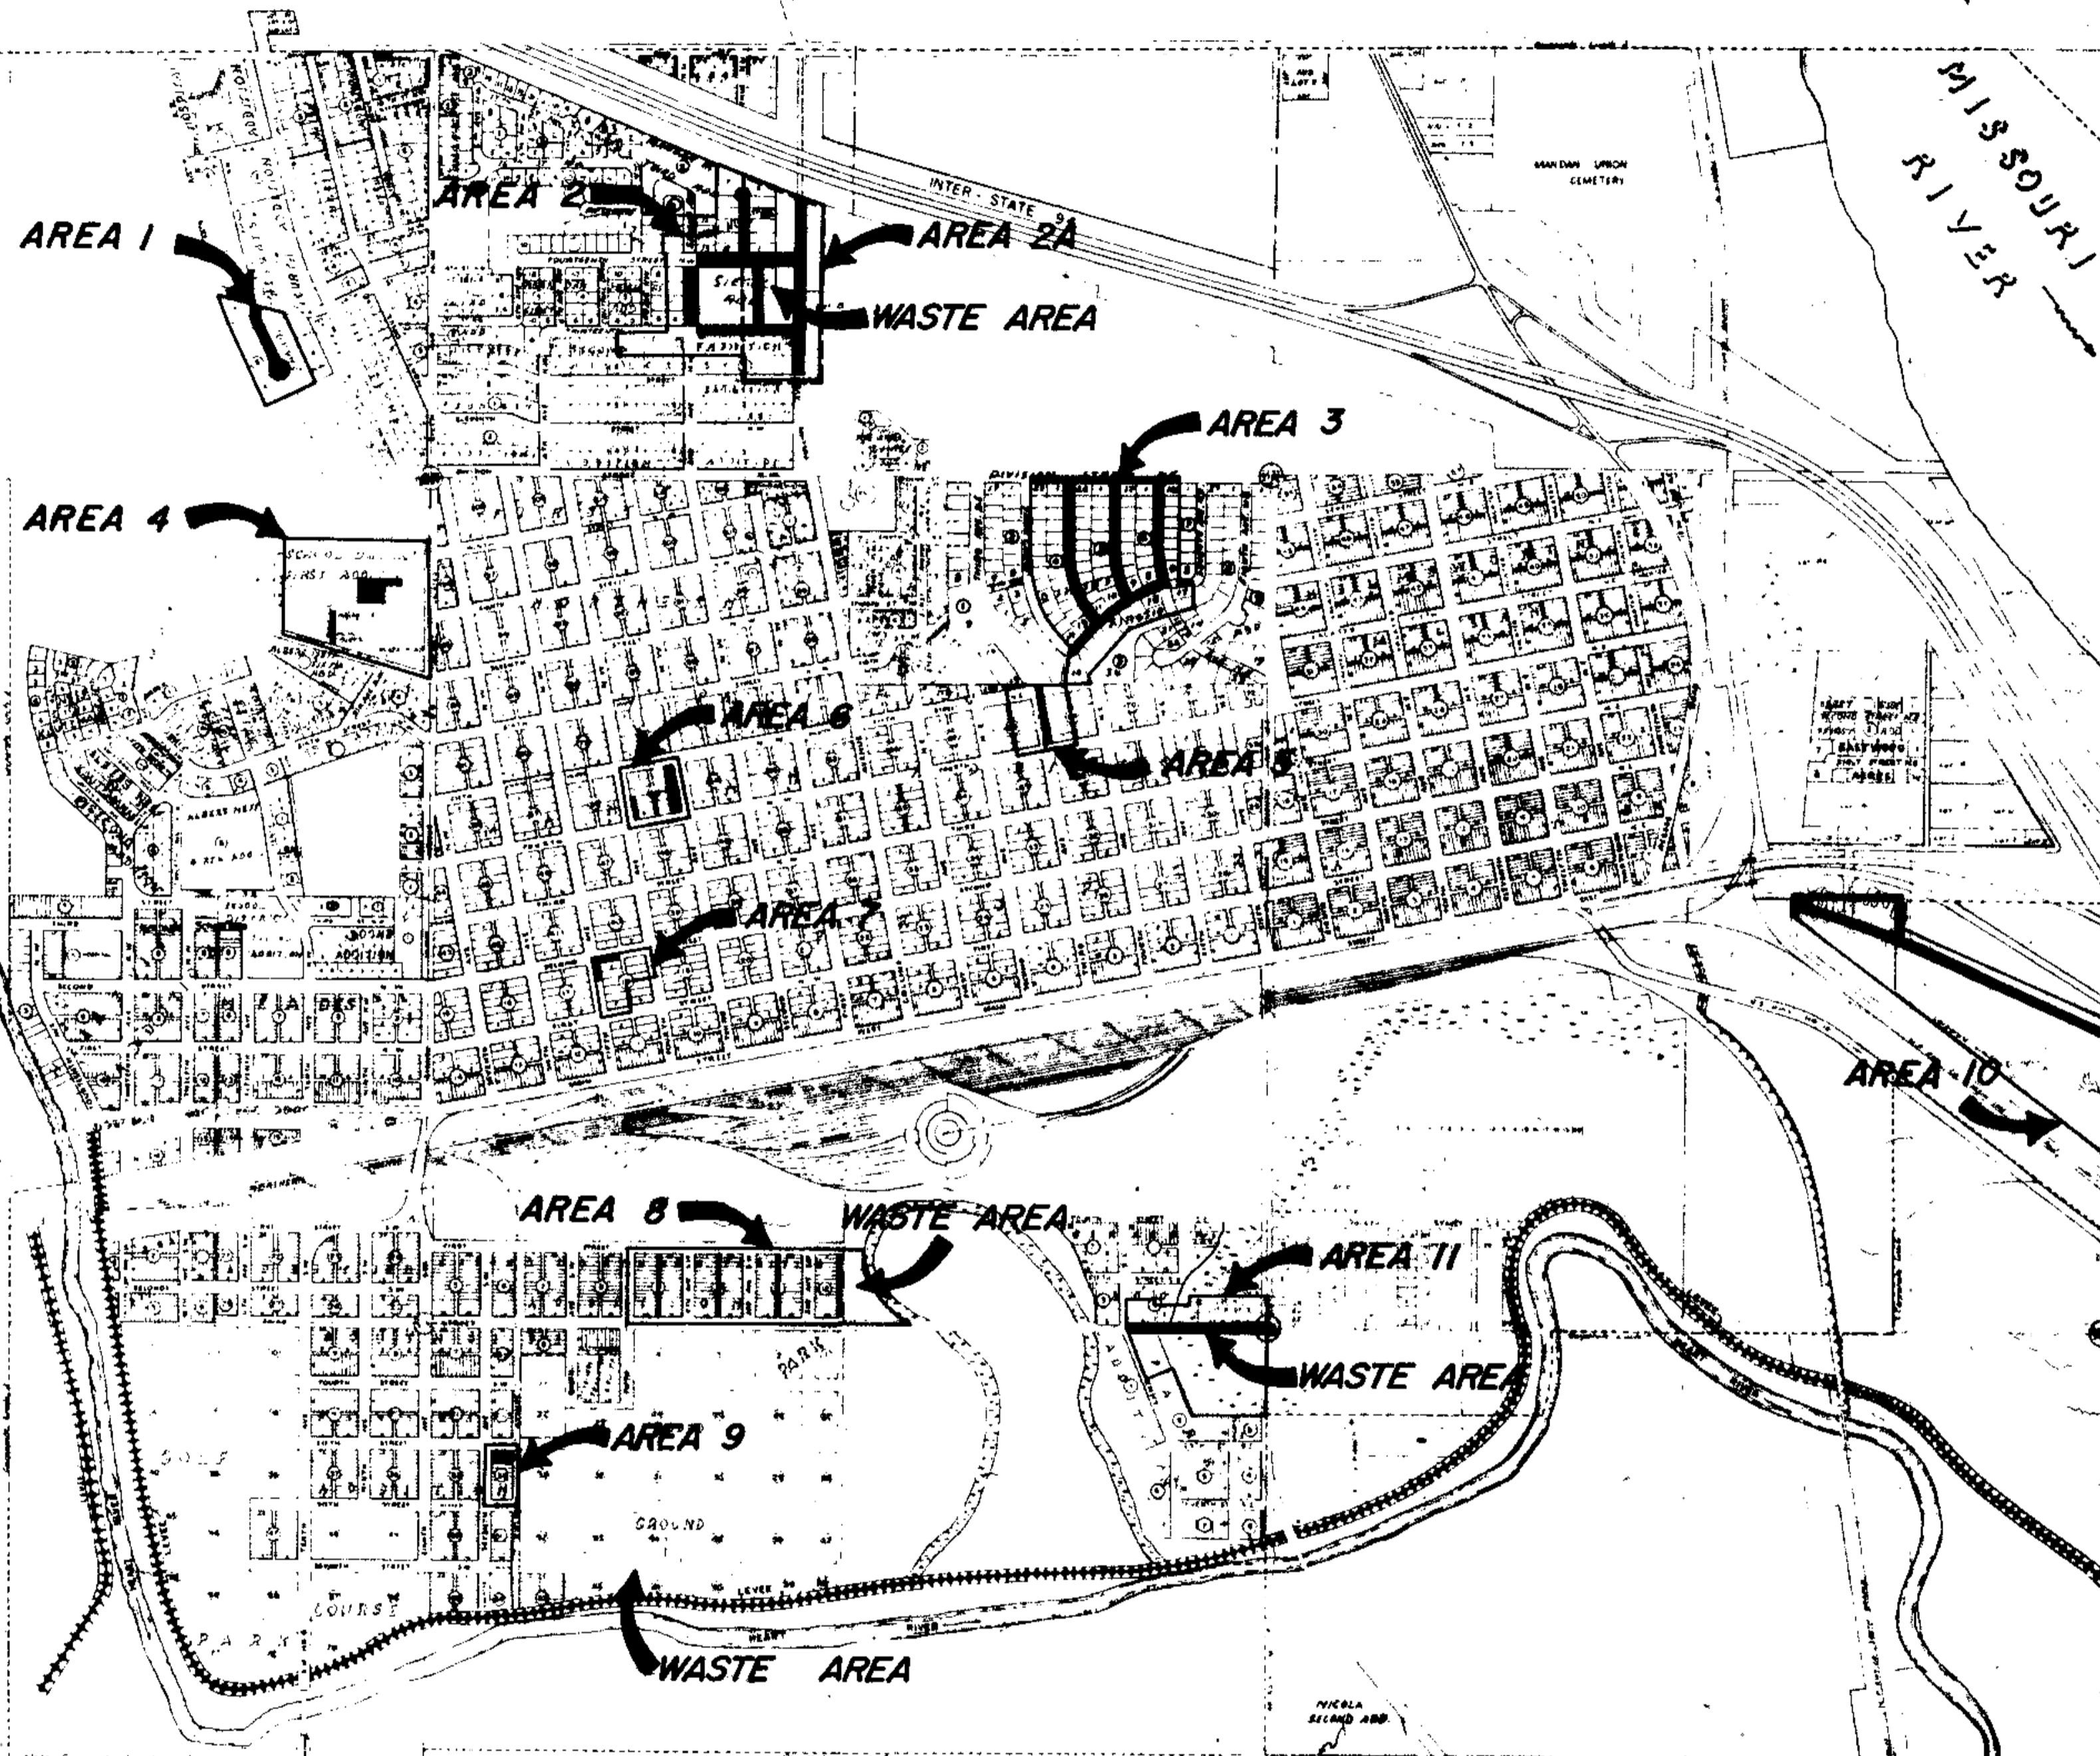


TYPICAL STREET SECTION  
AREAS 1,2,2A,3,4,5,6, & 11

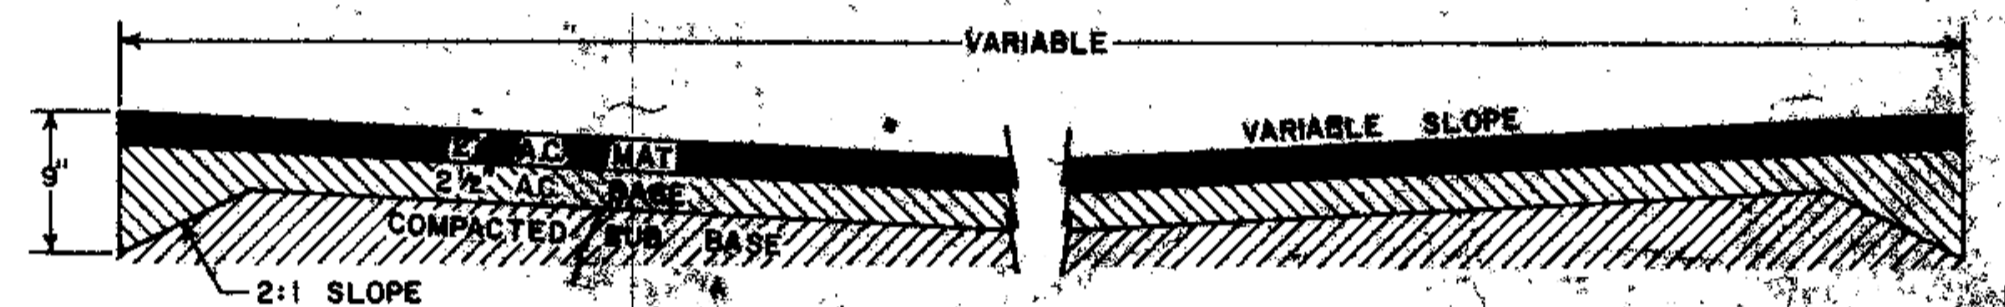

TYPICAL ALLEY & STREET SECTION  
AREAS 8 & 10

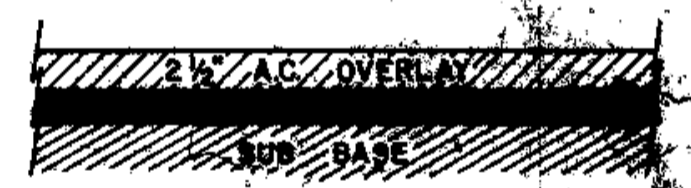

TYPICAL OVERLAY SECTION  
AREAS 4 & 9

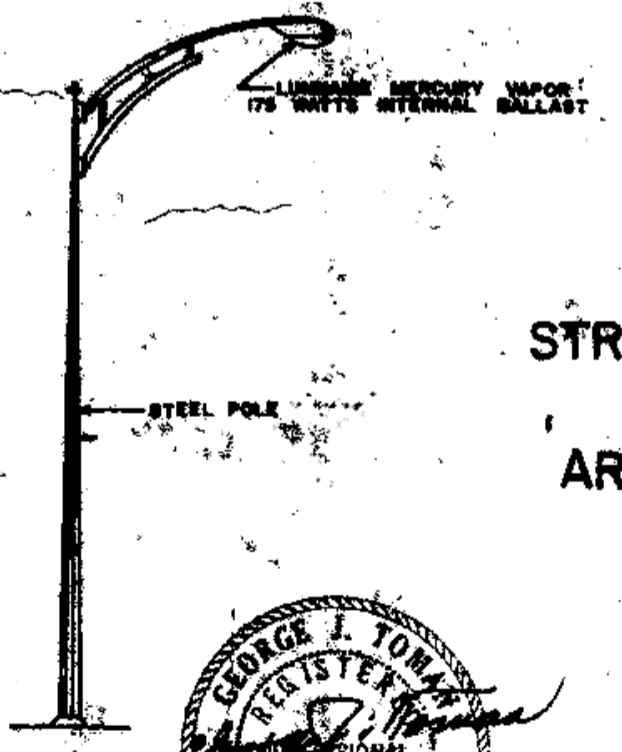

STREET LIGHT DETAIL  
AREAS 1,2,3,4,10, & 11

