

FORTH AVE
 NW

CLASSROOM ADDITION
 FLOOR ELEV. 100'-0" = 1656'-0"


GYMNASIUM
 FLOOR ELEV. 100'-0" = 1657'-0"

EXISTING JUNIOR HIGH

EXISTING JUNIOR HIGH SCHOOL

■ = 2 1/2" BASE
 ■ = 2" MAT

PLOT PLAN
 SCALE 1/16" = 1' - 0"

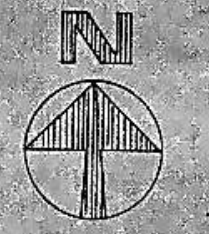

- - - - - EXIST. GRADES
 _____ NEW GRADES



M.C. SHALL CONNECT 15" REIN. CONC. PIPE INTO
 EXIST. STORM SEWER CATCH BASIN TOP ELEV. 1651.4'
 INV. ELEV. 1646.8'