


SCALE 1"=20'



SCALE 1"=30'

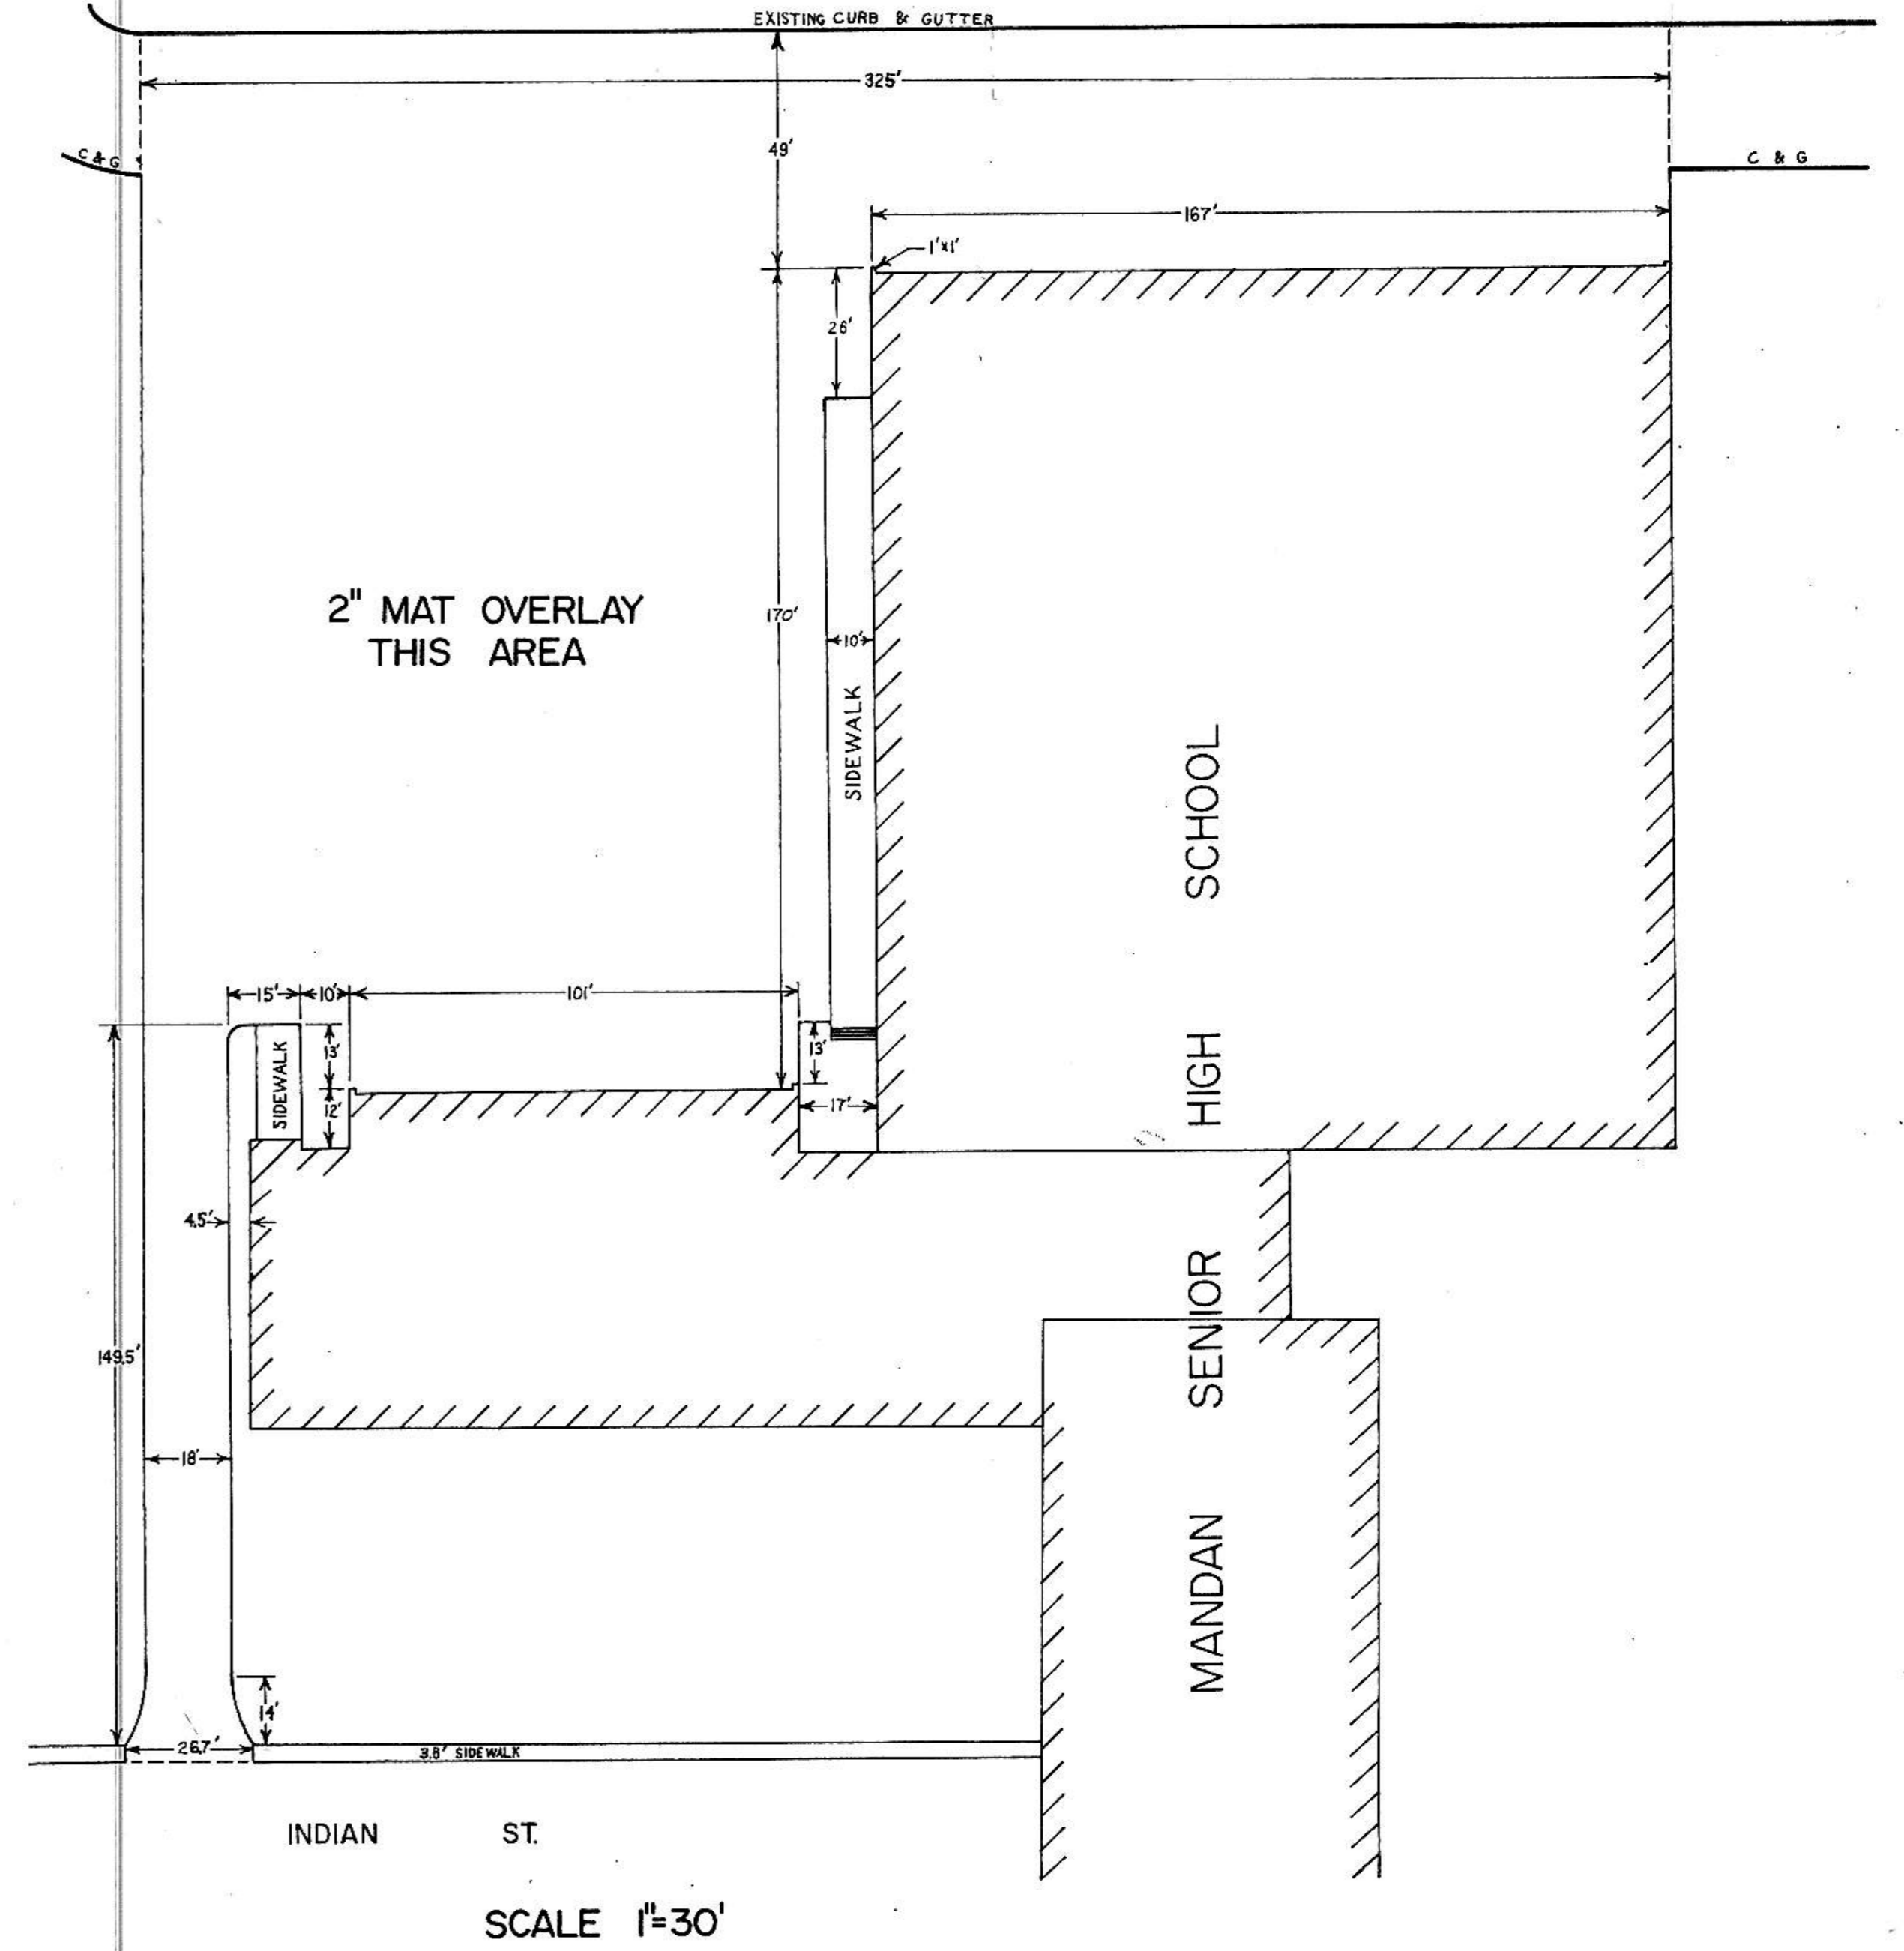