
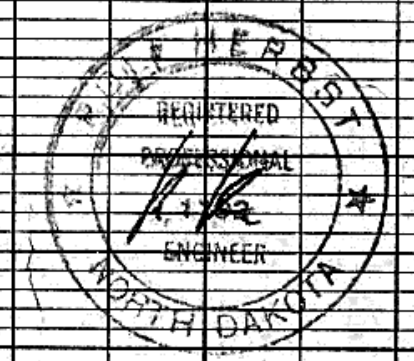
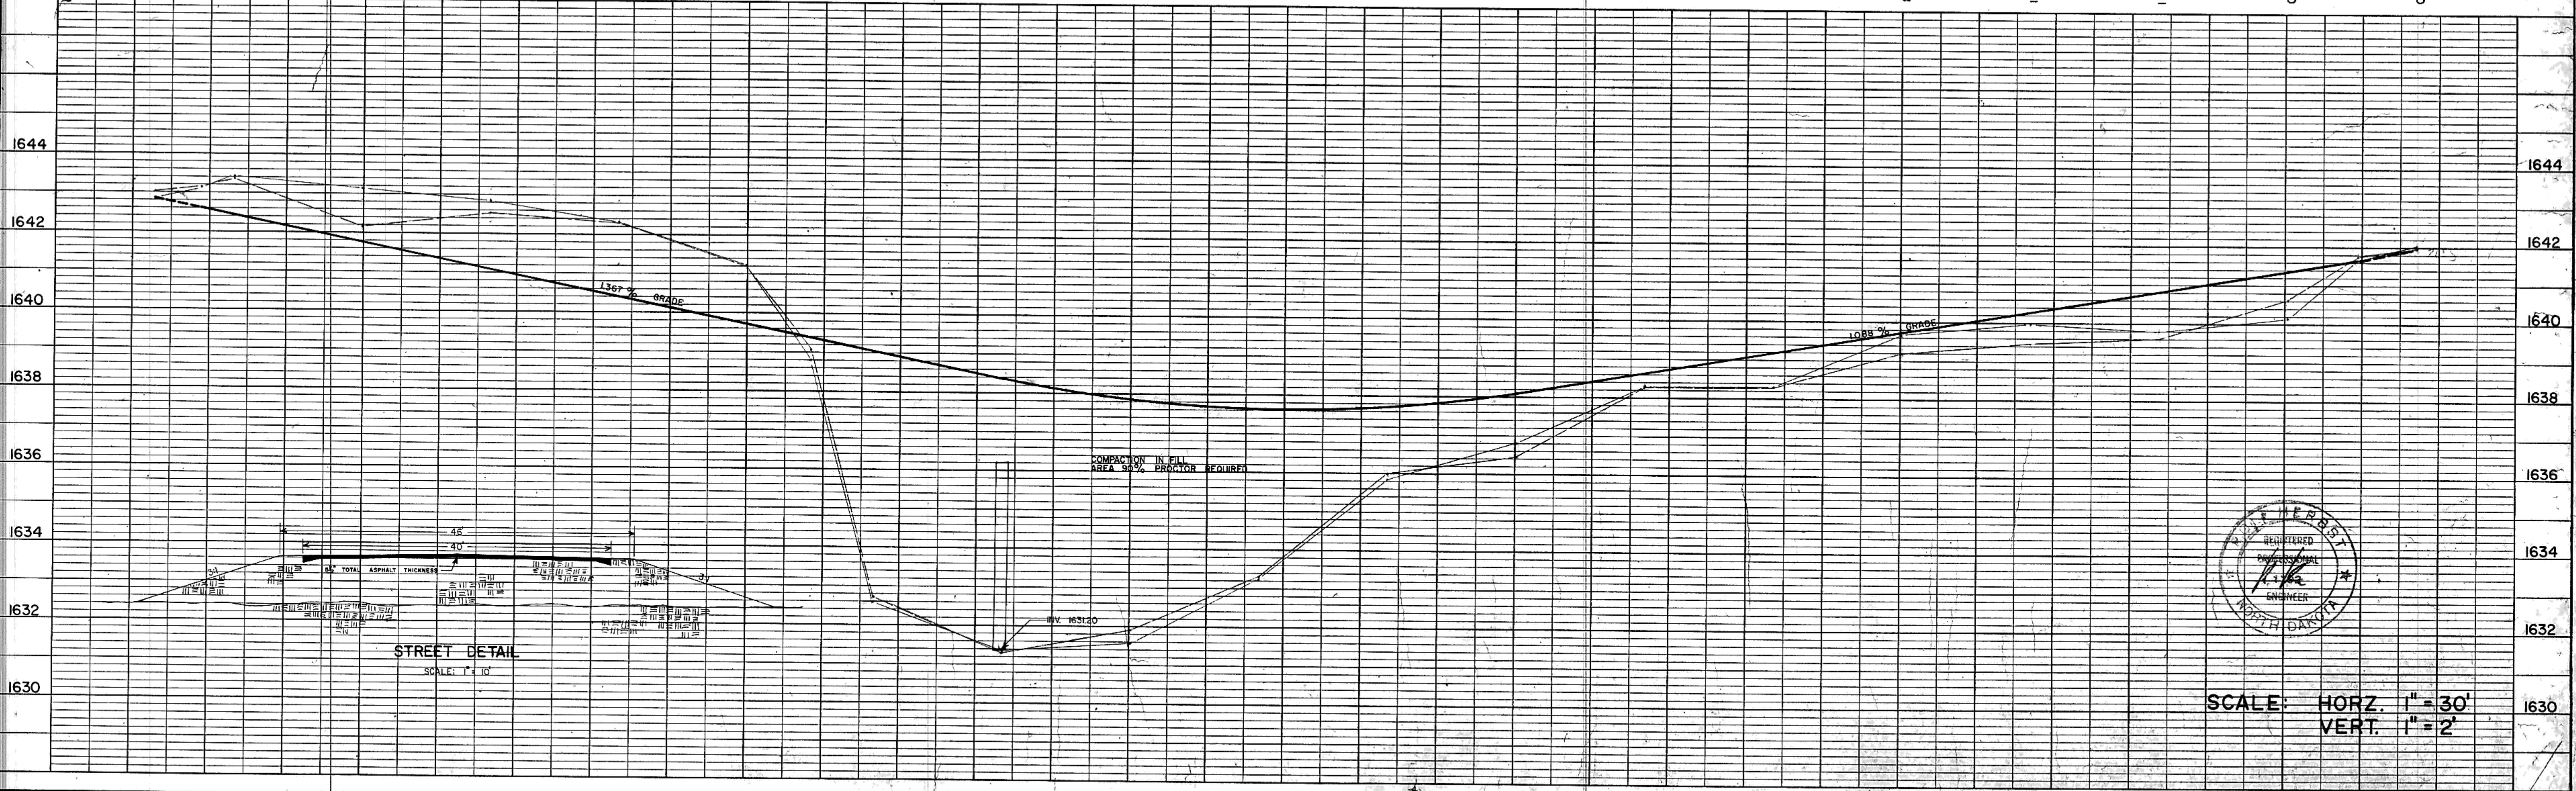


PLAN SURVEYED, PLOTTED, ALIGNED, CHECKED, BY: DATE: NO. OF SHEETS CHECKED: NO. OF SHEETS ORDERED: NO.

PROFILE SURVEYED, PLOTTED, CHECKED, BY: DATE: NO. OF SHEETS CHECKED: NO. OF SHEETS ORDERED: NO.

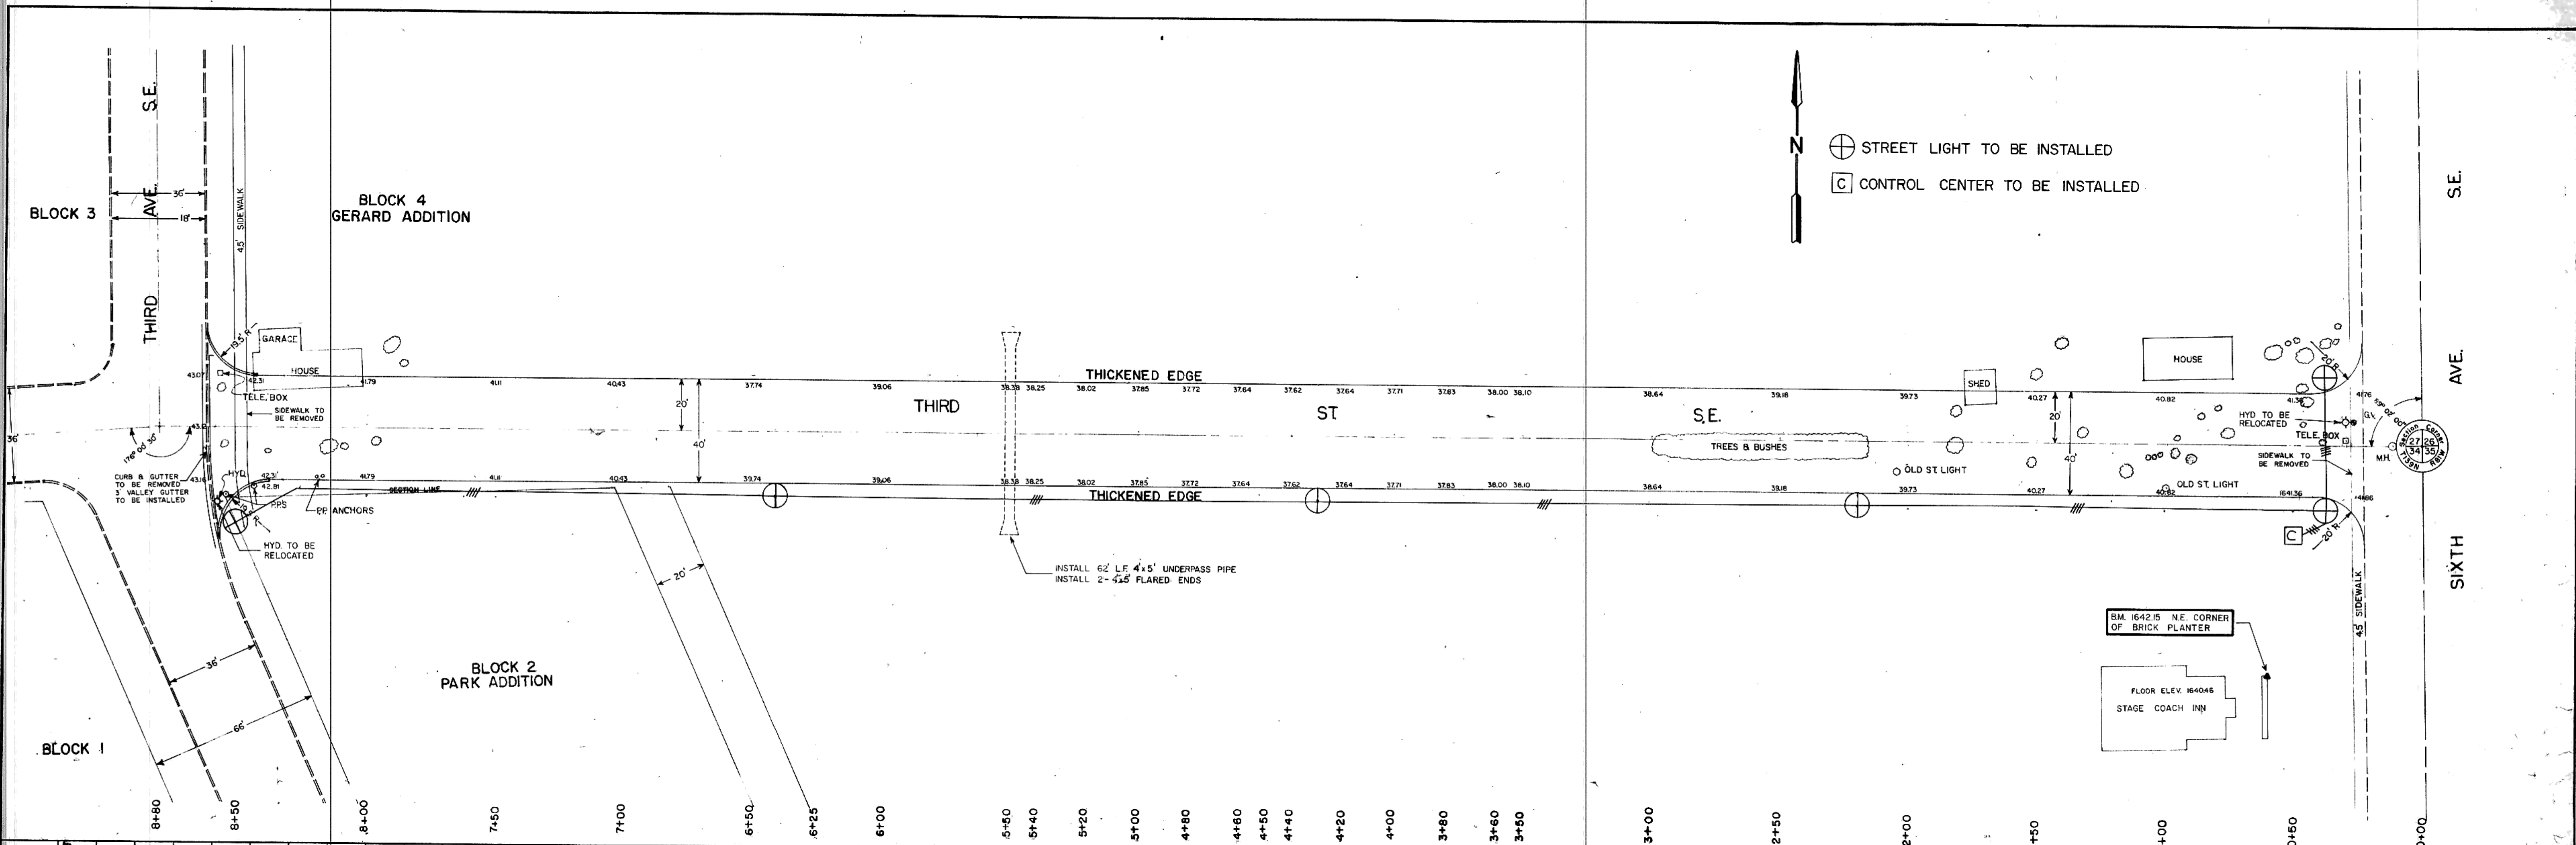

SCALE: HORZ. 1" = 30'
VERT. 1" = 2'