
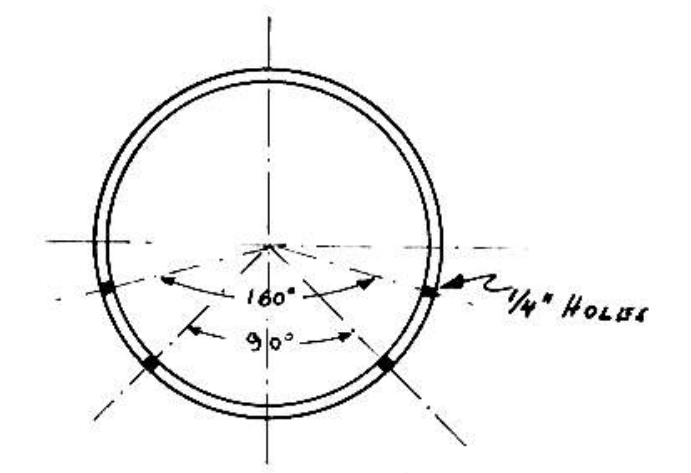


8" PERF. P.V.C.	L.F.	300
6" PERF. P.V.C.	L.F.	1050
4" PERF. P.V.C.	L.F.	1000
4" x 6" P.V.C. WYES	EACH	24
CONCRETE SAND	TON	600
6" STABILIZED BASE	S.Y.	4700
4' M.H. CONES WITH BASE AND CASTING EACH		4
4' x 8" P.V.C. WYES		2

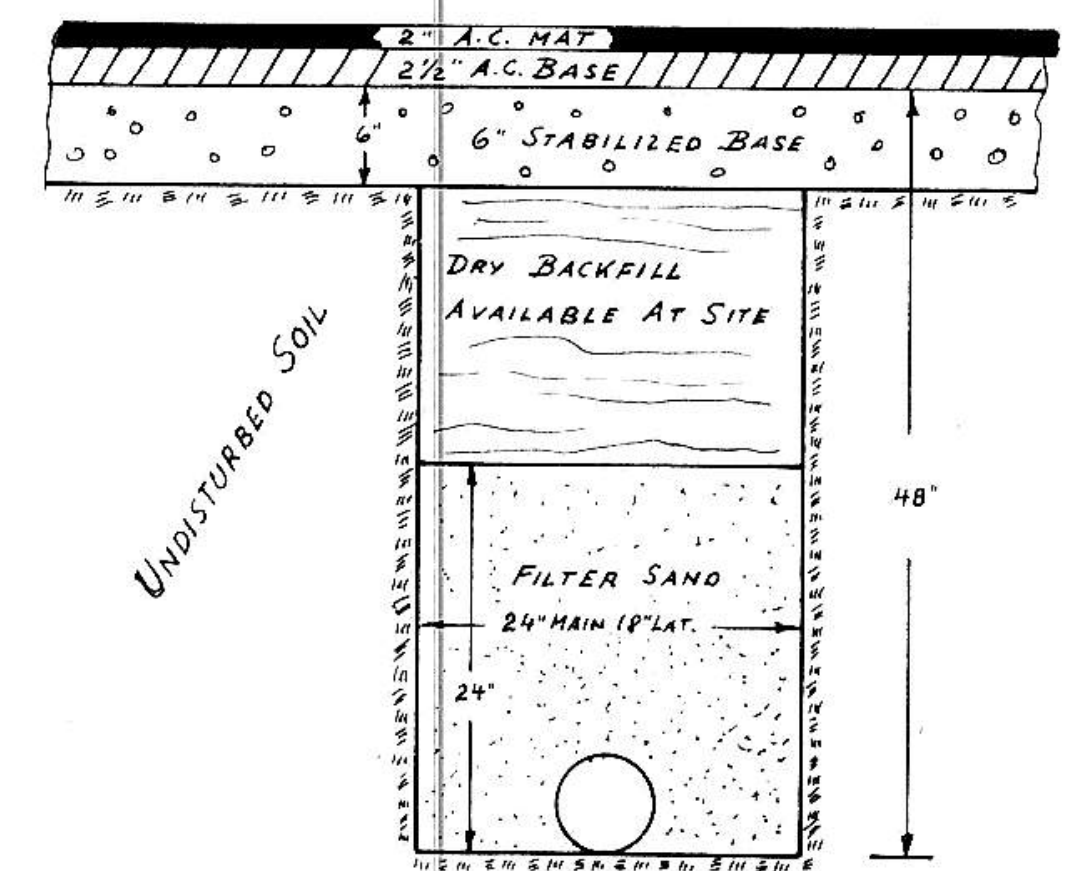

TYPICAL TRENCH

TYPICAL PIPE  
CRETEX W2

SIEVE SIZE ASTM	% PASSING
3/8"	100
No. 4	95-100
No. 16	45-80
No. 50	10-30
No. 100	2-10

GRADATION FOR FILTER (CONCRETE SAND)

UNDERDRAIN DETAILS

13414<sup>th</sup> St. N.W. First Ave. N.W.