

PLAN
 SURVEYED, PLOTTED, CHECKED, NOTE BOOK NO.
 BY DATE

PROFILE
 SURVEYED, GRADES CHECKED, B.M. NOTED, STRUCTURE NOTATIONS CHWD, NOTE BOOK NO.
 BY DATE








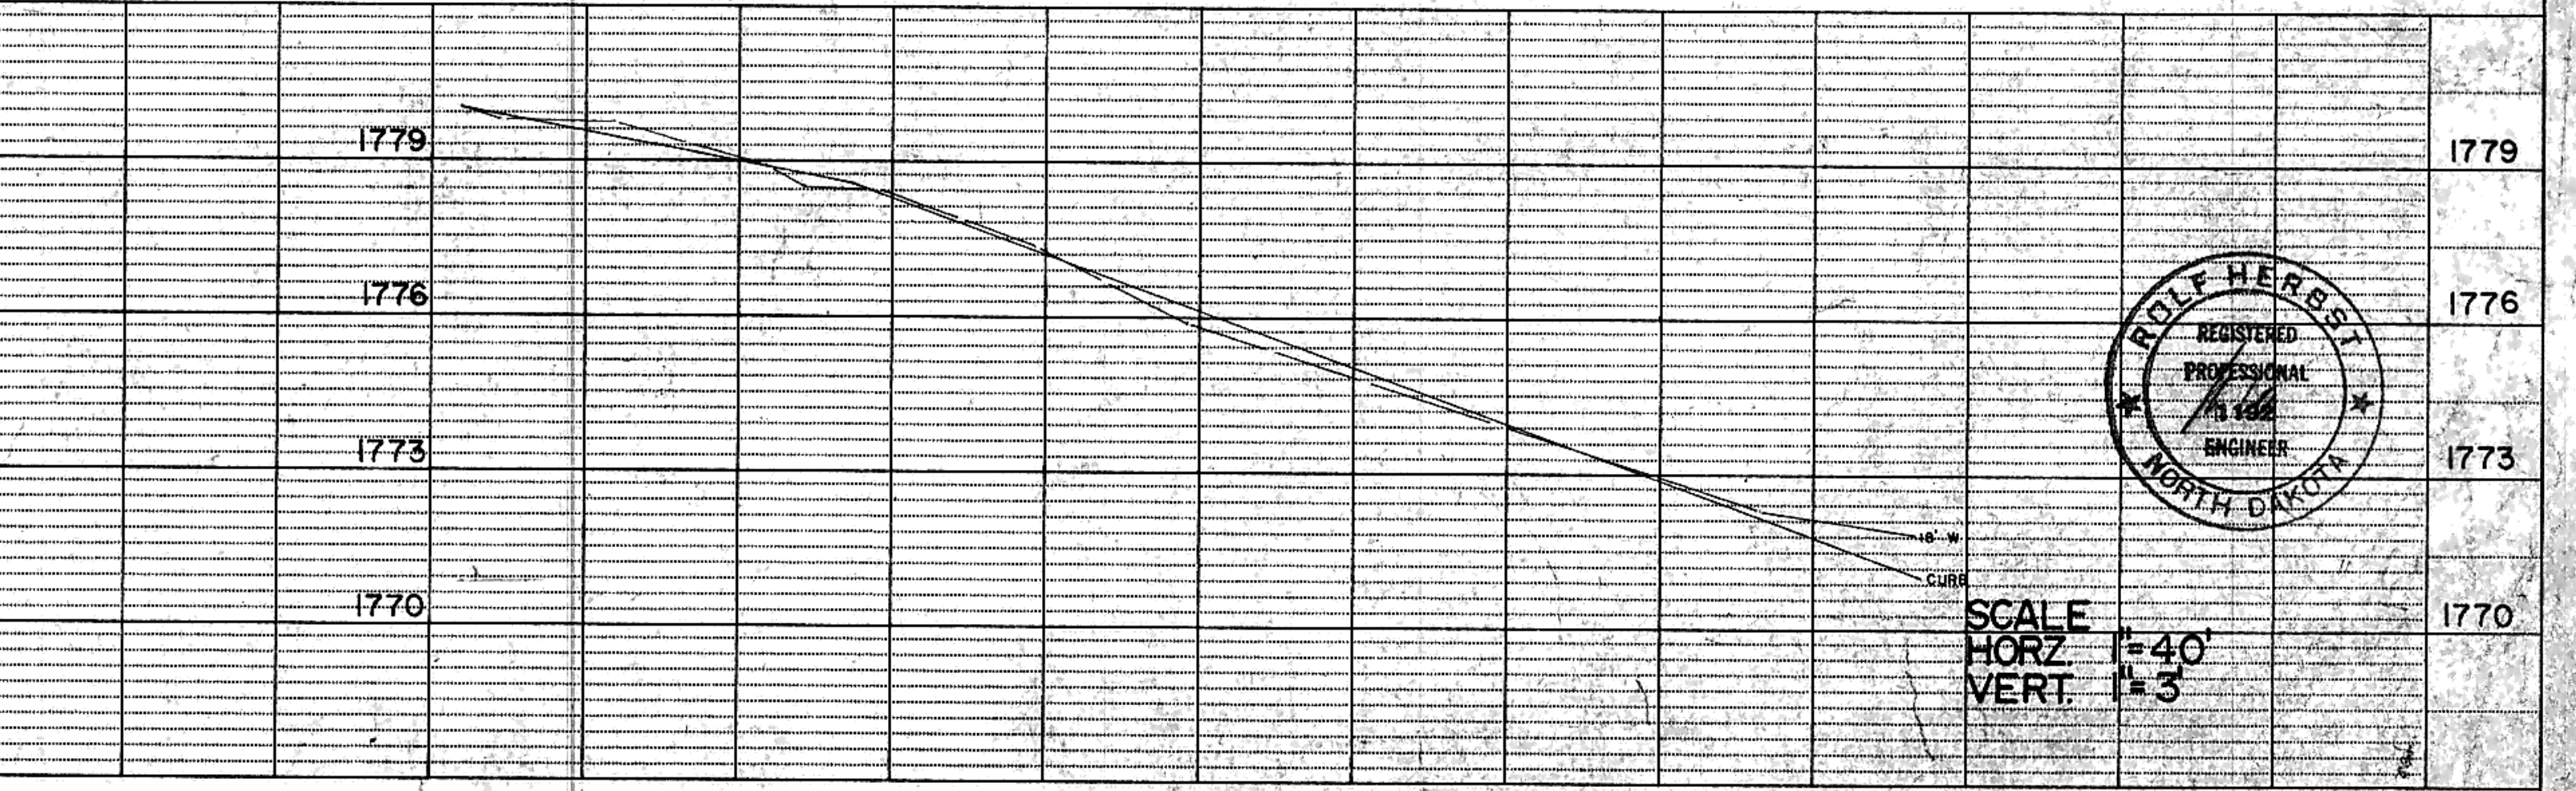


PLATE 2—DOUBLE PLAN AND PROFILE—DOTTED
 NATIONAL TRACING PAPER DIVISION
 I.P.P.A.L. CO., INC. INDIANAPOLIS, INDIANA

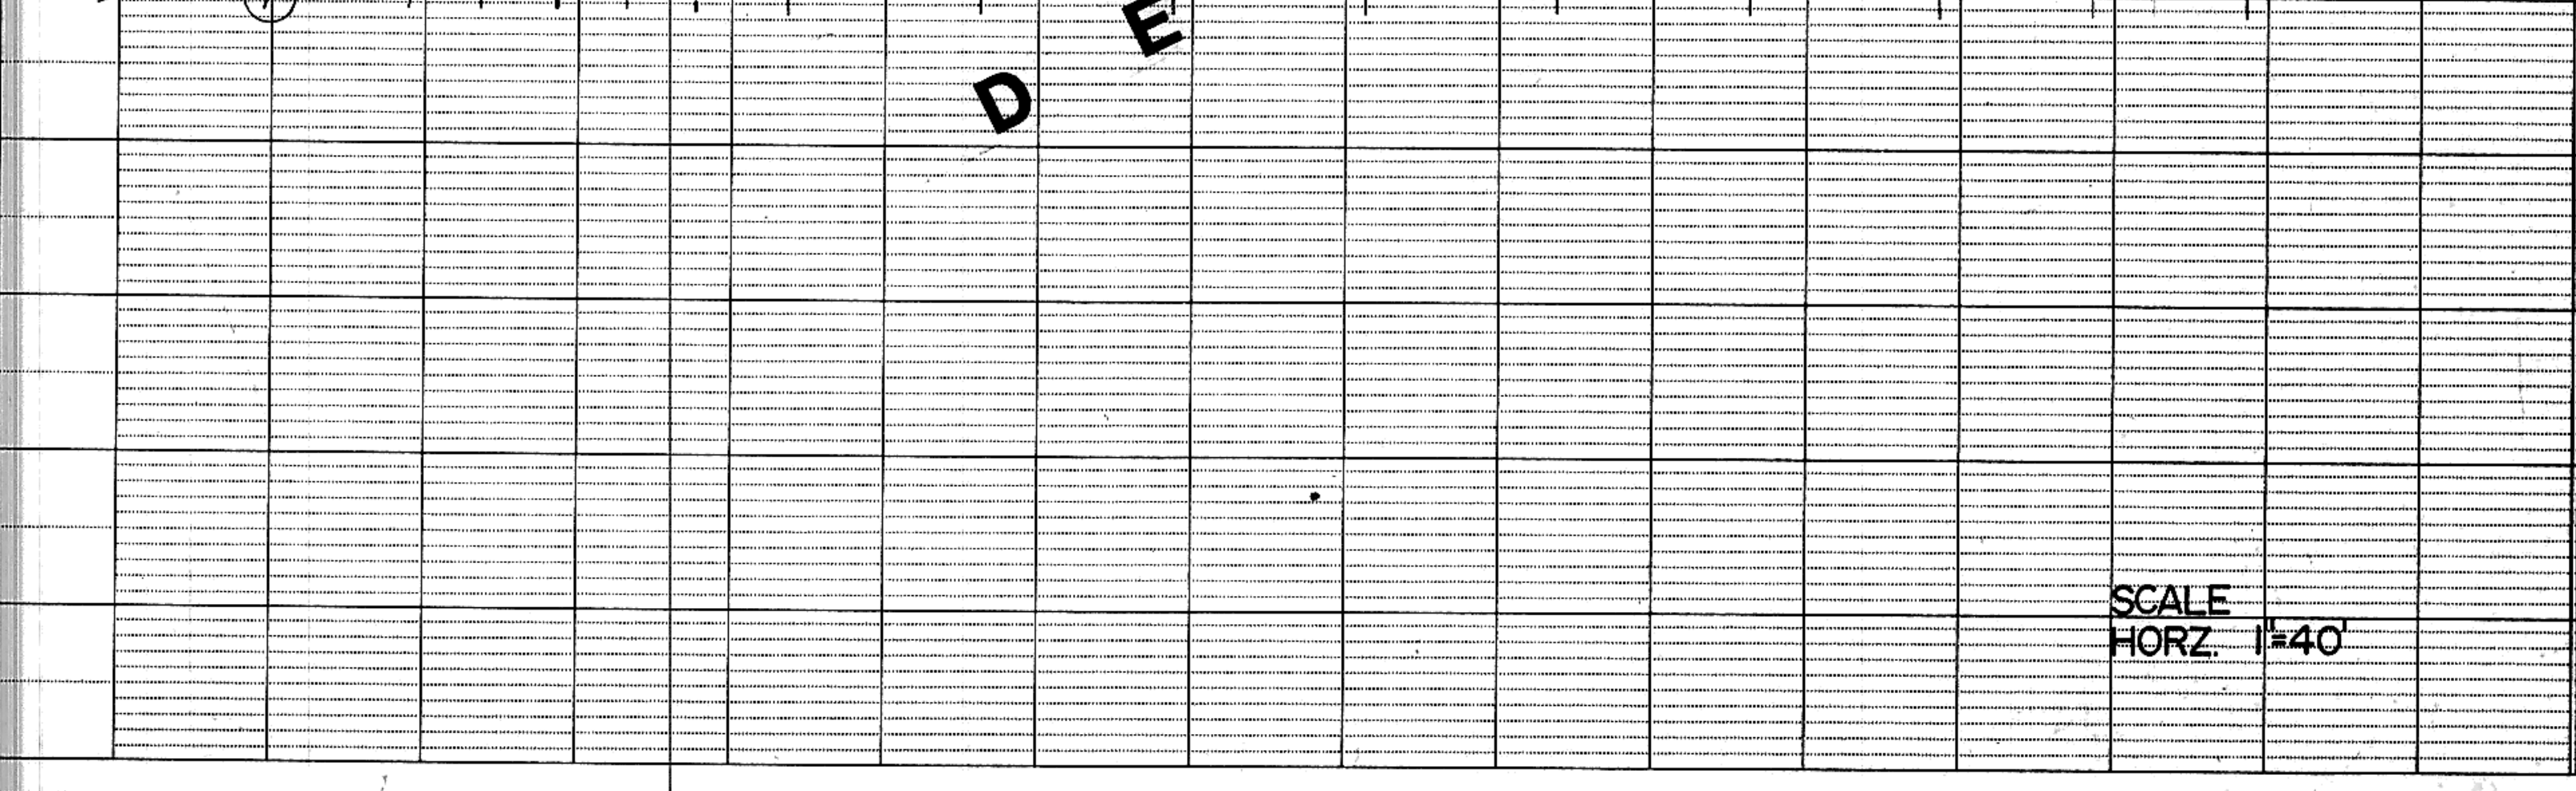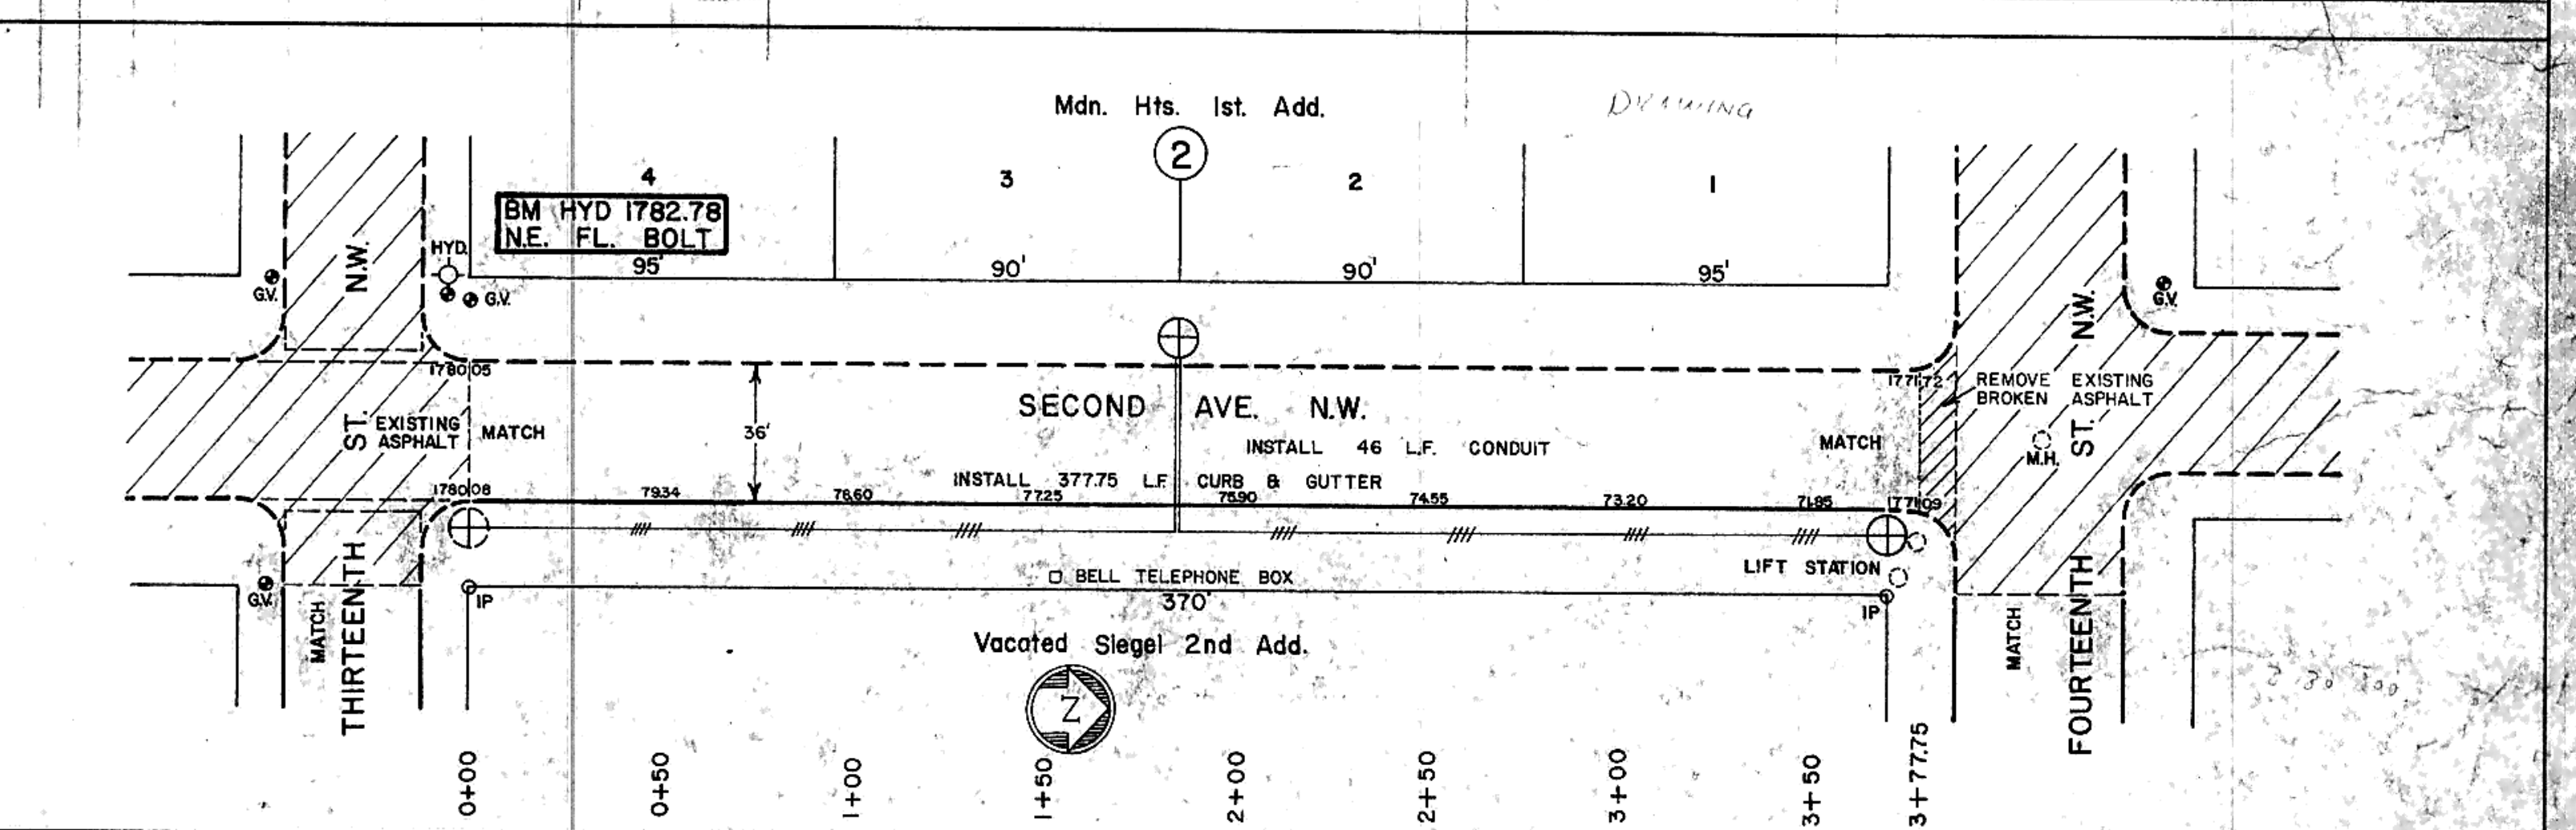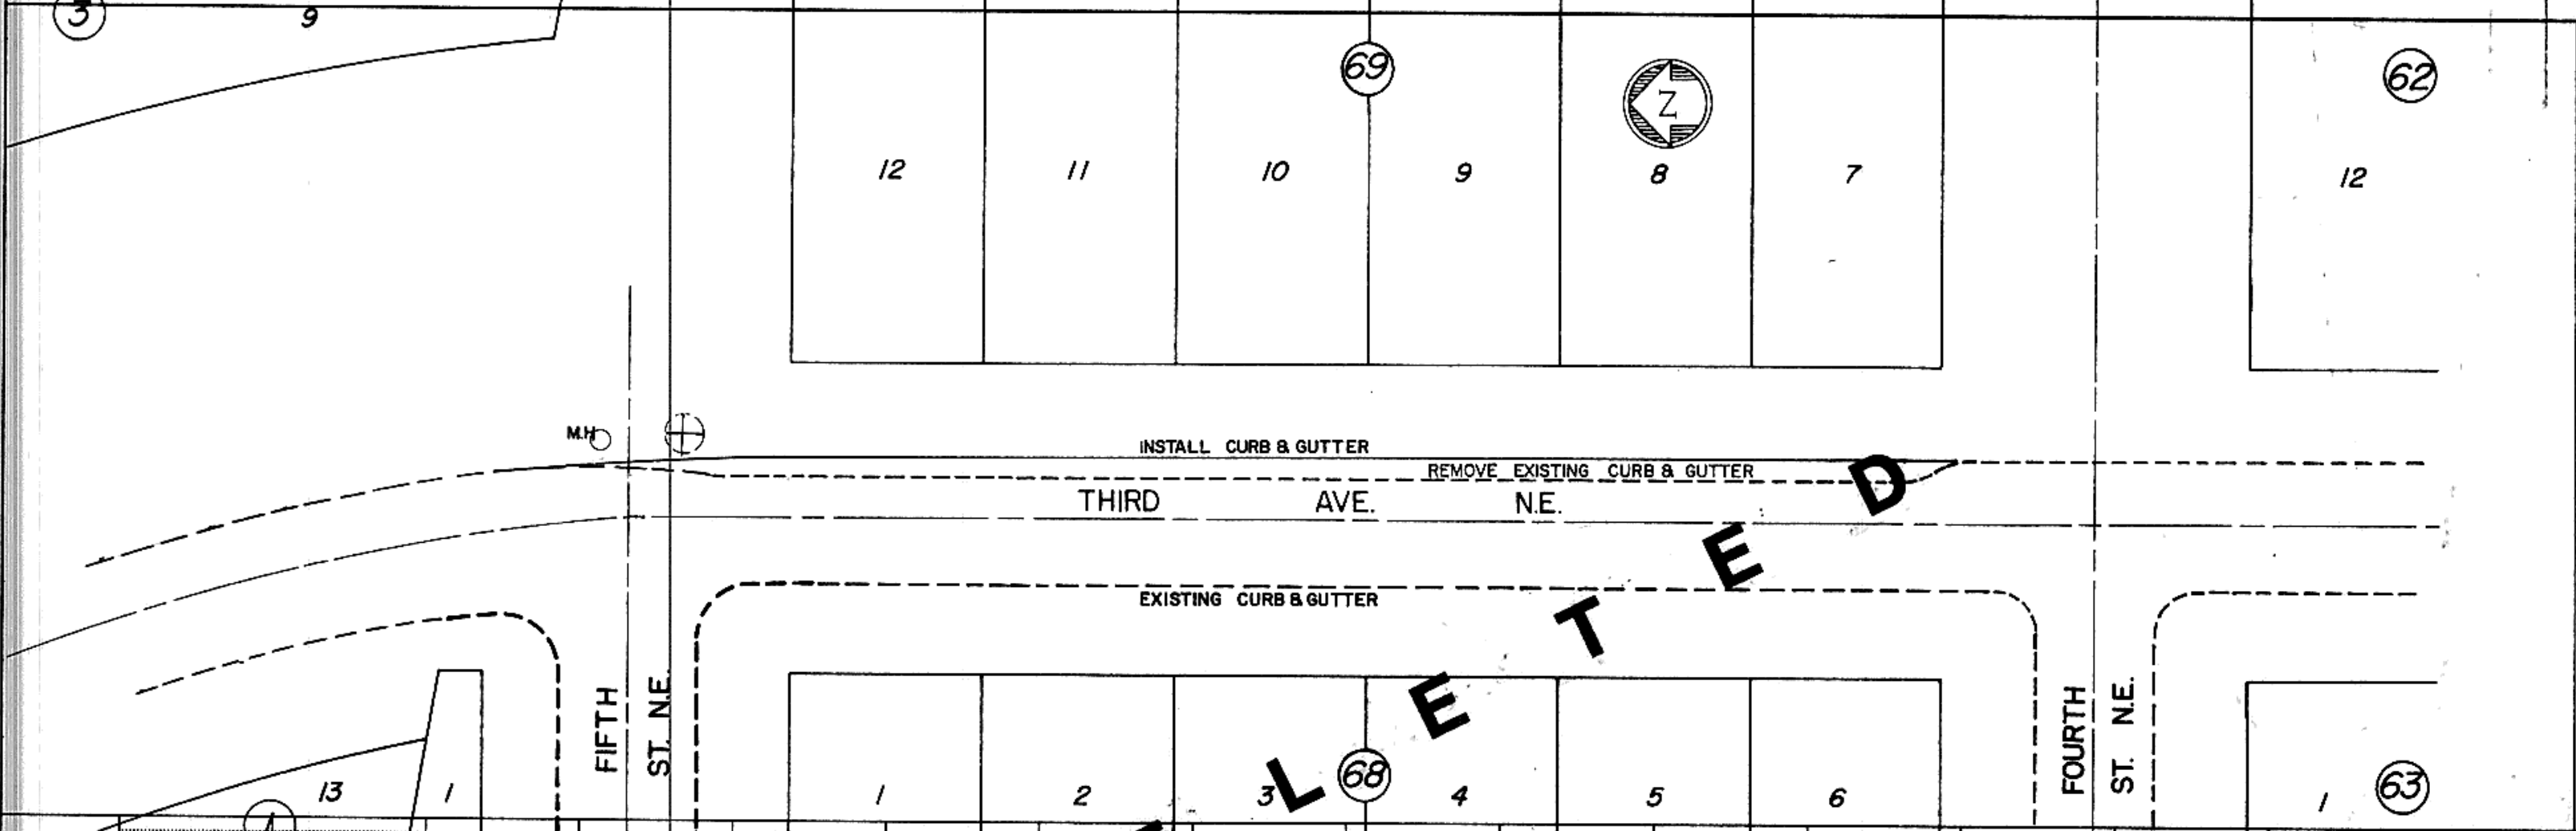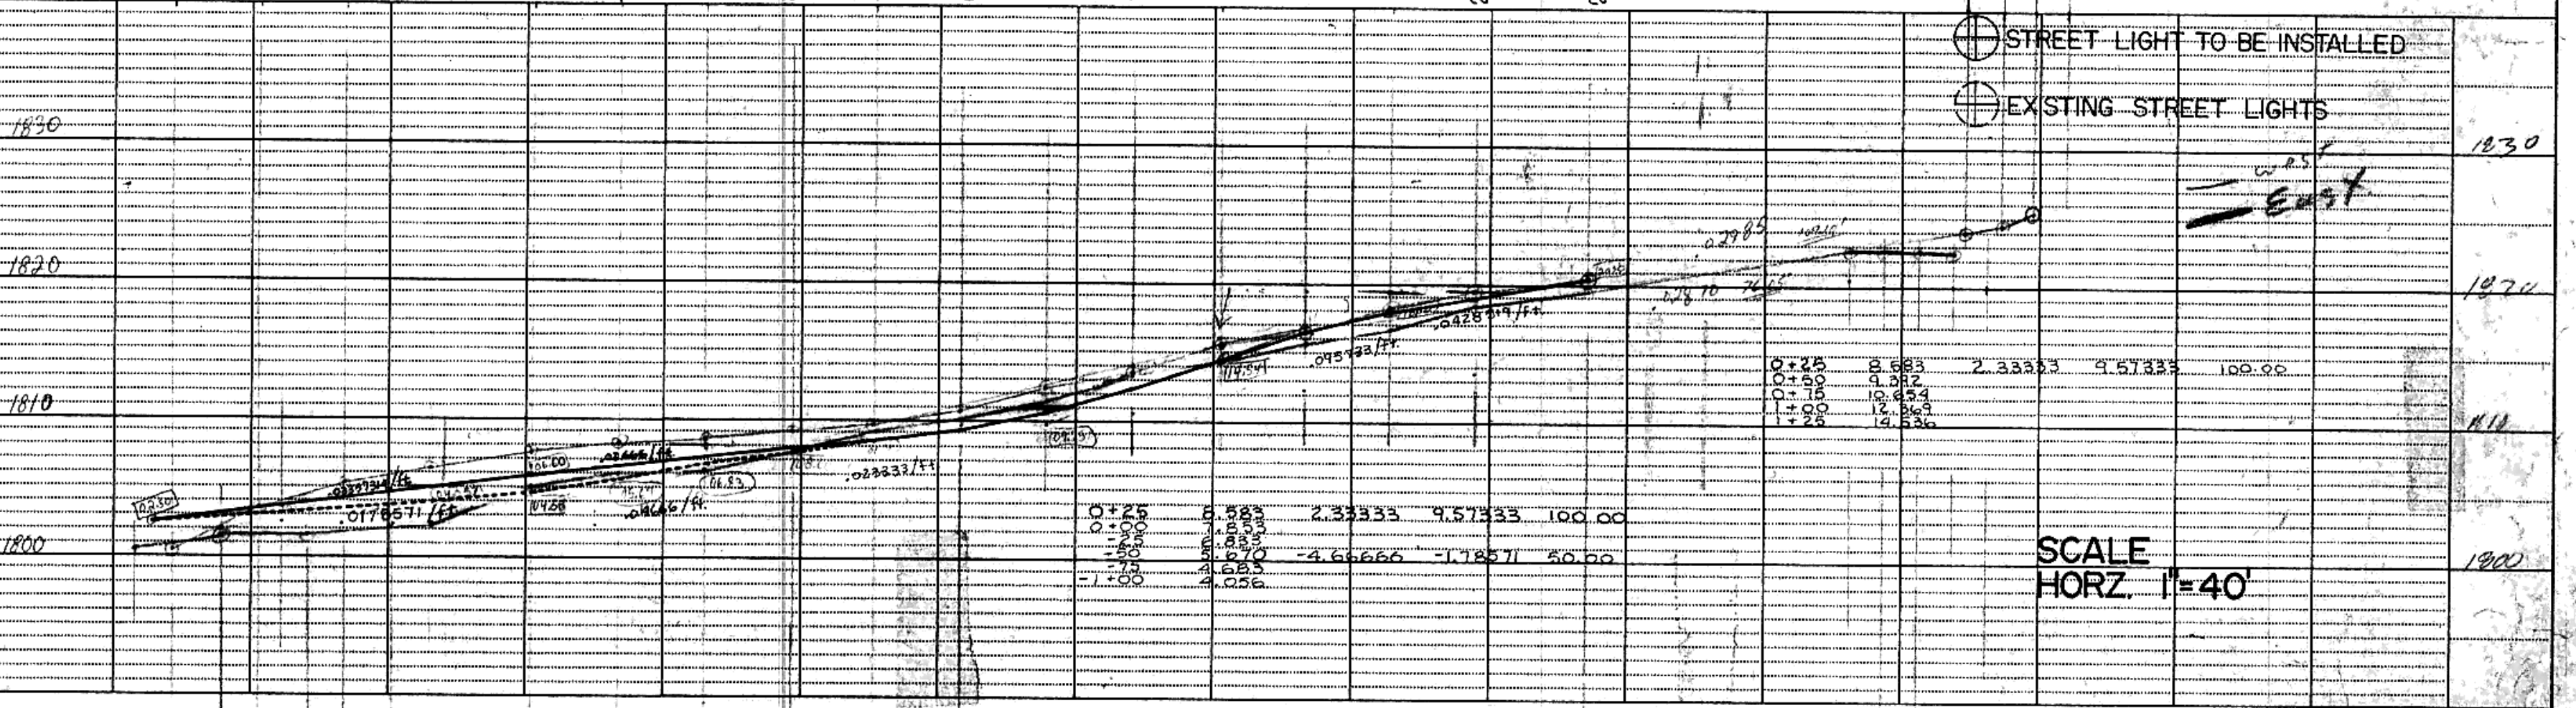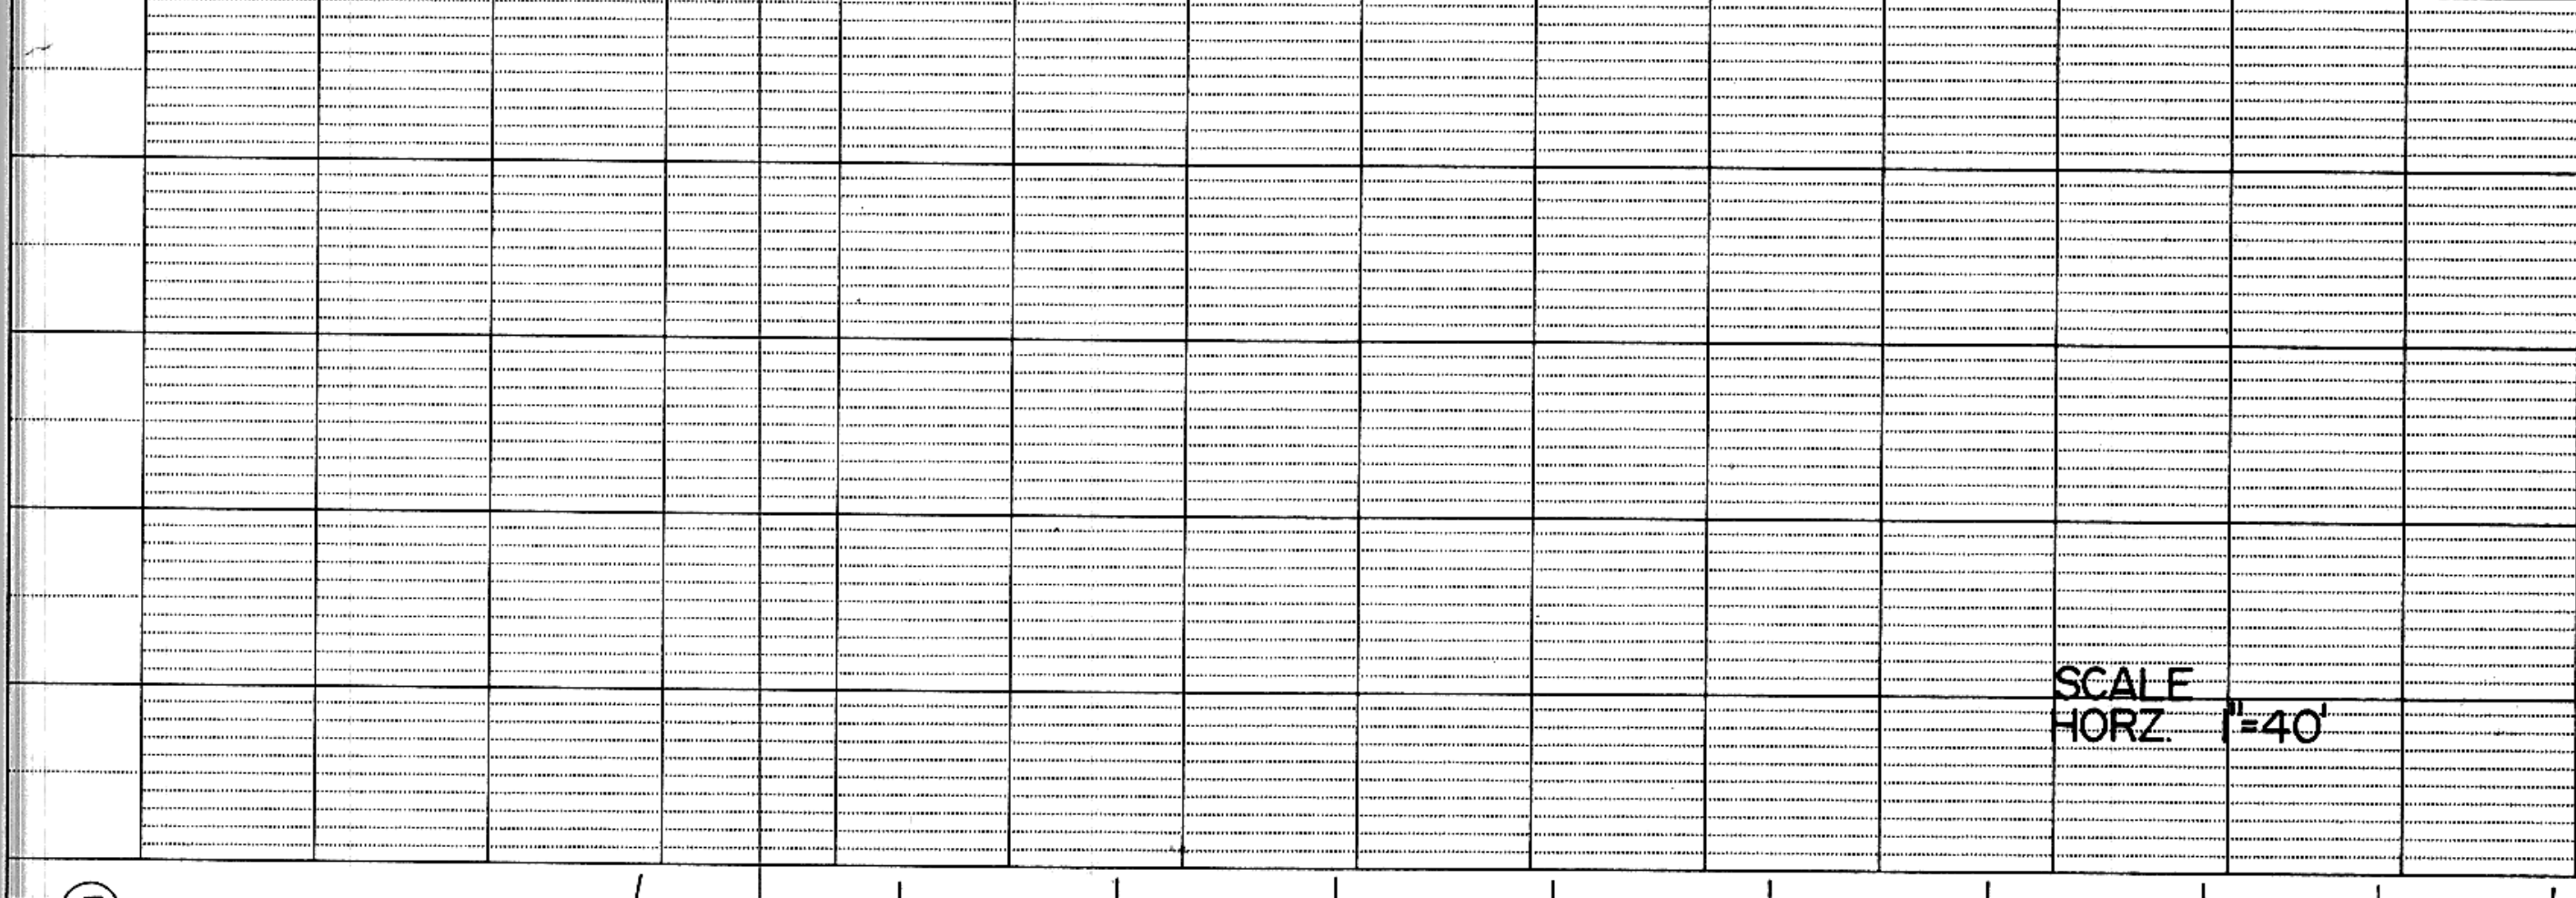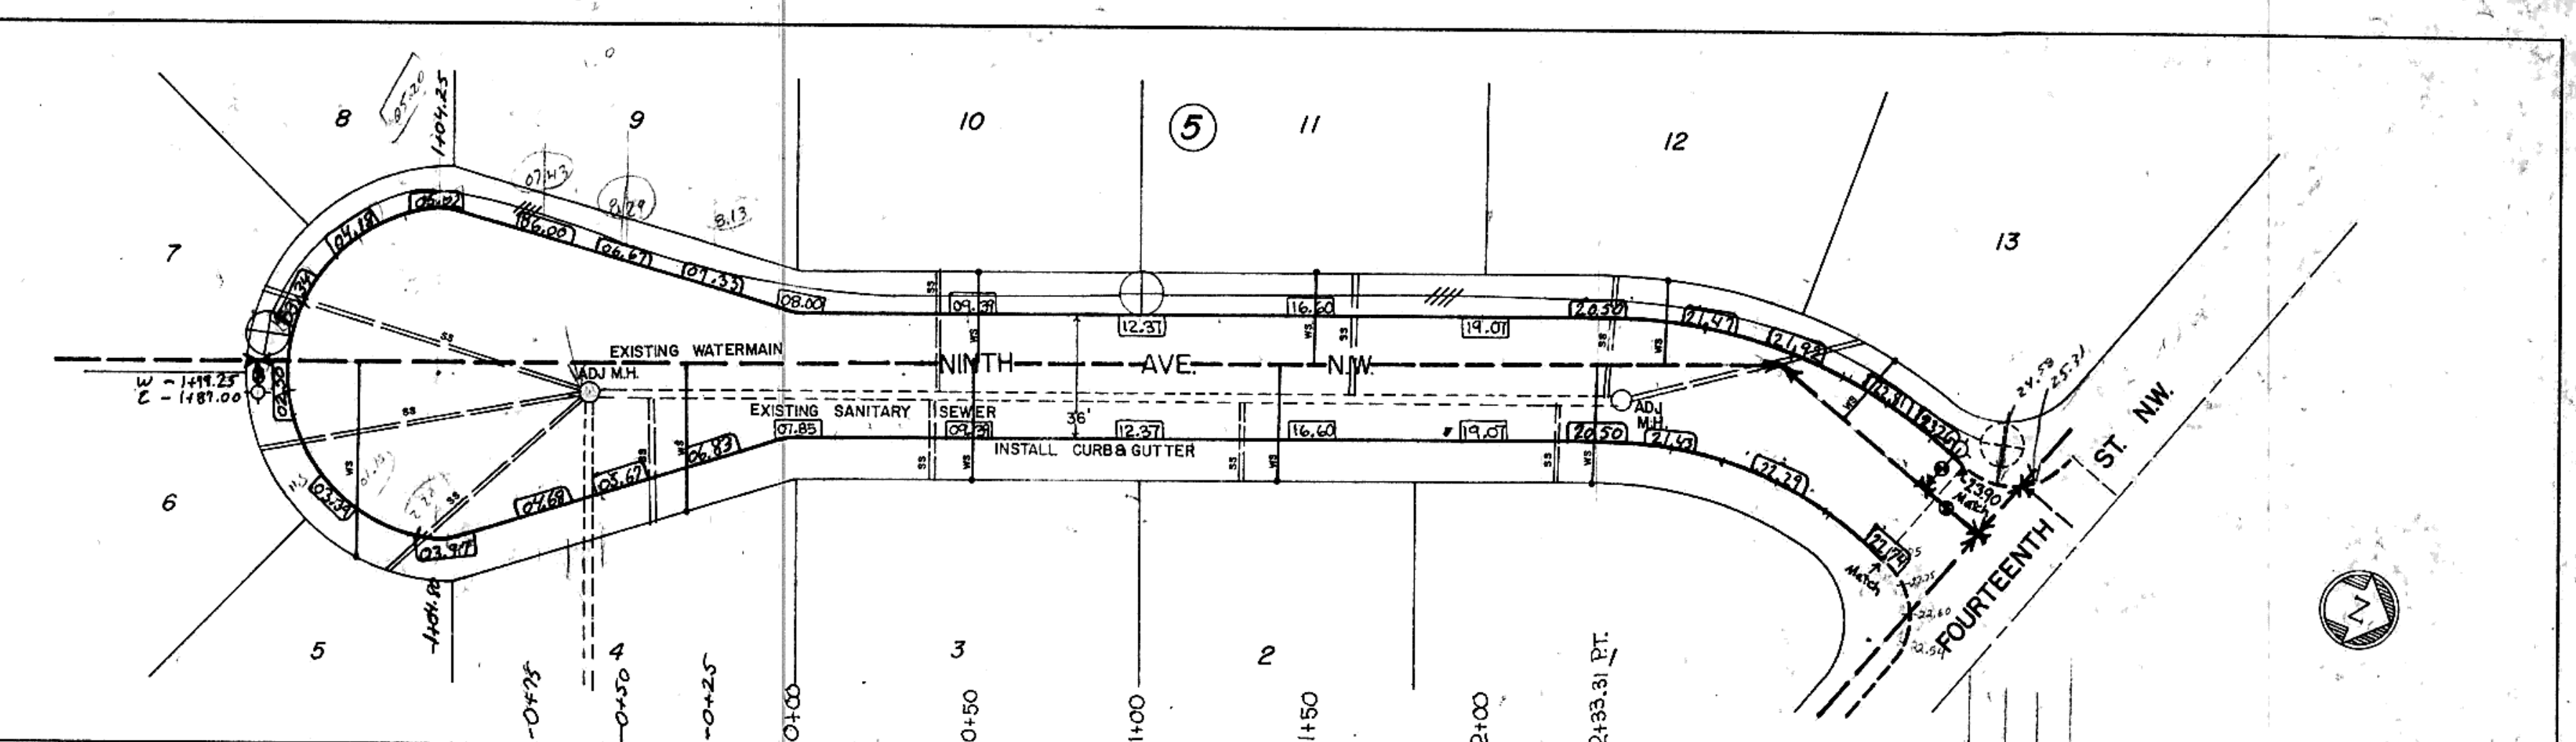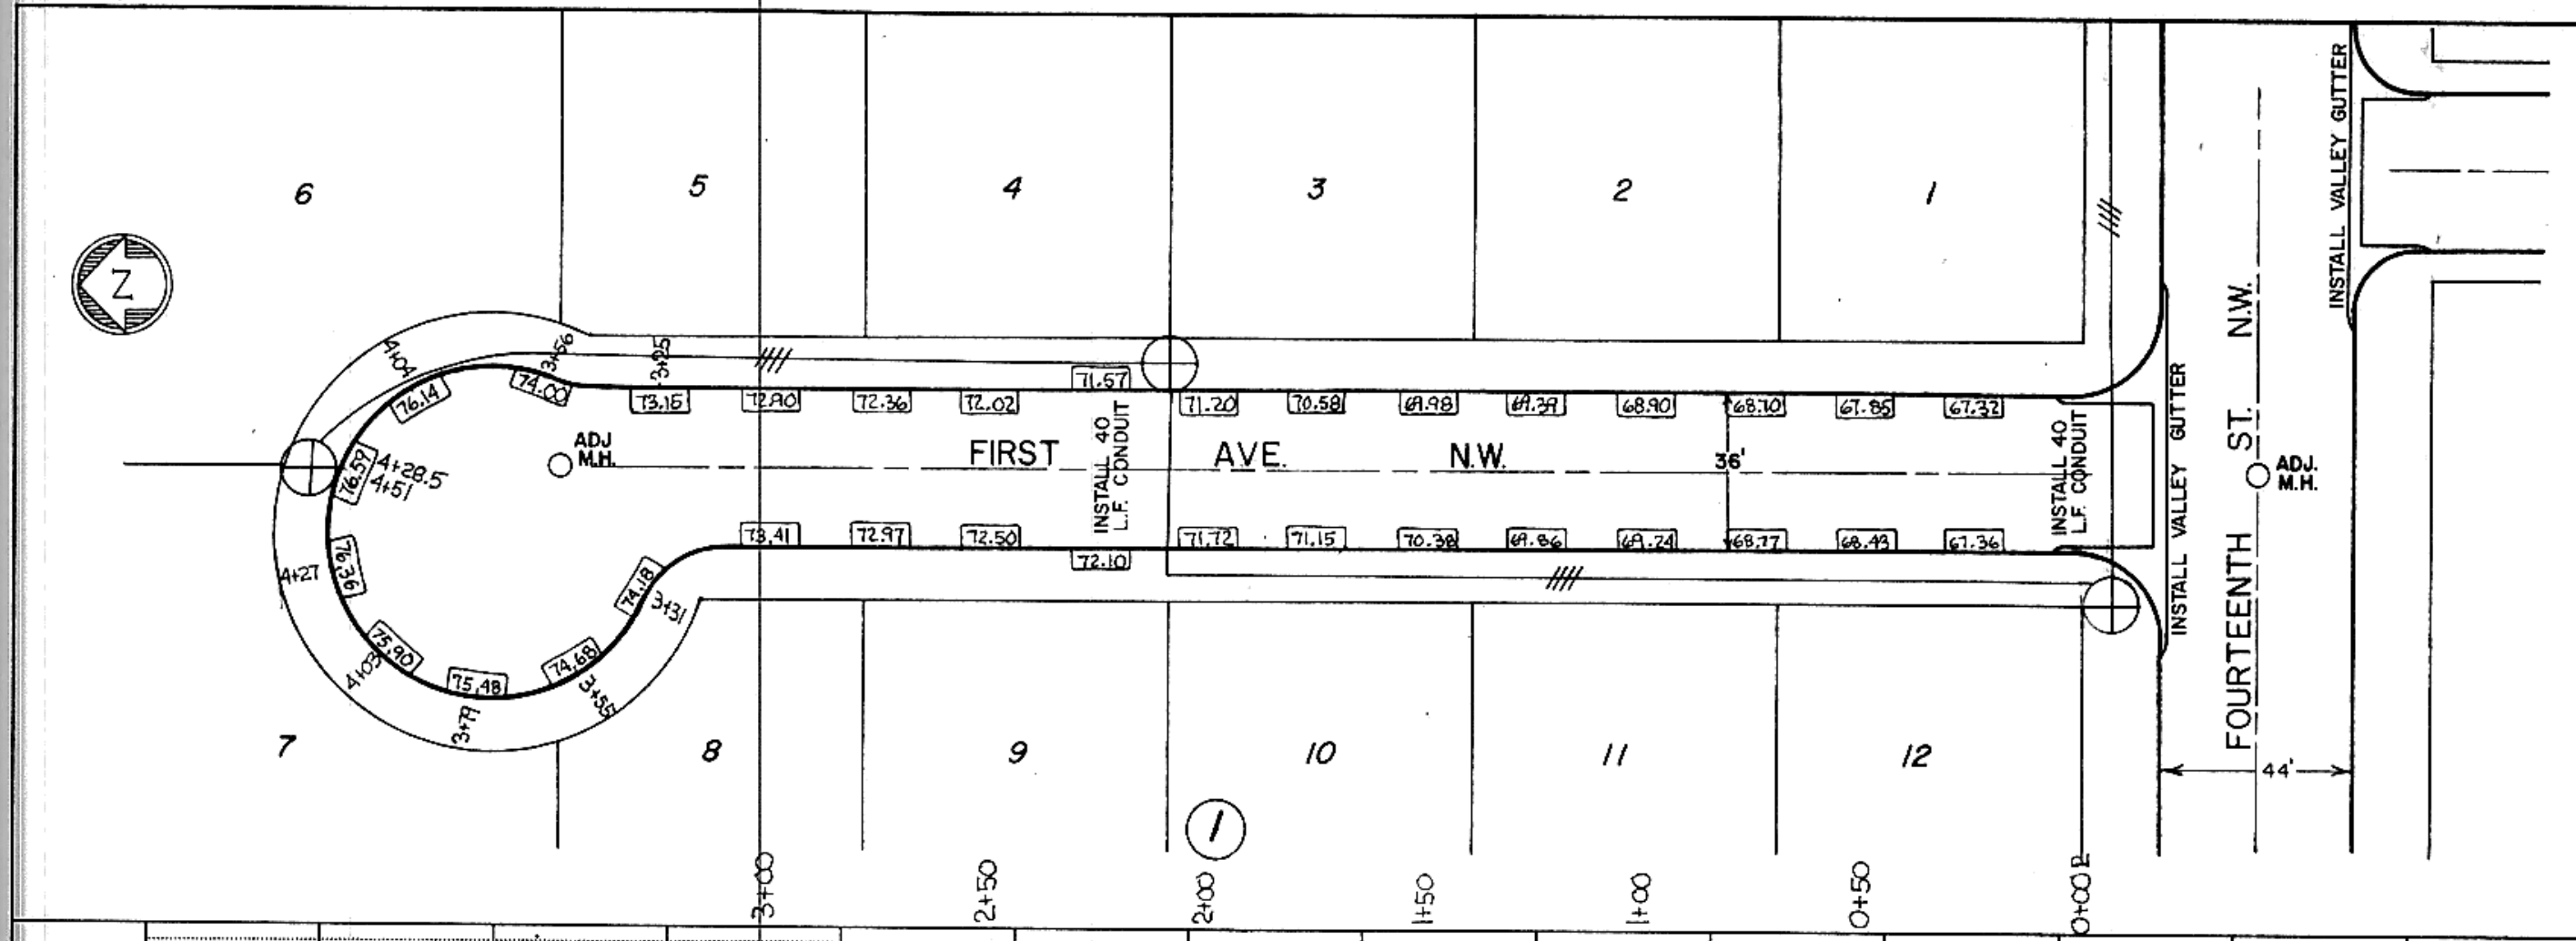